

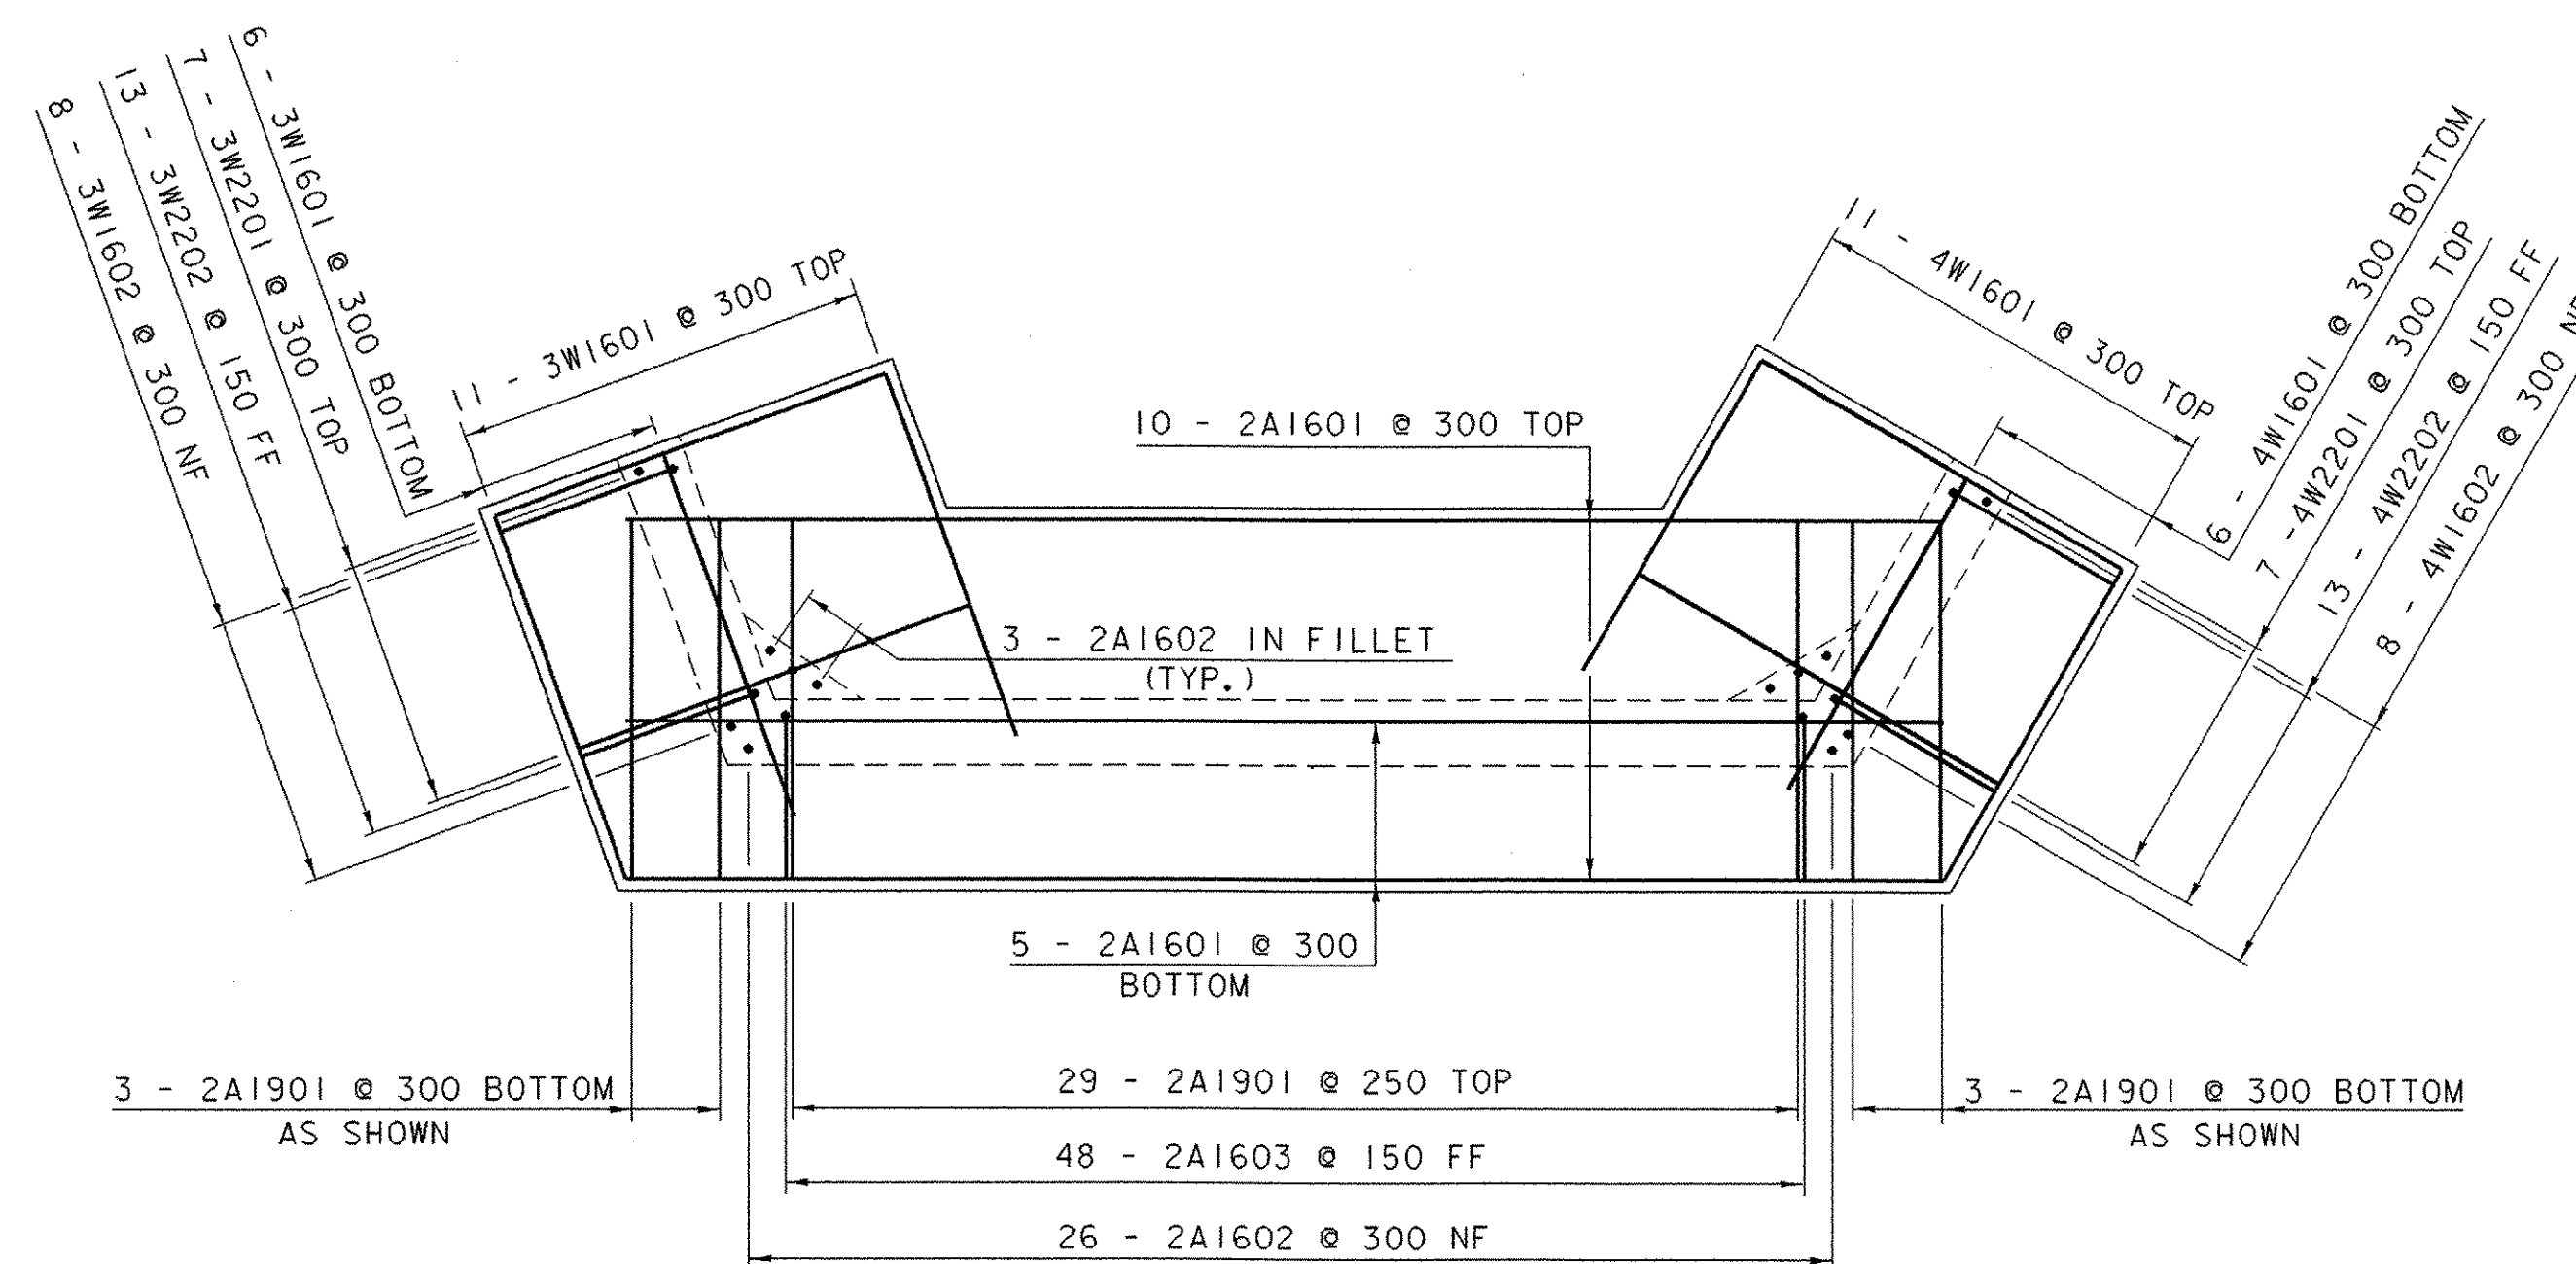


ABUTMENT NO. 1 FOOTING REINFORCING PLAN

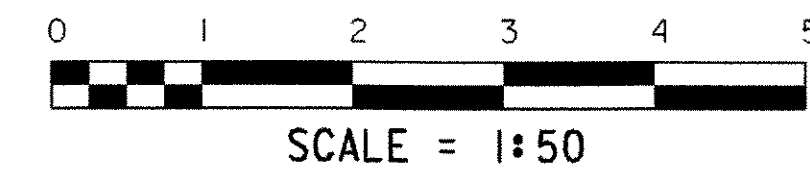

ABUTMENT NO. 2 FOOTING REINFORCING PLAN

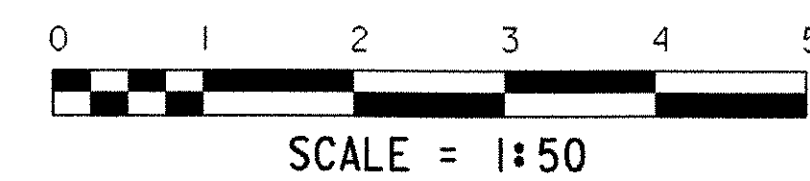

NOTE:

NF = NEAR FACE
 FF = FAR FACE
 EF = EACH FACE
 ▲ = CUT TO FIT IN FIELD
 80 CLR. UNLESS OTHERWISE
 SPECIFIED ON THE PLANS.

STATE OF VERMONT AGENCY OF TRANSPORTATION			
Town Of HUNTINGTON		Bridge No. 34	
Highway No. T.H. 21		Log Sta. Surv. Sta.	
T.H. 21 OVER BRUSH BROOK			
FOOTING REINFORCING DETAILS			
Designed By J. LACROIX	Date		Drawn By SSS/BMM
Checked By M. LOZIER	5/03	Project Manager R.R. WHITCOMB Date 6/03	
PROJECT HUNTINGTON		PROJECT NO. BR01445 (21)	
I.G.C. Info. <i>str3/93j029/sj029abdgn</i>		<i>sj029ftgJ</i>	
Bridge Sheet No.		Sheet 20 of 34	