


MAINLINE CROSS SECTIONS (3)

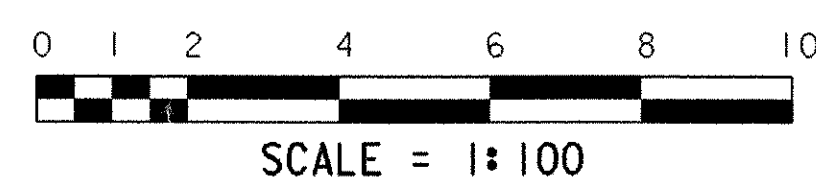

PROJECT NAME:	HUNTINGTON
PROJECT NUMBER:	BRO 1445 (2I)
FILE NAME:	93J029\Structures\sj029m03.1
PROJECT MANAGER:	R.R. WHITCOMB
DESIGNED BY:	J. ARMSTRONG
PLOT DATE:	09-JAN-2004
DRAWN BY:	J. ARMSTRONG
CHECKED BY:	M. LOZIER
SHEET	26 OF 34