



CHAN. STA. 20+075.0 RT.  
 END UNCLASSIFIED CHANNEL EXCAVATION  
 GEOTEXTILE UNDER STONE FILL  
 STONE FILL, TYPE III  
 GRUBBING MATERIAL

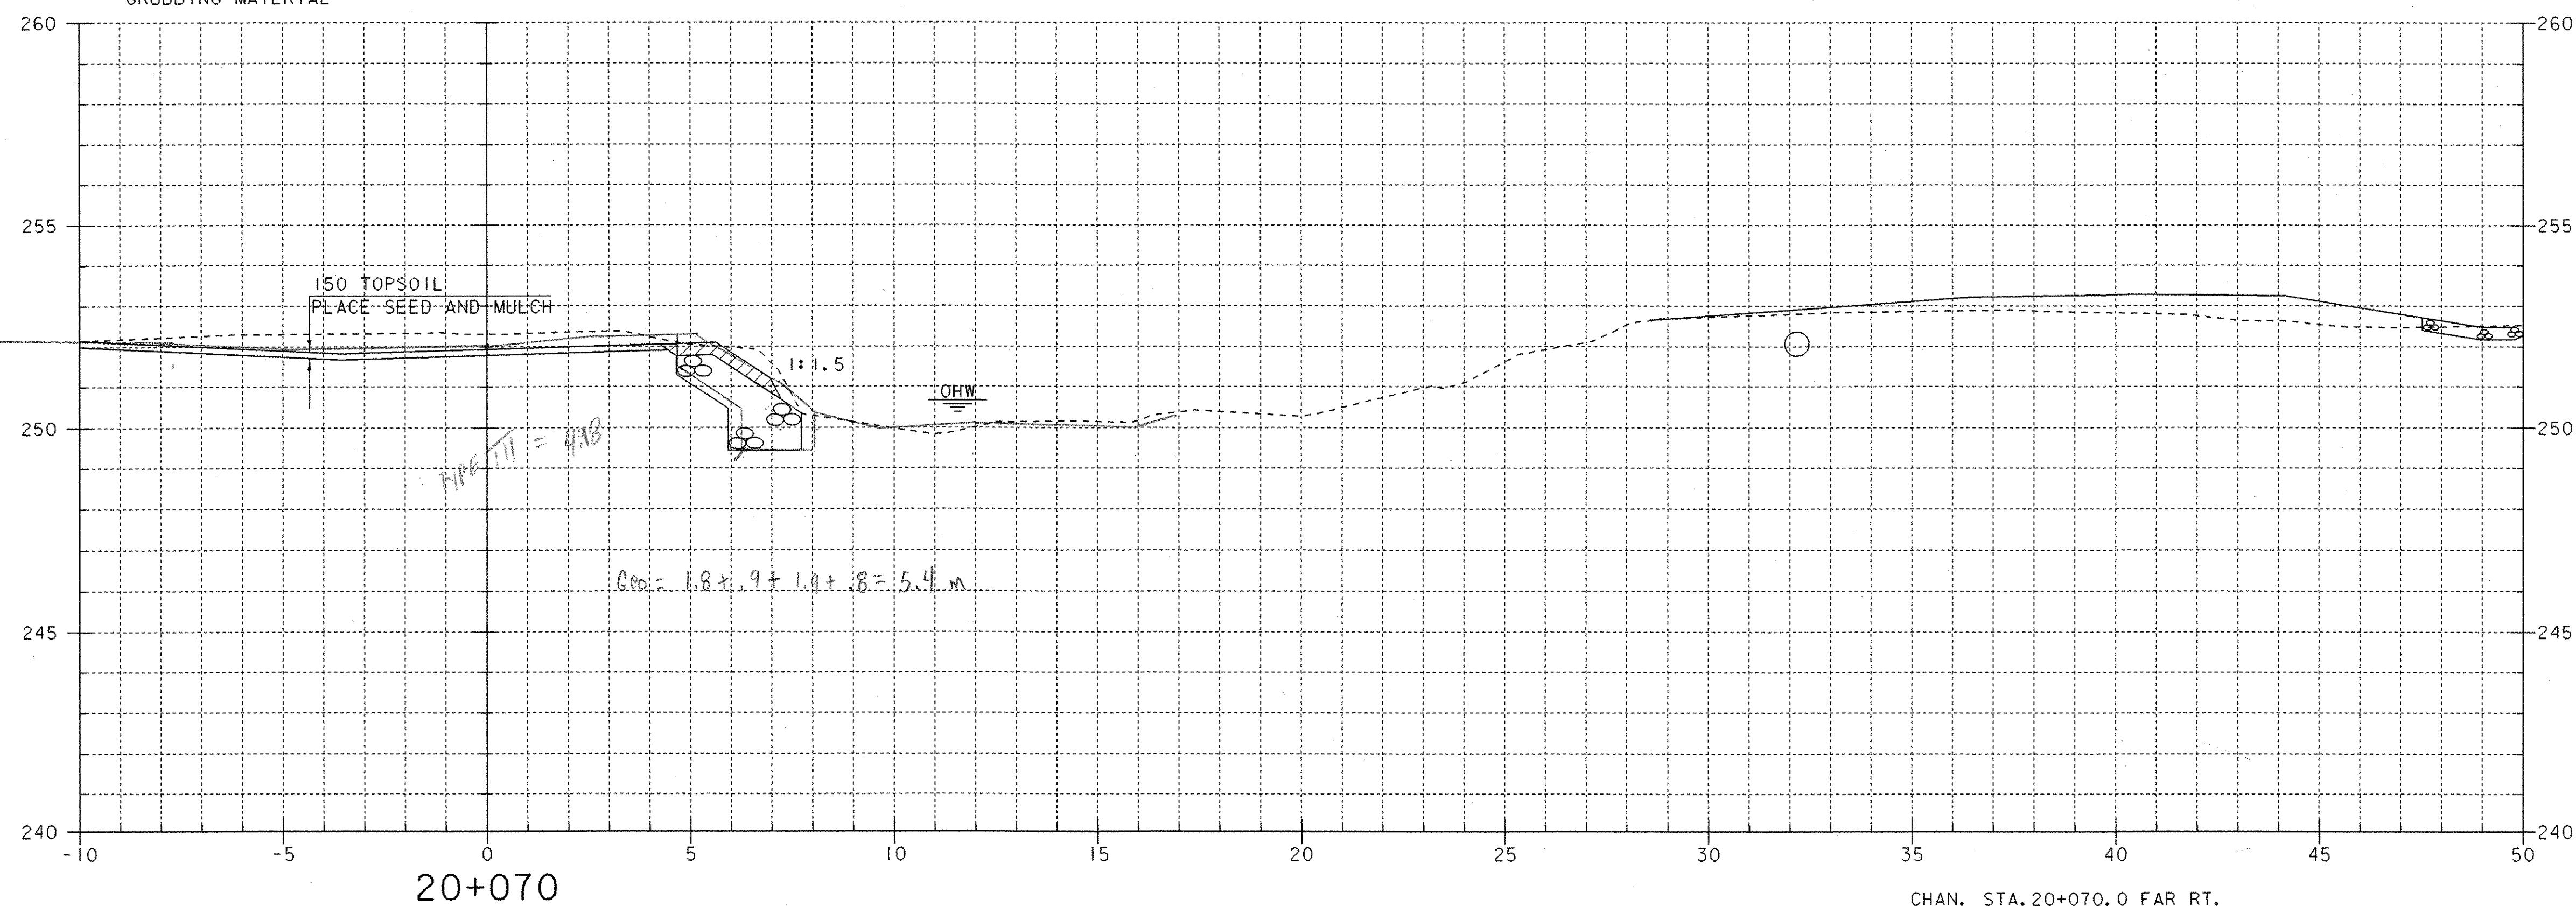

CHAN. STA. 20+070.0 FAR RT.  
 END UNCLASSIFIED CHANNEL EXCAVATION  
 GEOTEXTILE UNDER STONE FILL  
 STONE FILL, TYPE III  
 GRUBBING MATERIAL

CHANNEL CROSS SECTIONS (6)

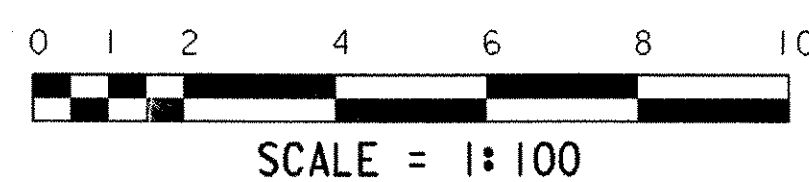

PROJECT NAME:	HUNTINGTON
PROJECT NUMBER:	BRO 1445 (21)
FILE NAME:	93J029\Structures\sj029c06.i
PROJECT MANAGER:	R.R. WHITCOMB
DESIGNED BY:	J. ARMSTRONG
PLOT DATE:	09-JAN-2004
DRAWN BY:	J. ARMSTRONG
CHECKED BY:	M. LOZIER
SHEET	33 OF 34