



WINGWALL #2
SCALE = 1:20

WINGWALL #1
SCALE = 1:20

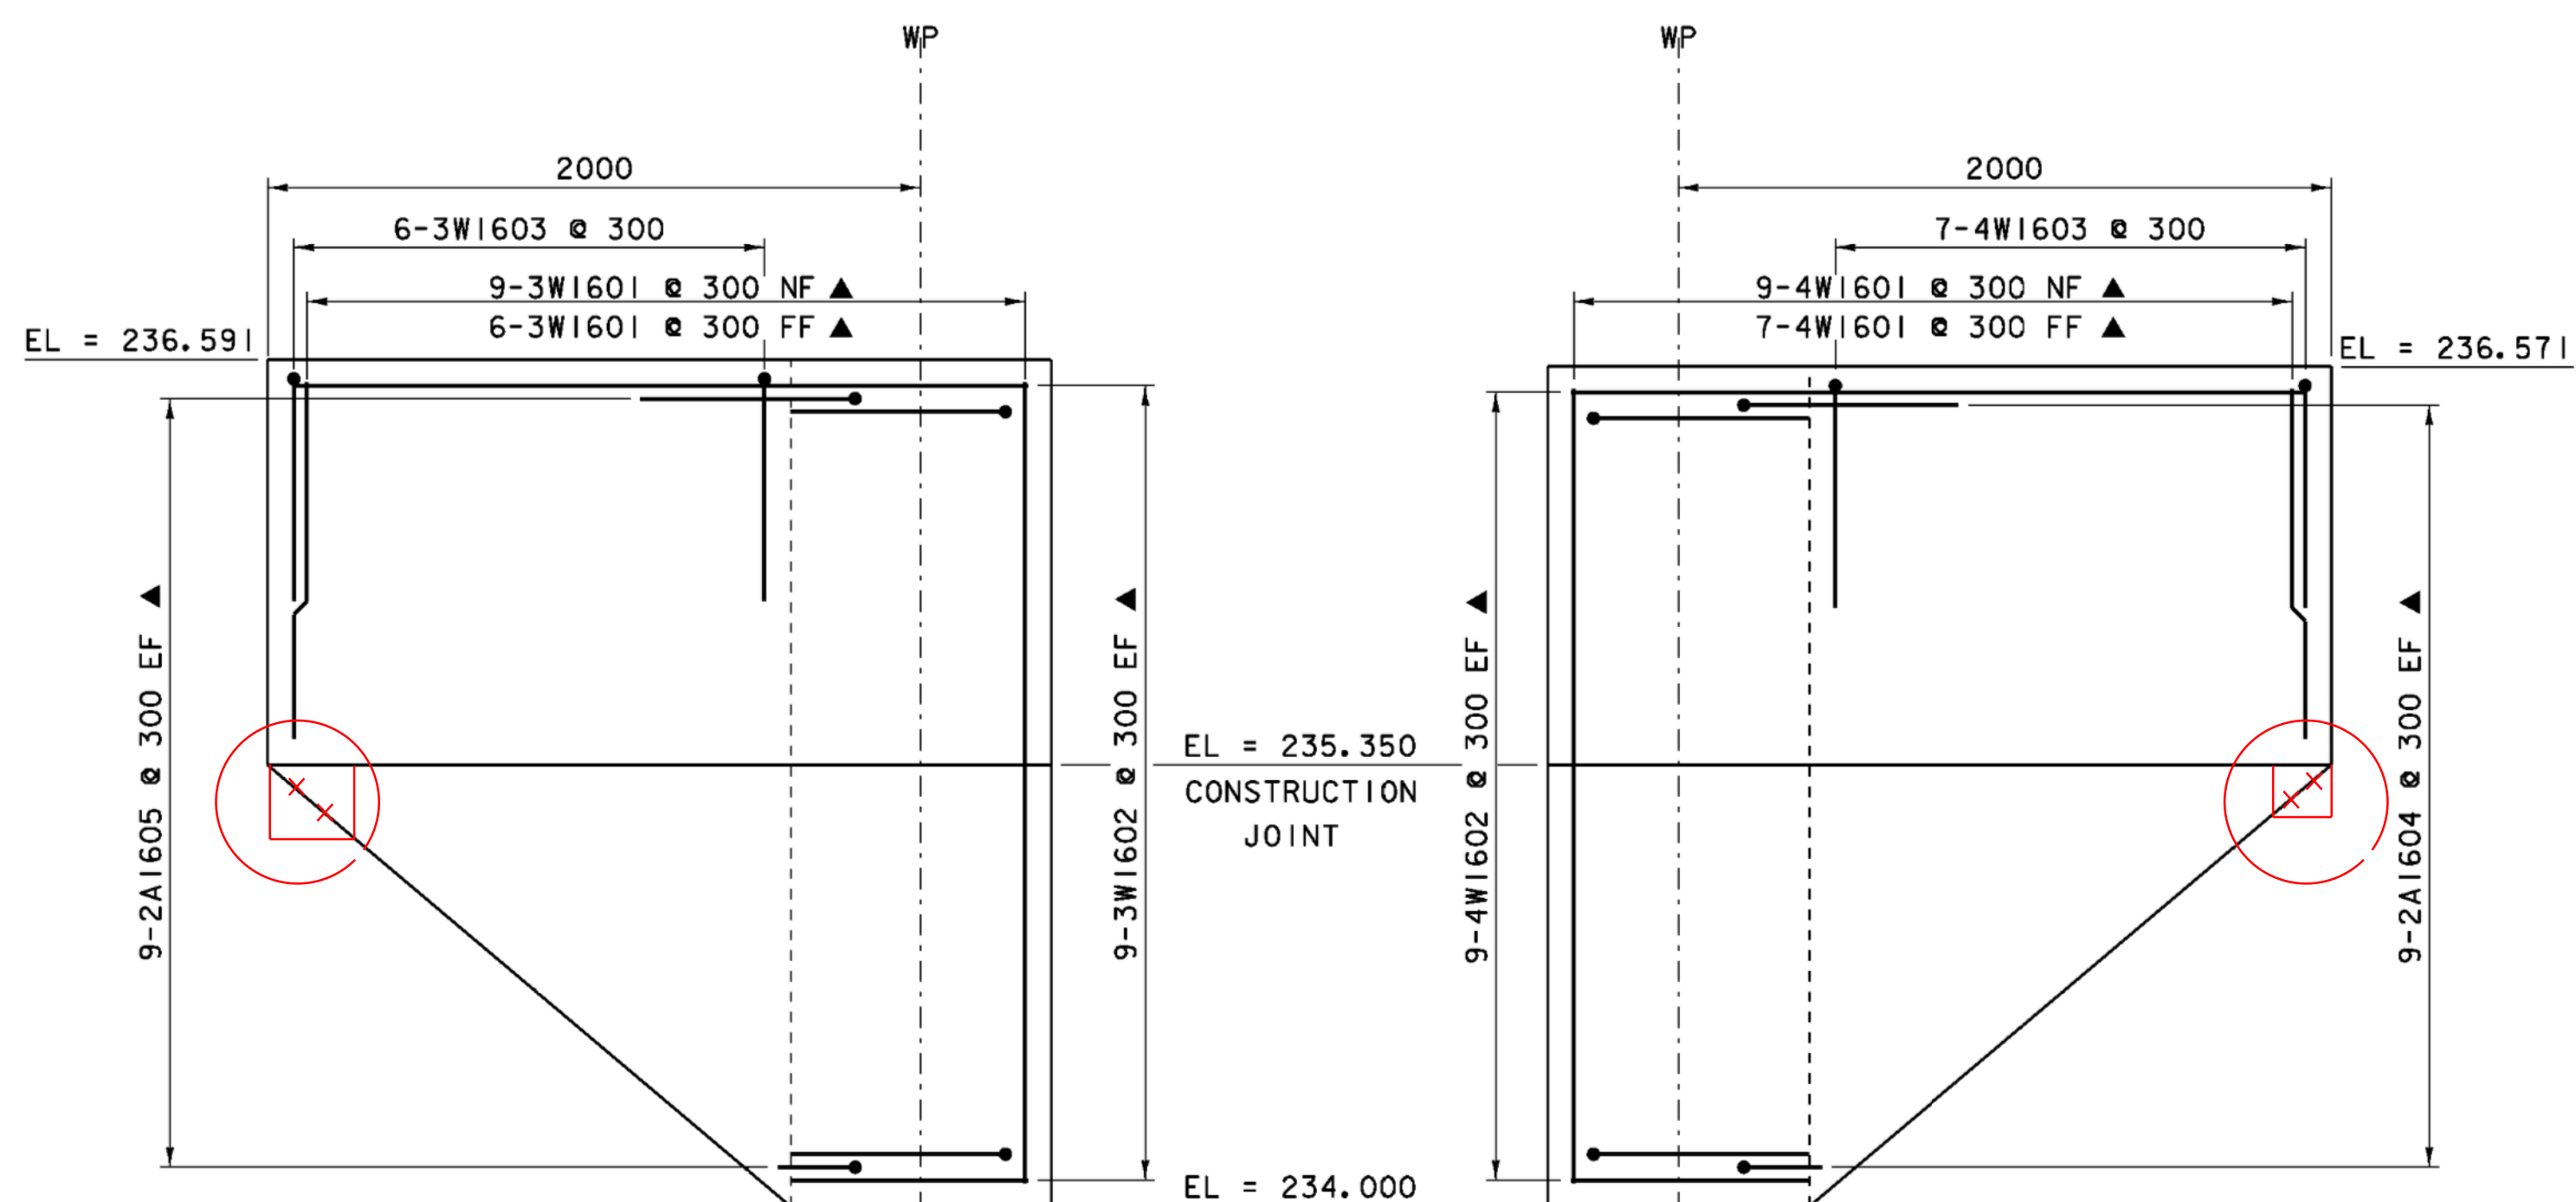


WINGWALL #3
SCALE = 1:20


WINGWALL #4
SCALE = 1:20

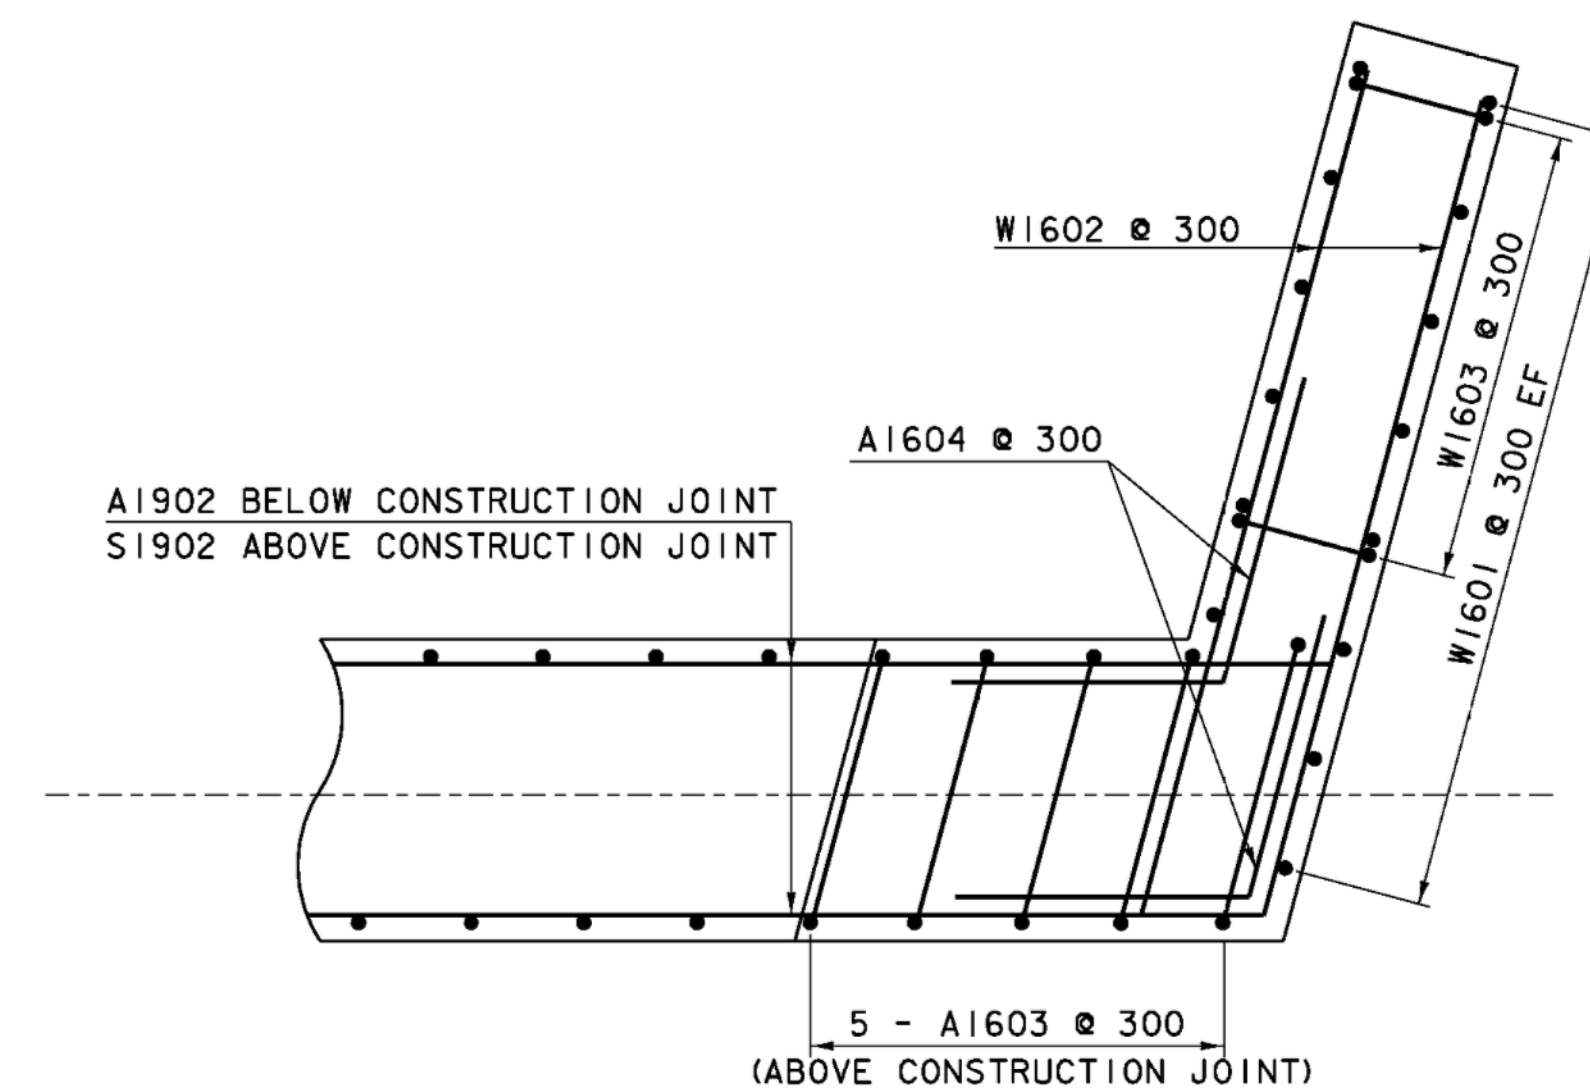

CORNER DETAIL
SCALE = 1:20

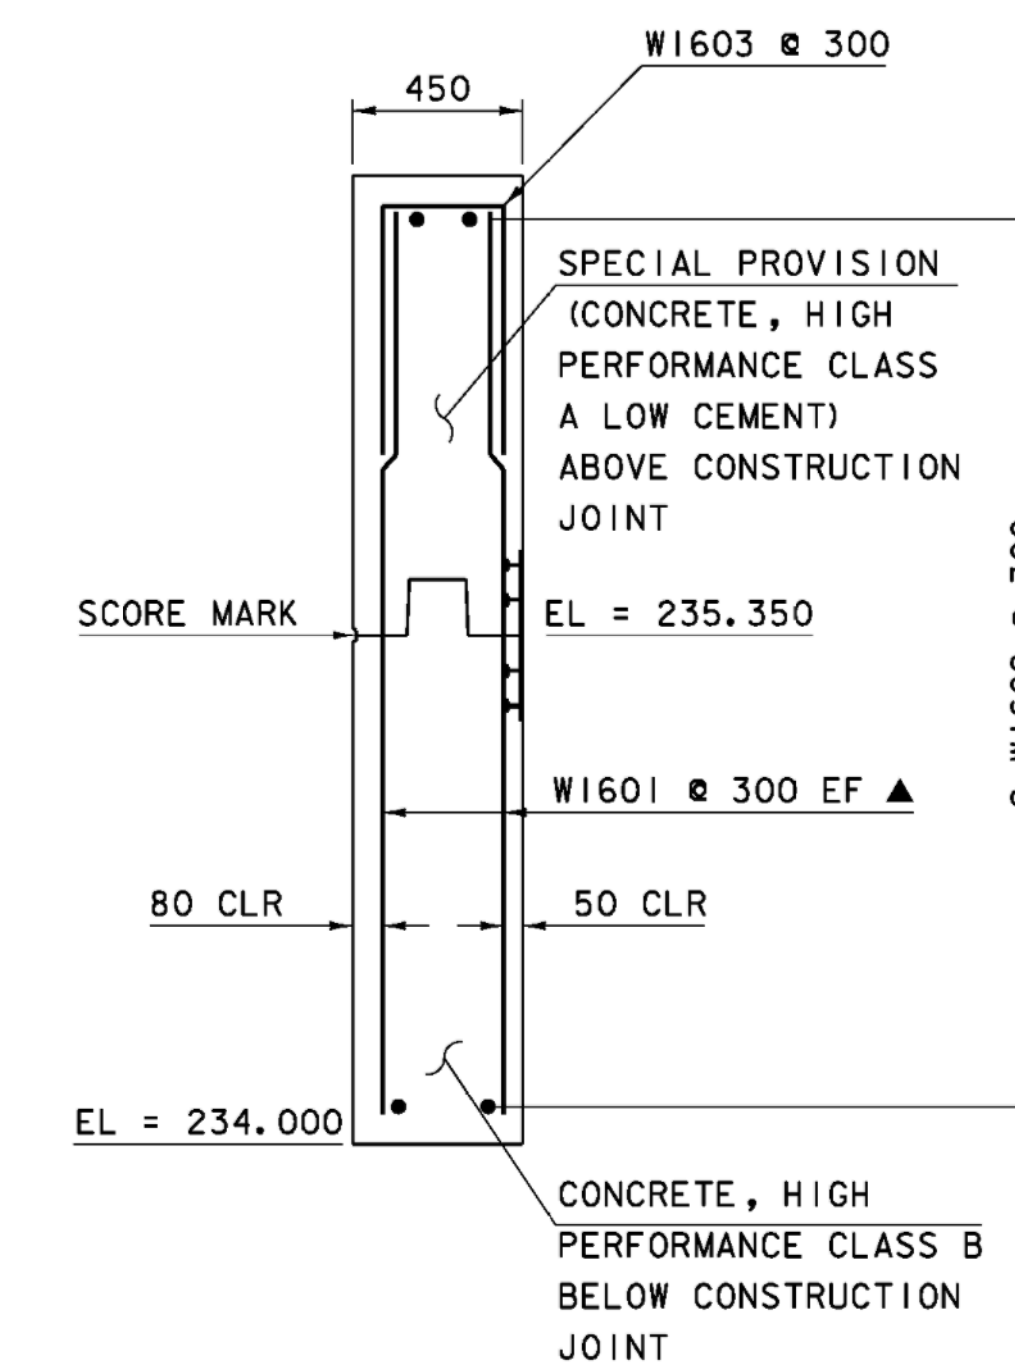

WINGWALL TYPICAL SECTION
SCALE = 1:20

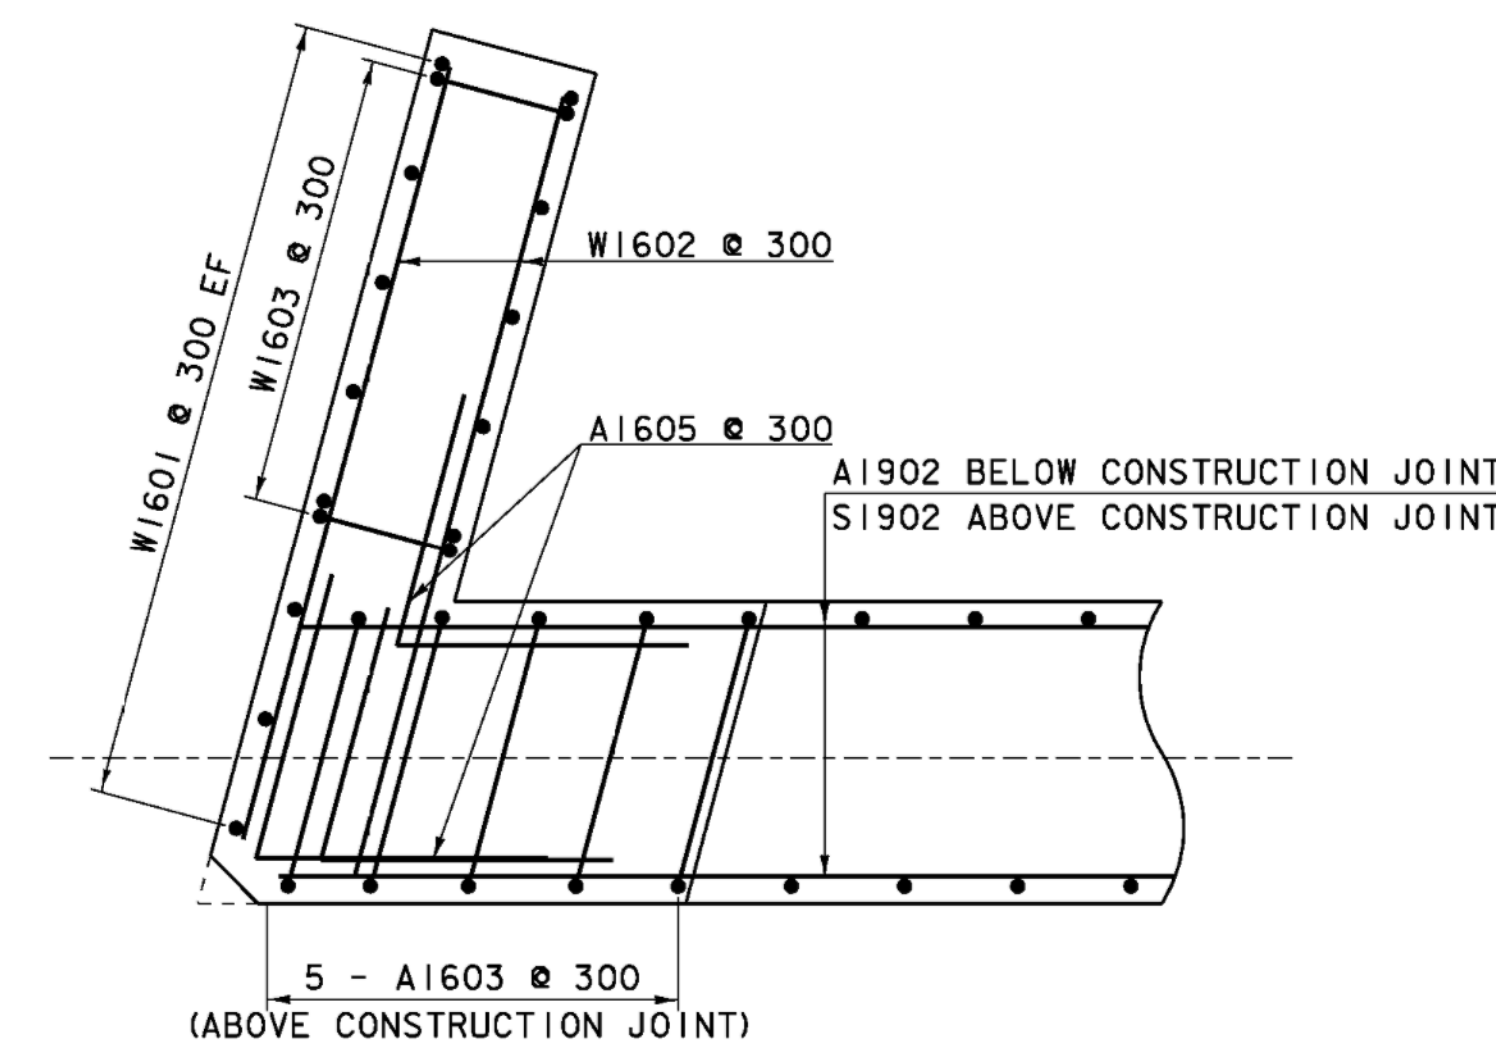

CORNER DETAIL
SCALE = 1:20



NOTE:

NF = NEAR FACE
FF = FAR FACE
EF = EACH FACE
▲ = CUT TO FIT IN FIELD
80 CLR. UNLESS OTHERWISE SPECIFIED ON THE PLANS.
ALL LAPS SHALL BE 660 UNLESS NOTED OTHERWISE
ALL REINFORCING STEEL SHALL BE EPOXY COATED.

PROJECT: CORINTH	PROJECT NO.: STP BR0 1447 (22) (RE-ADVERTISED)
DESIGN FILE NAME: sj042sub.dgn IPARM FILE NAME: sj042wvs.i DESIGNED BY: H. I. SALLS SQUAD LEADER: C. P. WILLIAMS WINGWALL DETAIL SHEET	PLOT DATE: 16-JUL-2008 DRAWN BY: M. FESSEL CHECKED BY: R. S. YOUNG SHEET: 26 OF 42