



STA. I+080.086  
 BEGIN BRIDGE

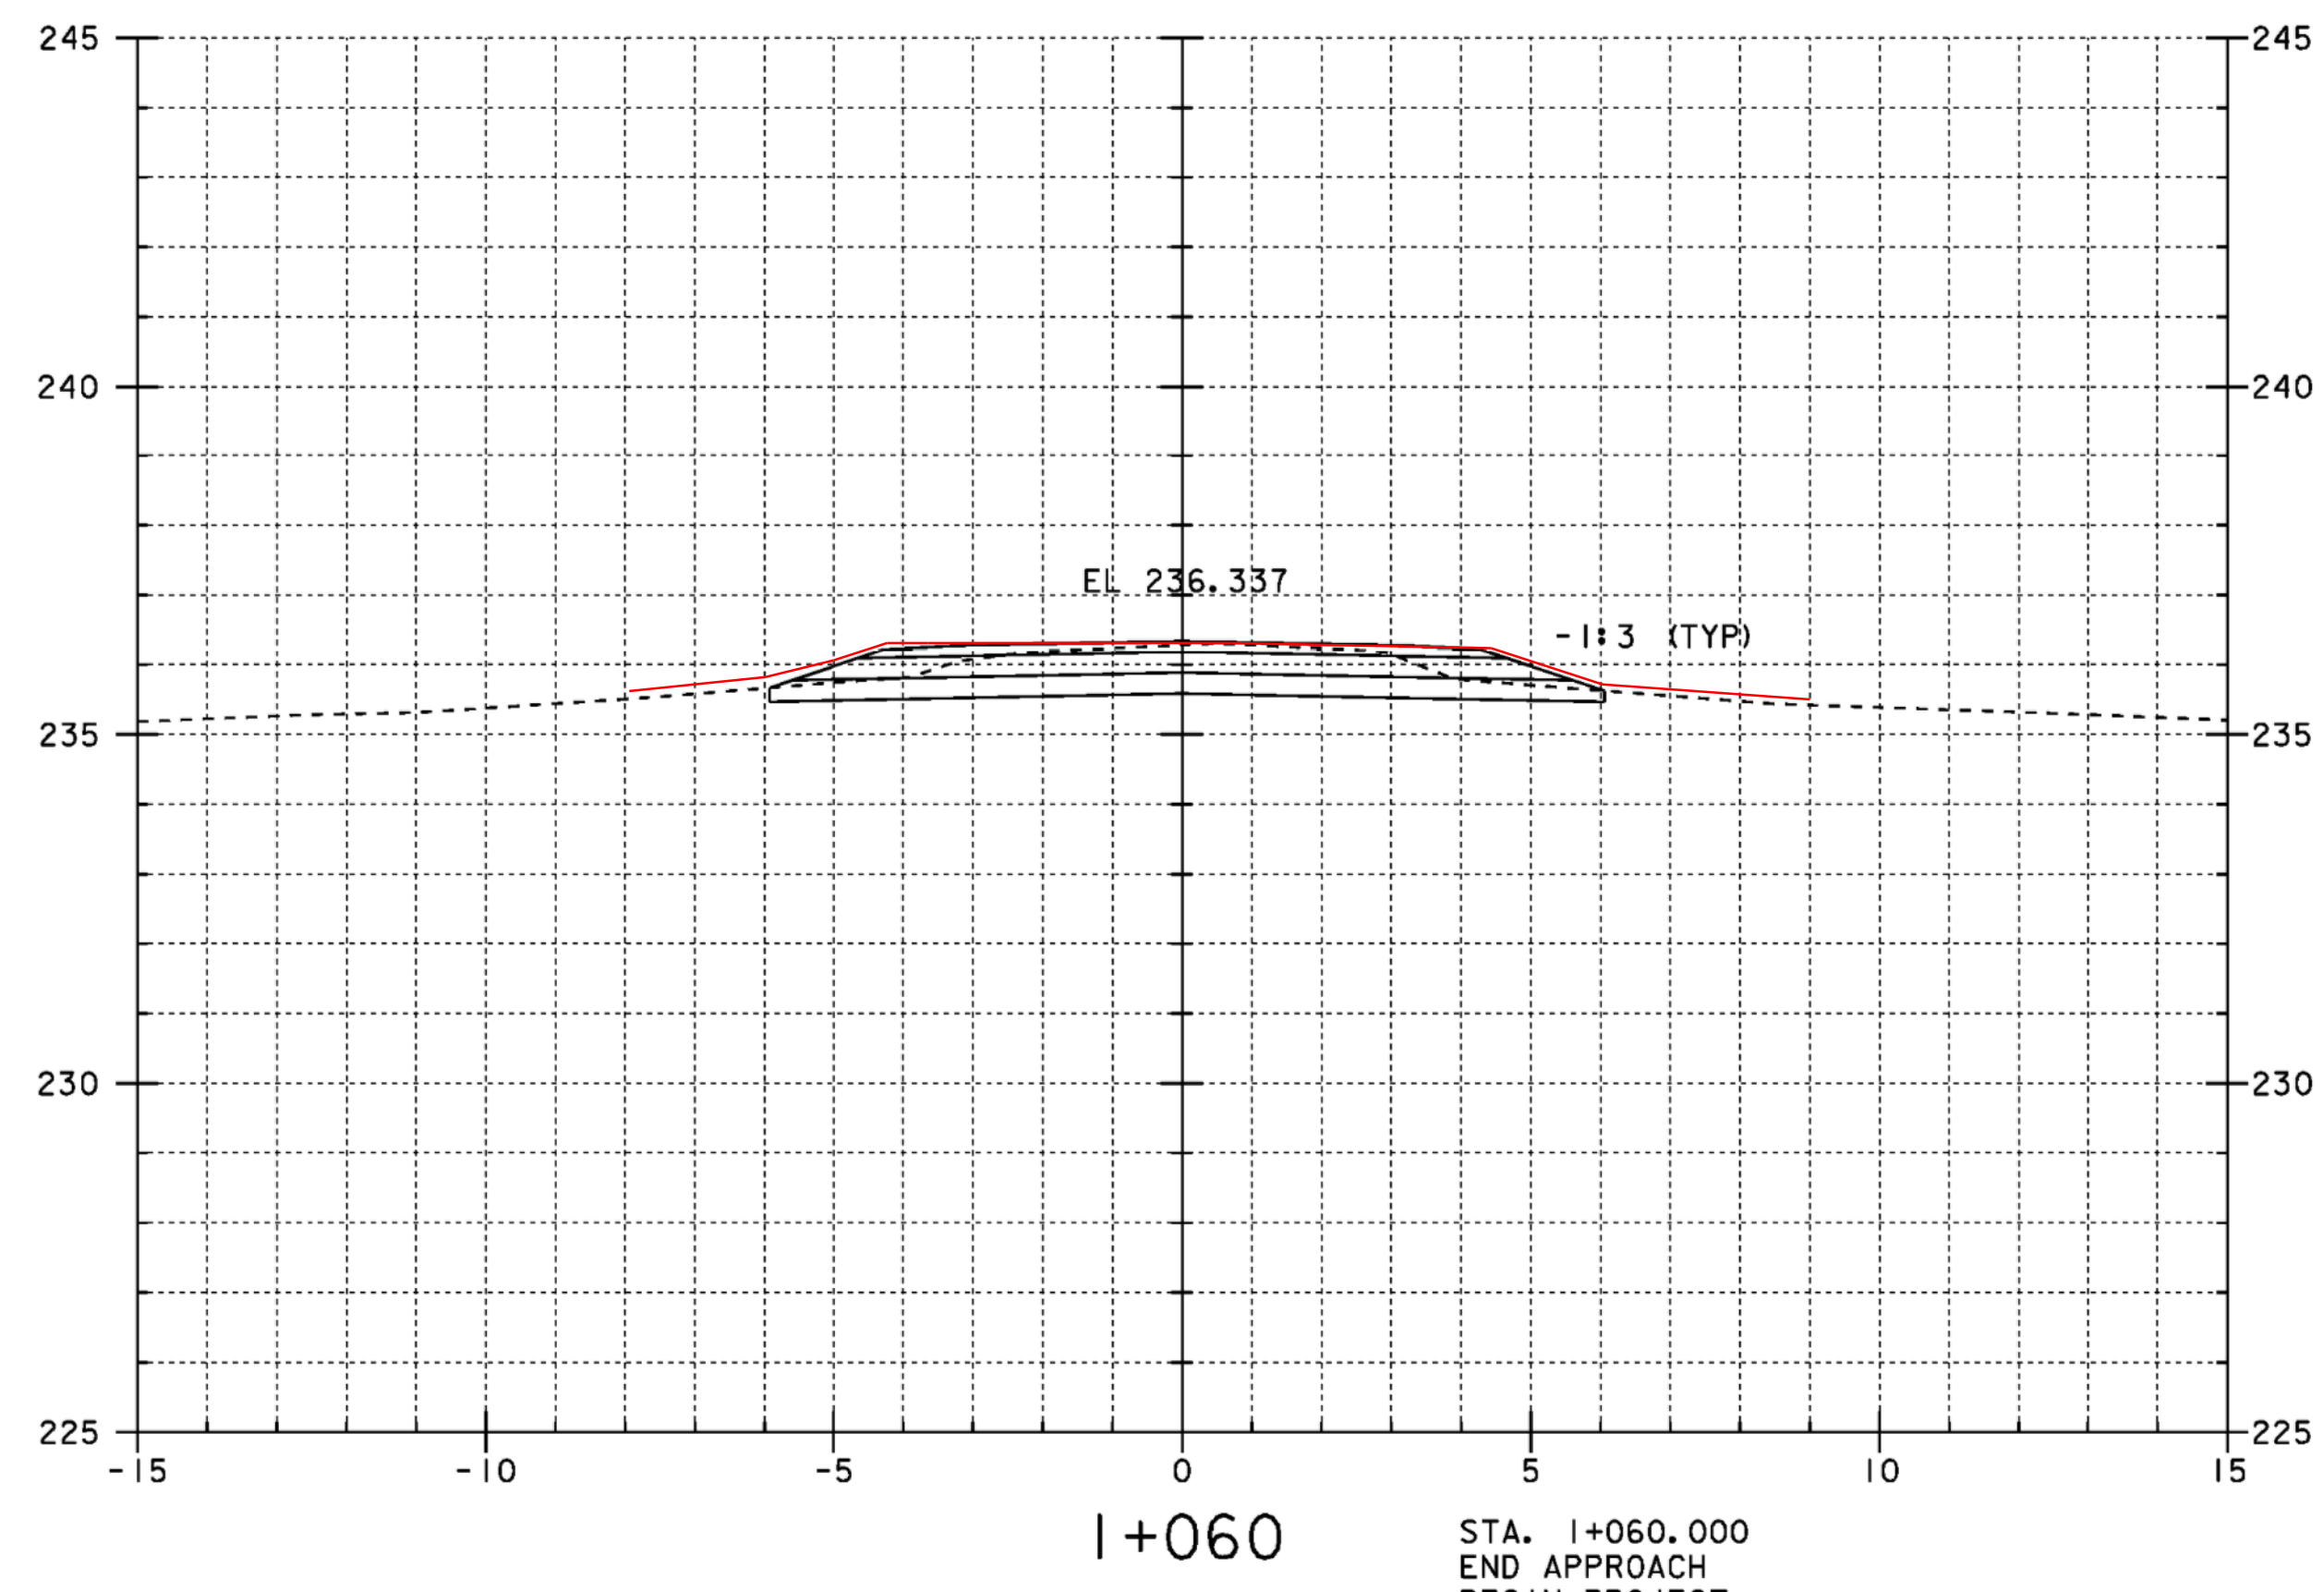

STA. I+060.000  
 END APPROACH  
 BEGIN PROJECT

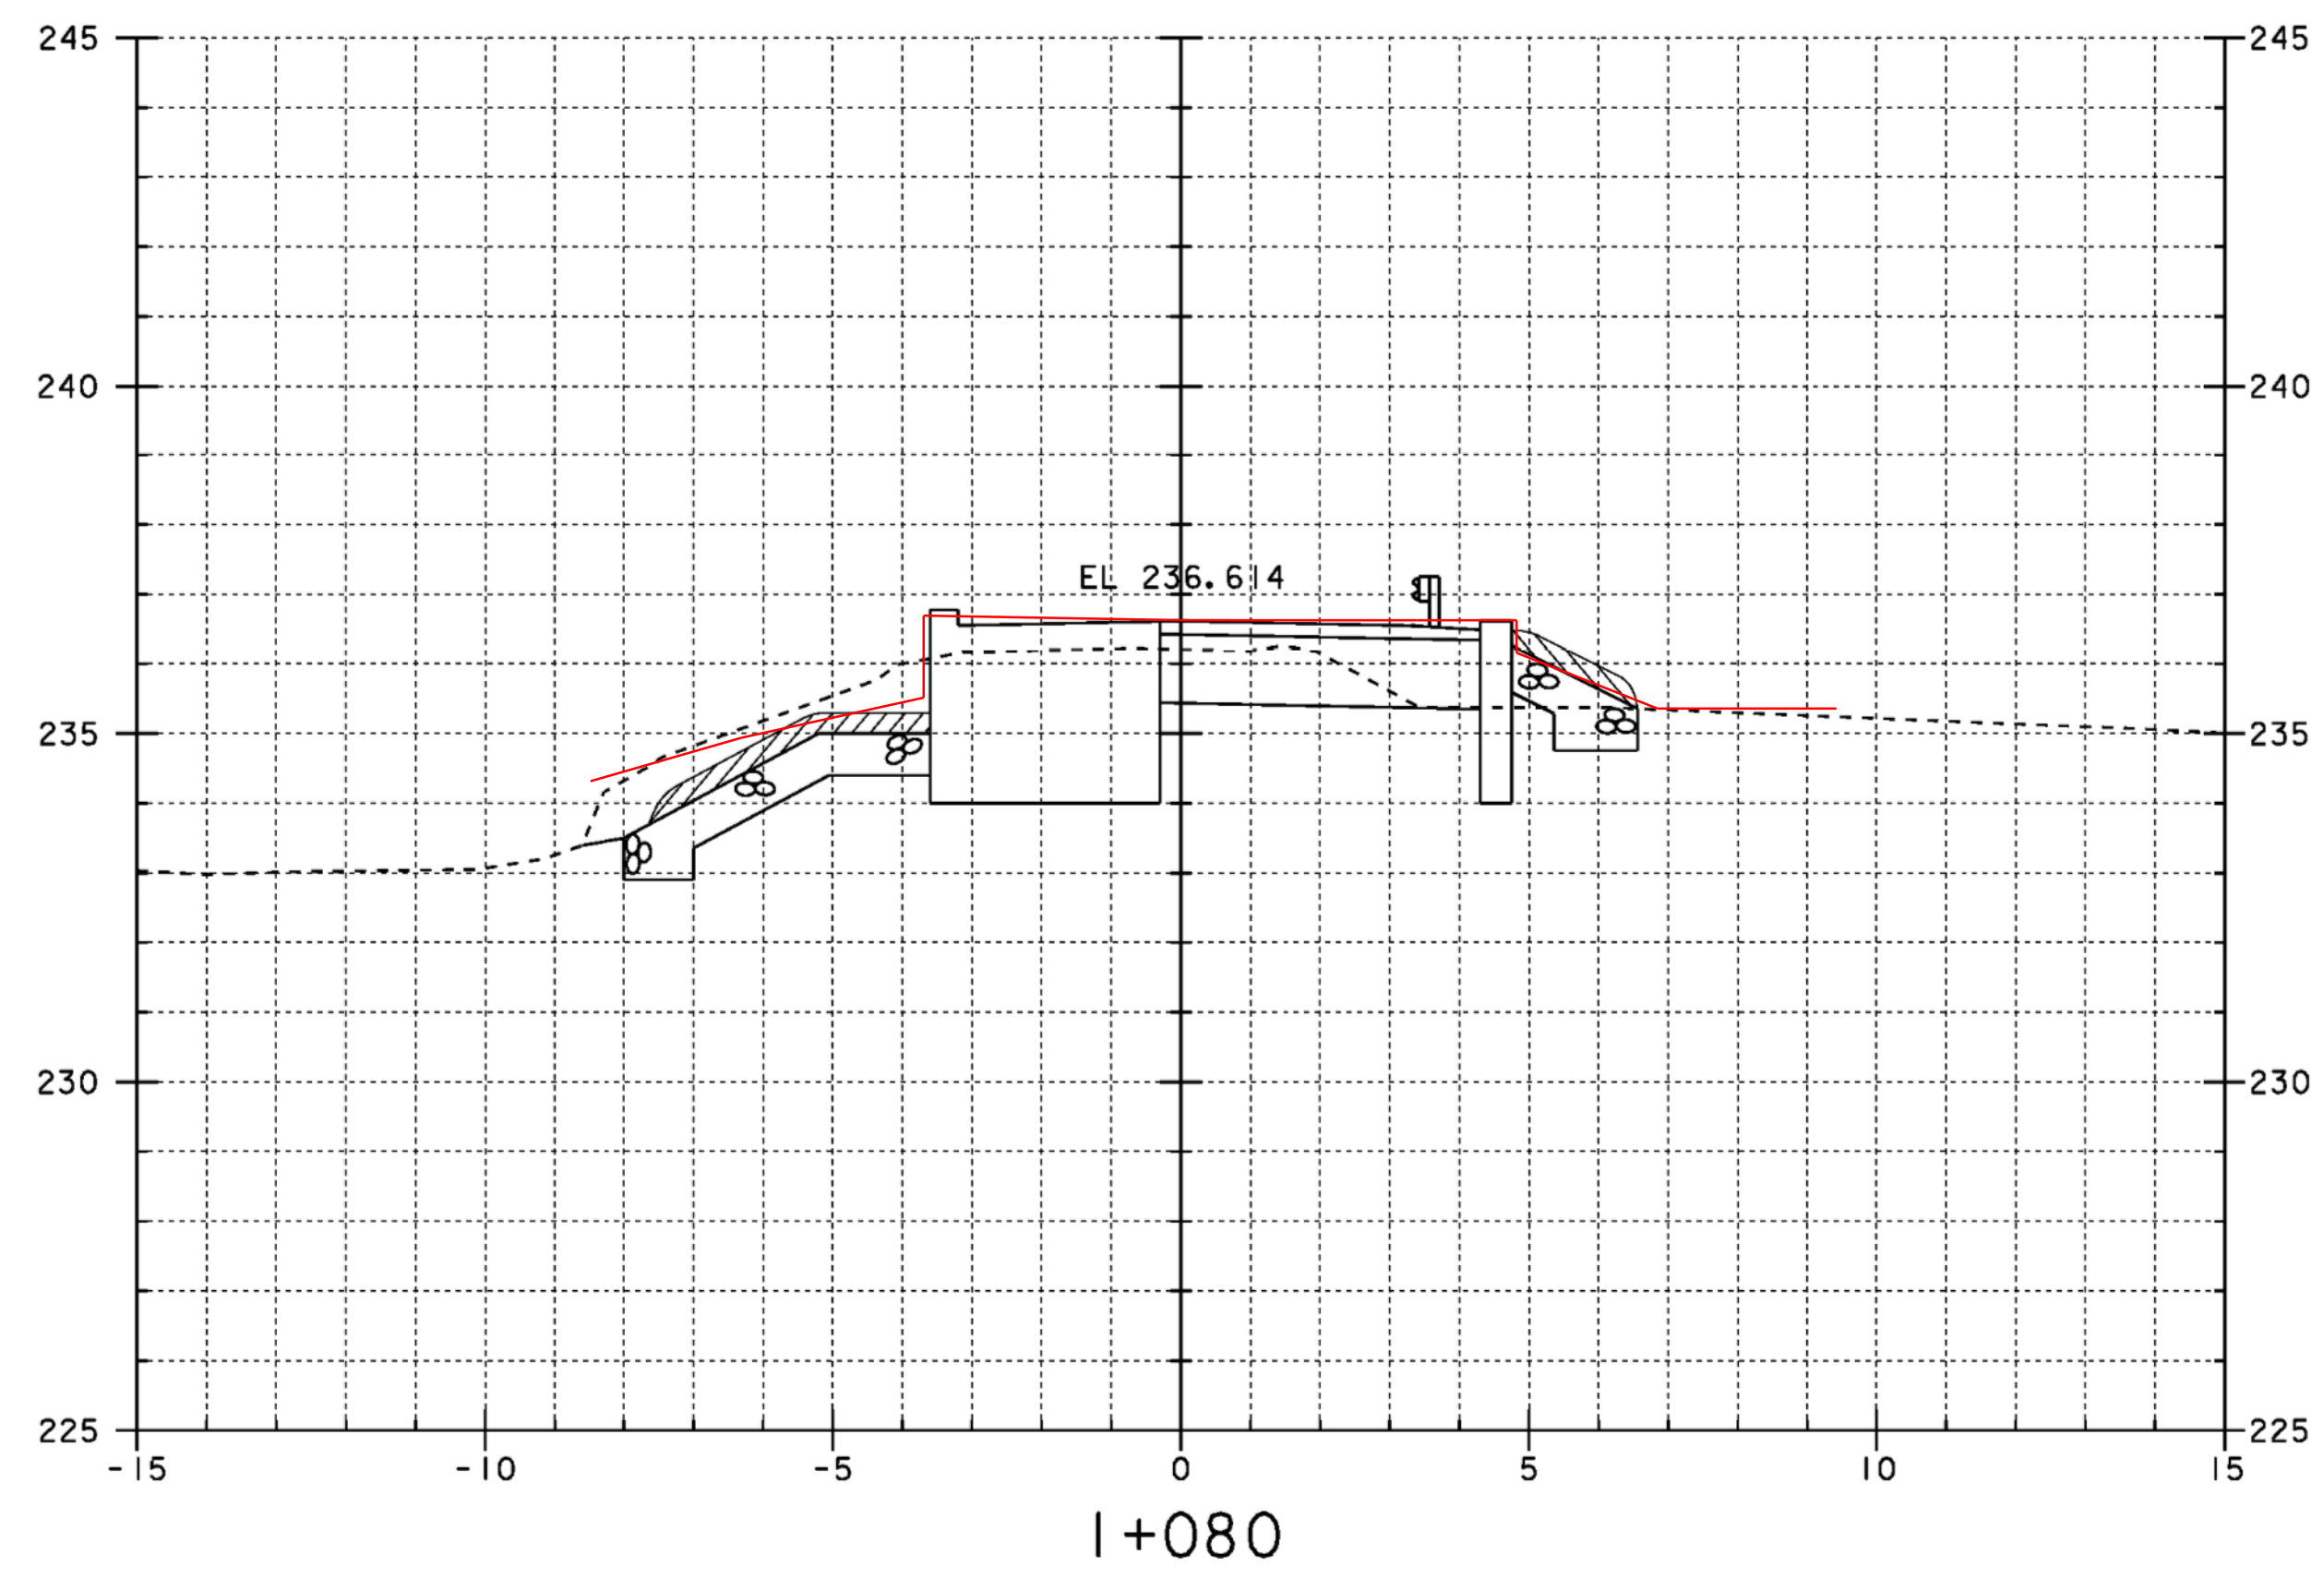

PROJECT: CORINTH	PROJECT NO.: STP BRO 1447 (22) (RE-ADVERTISED)
DESIGN FILE NAME: sj042xs2.dgn	PLOT DATE: 16-JUL-2008
IPARM FILE NAME: sj042m2.i	
MAIN LINE SECTIONS I+060 TO I+090	SHEET: 37 OF 42