


STA. I+140.000 END APPROACH
END EROSION MATTING

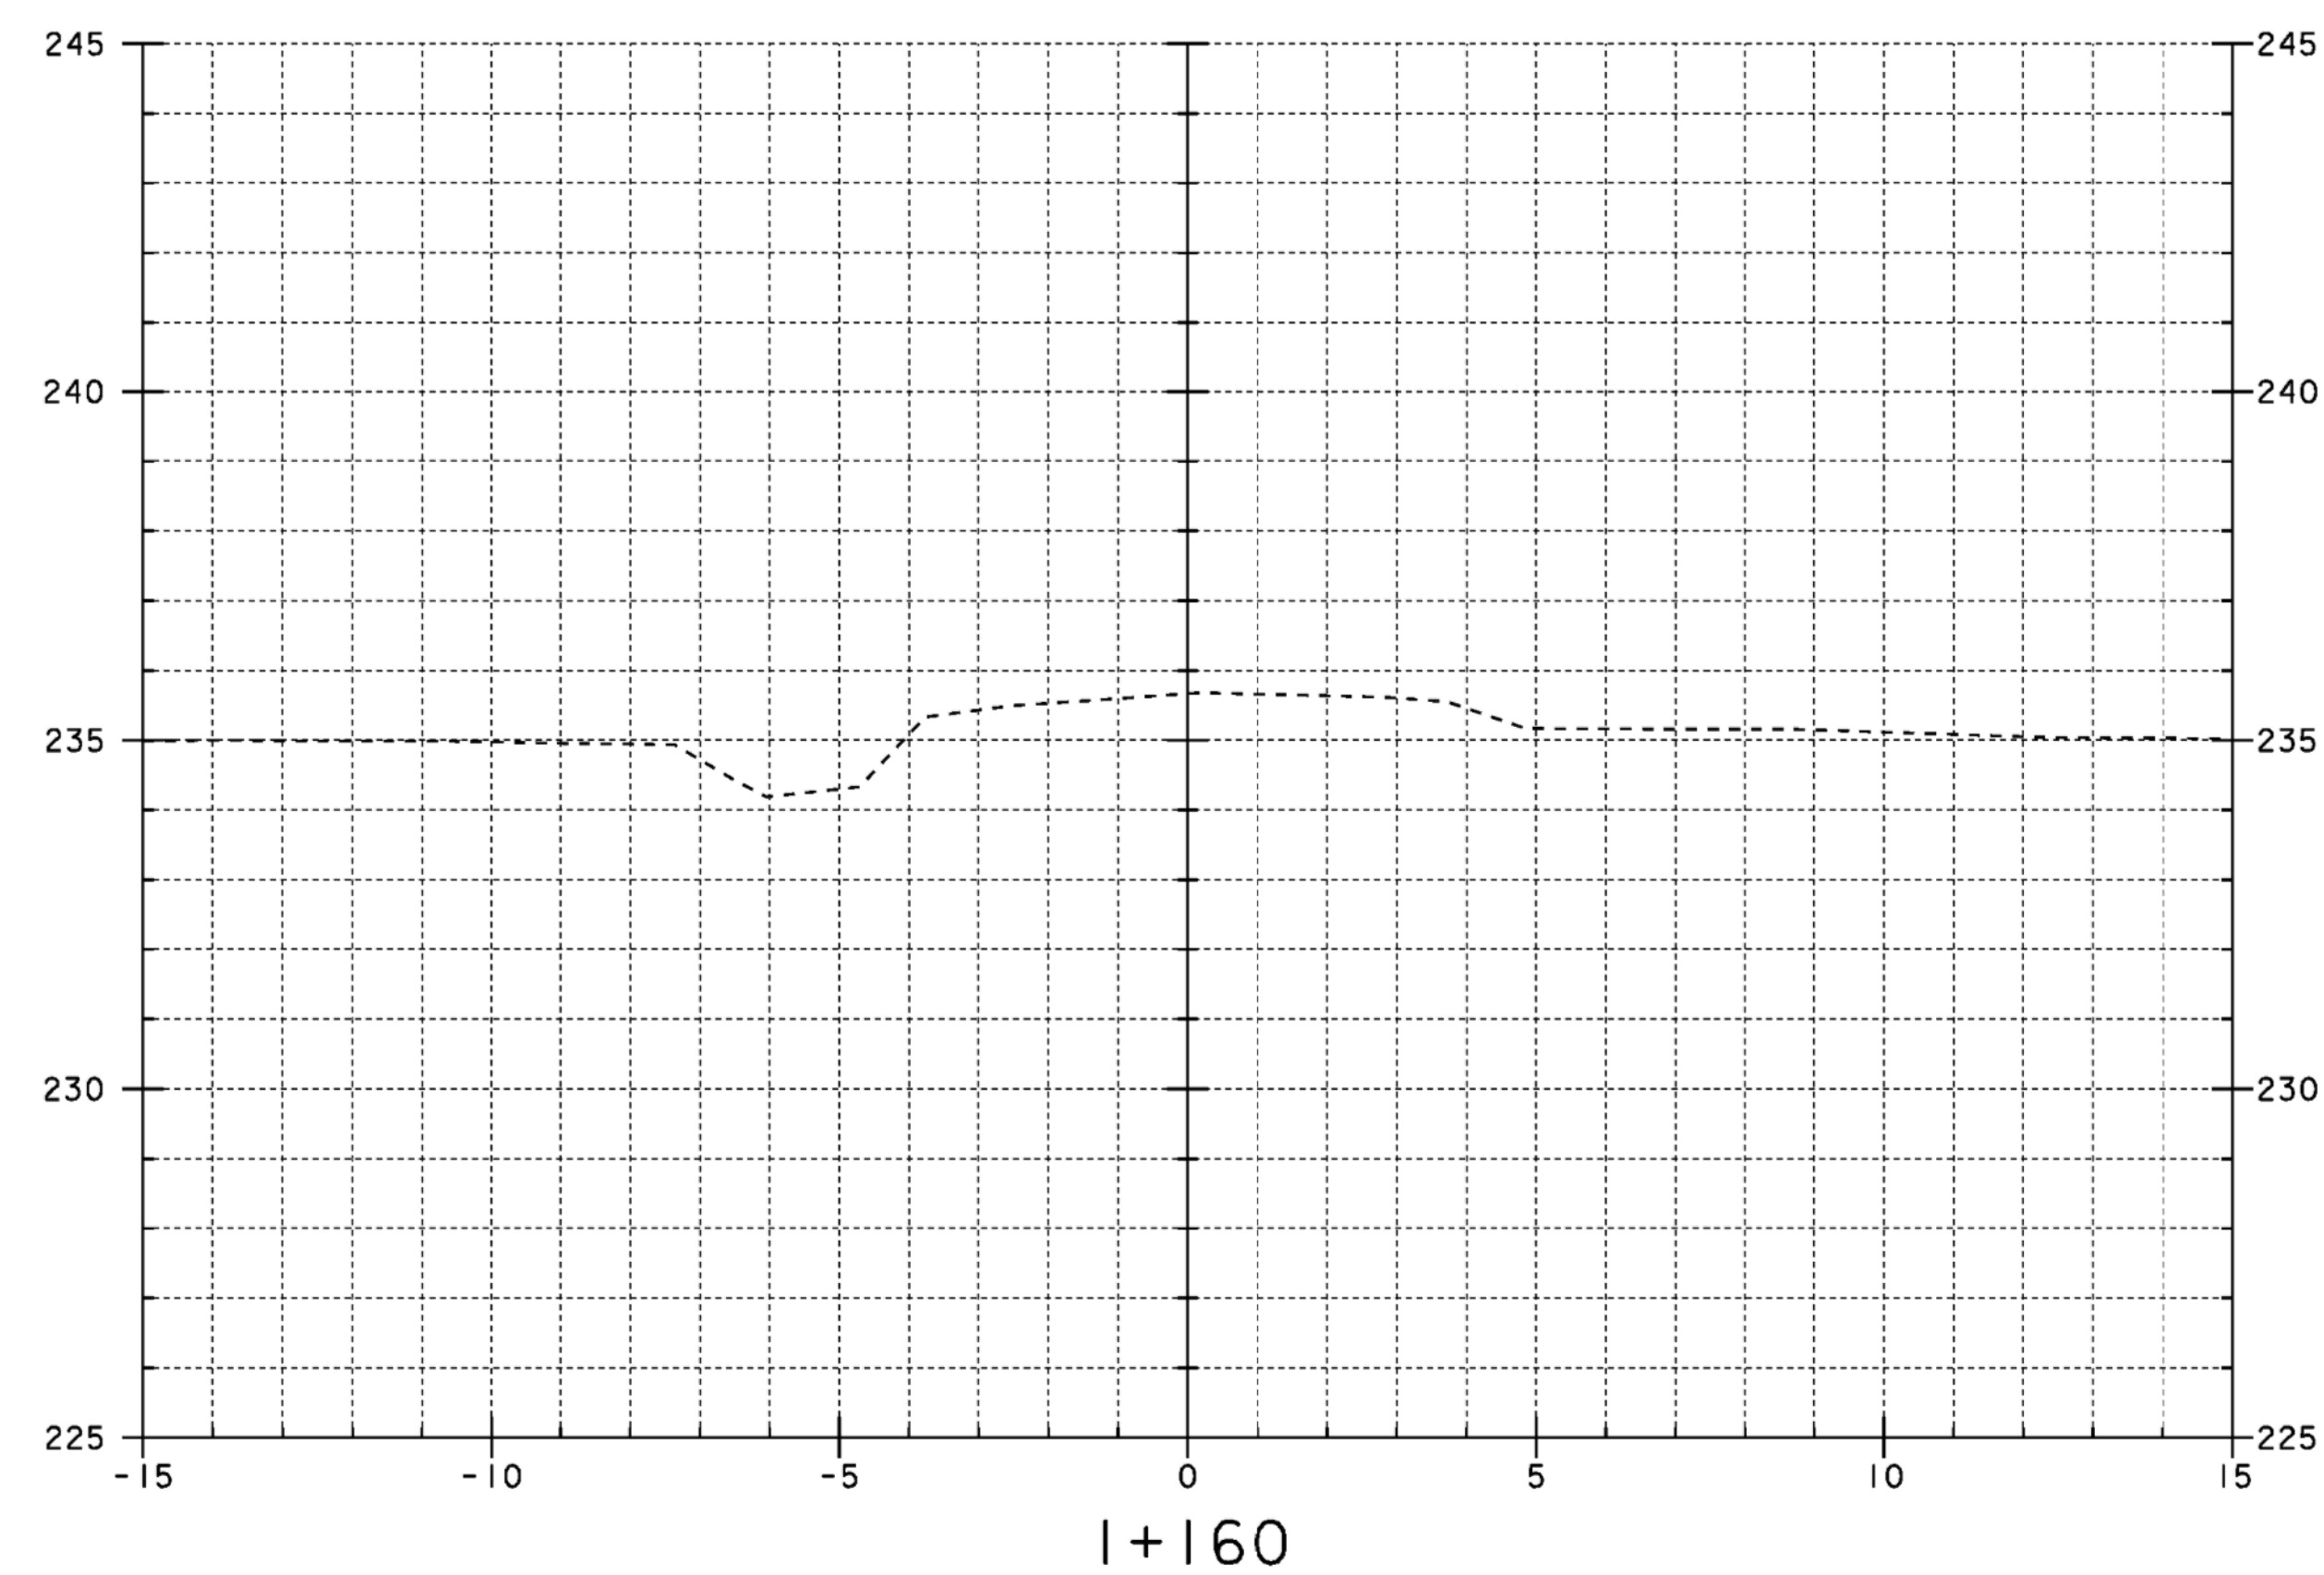

PROJECT: CORINTH	PROJECT NO.: STP BRO I447 (22) (RE-ADVERTISED)
DESIGN FILE NAME: sj042xs2.dgn	PLOT DATE: 16-JUL-2008
IPARM FILE NAME: sj042m4.i	
MAIN LINE SECTIONS	
I+140 TO I+170	SHEET: 39 OF 42