



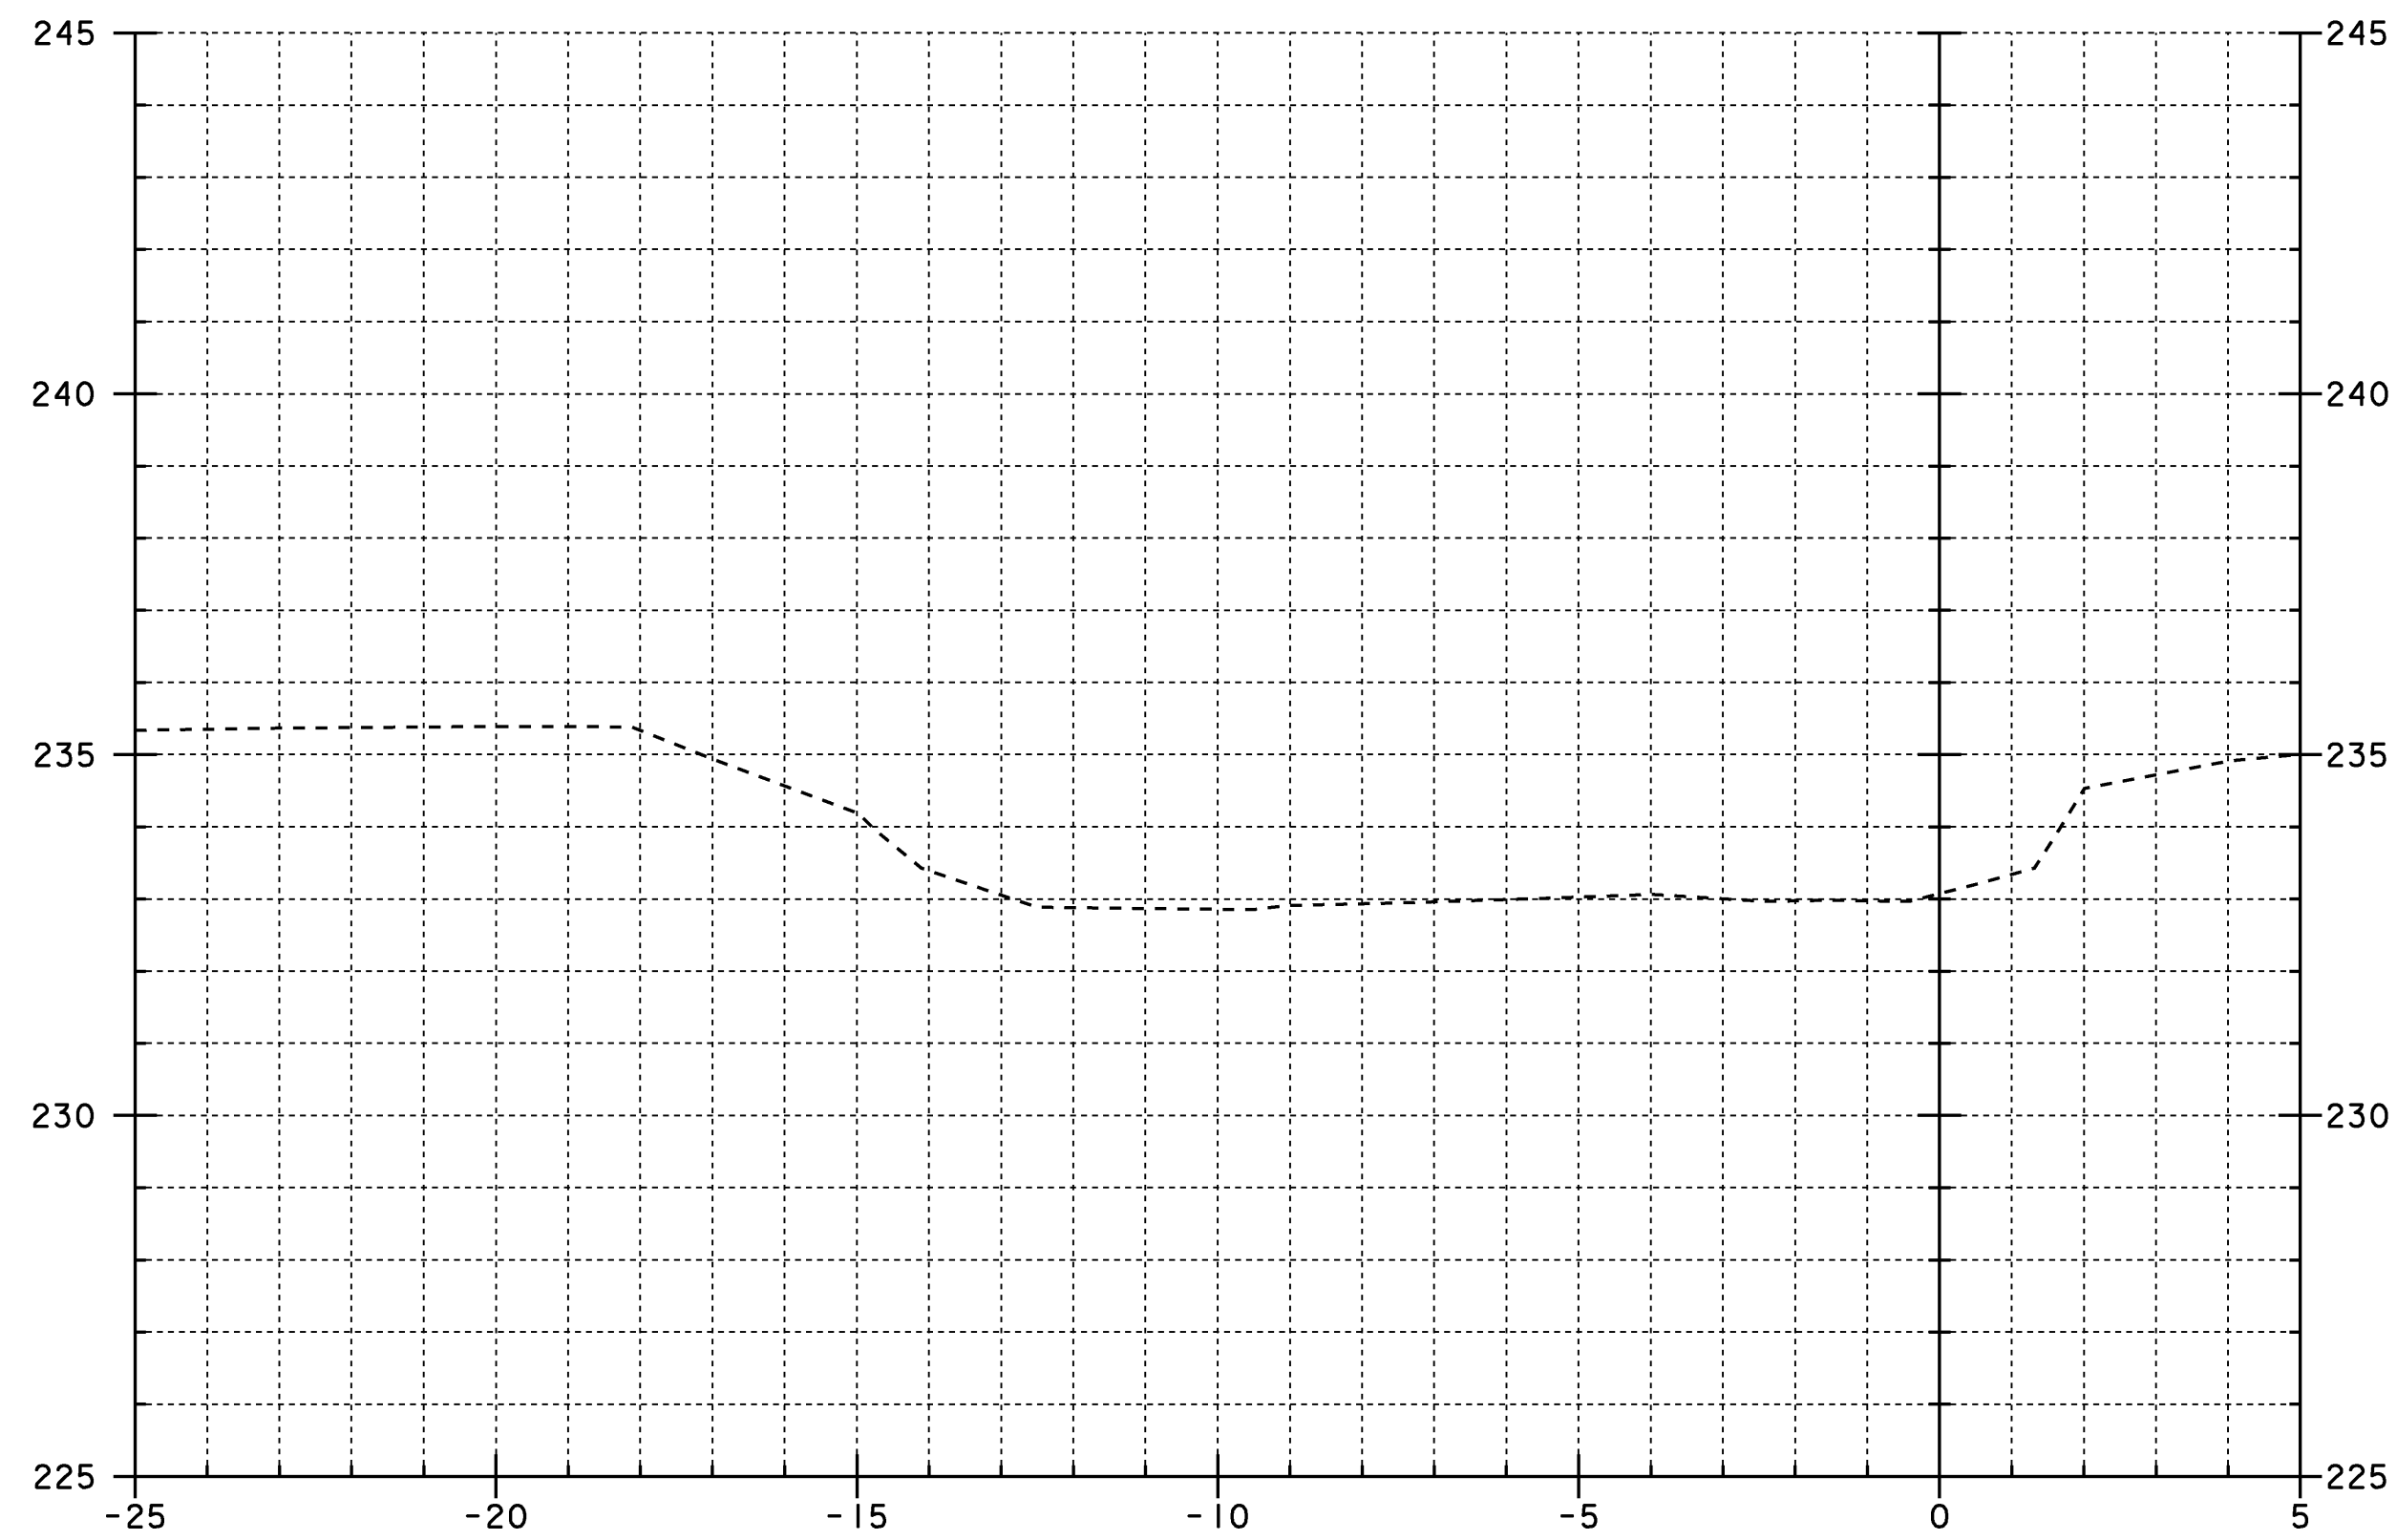

5+025

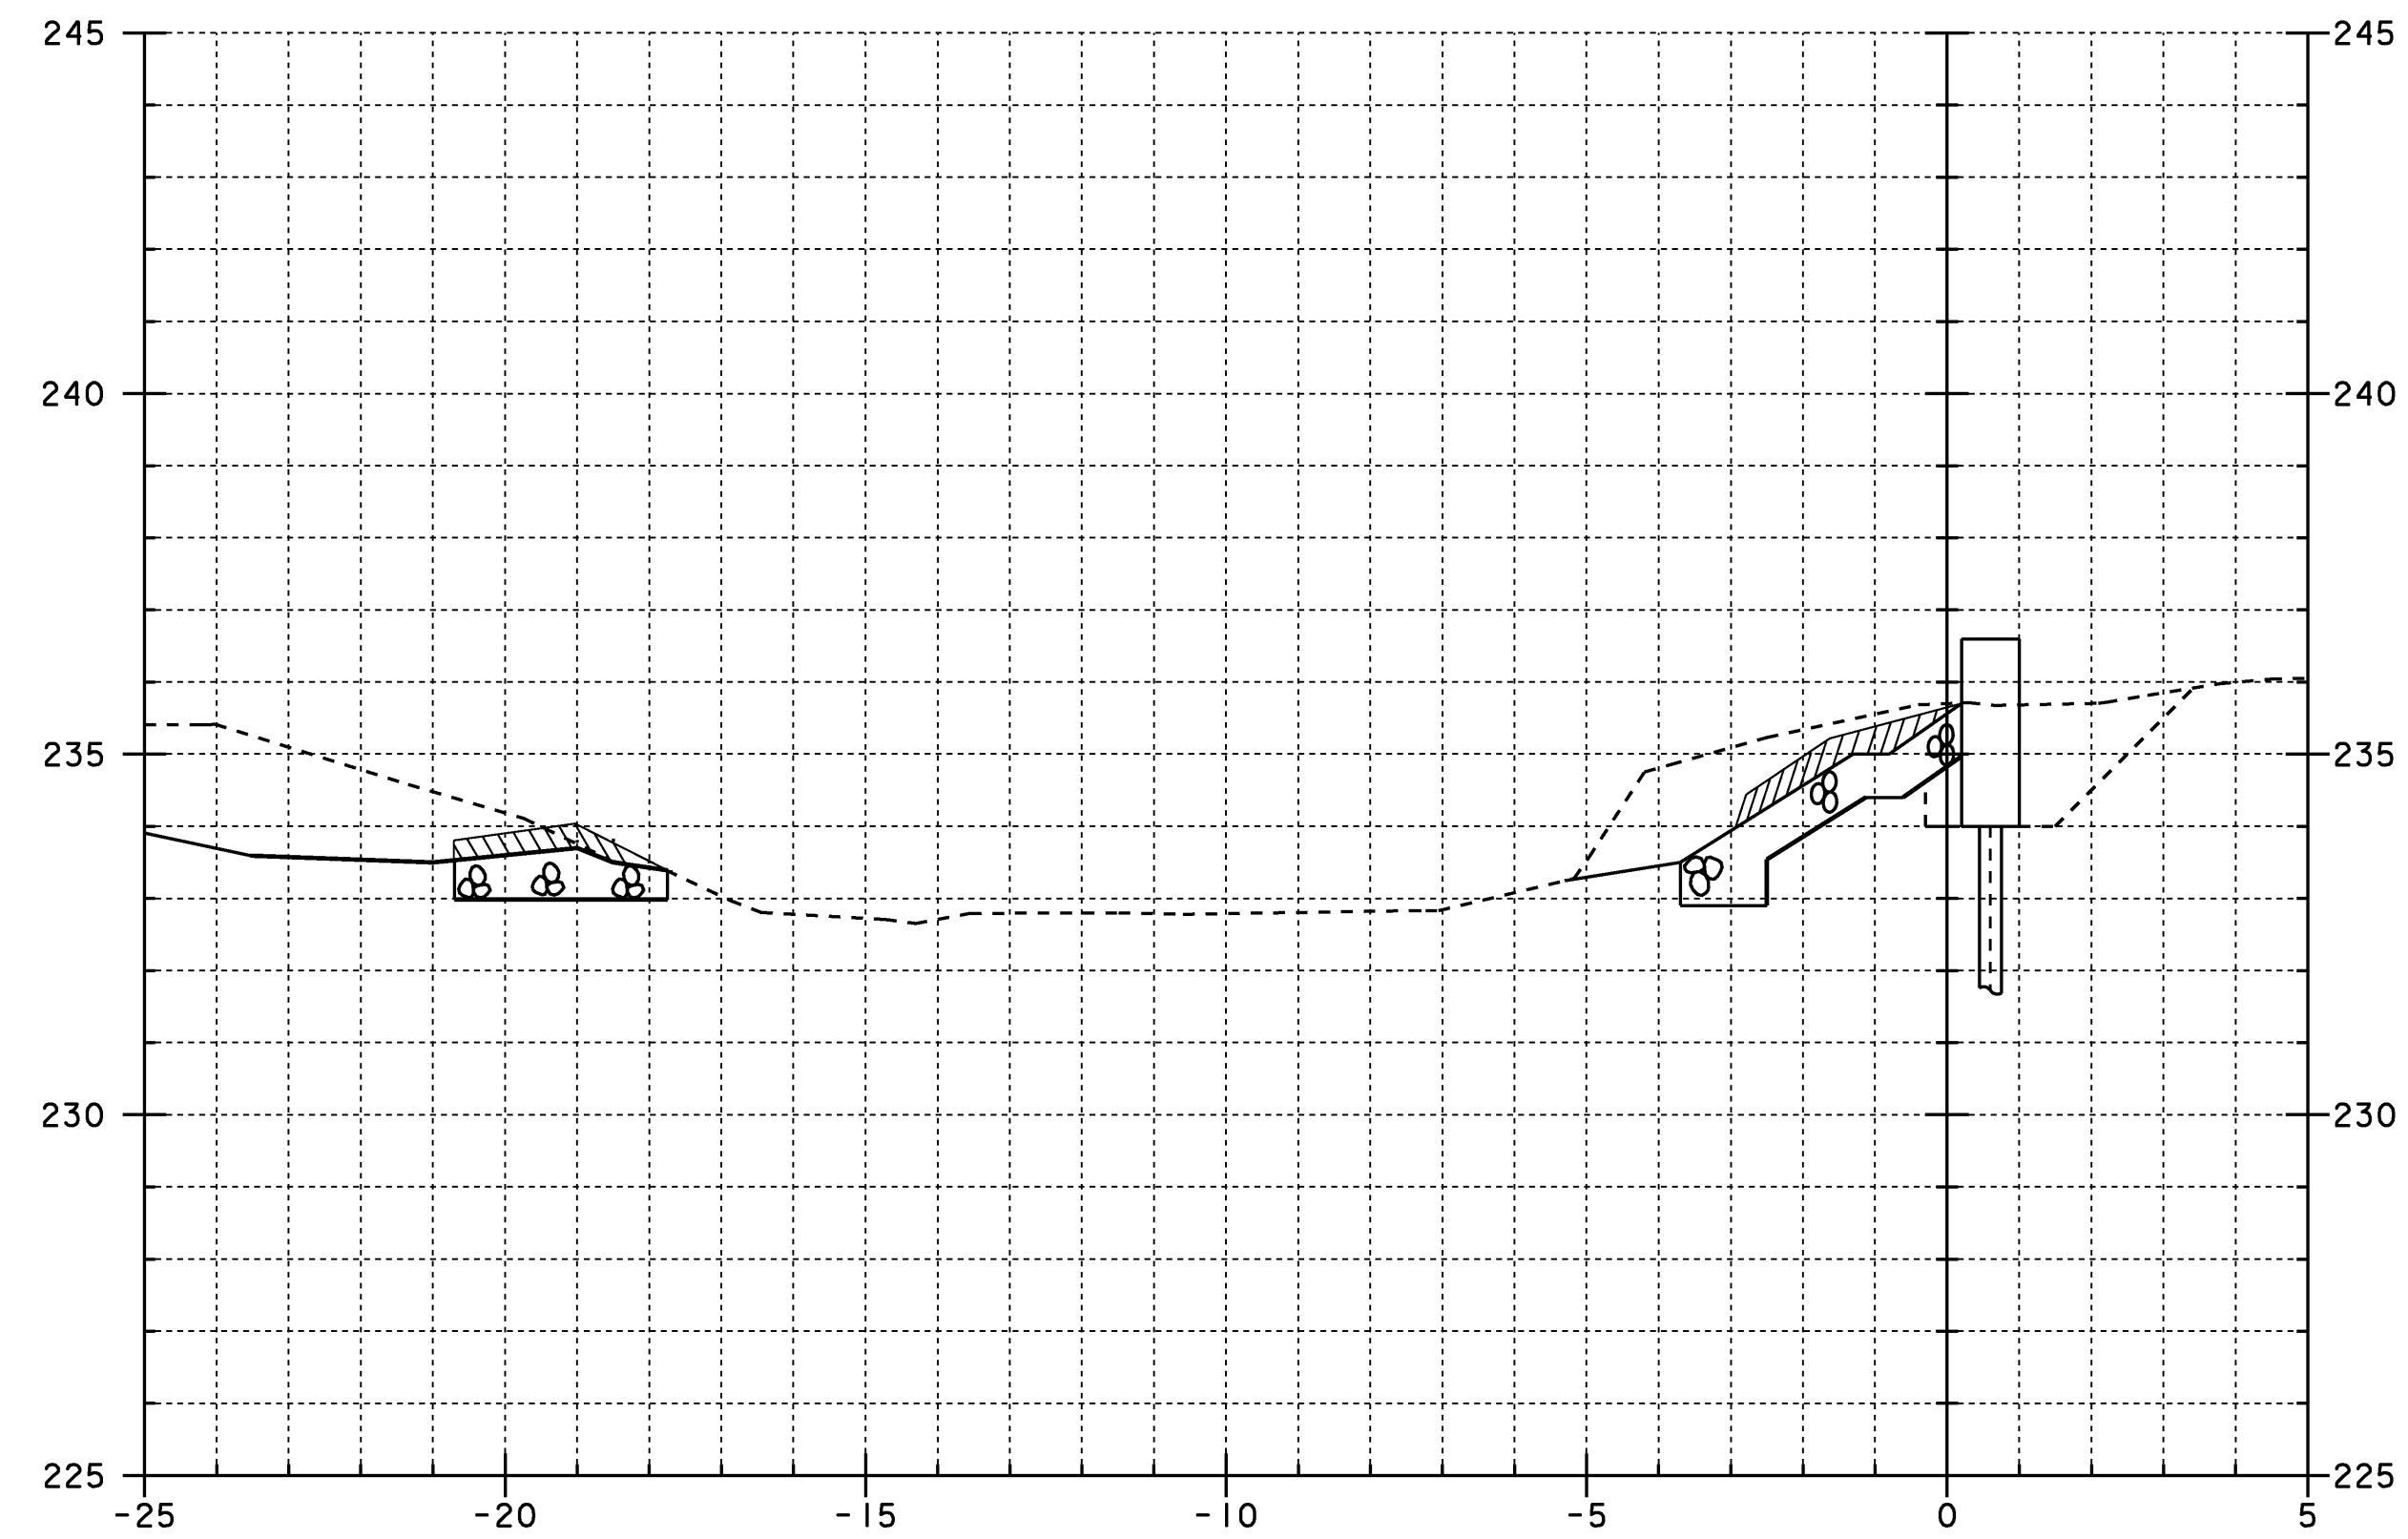


STA. 5+034.000 FAR LEFT 5+035


BEGIN STONE FILL TYPE II
BEGIN GRUBBING MATERIAL
BEGIN GEOTEXTILE UNDER STONE FILL
BEGIN UNCLASSIFIED CHANNEL EXCAVATION

STA. 5+031.000 LEFT

BEGIN STONE FILL TYPE II
BEGIN GRUBBING MATERIAL
BEGIN GEOTEXTILE UNDER STONE FILL
BEGIN UNCLASSIFIED CHANNEL EXCAVATION

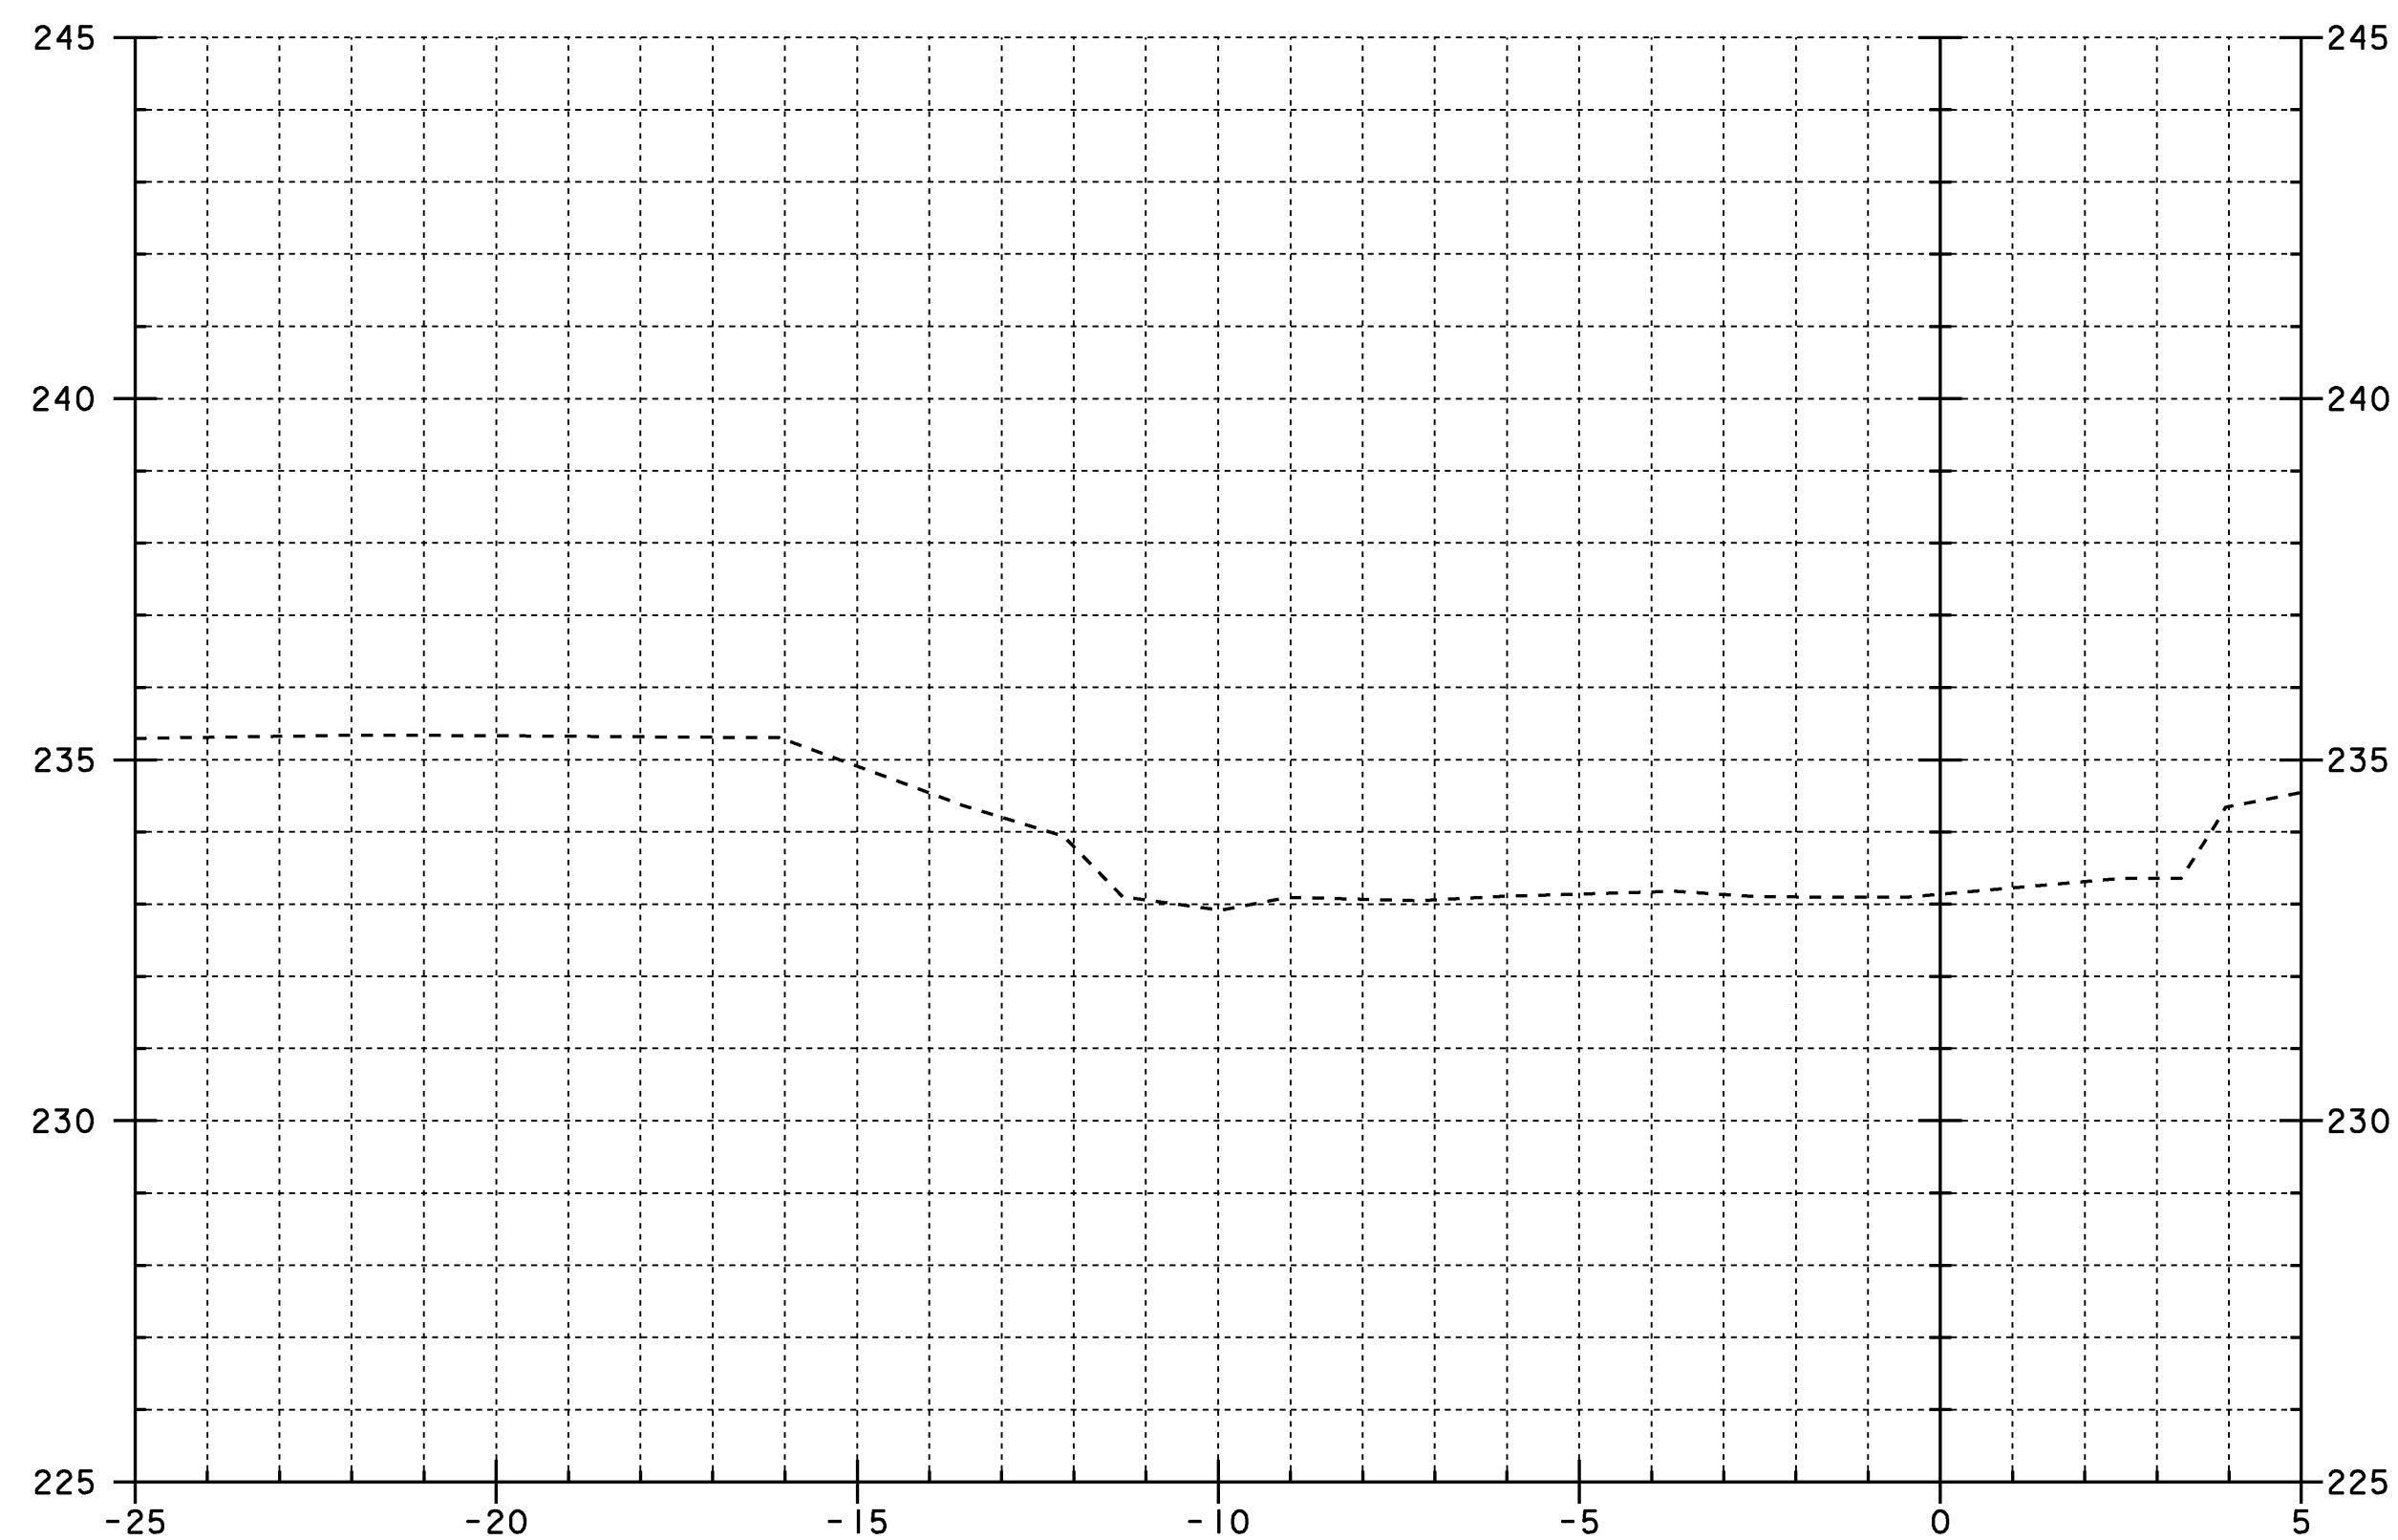

5+020

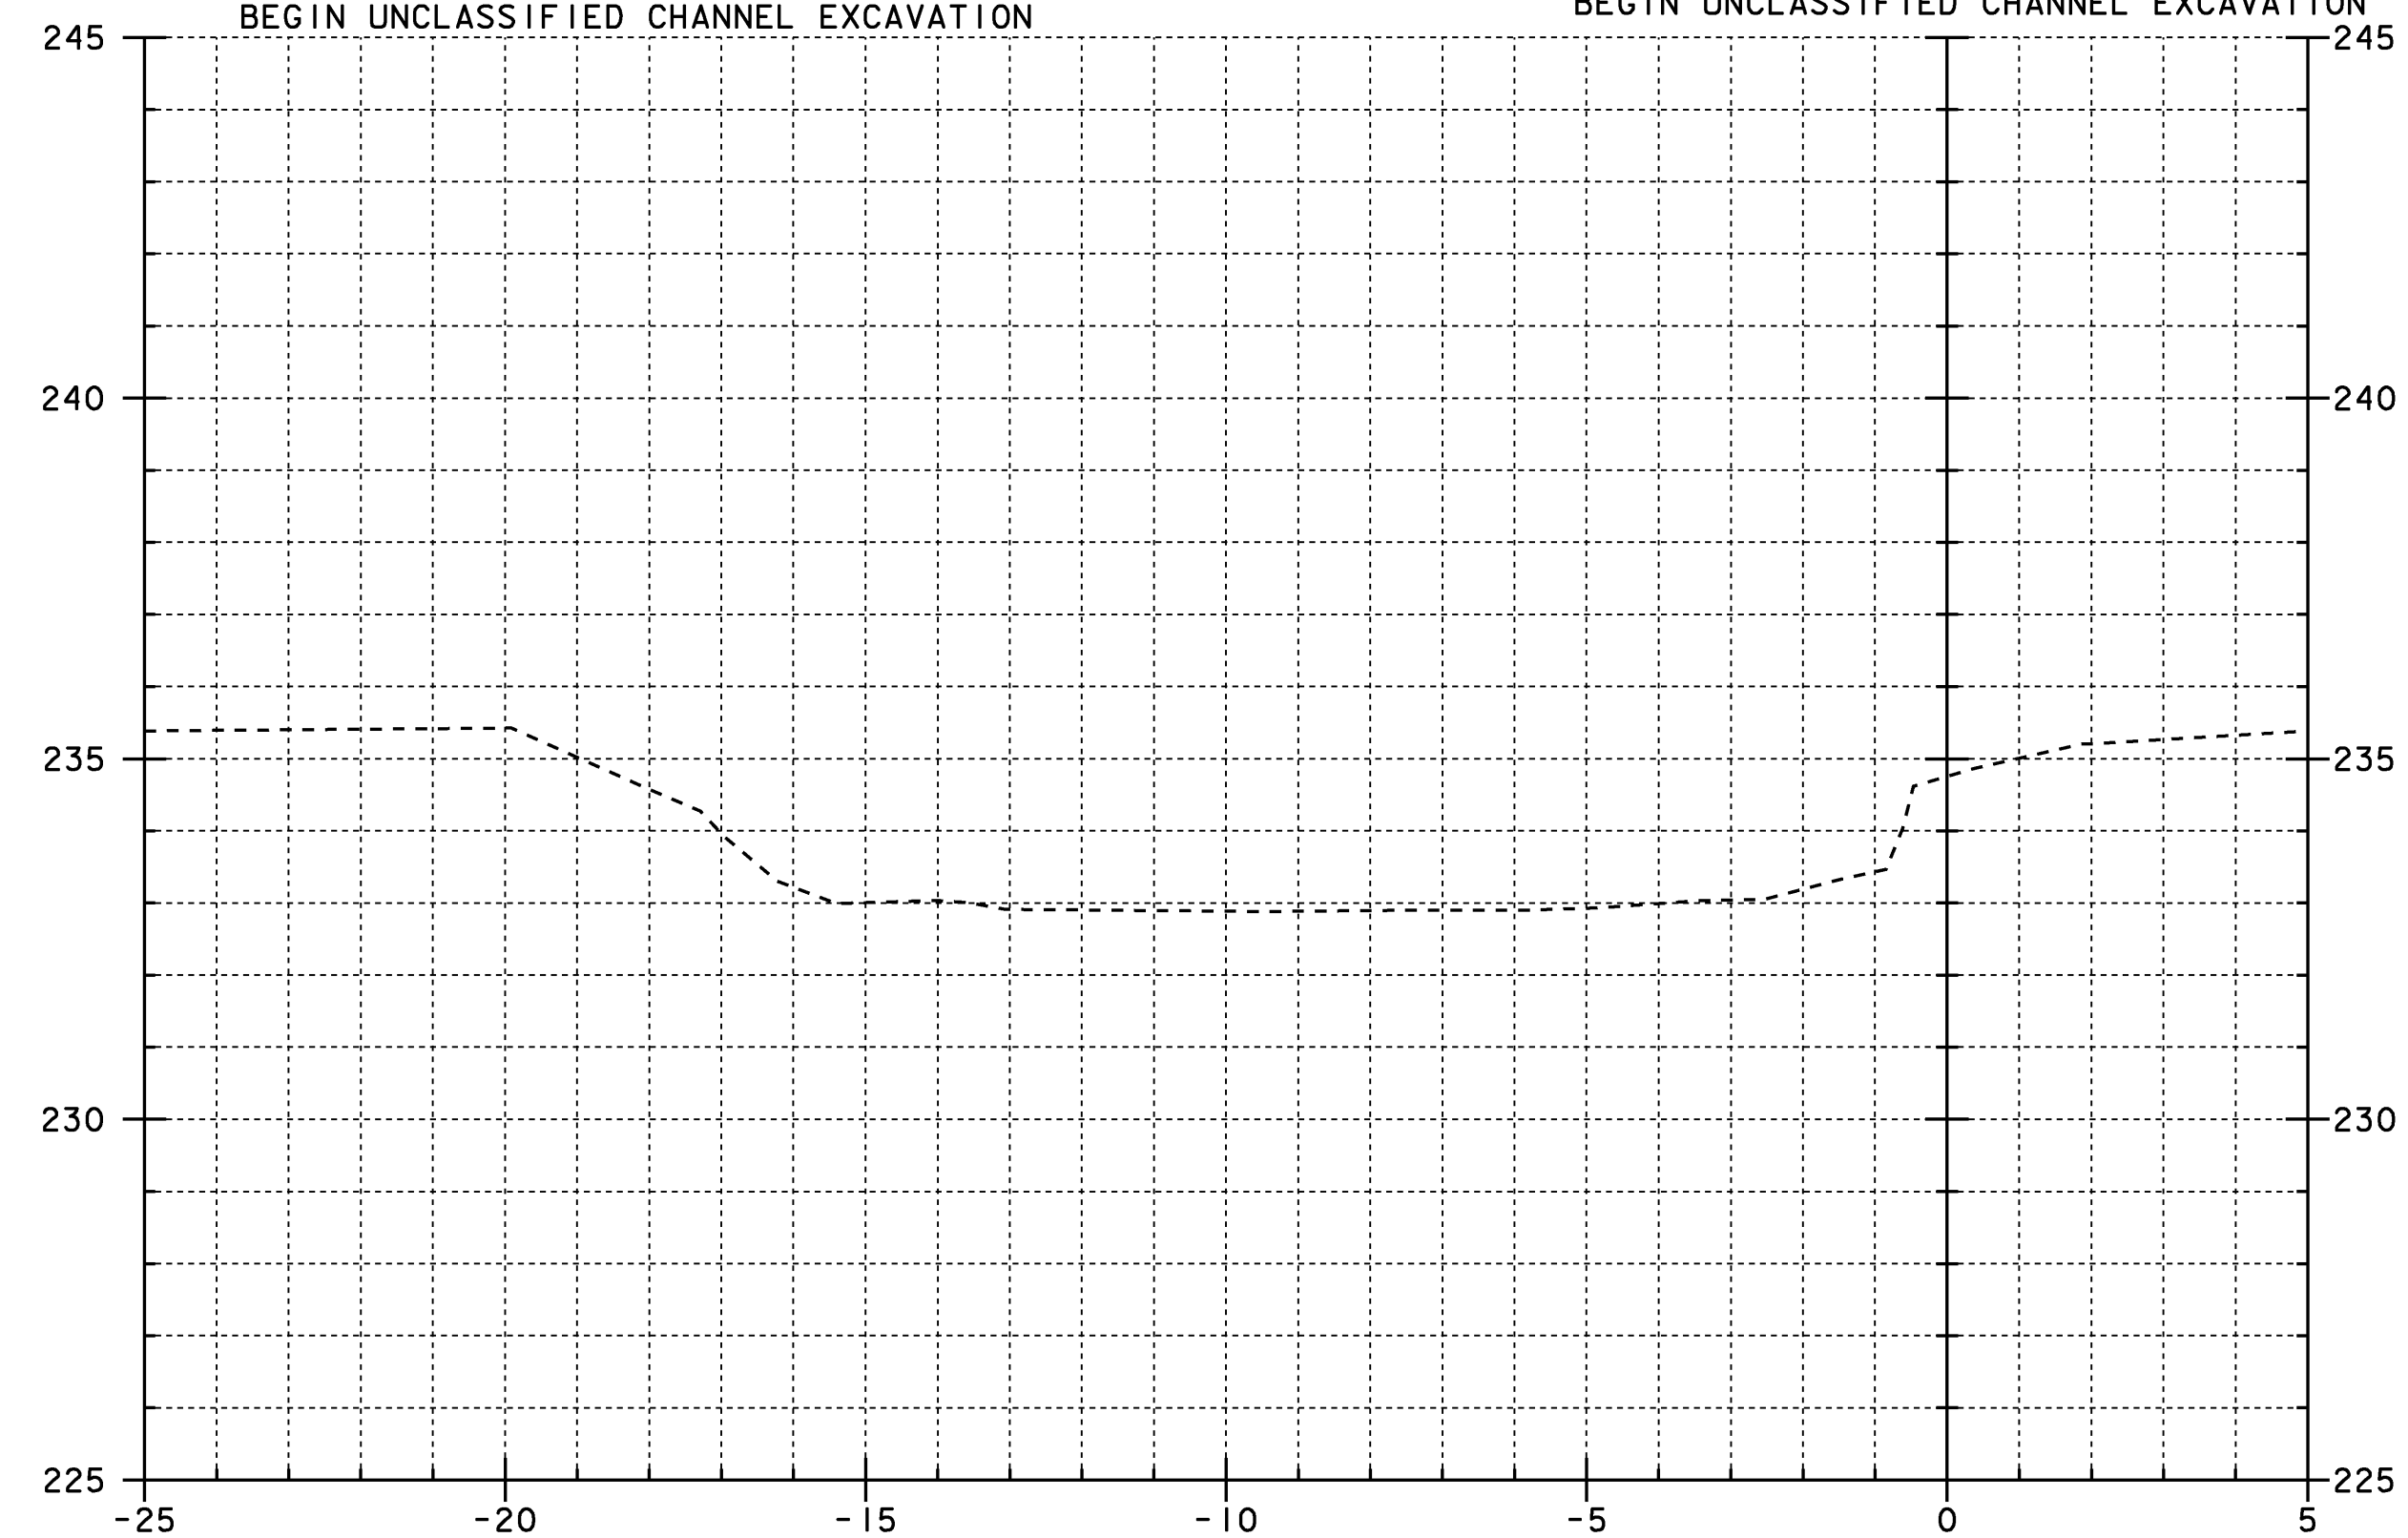

5+030



PROJECT: CORINTH	PROJECT NO.: STP BRO 1447 (22) (RE-ADVERTISED)
DESIGN FILE NAME: sj042xs2.dgn IPARM FILE NAME: sj042c2.i	PLOT DATE: 16-JUL-2008
CHANNEL LINE SECTIONS 5+020 TO 5+035	SHEET: 40 OF 42