

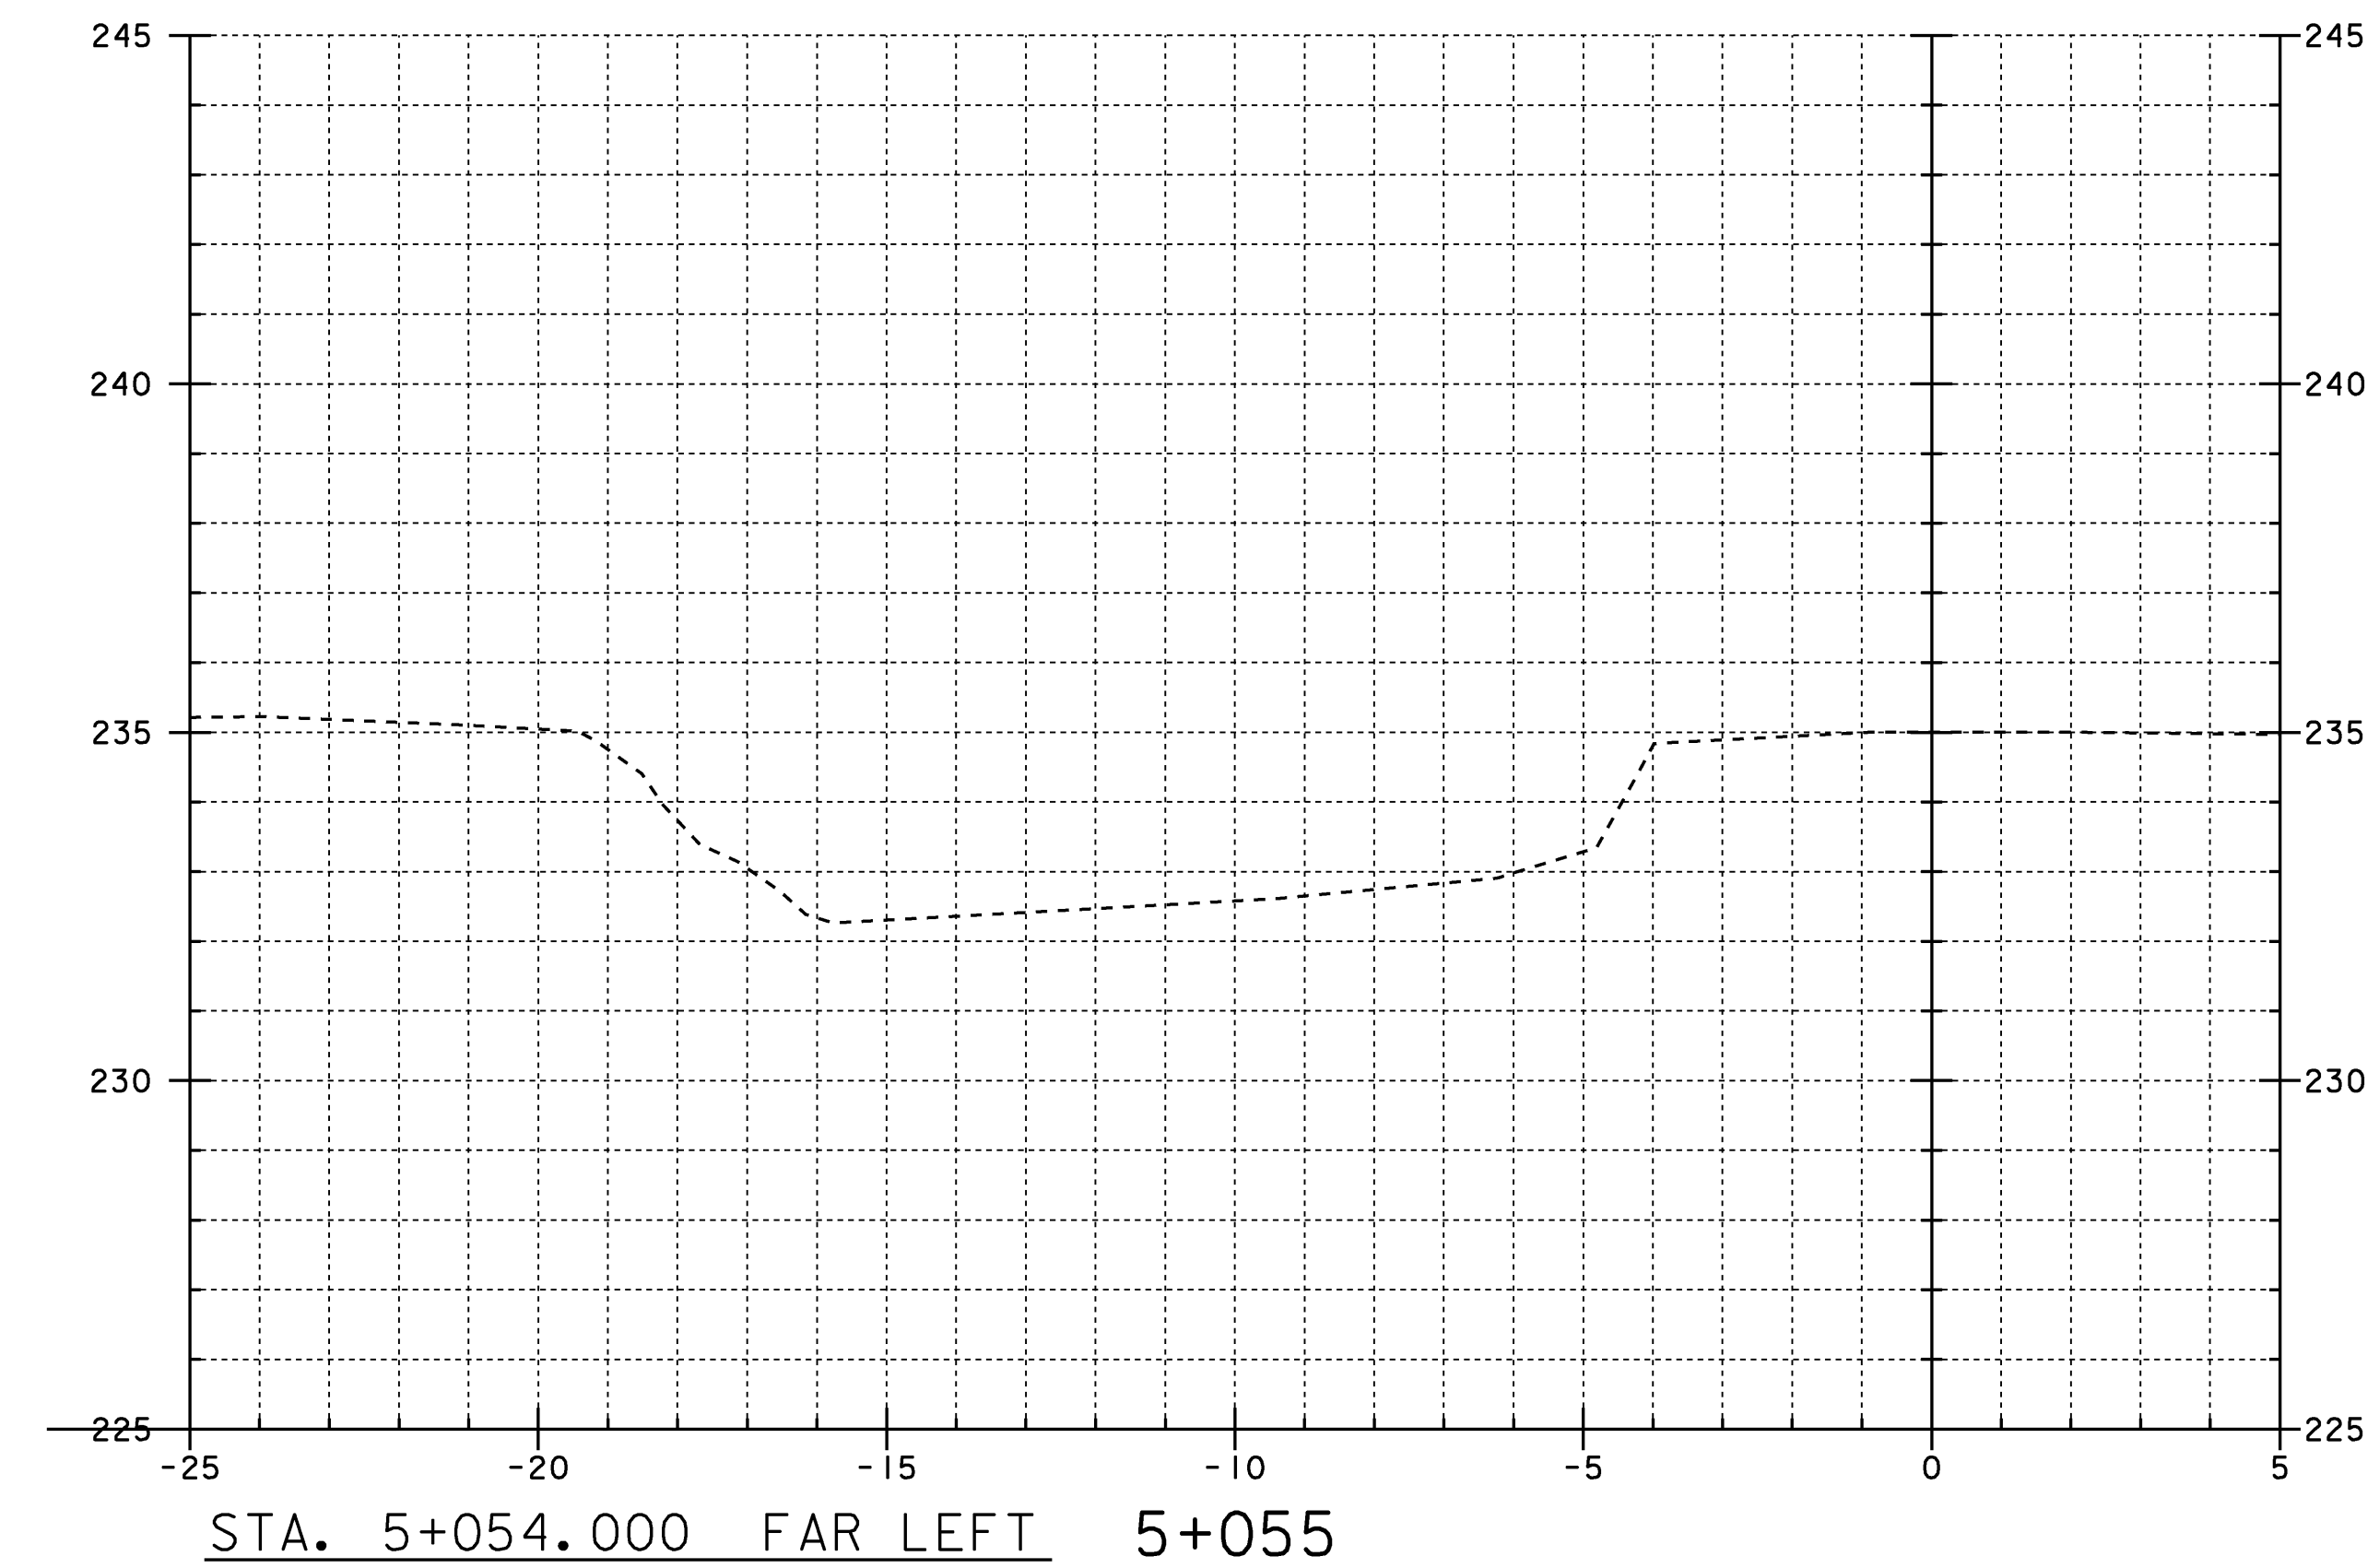
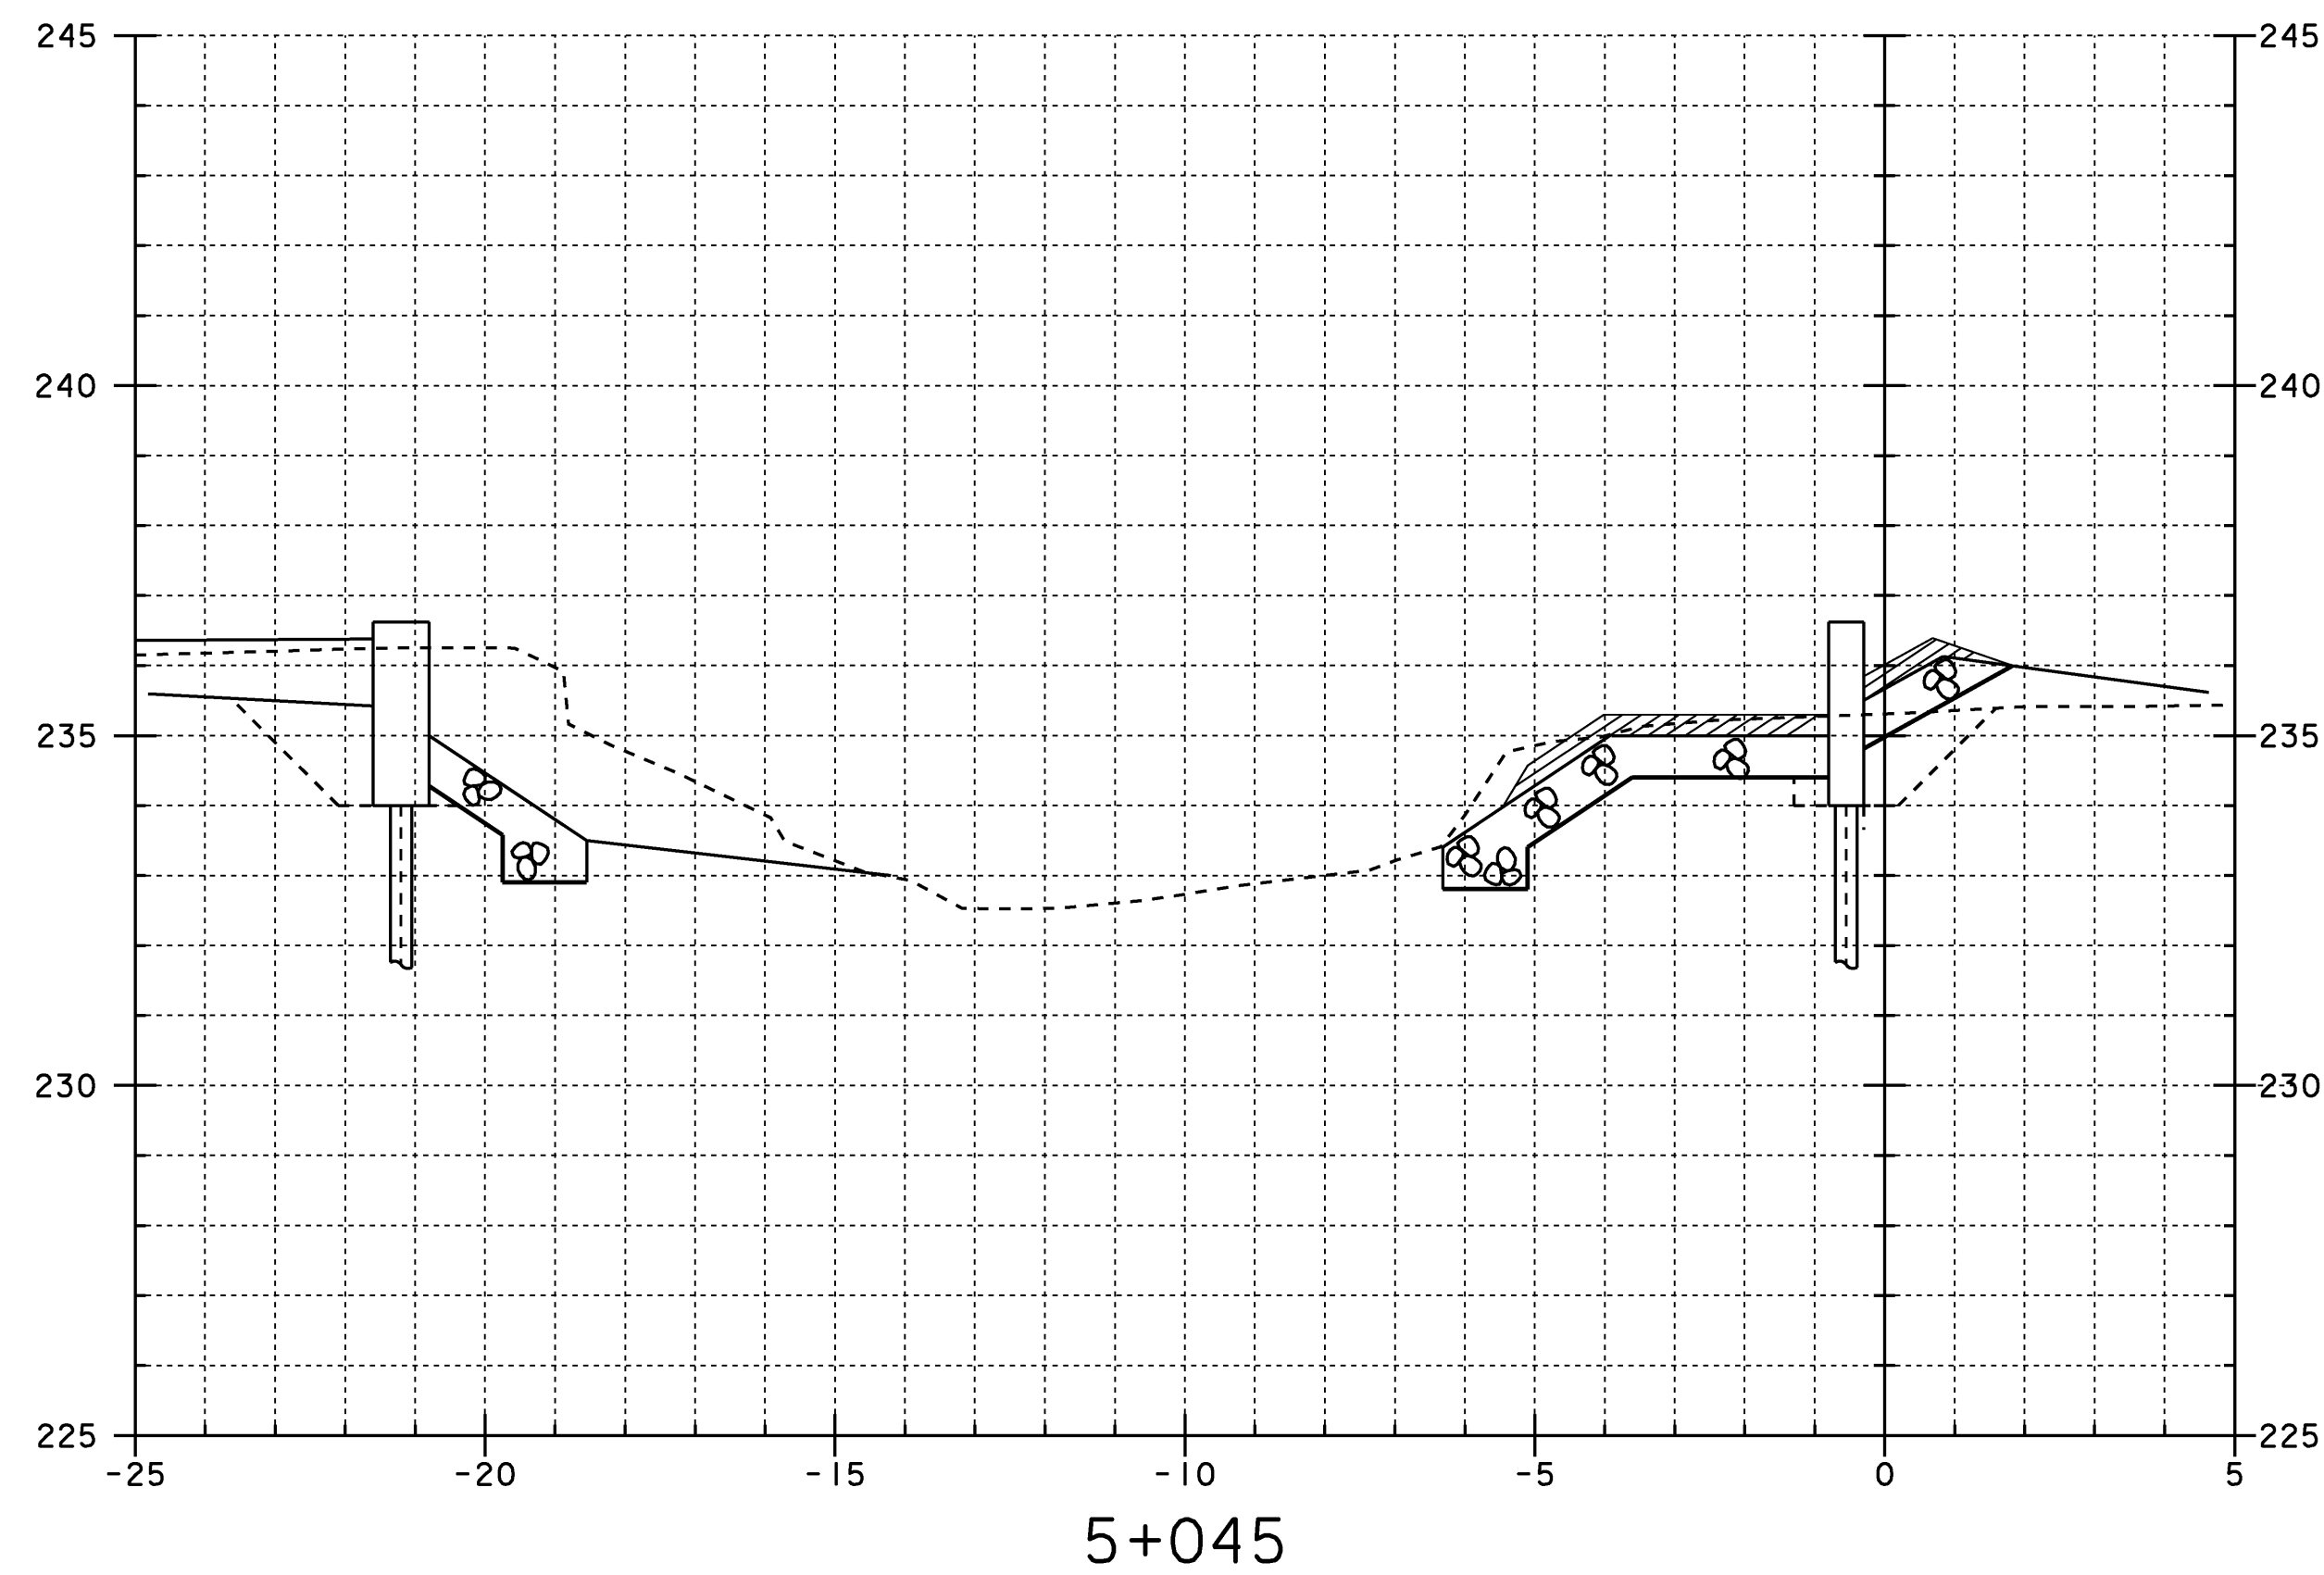


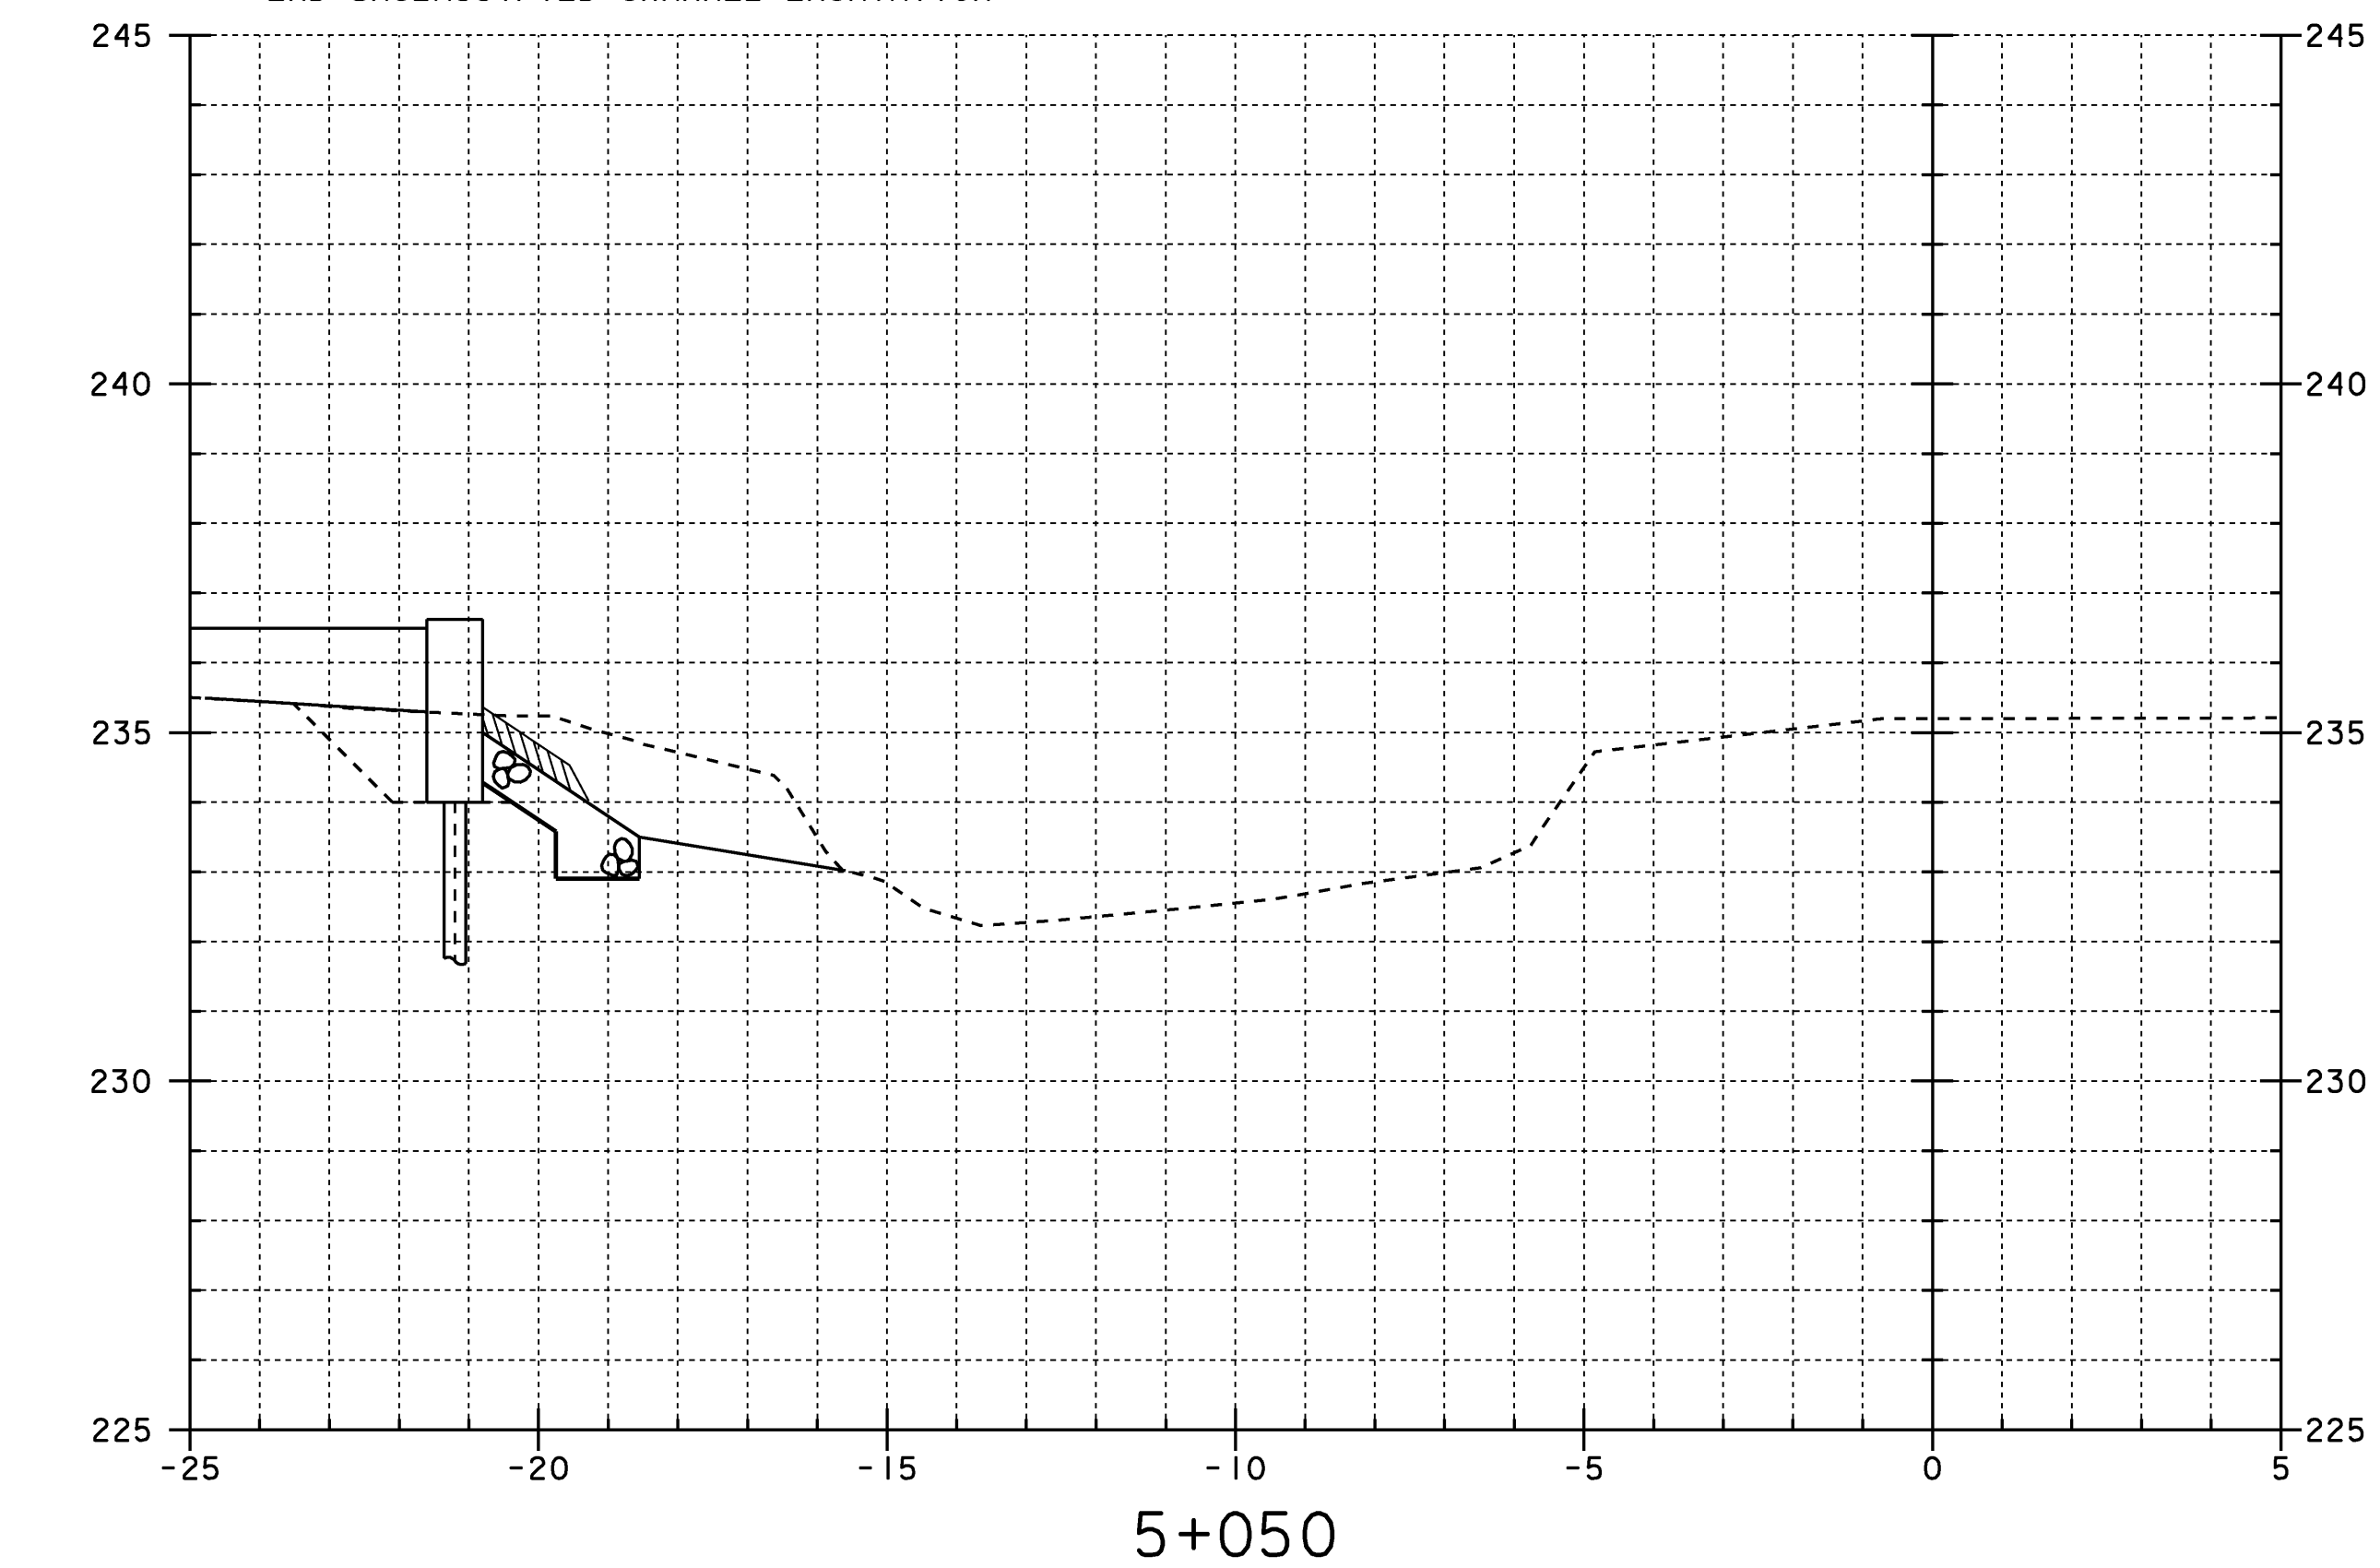

END STONE FILL TYPE II
END GRUBBING MATERIAL
END GEOTEXTILE UNDER STONE FILL
END UNCLASSIFIED CHANNEL EXCAVATION

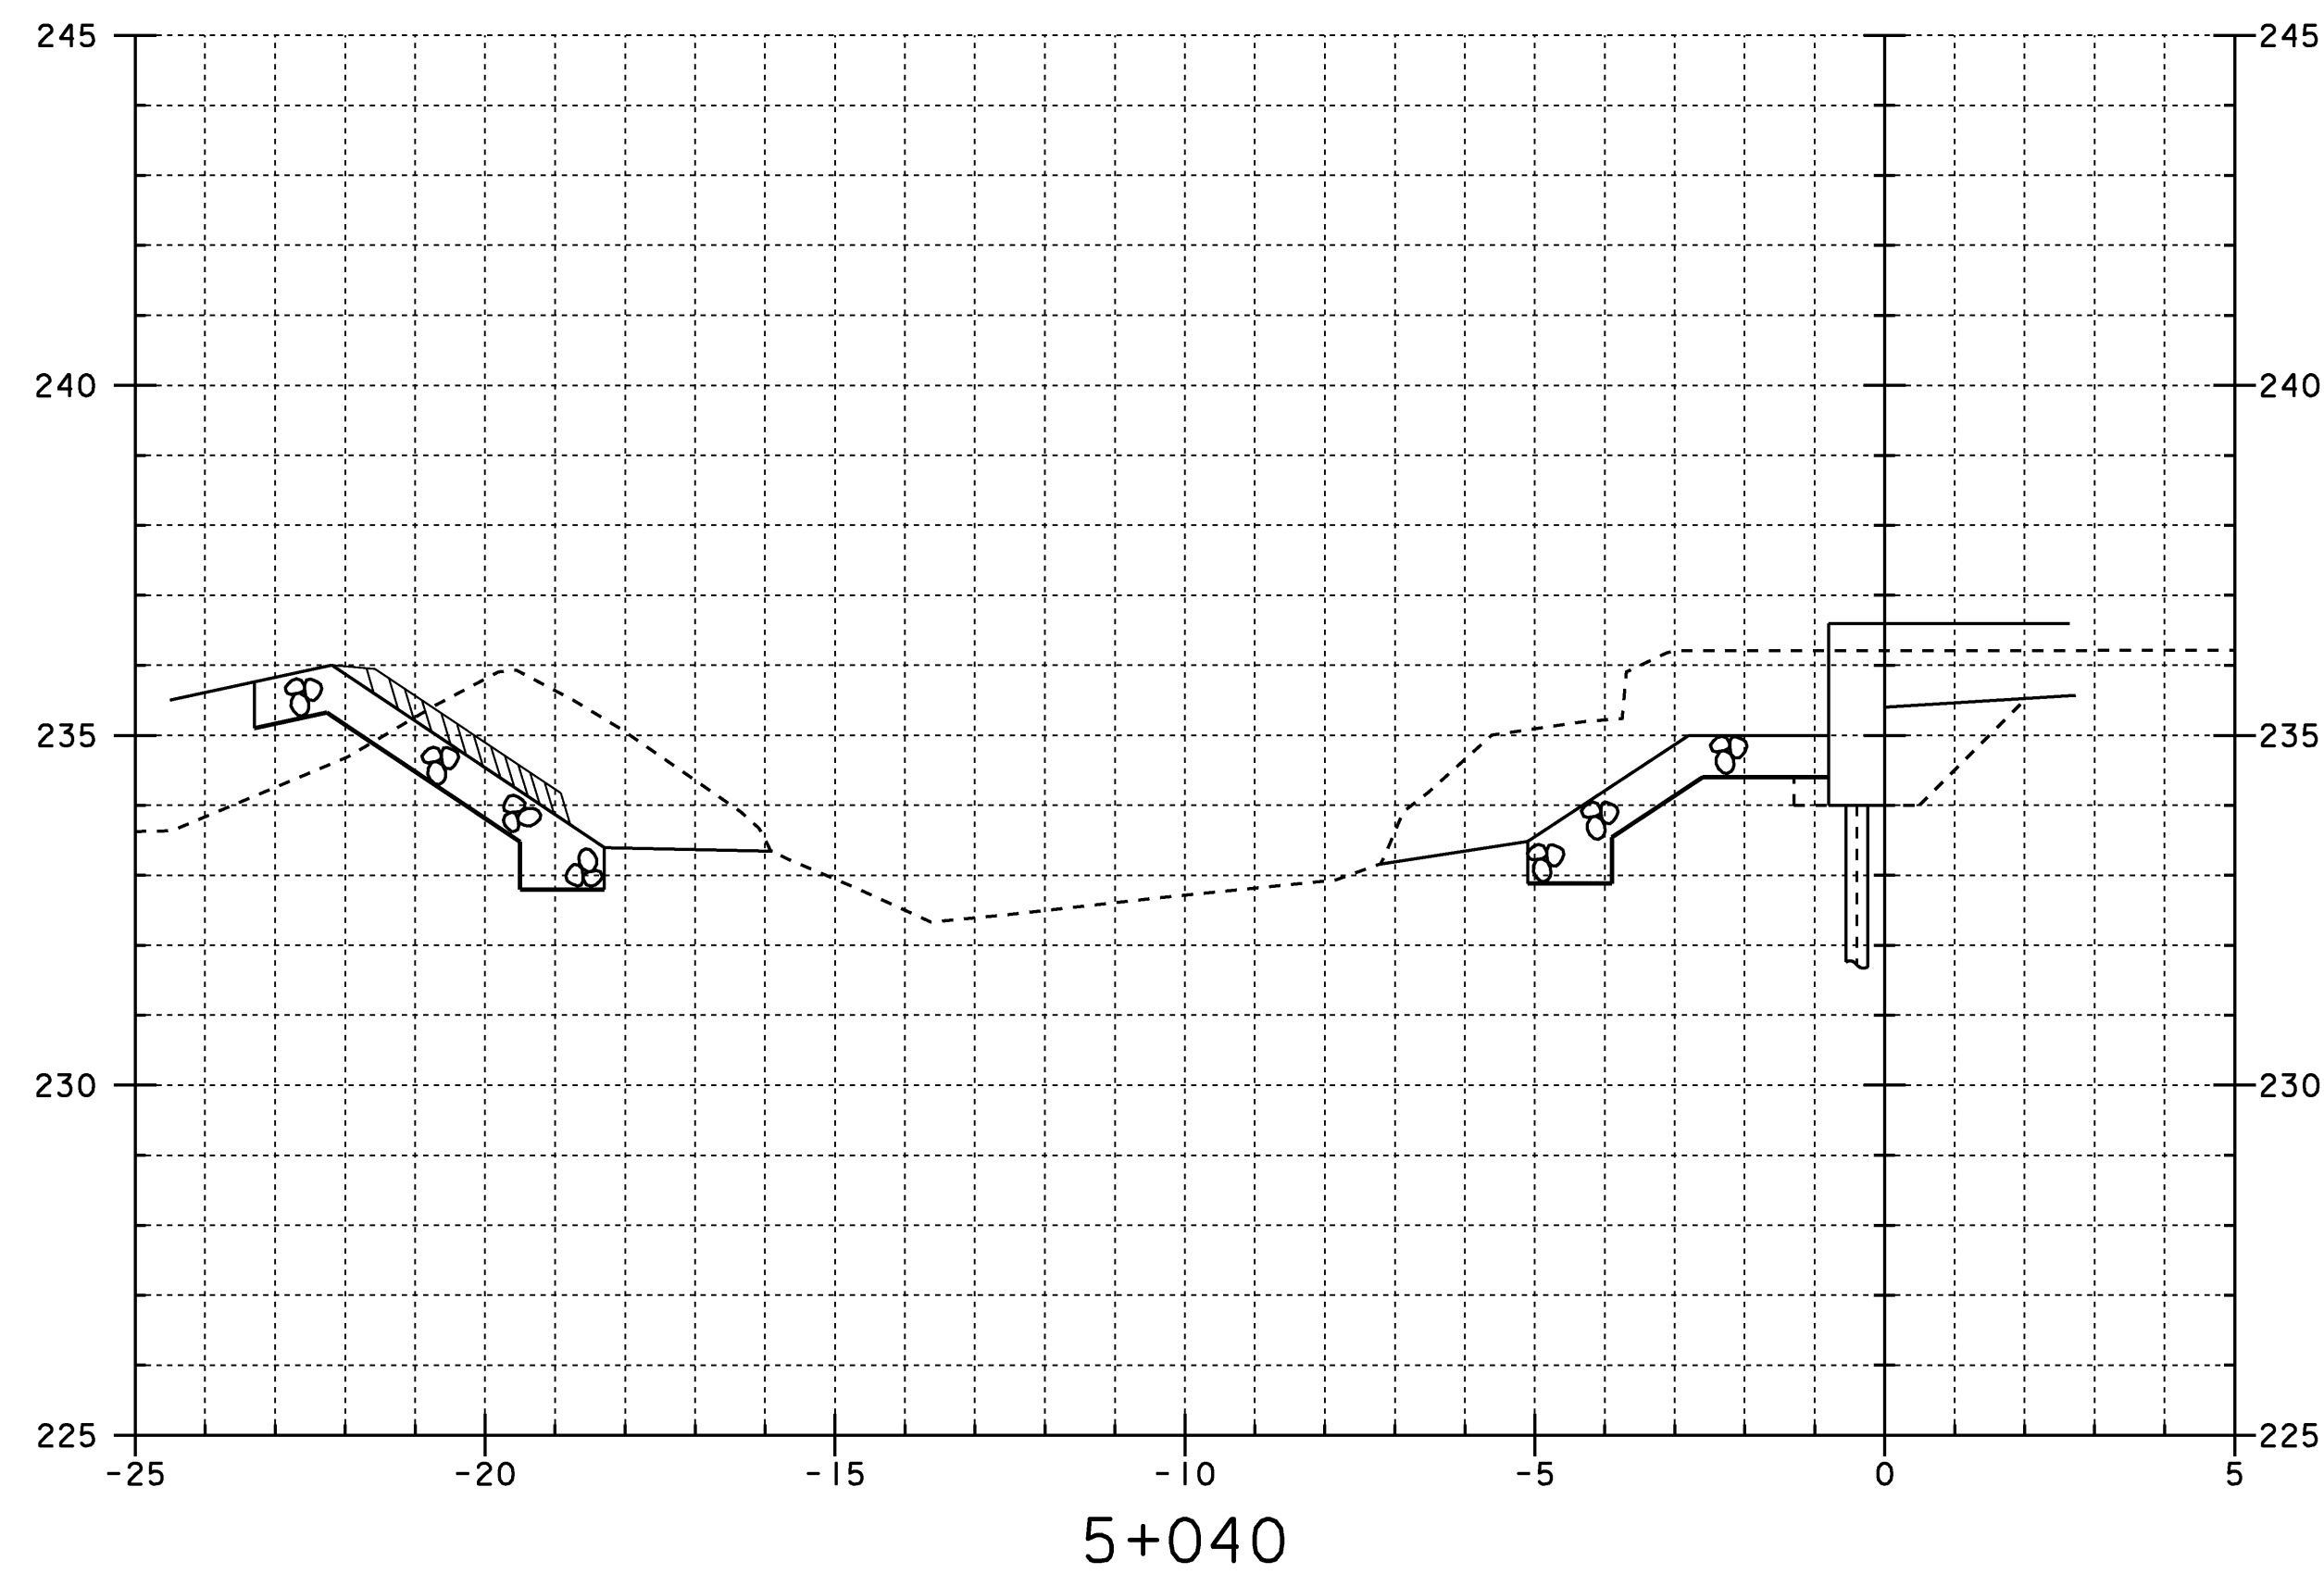

STA. 5+ 049.000 LEFT

END STONE FILL TYPE II
END GRUBBING MATERIAL
END GEOTEXTILE UNDER STONE FILL
END UNCLASSIFIED CHANNEL EXCAVATION



PROJECT: CORINTH	PROJECT NO.: STP BRO 1447 (22) (RE-ADVERTISED)
DESIGN FILE NAME: sj042xs2.dgn IPARM FILE NAME: sj042c3.i	PLOT DATE: 16-JUL-2008
CHANNEL LINE SECTIONS 5+040 TO 5+055	SHEET: 41 OF 42