
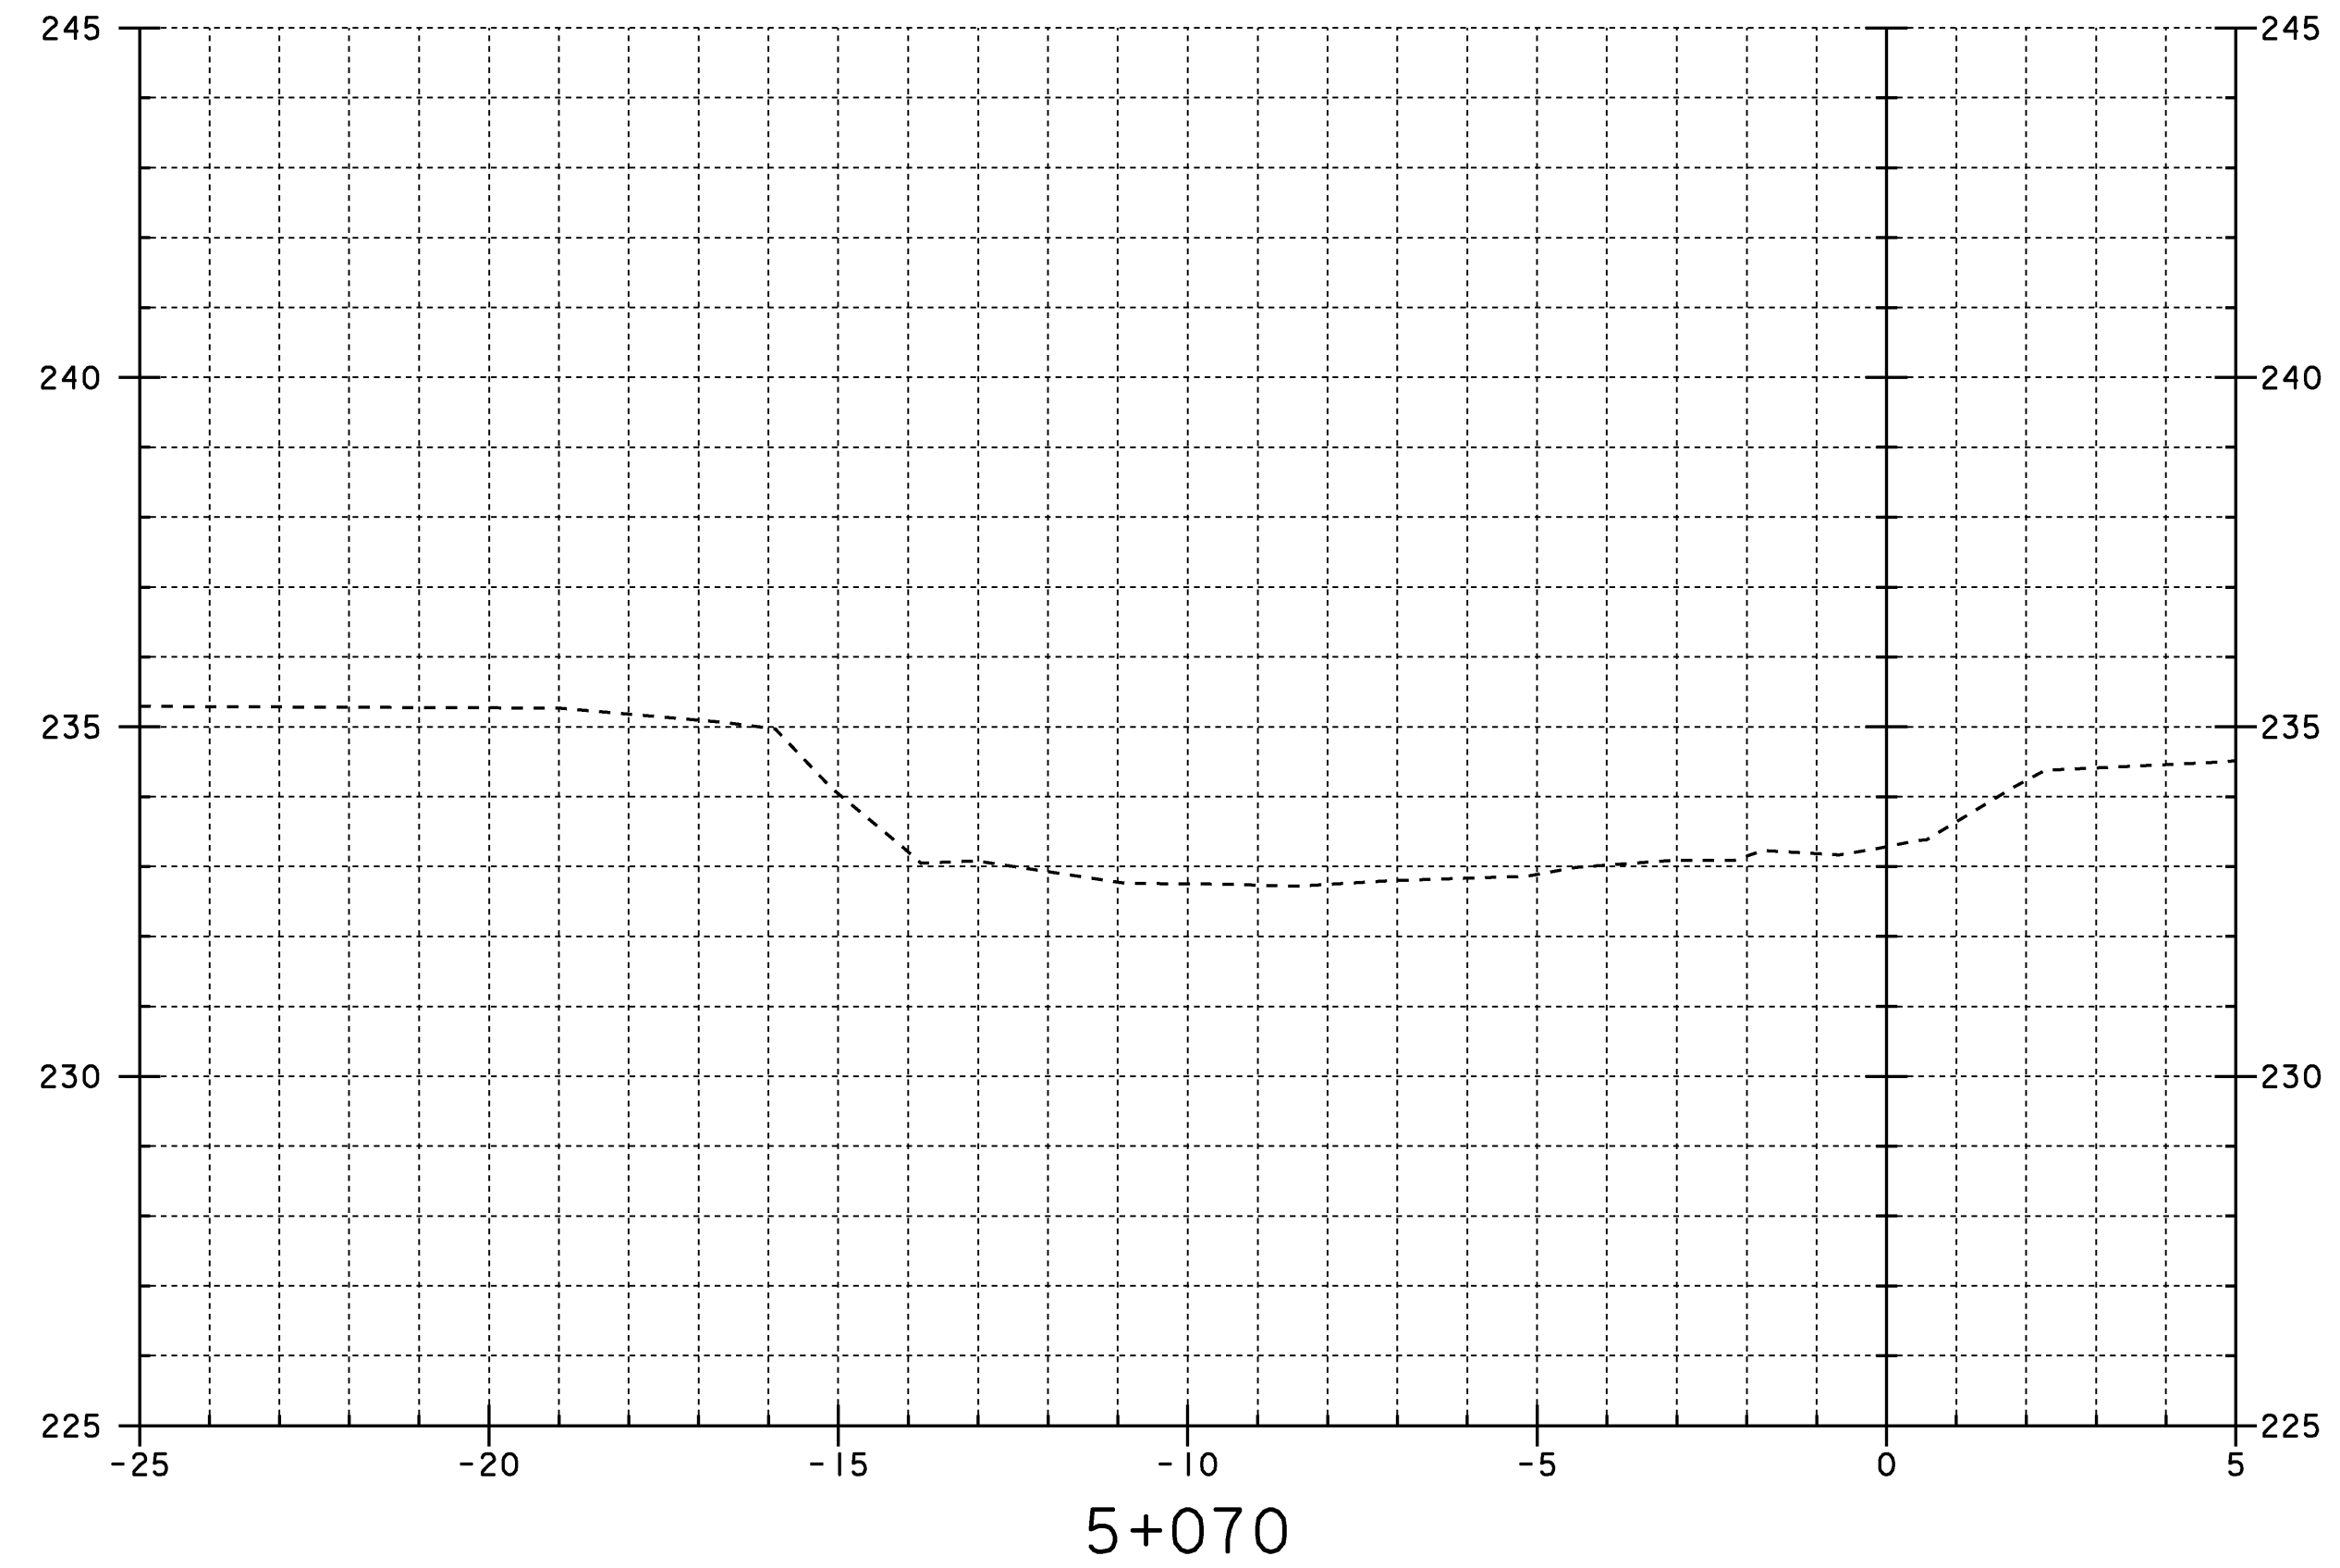
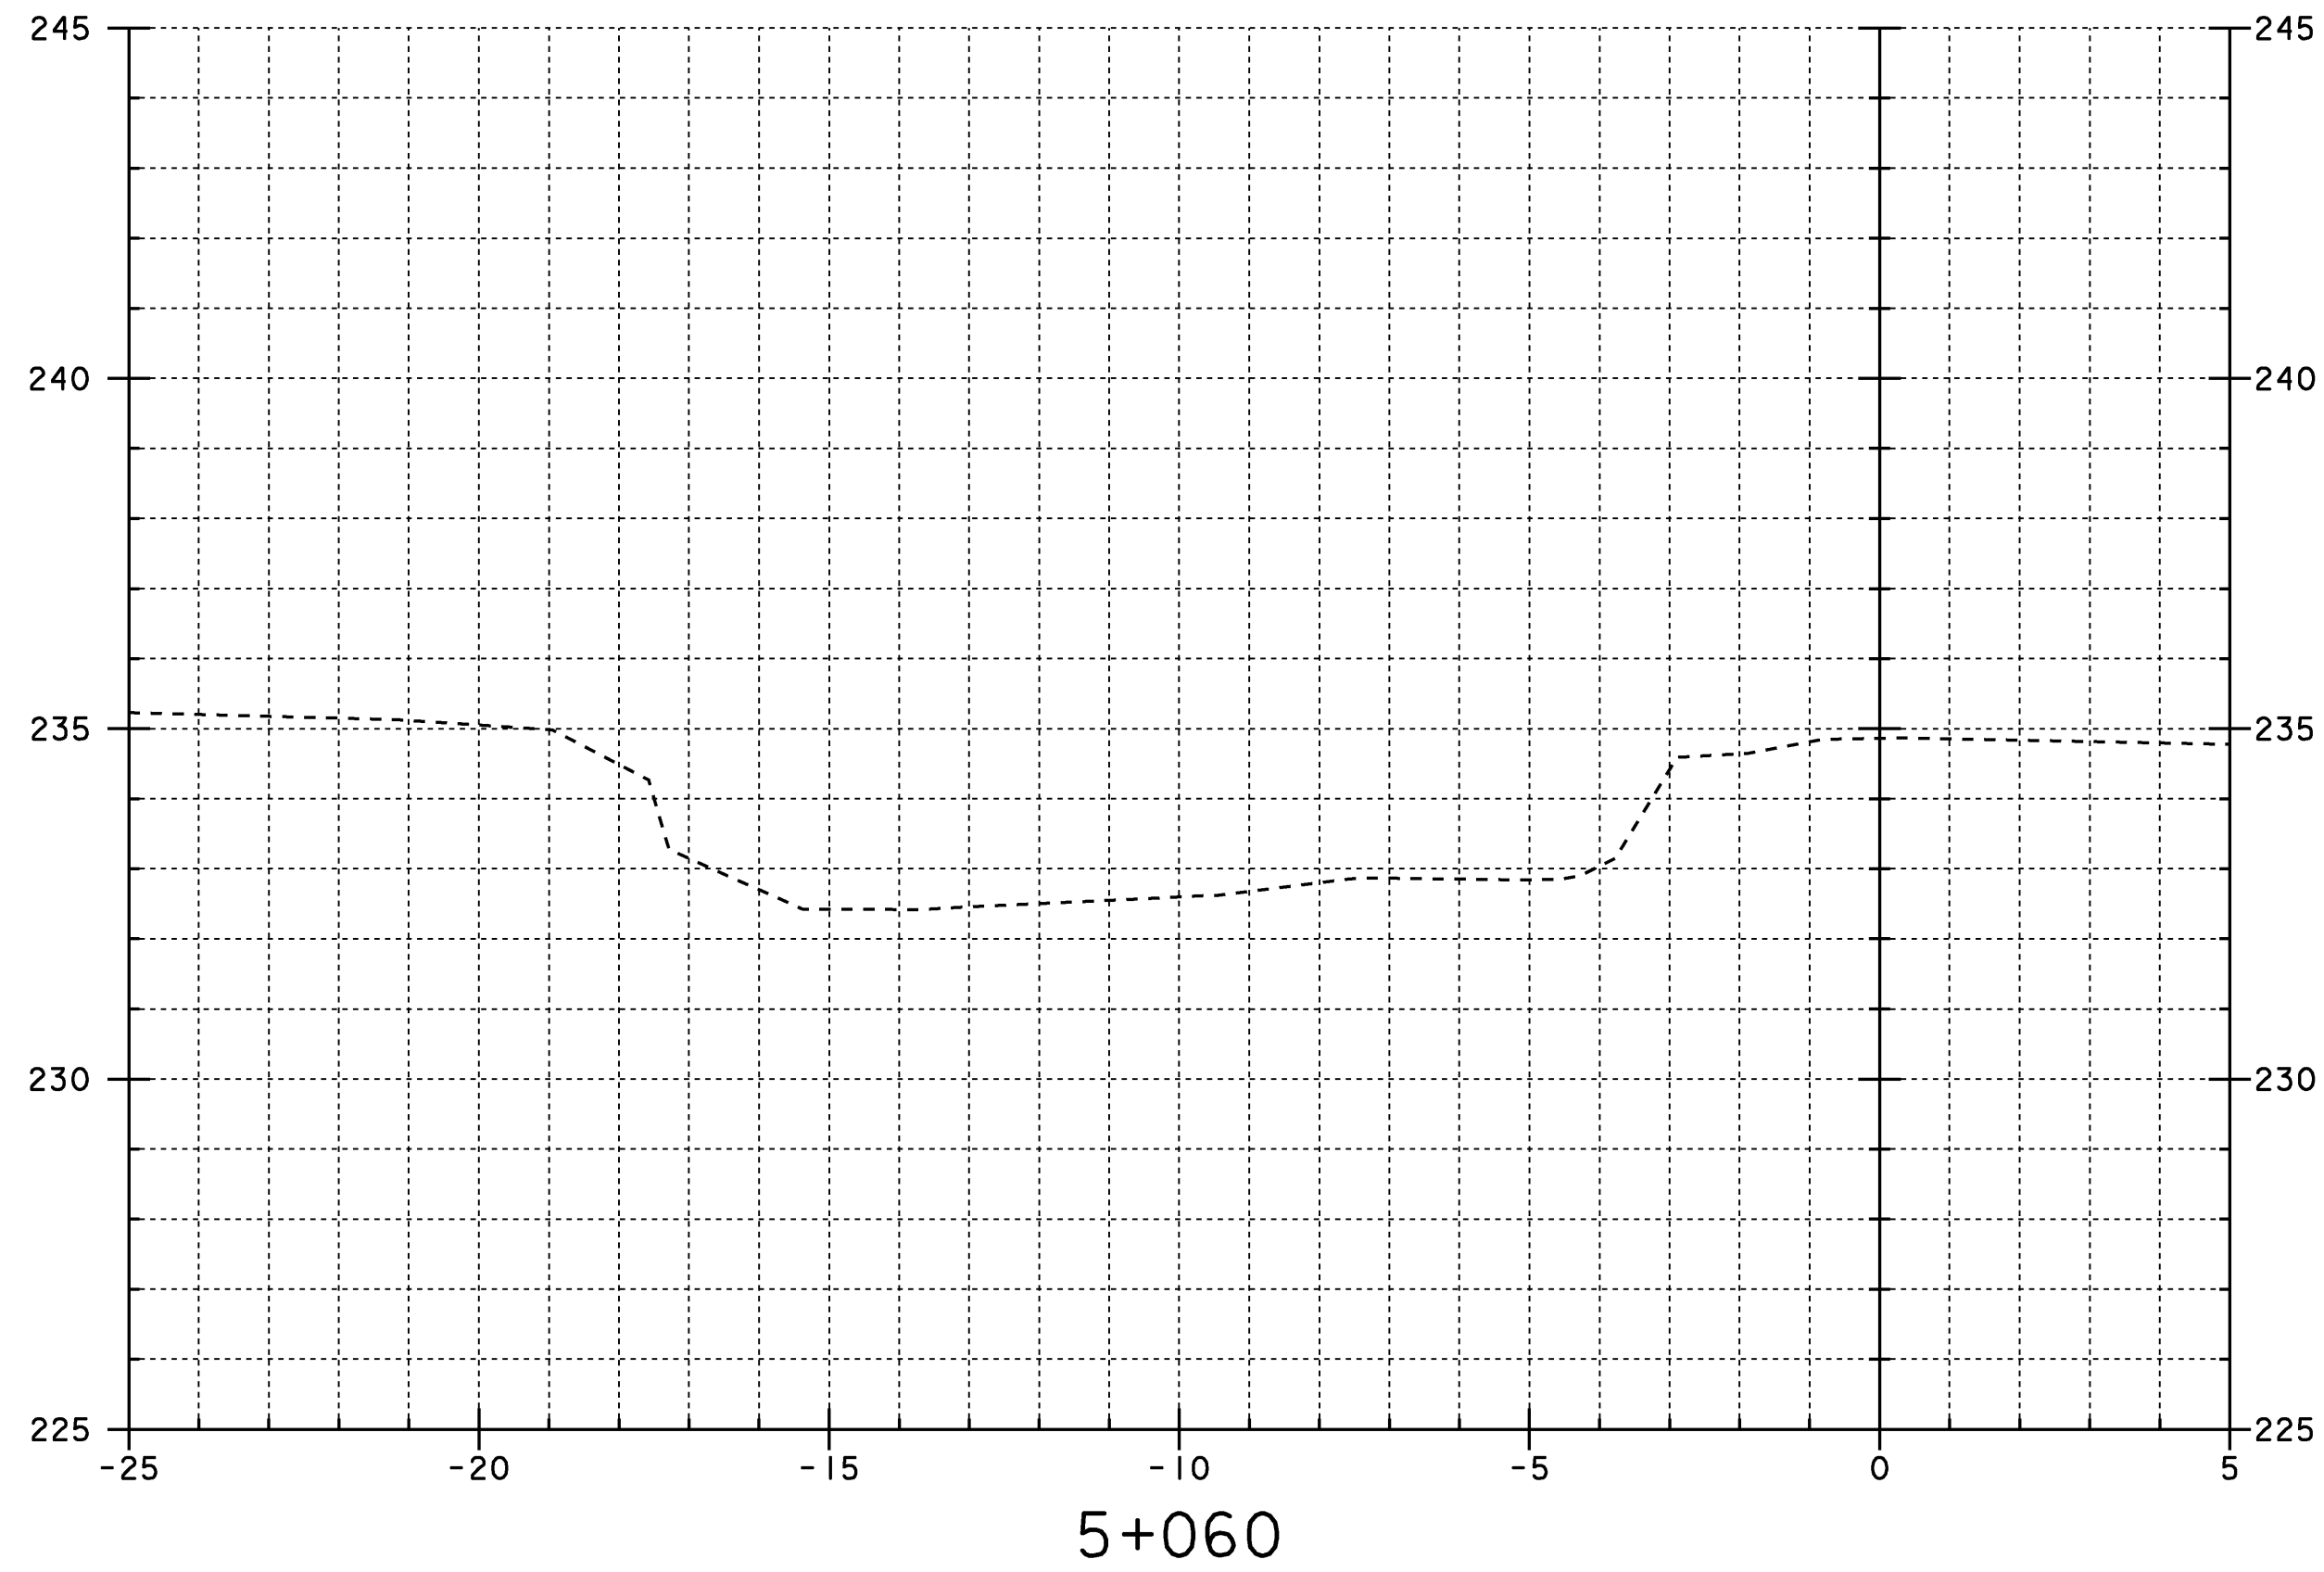
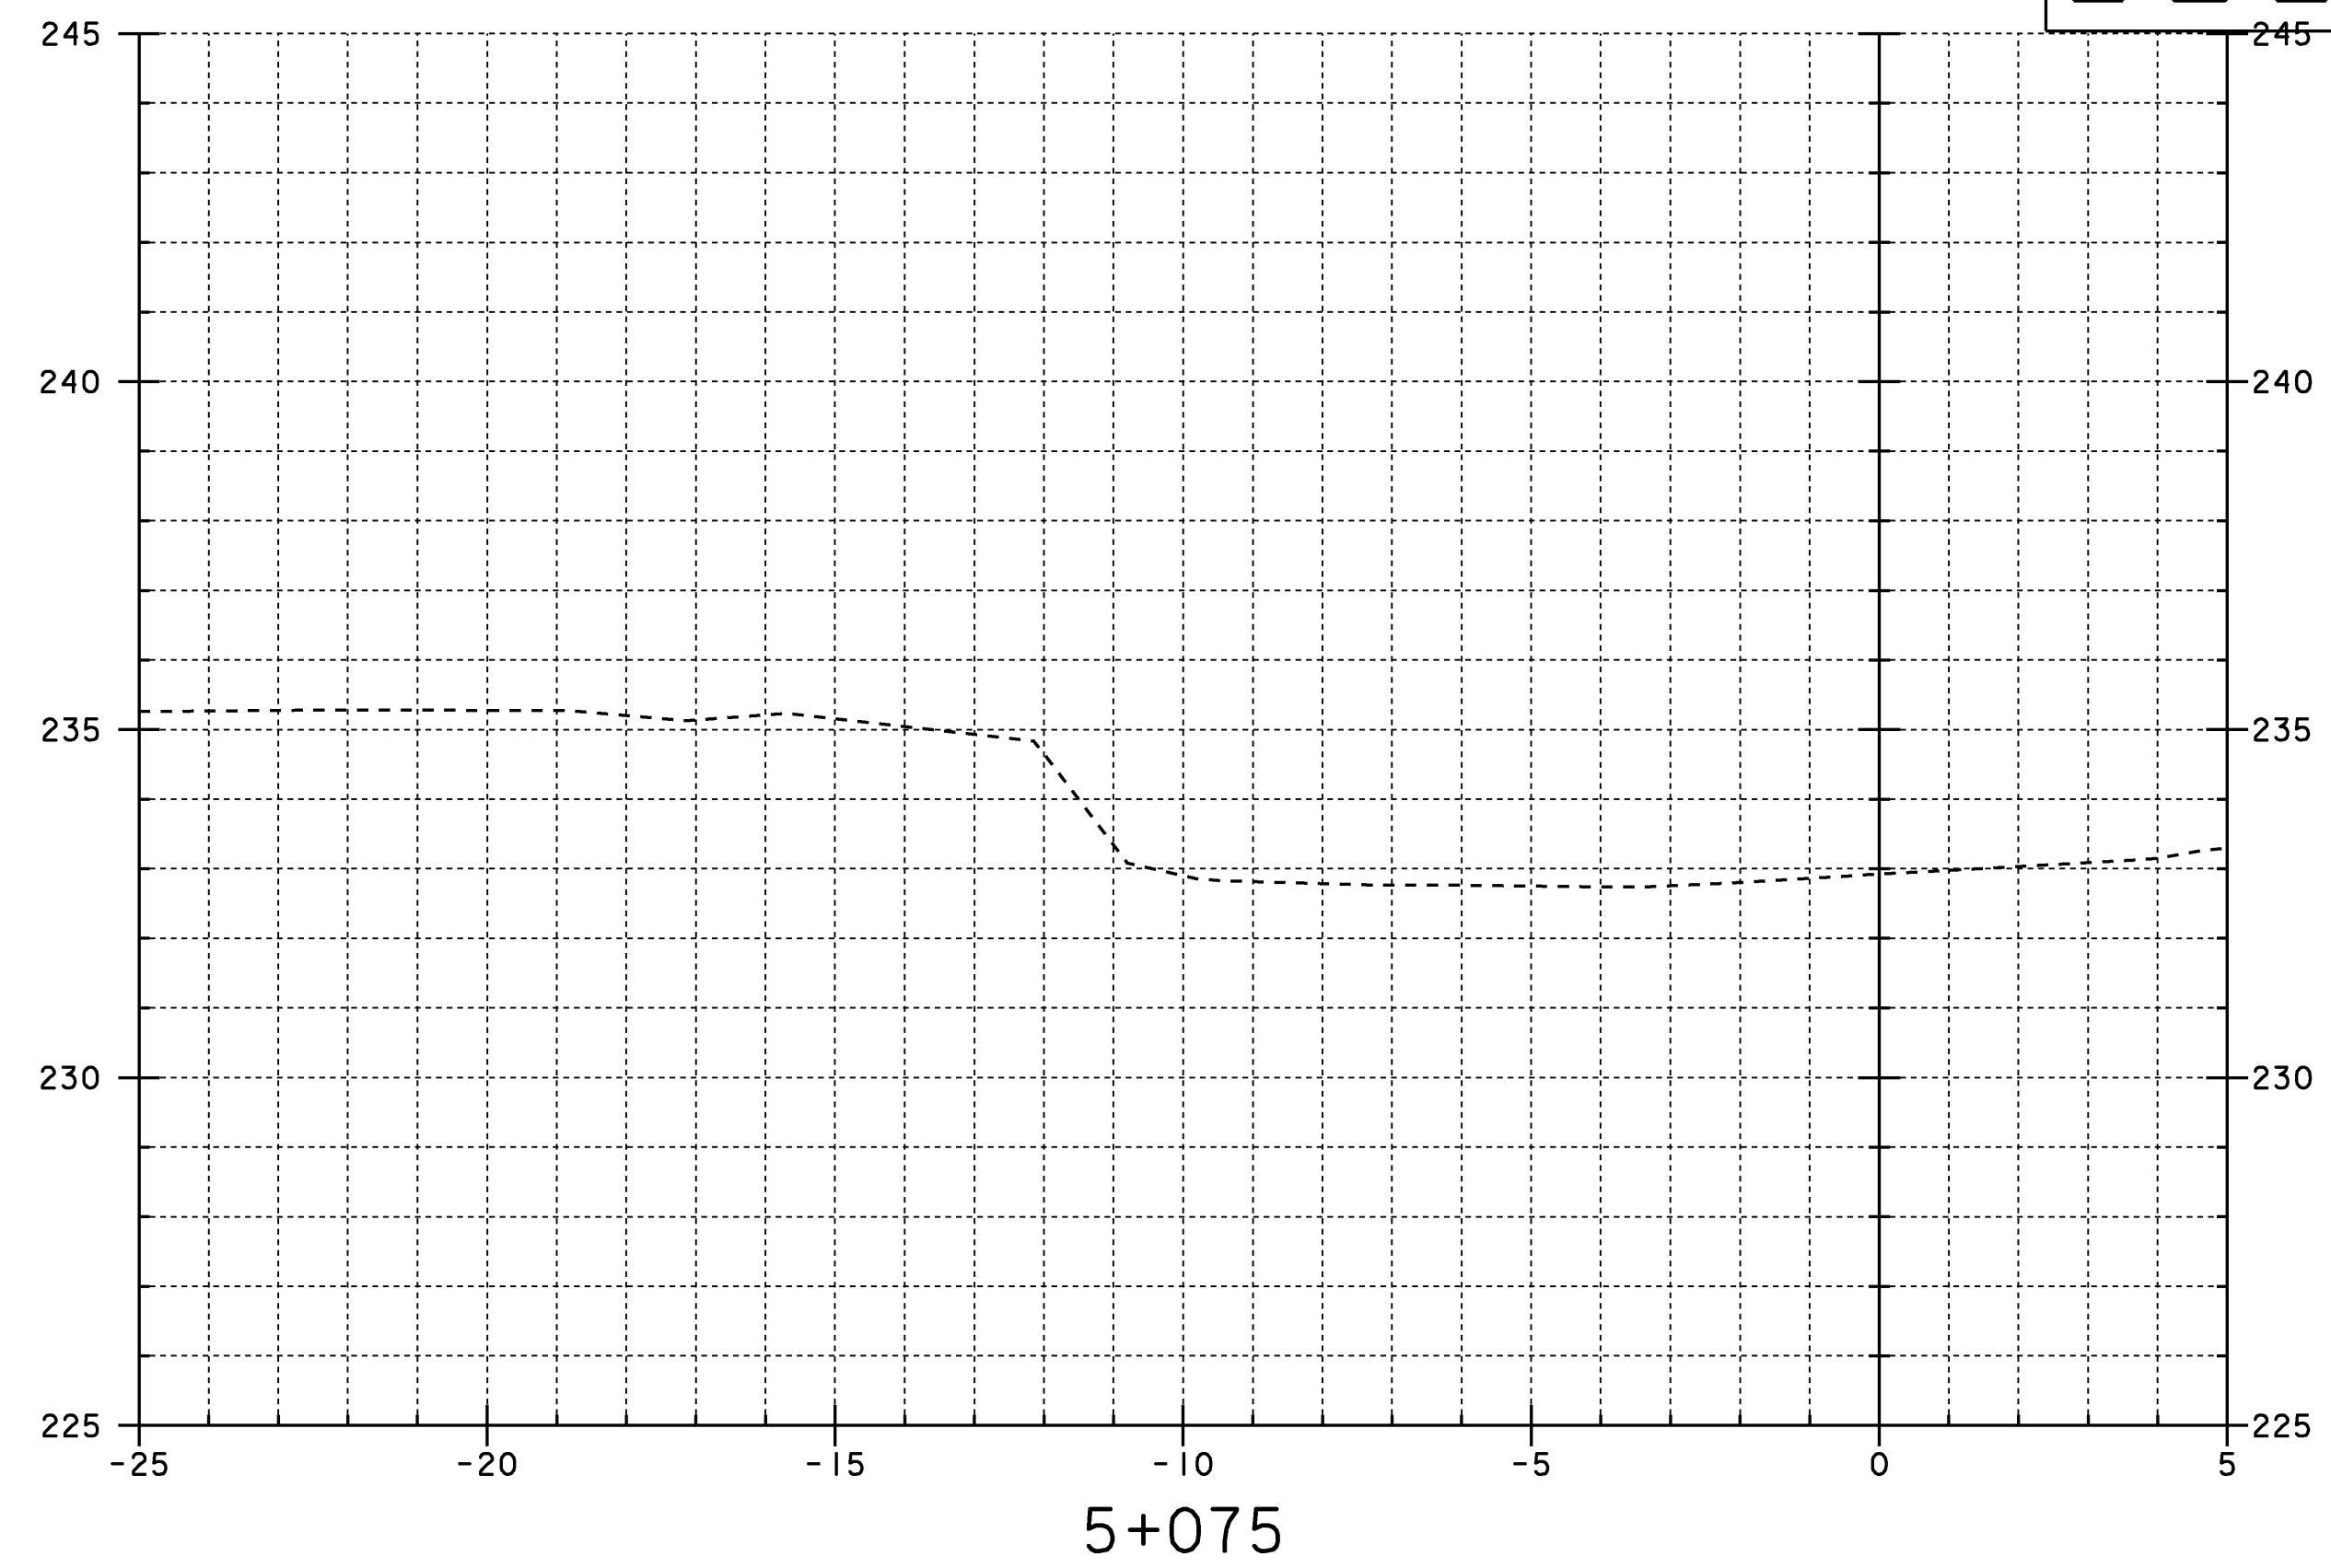


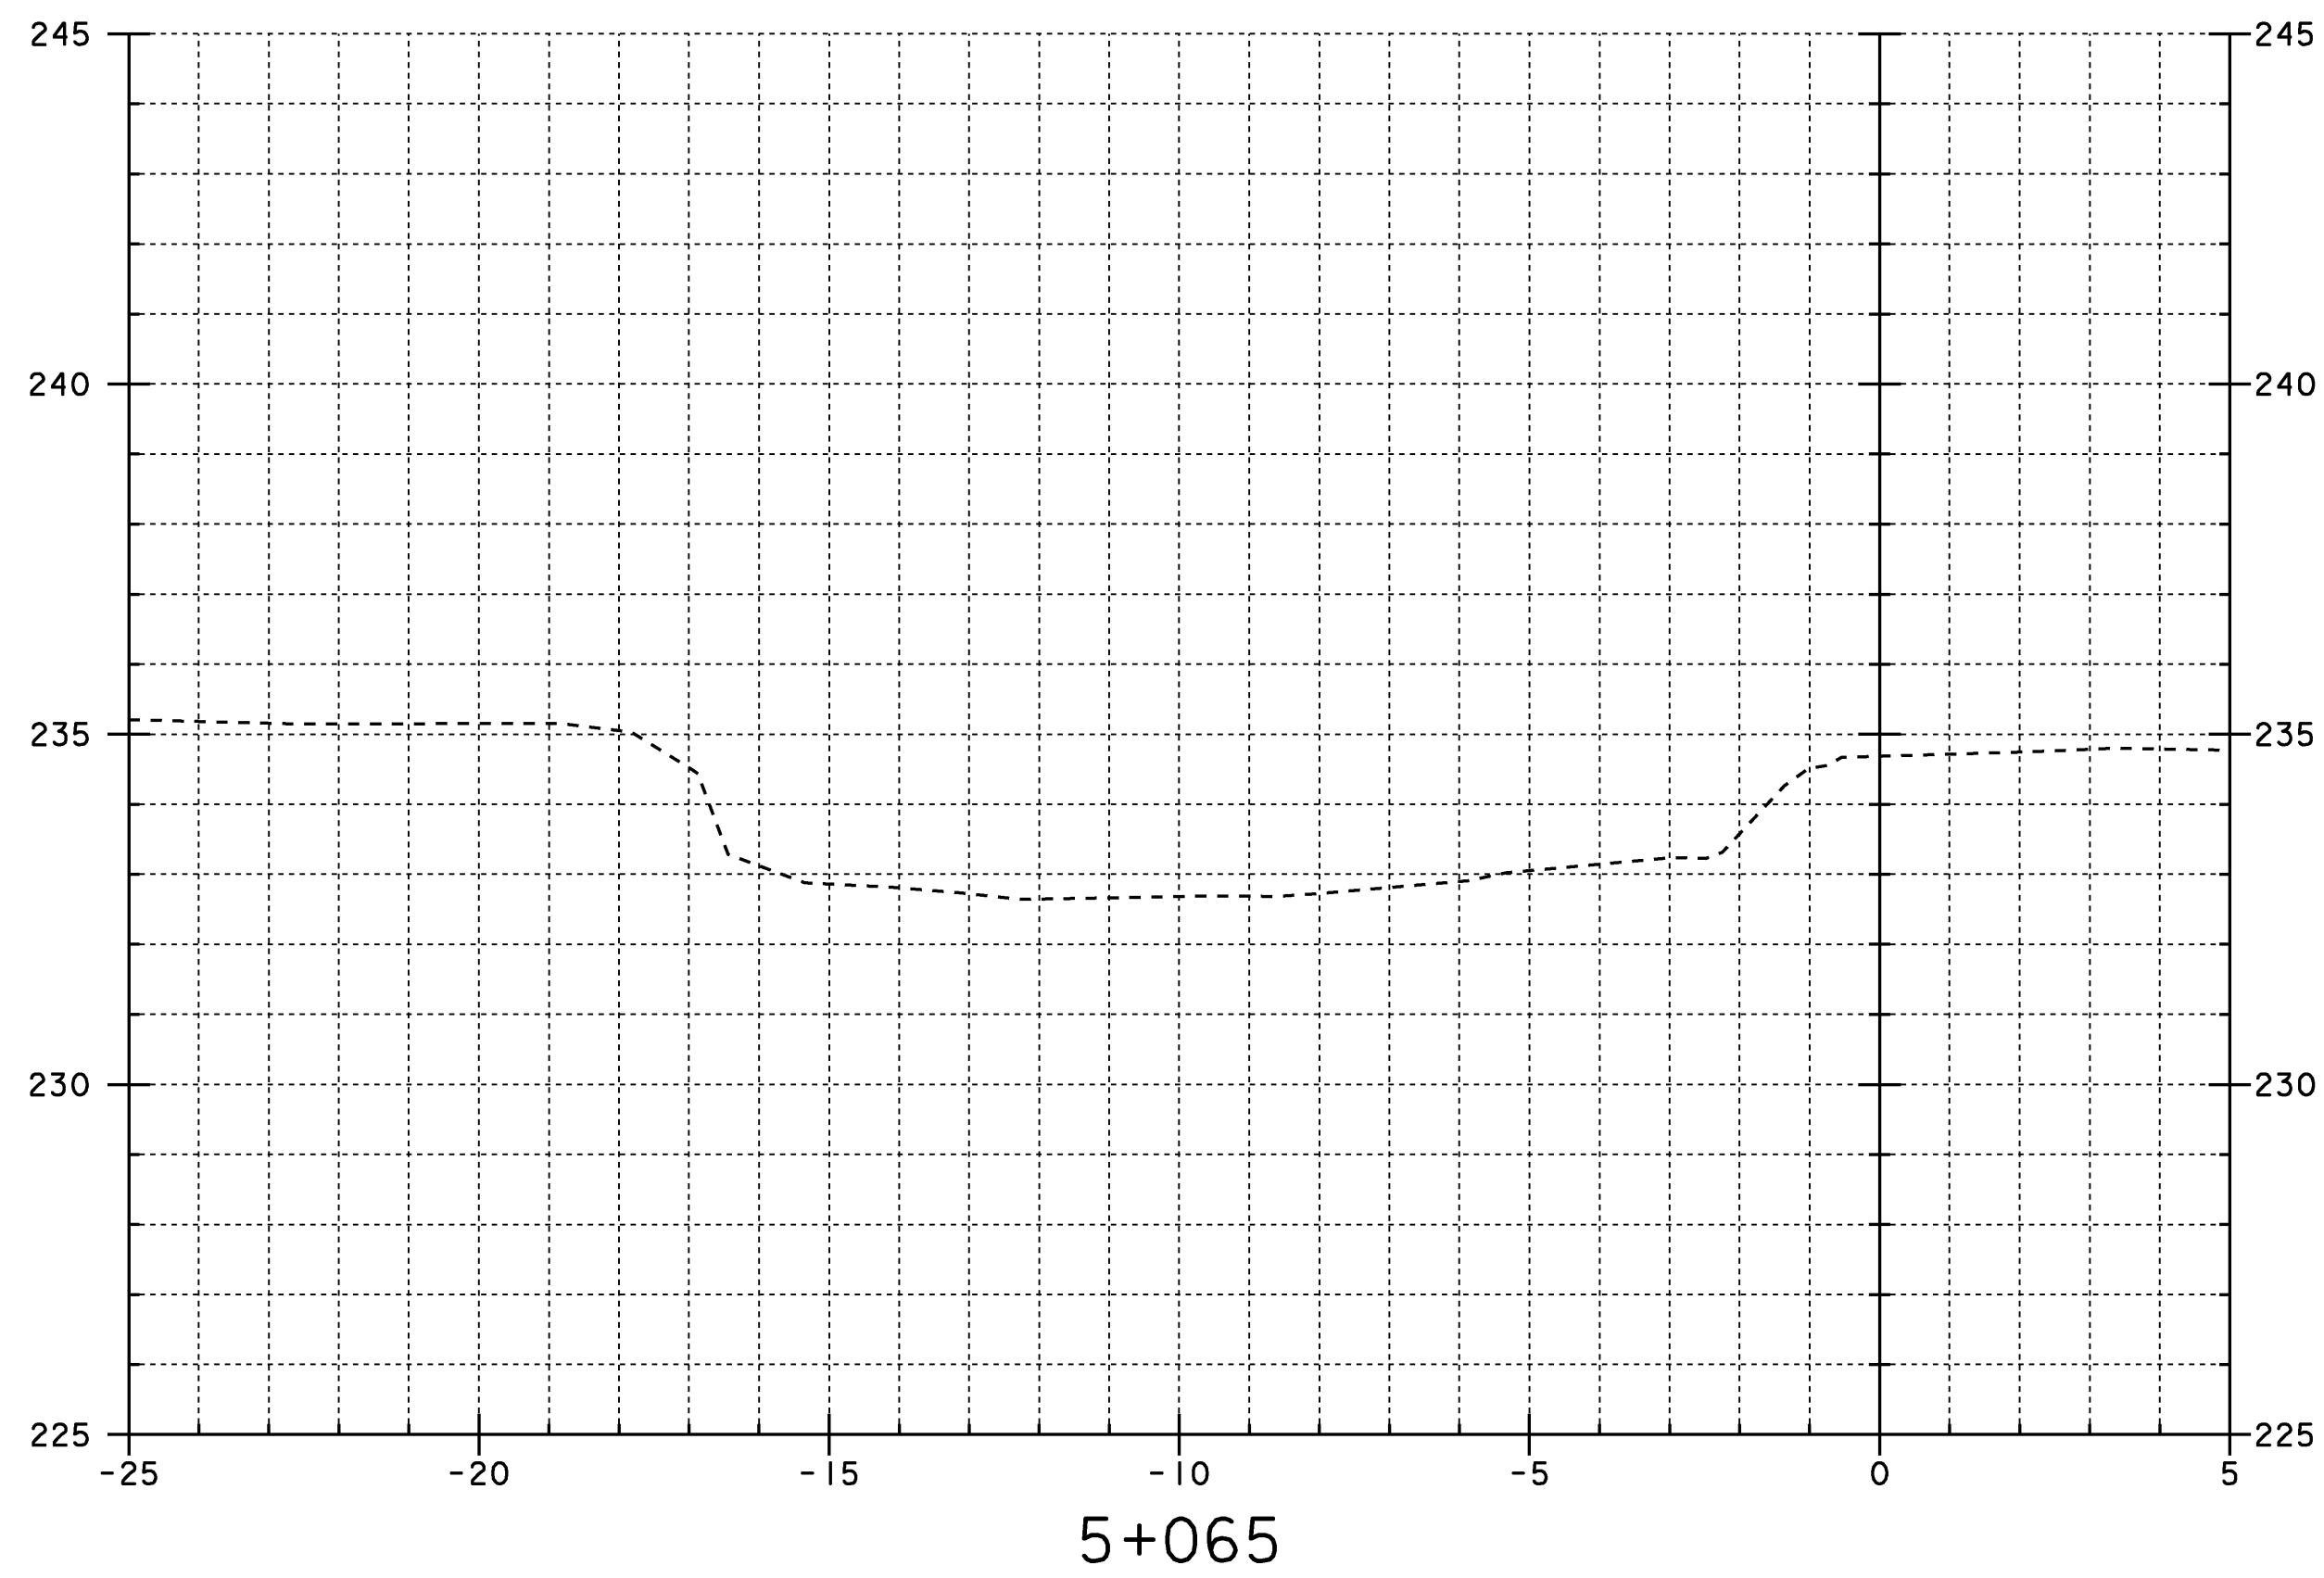

PROJECT: CORINTH	PROJECT NO.: STP BRO 1447 (22) (RE-ADVERTISED)
DESIGN FILE NAME: sj042xs2.dgn IPARM FILE NAME: sj042c4.i	PLOT DATE: 16-JUL-2008
CHANNEL LINE SECTIONS	
5+060 TO 5+075	SHEET: 42 OF 42