


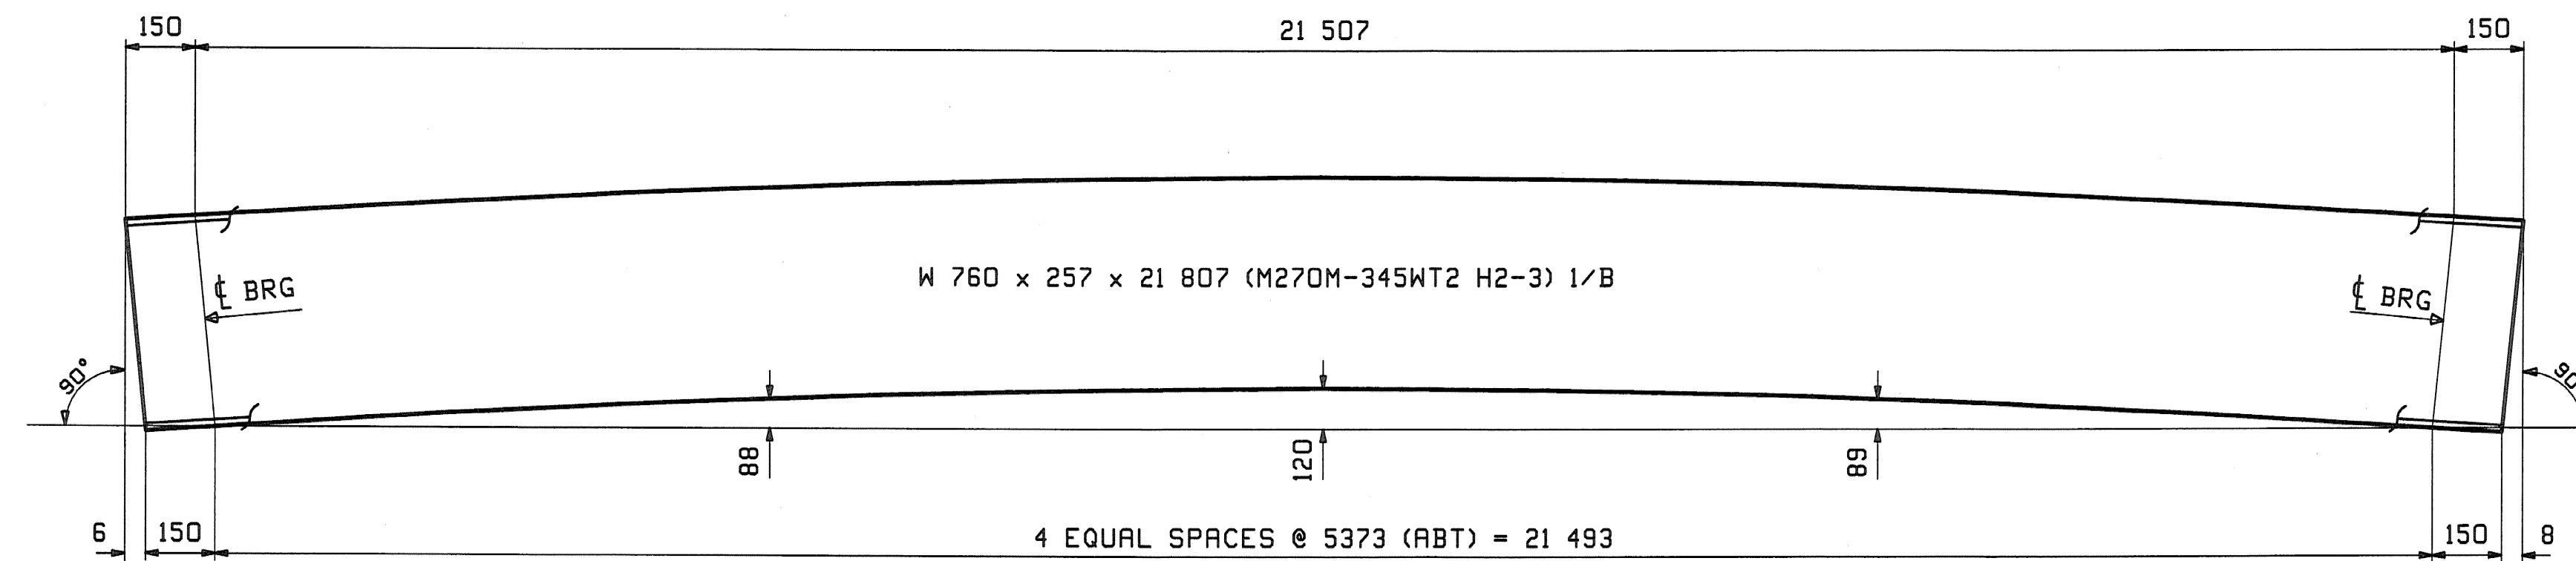

CAMBER DIAGRAM FOR 1S1 THRU 2S4

NOTES:

1. FOR GENERAL NOTES SEE DRAWING GNI.
2. H2-3 DENOTES MATERIAL SUBJECT TO CHARPY V-NOTCH TEST AT H FREQ. FOR ZONE 2

REV.	DATE	REMARKS	DWN	CHK	APVL	SHOP
0					11-10-08	
MATERIAL:		SURFACE PREP. & PAINT:	HOLES:		SHOP BOLTS:	
M270M-345W (UN)		AS NOTED ON GNI				
DESCRIPTION: CAMBER DIAGRAM						
CASCO BAY STEEL STRUCTURES, INC.						
75 SPRING HILL ROAD SACO, MAINE 04072						
PHONE (207) 282-7360 FAX. (207) 282-1179						
STRUCTURE: ROUTE NO: TH 50, CL 3					DRAWN:	DATE:
BRIDGE NO: BR 34					JTB	10/14
COUNTY OF ORANGE					CHKD:	DATE:
					DBH	10/28
LOCATION: TOWN OF CORINTH					JOB NO.	DWG NO.
PROJ NO. STP BRO 1447(22) (RE-ADVERTISED)					380	C1
CUSTOMER: VERMONT AOT					REV.	△

RECEIVED
 CKD BY: LSS CKD BY: RST
 NOV 14 2008
 RESUBMIT APPROVED
 OPW DATE 11/28/08