
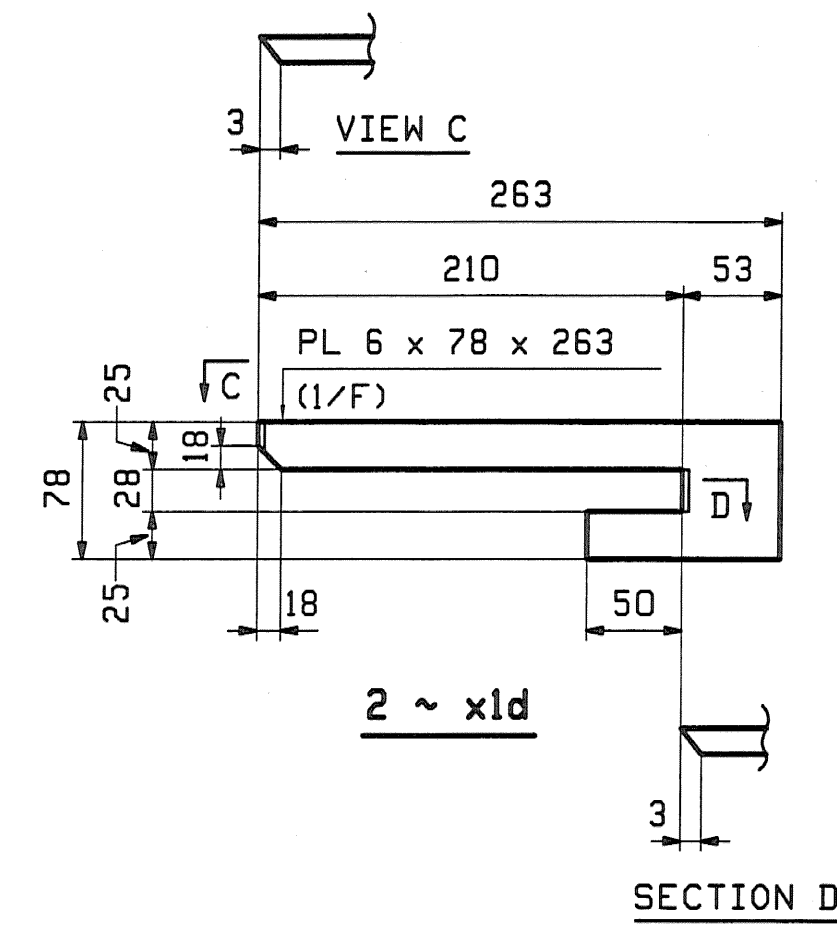
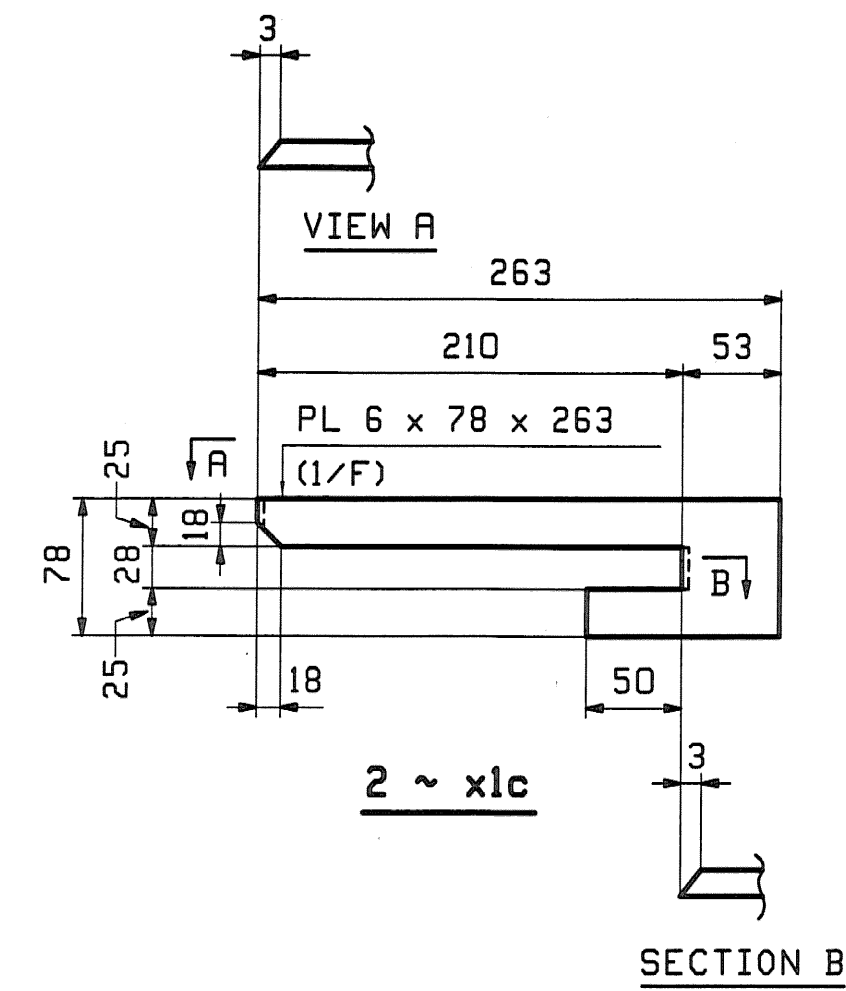
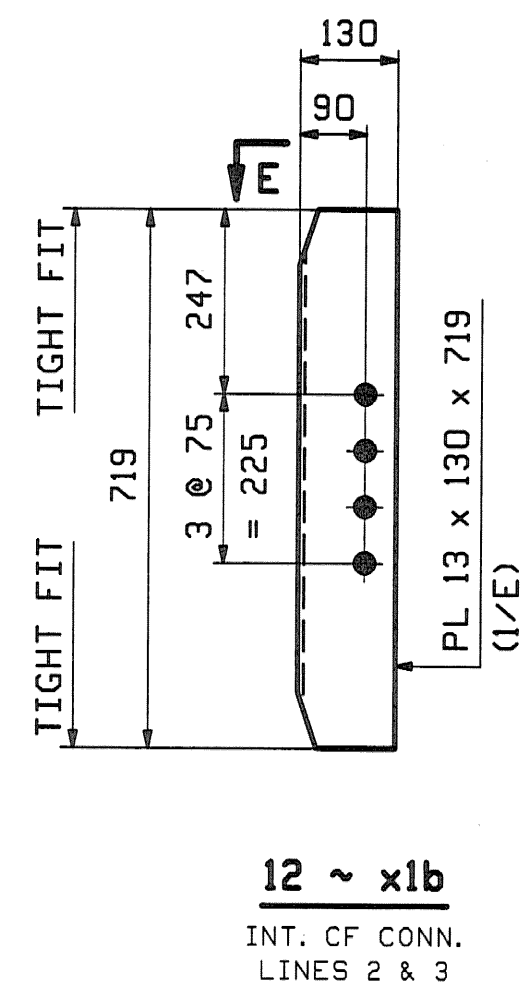


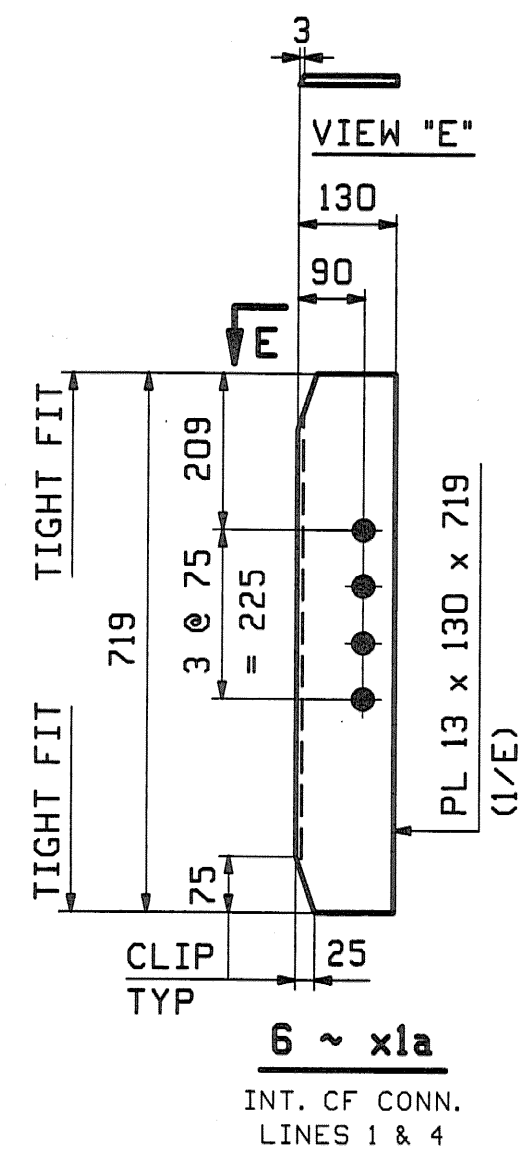

NOTES:
ALL MATERIAL SHALL BE M270M-345W.
ALL BOLT HOLES SHALL BE 15/16" FOR 3/4" HSB.
FOR GENERAL NOTES SEE DRAWING GNI.

0							1/- 10 - 03		
REV.	DATE	REMARKS			DWN	CHK	APVL	SHOP	
MATERIAL:		SURFACE PREP. & PAINT:			HOLES:		SHOP BOLTS:		
DESCRIPTION: STRINGER STANDARD DETAILS									
CASCO BAY STEEL STRUCTURES, INC.									
75 SPRING HILL ROAD				SACO, MAINE 04072					
PHONE (207) 282-7360				FAX. (207) 282-1179					
STRUCTURE: ROUTE NO: TH 50, CL 3 BRIDGE NO: BR 34 COUNTY OF ORANGE						DRAWN:		DATE:	
						JTB		10/14	
						CHKD:		DATE:	
LOCATION: TOWN OF CORINTH						DBH		10/28	
						JOB NO.		DWG NO.	
						380		X1	
CUSTOMER:		VERMONT ROT							
		REV.							

RECEIVED
NOV 14 2008
APPROVED: *As noted*
DATE: 11/25/08