
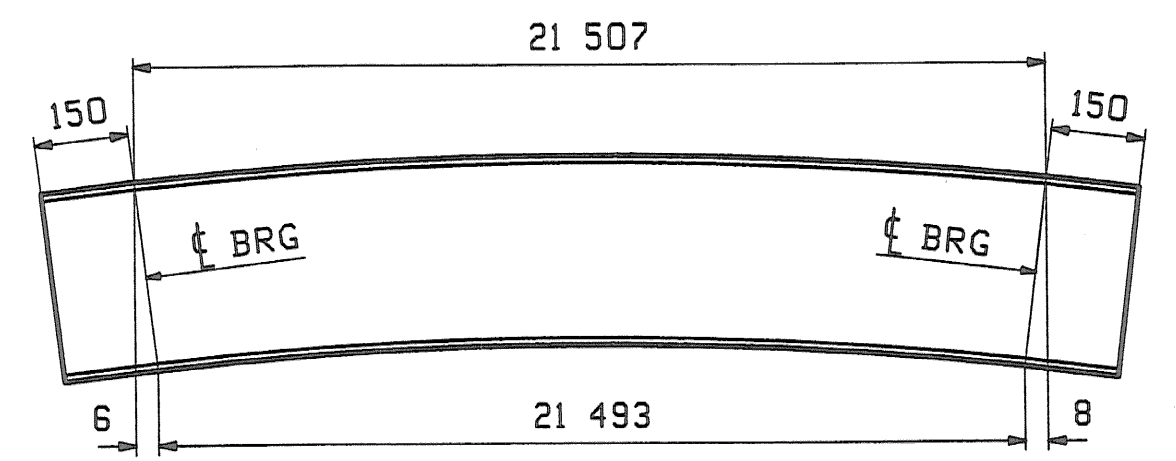
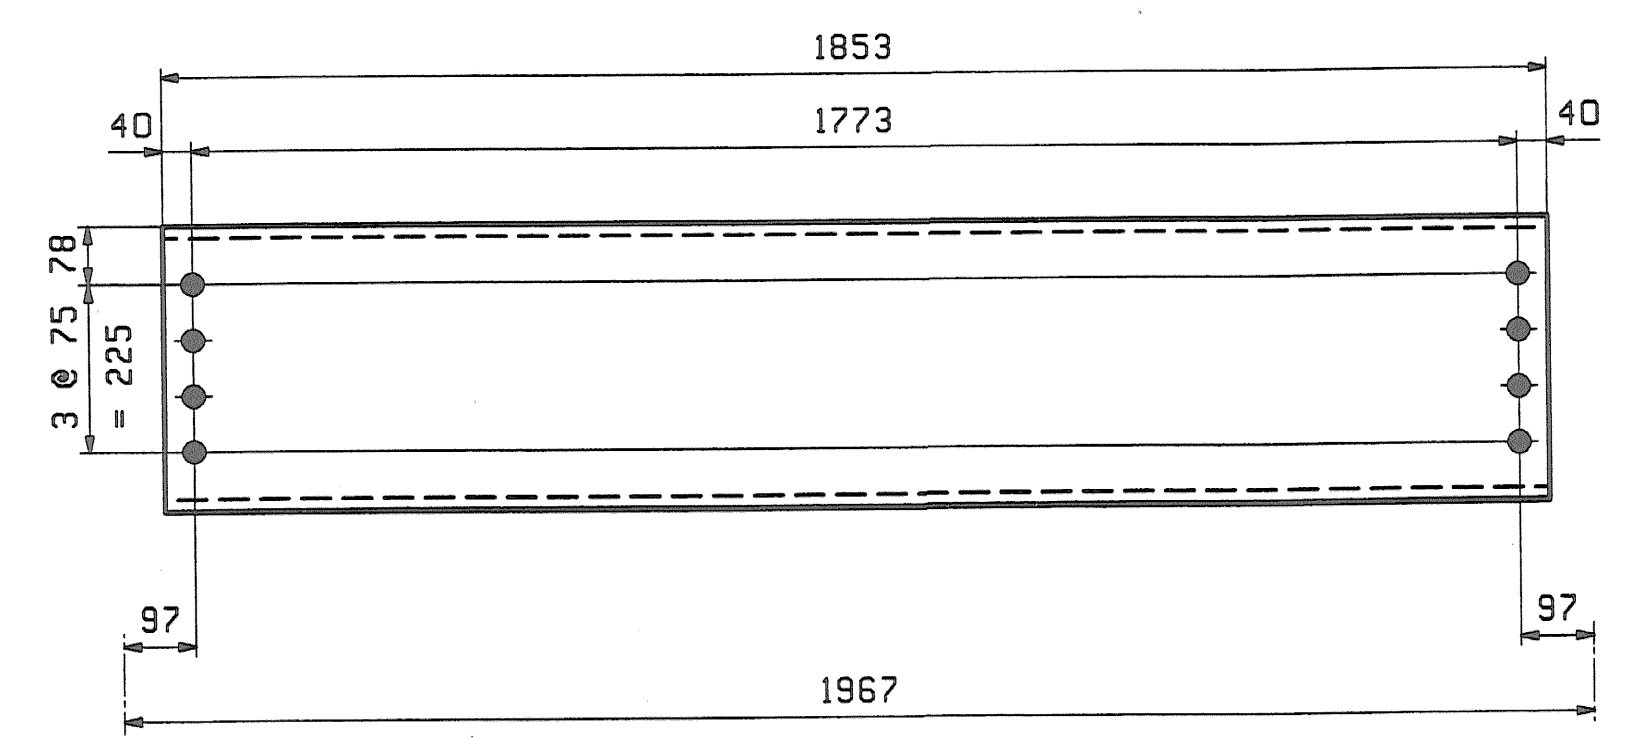
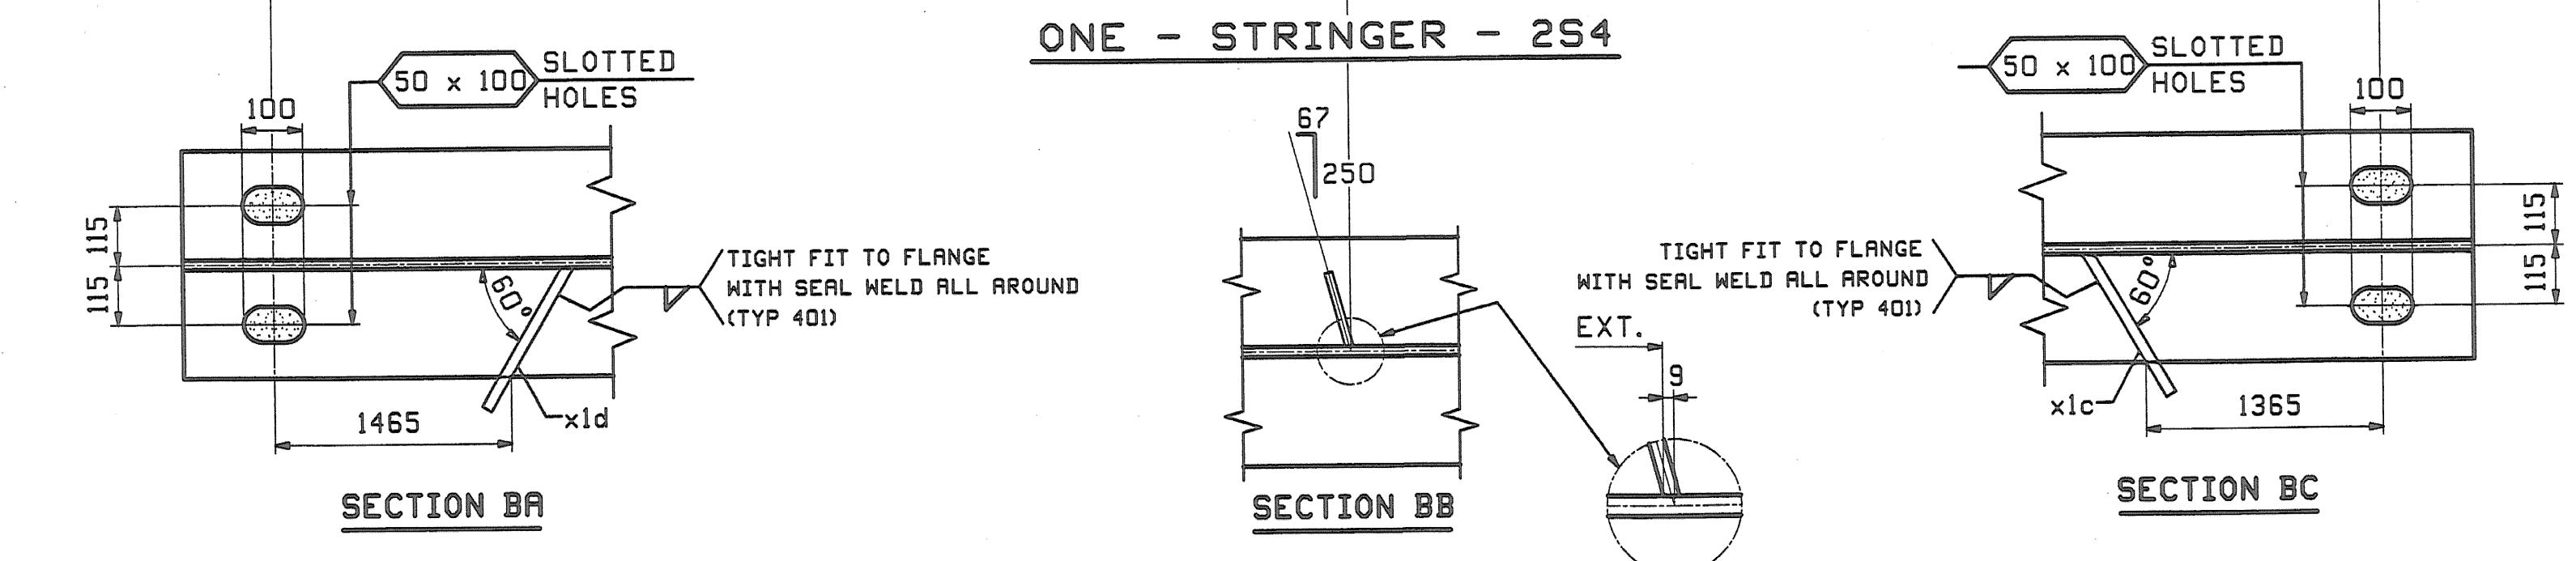
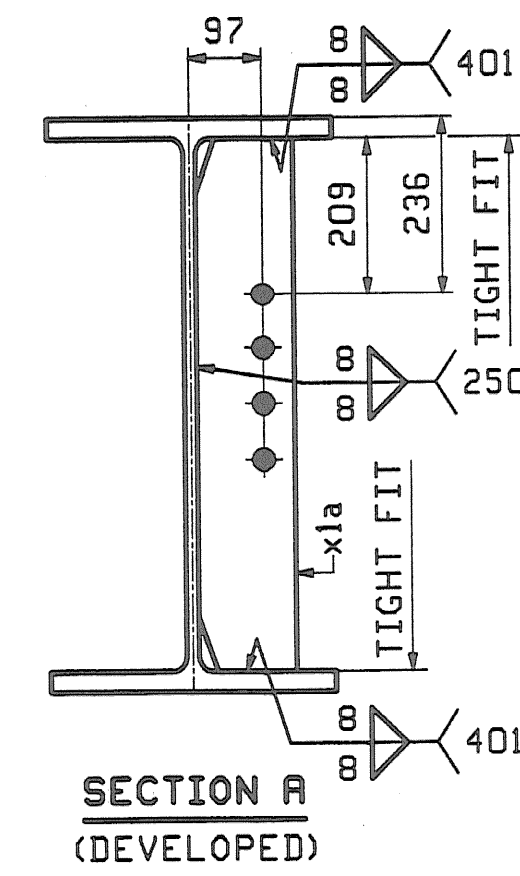


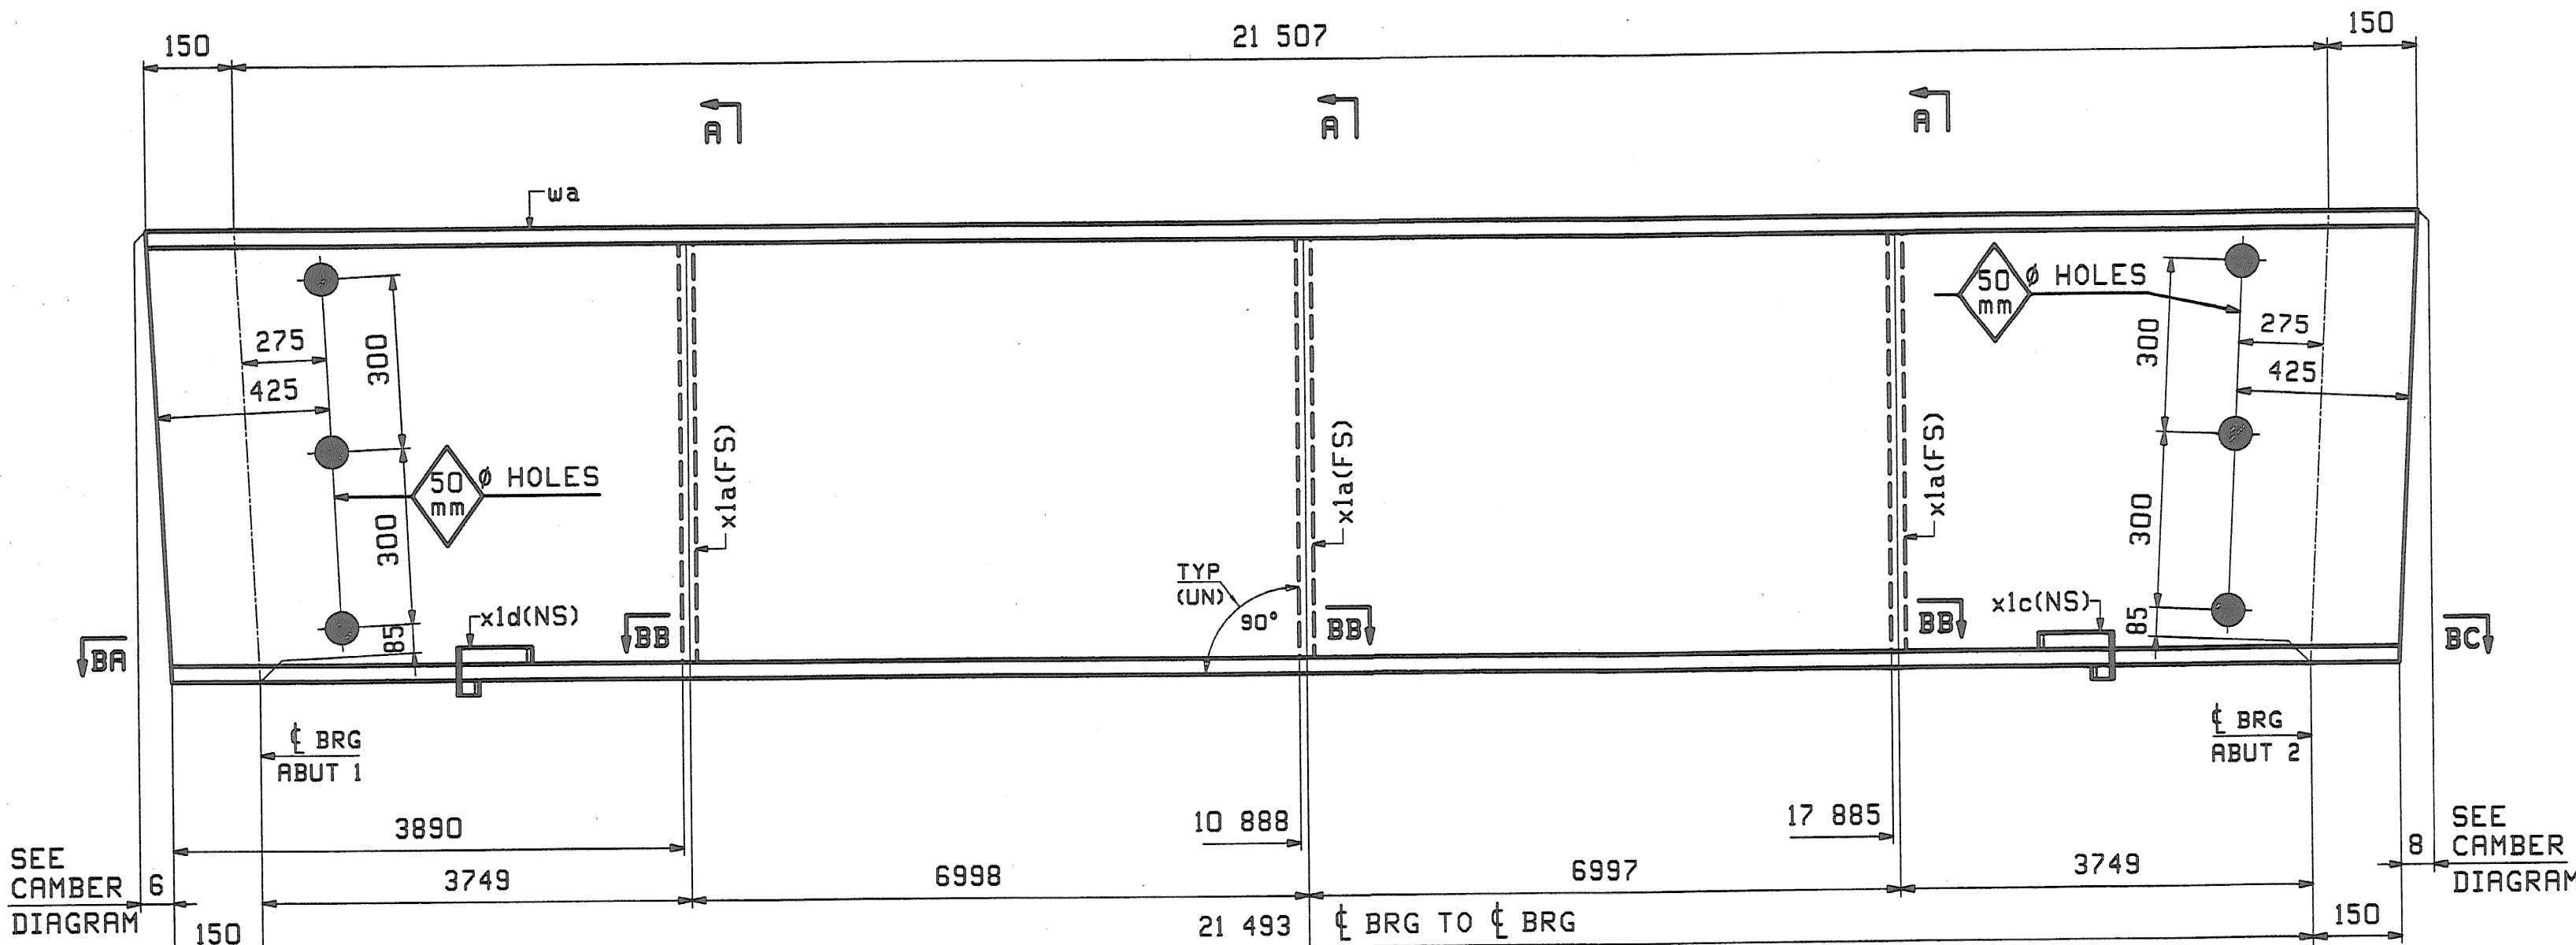

ABM INFO		SHIP	BILL OF MATERIAL				JOB NO. 380		DRAWING NO. 2		REV.
PAGE	LINE	MARK	QTY	MARK	MATERIAL	LENGTH mmm		REMARKS	MT	PROCUREMENT NOTES	
		2S4	1		STRINGER				935 kg 1323 lbs		
1	B		1	wa	W 760x257	21	807	(M270M-345WT2)	(M2-3)		
1	E		3	x1a	PL 13x130	0	719	(M270M-345W)			
1	F		1	x1c	PL 6x78	0	263	(M270M-345W)			
1	F		1	x1d	PL 6x78	0	263	(M270M-345W)			
					DIAPHRAGMS						
1	J	2D1	9		C 380x50	1	853	(M270M-345W)	93 kg 205 lbs		
	</										

$30 \frac{kg}{m} \times 201.853 m = 93.55 kg$
 Metric: C 380 x 50 = C 15 x 33.9
 English: $33.9 \frac{lb}{ft} \times 21853 mm \times \frac{1 in}{25.4 mm} \times \frac{1 ft}{12 in} = 20510$

STRINGER NOTES:
 FOR STRINGER STANDARDS SEE DRAWINGS X1.
 FOR CAMBER DIAGRAM SEE DRAWING C1.
 FOR GENERAL NOTES & WELD PROCEDURES SEE DRAWING GNI.
 H2-3 DENOTES MATERIAL SUBJECT TO CHARPY V-NOTCH TESTING.