


BITUMINOUS CONCRETE PAVEMENT:  
 1/2" TYPE III (LIFT)  
 1/2" TYPE IV (LIFT)  
 1/2" BASE COURSE, BITUMINOUS CONCRETE PAVEMENT, TYPE III (LIFT)  
 18" SUBBASE OF CRUSHED GRAVEL (FINE GRADED) DENSE GRADED CRUSHED STONE


MATERIAL ITEM	TOLERANCE
PAVEMENT	+/- 1/4" TOTAL THICKNESS
SUBBASE	+/- 1"

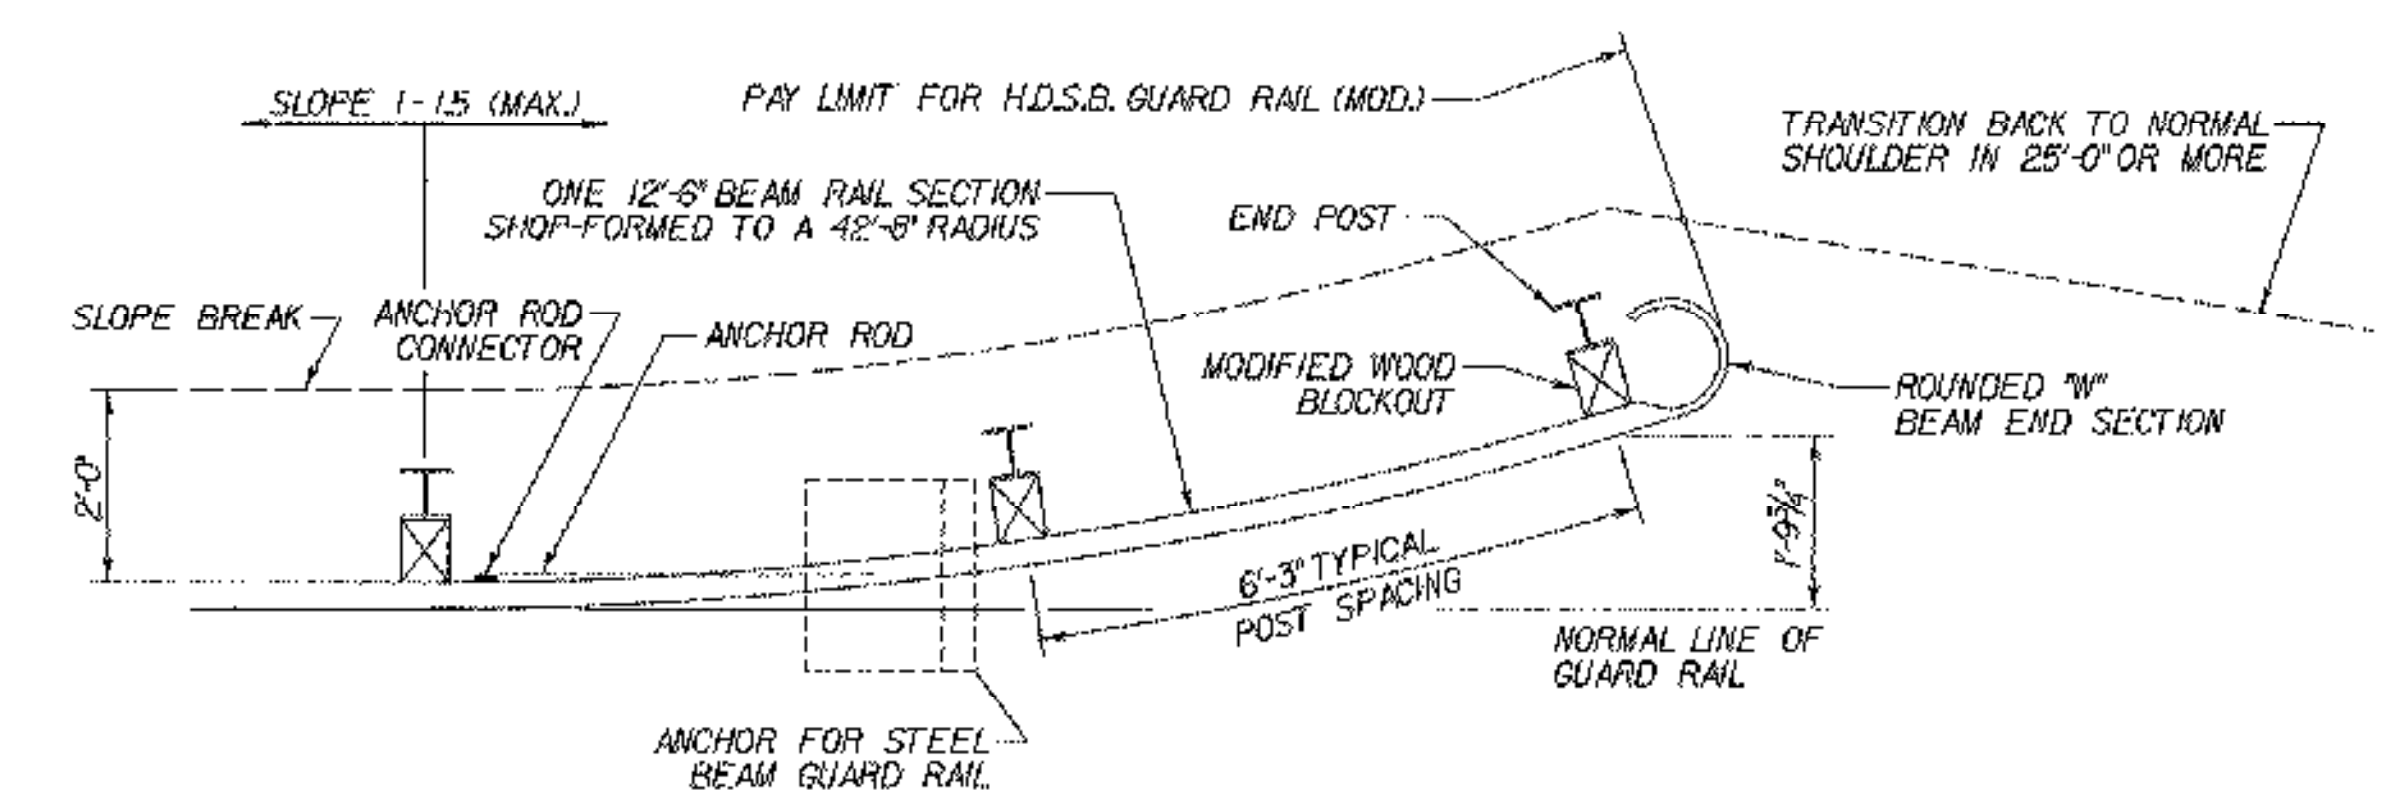

**NOTES**  
 1. SEE SHEET 12 FOR DETAIL AT SOUTHWEST CORNER.  
 2. SEE VAOT STANDARD G-16 FOR ADDITIONAL INFORMATION

**TYPICAL APPROACH END DETAIL FOR H.D.S.B. GUARD RAIL (MOD.)**

SCALE 1/2" = 1'-0"  
 1 0 1 2

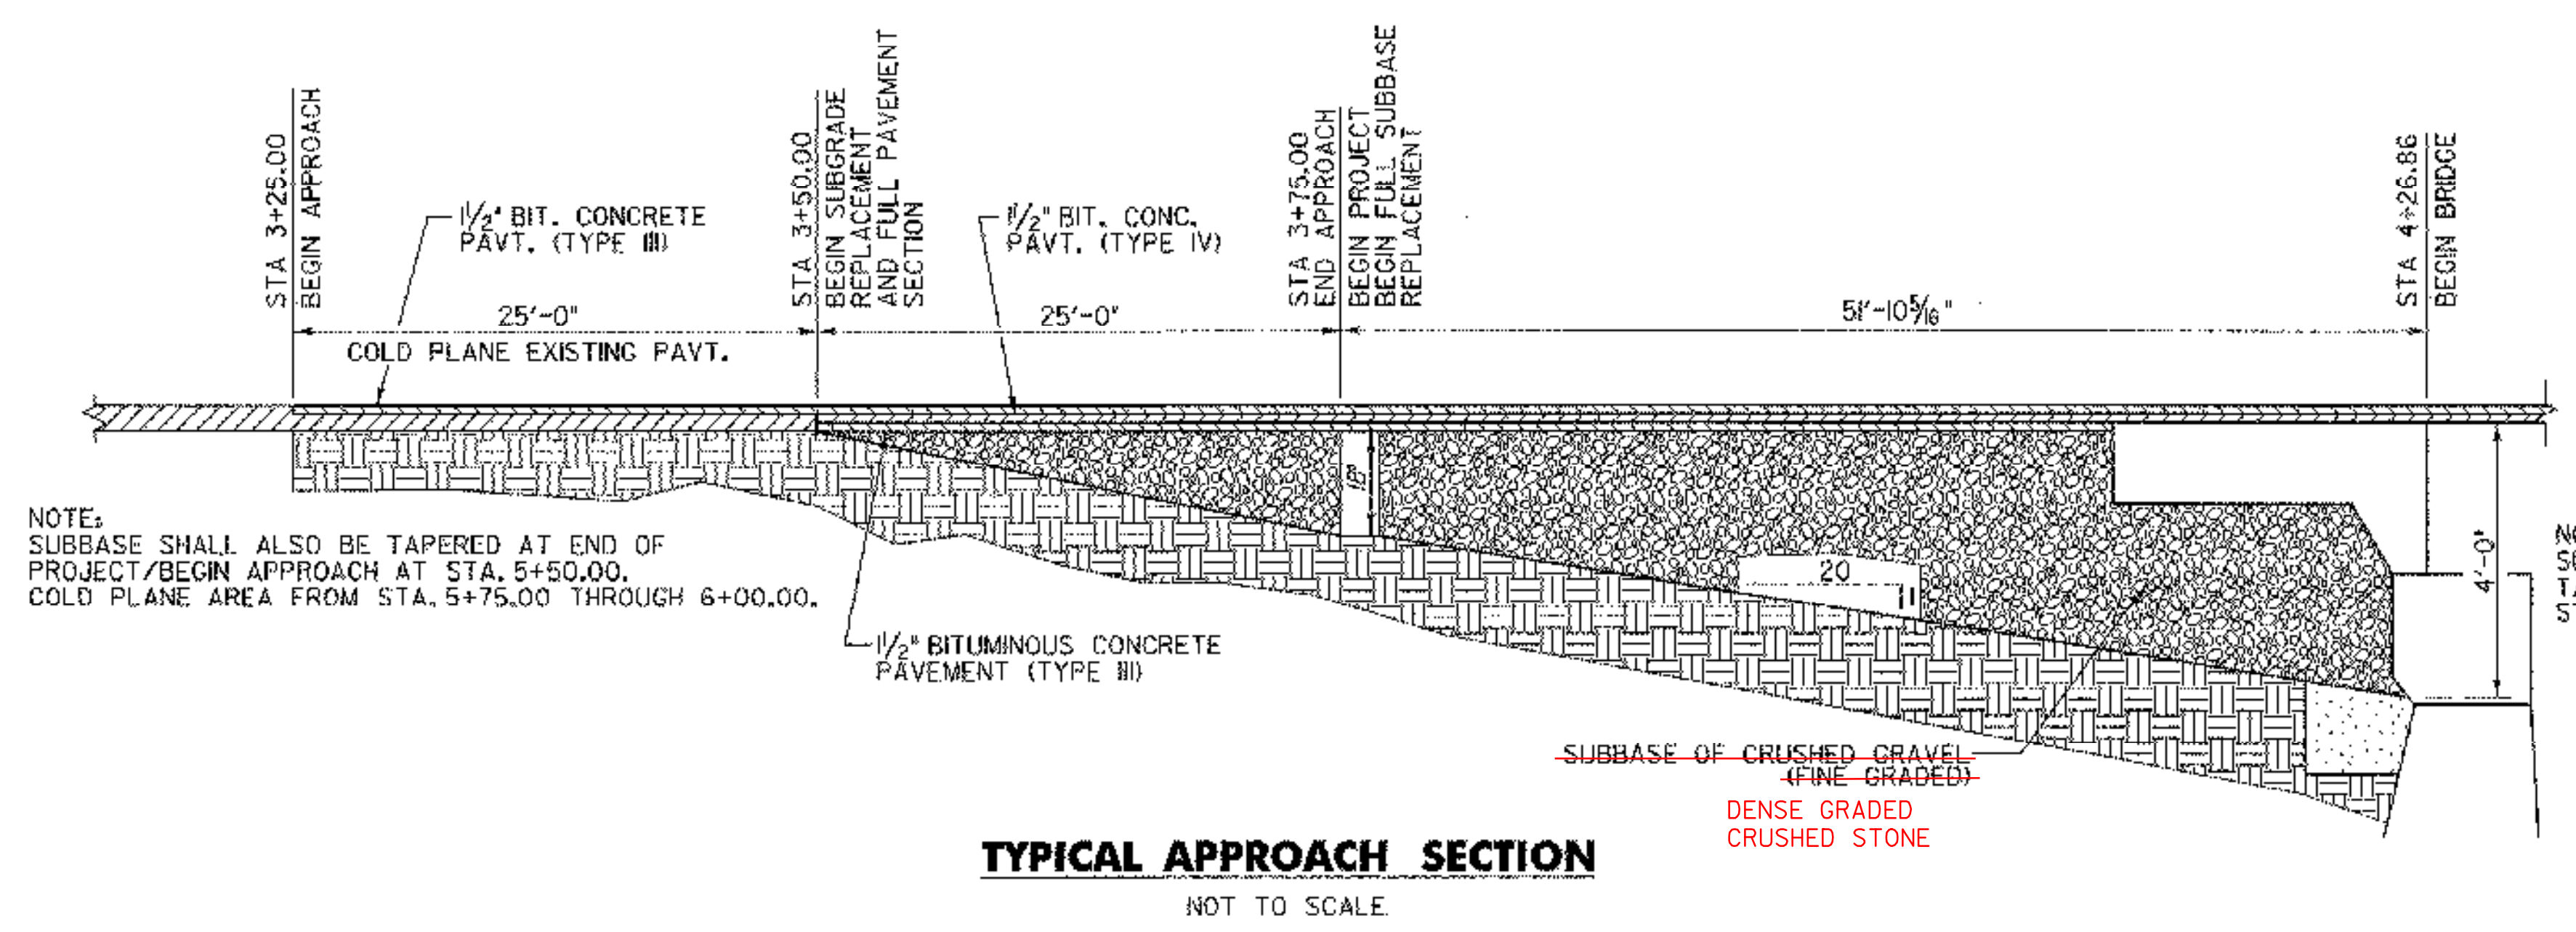

NOTE: SUBBASE SHALL ALSO BE TAPERED AT END OF PROJECT/BEGIN APPROACH AT STA. 5+50.00. COLD PLANE AREA FROM STA. 5+75.00 THROUGH 6+00.00.

NOTE: SUBBASE SHALL ALSO BE TAPERED AT END OF BRIDGE STA. 4+98.86 TO STA. 5+48.86.

<b>DH</b> Dufresne-Henry	PROJECT NAME: CORINTH
	PROJECT NUMBER: TH2-9352
	FILE NAME: ...Cor-rdwsect.dgn
	DESIGNED BY: SEB
	<b>TYPICAL ROADWAY SECTIONS</b>
PLOT DATE: 05/07/2003	
DRAWN BY: SEB	
CHECKED BY: MJC	
SHEET 3 OF 28	