


NOTE: FOR ANCHORING DETAIL OF TEMPORARY TRAFFIC BARRIER (HDSB GUARD RAIL) (MOD.) SEE SHEET 9.


APPROACH SLAB PLAN

SCALE 1/4" = 1'-0"
0 2 4 6

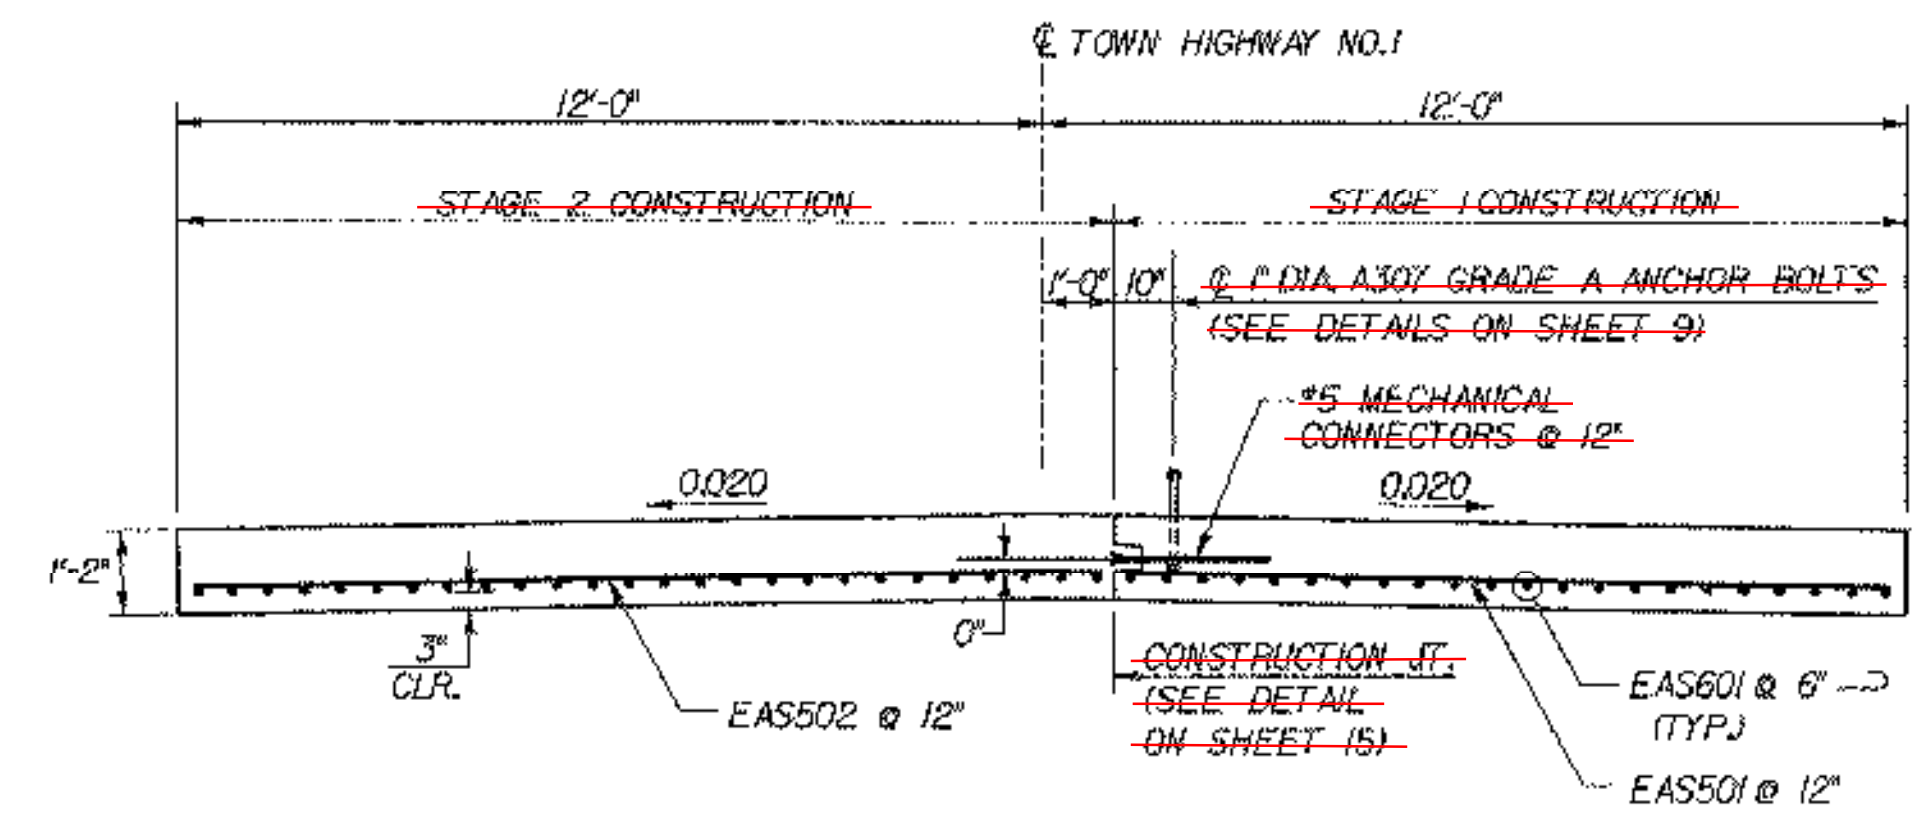


SECTION A-A

SCALE 3/8" = 1'-0"
0 1 2 3 4

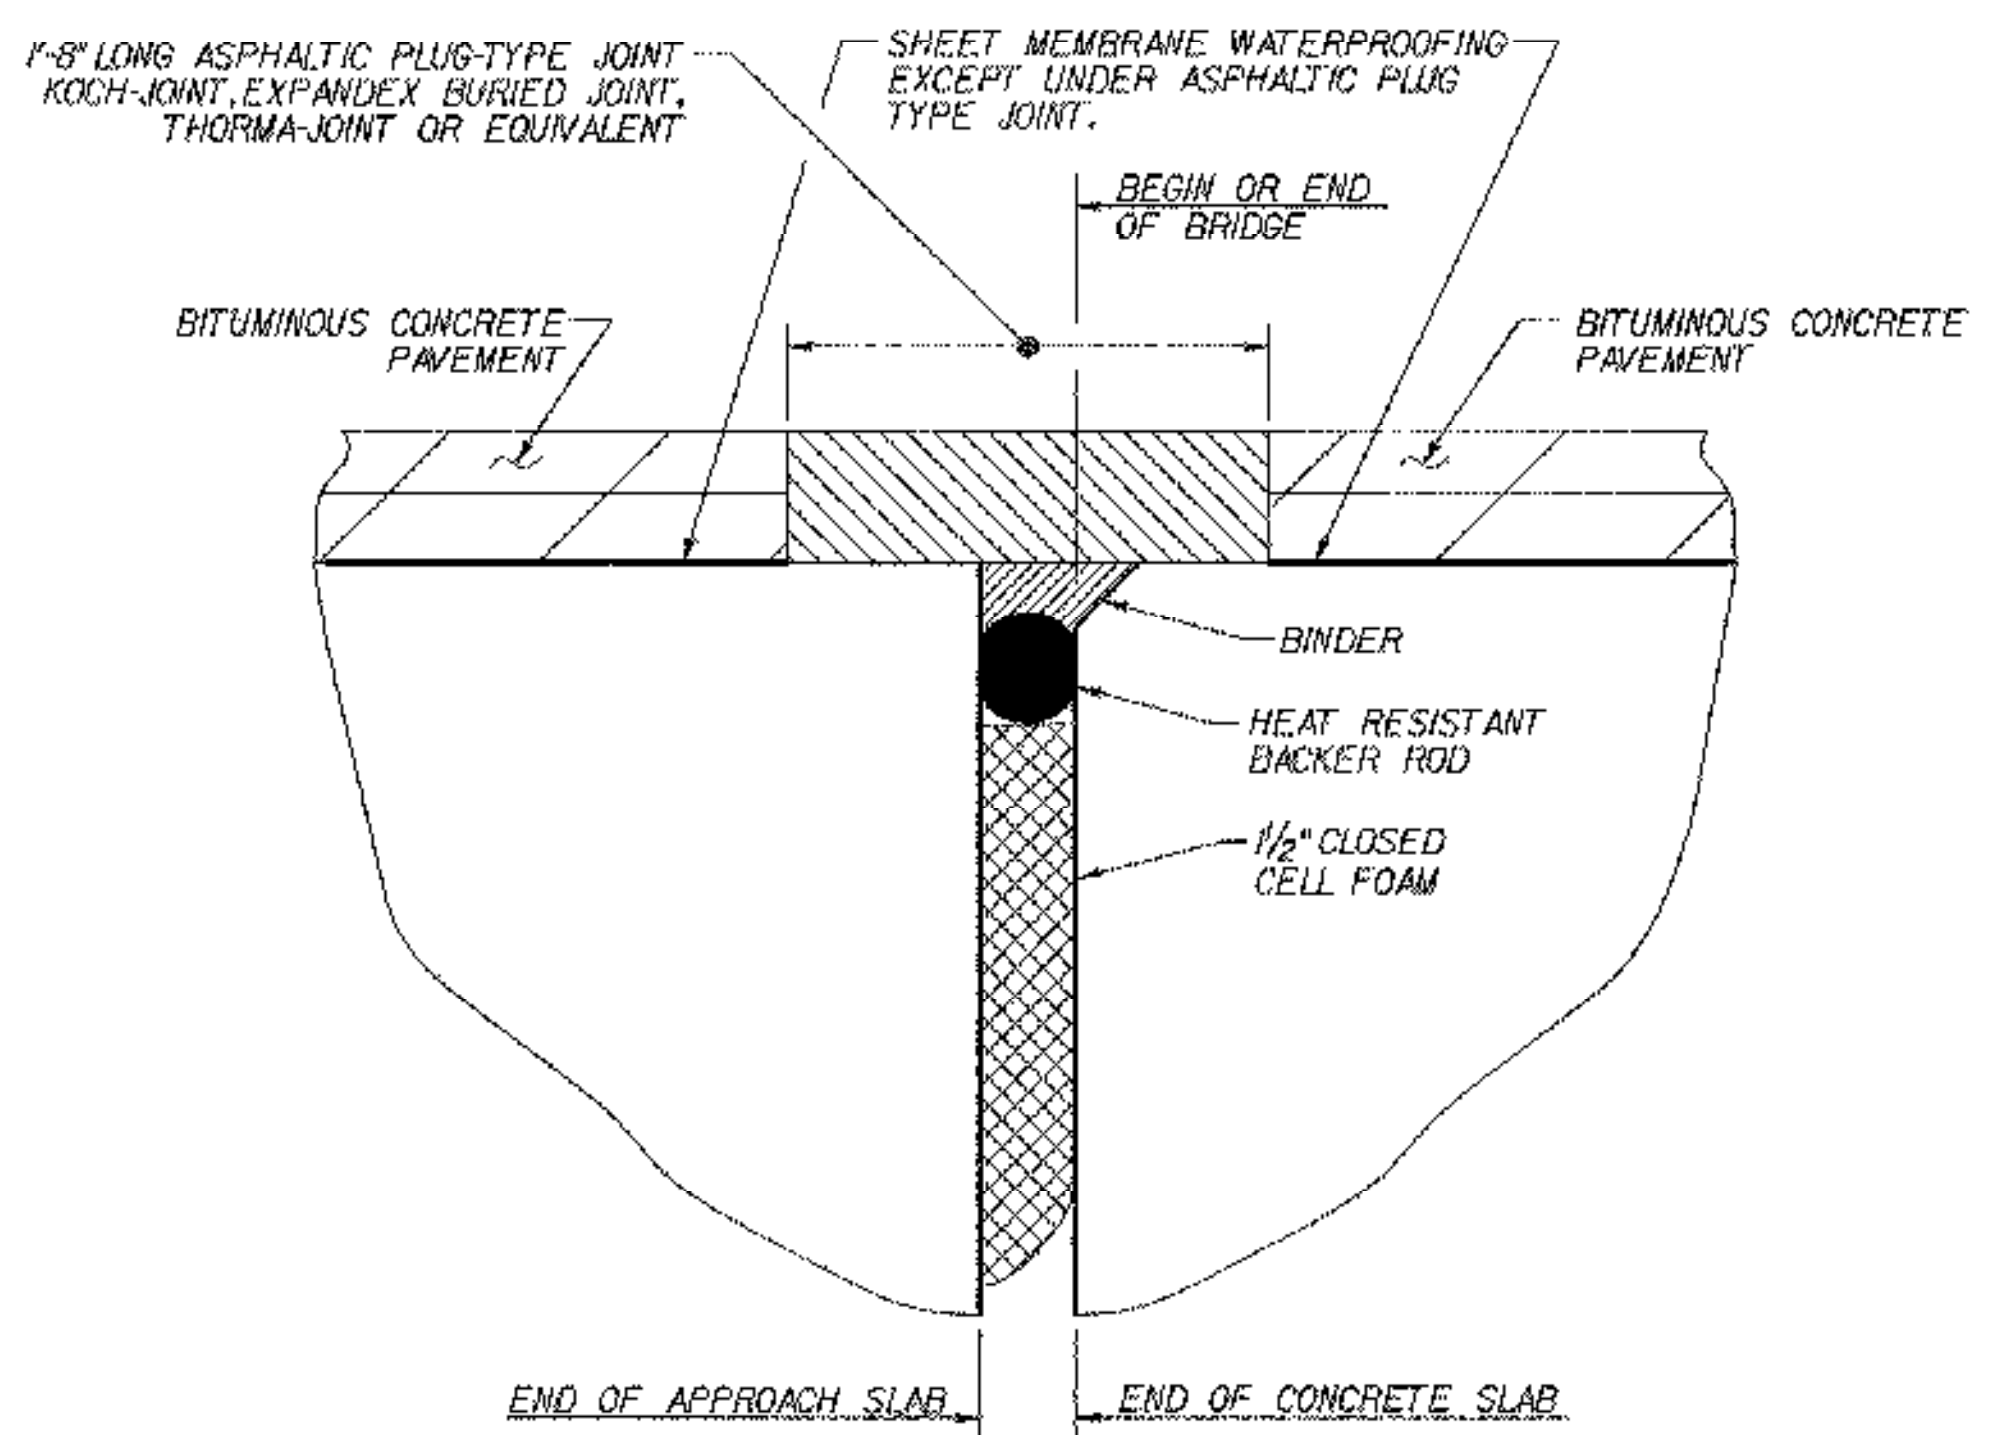

DETAIL FOR JOINT IN PAVEMENT AND SHEET MEMBRANE AT EXPANSION ENDS OF BRIDGE

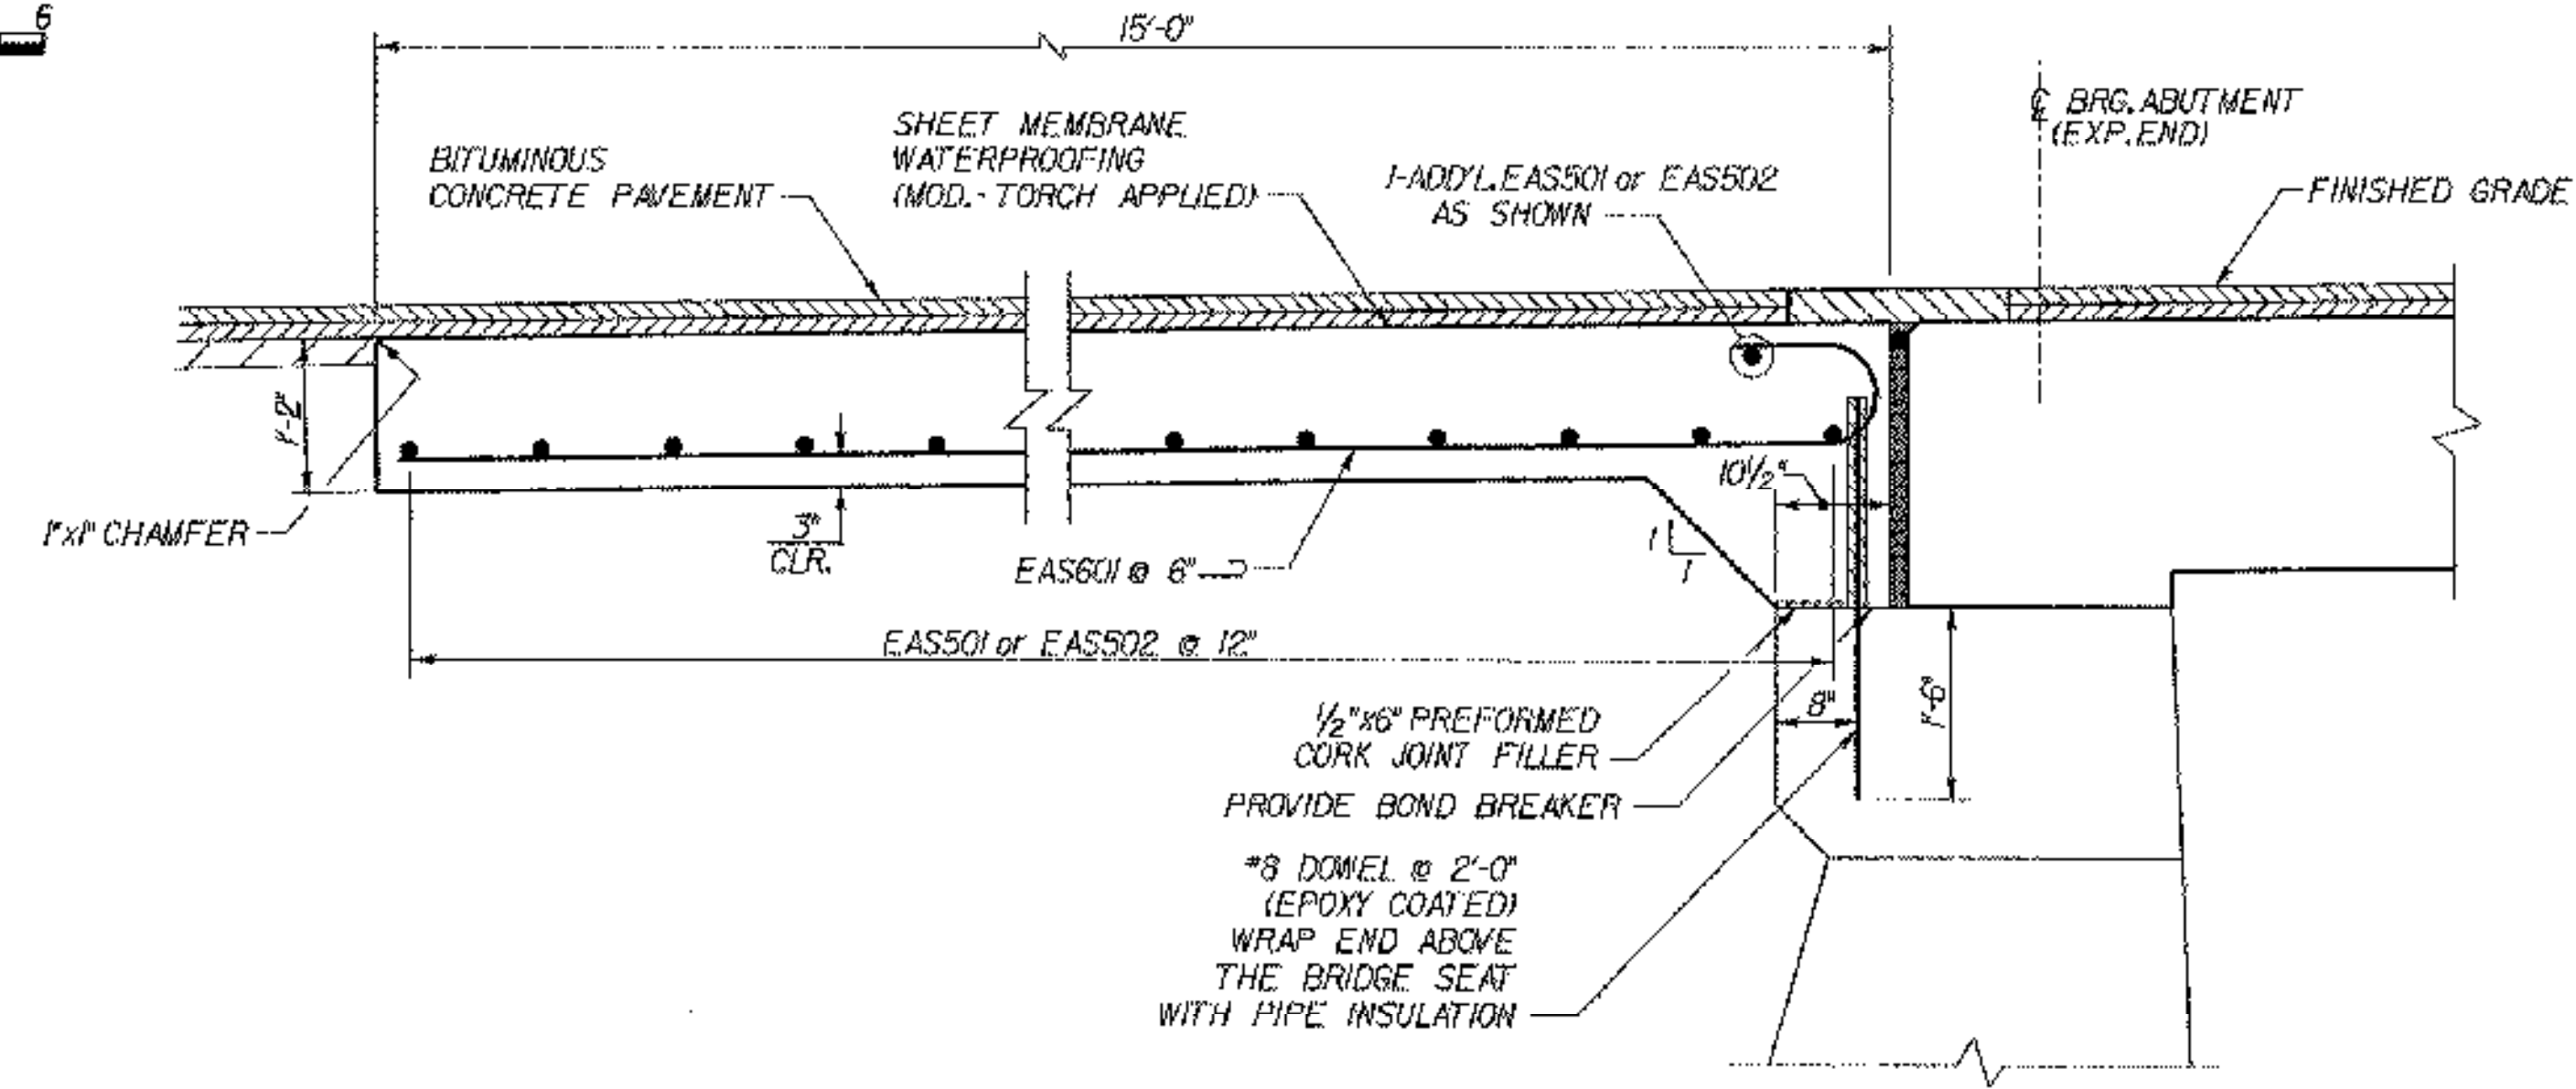

APPROACH SLAB SECTION

SCALE 3/4" = 1'-0"
0 1 2

STATE OF VERMONT
AGENCY OF TRANSPORTATION

Town Of	CORINTH	Bridge No.	10C
Highway No.	T.H.1	Log Sta.	
		Surv. Sta.	
TOWN HIGHWAY NO. 1 OVER WAITS RIVER			

APPROACH SLAB DETAILS

Designed By	S. BURBANK	Drawn By	A. THIBAUT
Checked By	M. CHENETTE	Date	05/03
		Bridge Design Supervisor	M. CHENETTE
		Date	05/03
PROJECT	CORINTH	PROJECT NO.	TH2-9352
DH CAD Filename	...Cor-apprslab.dgn	Plot Date	05/07/2003
Bridge Sheet No.		Sheet	17 of 28