



R2-5A
SEE STD. SHEET E-142

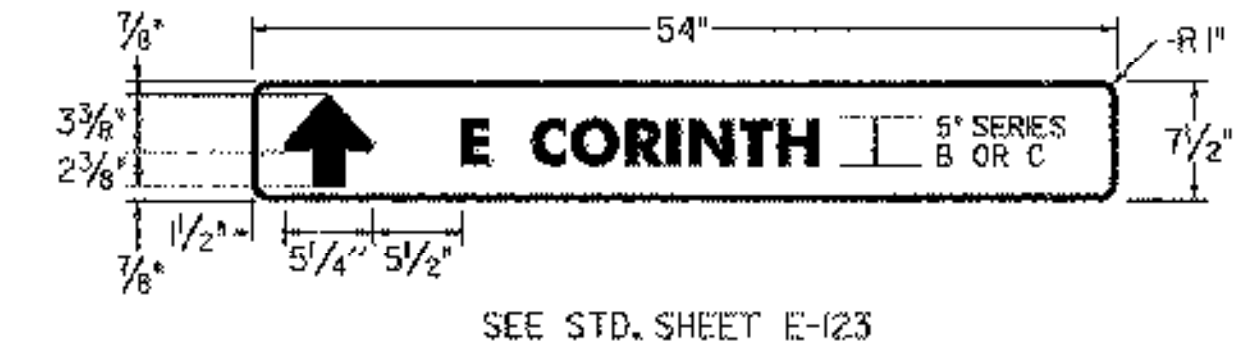


SEE STD. SHEET E-123

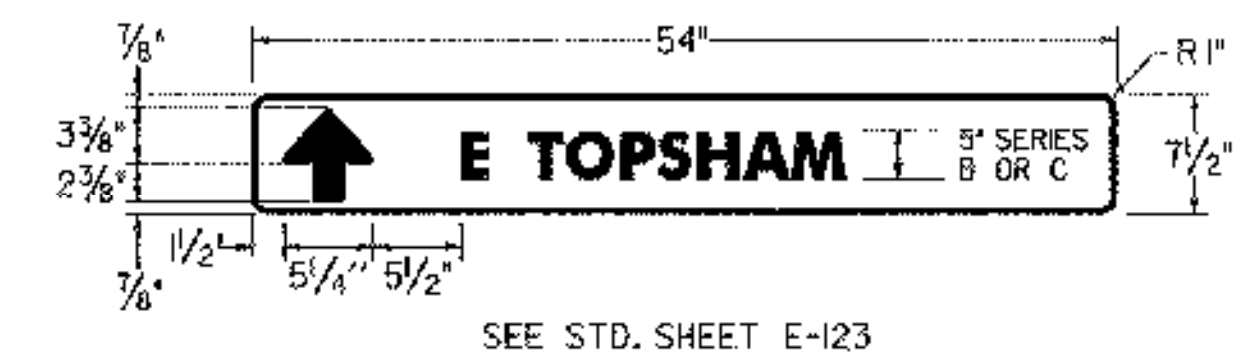

SEE STD. SHEET E-123

BUILT AS DESIGNED

SIGN LEGEND.	
N	= NEW
R	= REMOVE
R&S	= REMOVE & SALVAGE
S	= SALVAGE SIGN
RET	= RETAIN
B-B	= BACK TO BACK
*	= RETURN TO TOWN OF CORINTH

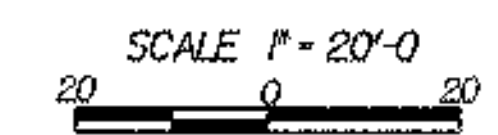

PROJECT NAME: CORINTH	PLOT DATE: 05/07/2003
PROJECT NUMBER: TH2-9352	DRAWN BY: SEB
FILE NAME: ...Cor-pavemrk.dgn	CHECKED BY: MJC
PROJECT LEADER: MJC	SHEET 23 OF 28
DESIGNED BY: SEB	
SIGN & PAVEMENT MARKING PLAN	