

PIER  
11+31  
SF = 51'  
CD EX = 34'

11+35  
SF = 51'  
CD EX = 34'


ABUT #1  
11+31 RT  
CHAN EX = 22  
SF IV = 44

ABUT #1  
11+35 RT END CHAN EX  
CHAN EX = 12  
SF IV = 30

11+31 RT. BEGIN COFFERDAM EXCAVATION - EARTH  
UNCLASSIFIED CHANNEL EXCAVATION  
DESIGN UNDER STONE FILL  
STONE FILL, TYPE IV  
CONSTRUCTION EASEMENT

11+35 RT. BEGIN COFFERDAM EXCAVATION - EARTH  
UNCLASSIFIED CHANNEL EXCAVATION  
DESIGN UNDER STONE FILL  
STONE FILL, TYPE IV  
CONSTRUCTION EASEMENT

10+35 RT. BEGIN COFFERDAM EXCAVATION - EARTH  
UNCLASSIFIED CHANNEL EXCAVATION  
DESIGN UNDER STONE FILL  
STONE FILL, TYPE IV  
CONSTRUCTION EASEMENT

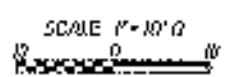

PROJECT NAME: CORINTH	DATE PLOTTED: 05/01/2003
PROJECT NUMBER: 112 9352	DRAWN BY: SED
PROJECT LEADER: IAJC	CHECKED BY: IAJC
DESIGNED BY: SED	SHEET 27 OF 28
<b>CHANNEL CROSS SECTIONS</b>	