

GPS CONTROL POINTS

Points 1 & 2 were temporary points established using GPS

[Tie Data not Available]

[For Tie Data, See TRAV PT 3]




North: 256891.101
East: 540756.385

North: 256432.938
East: 540427.794





Point Designated by rebar driven in Earth

Point Designated by rebar driven in Earth

TRAVERSE TIES

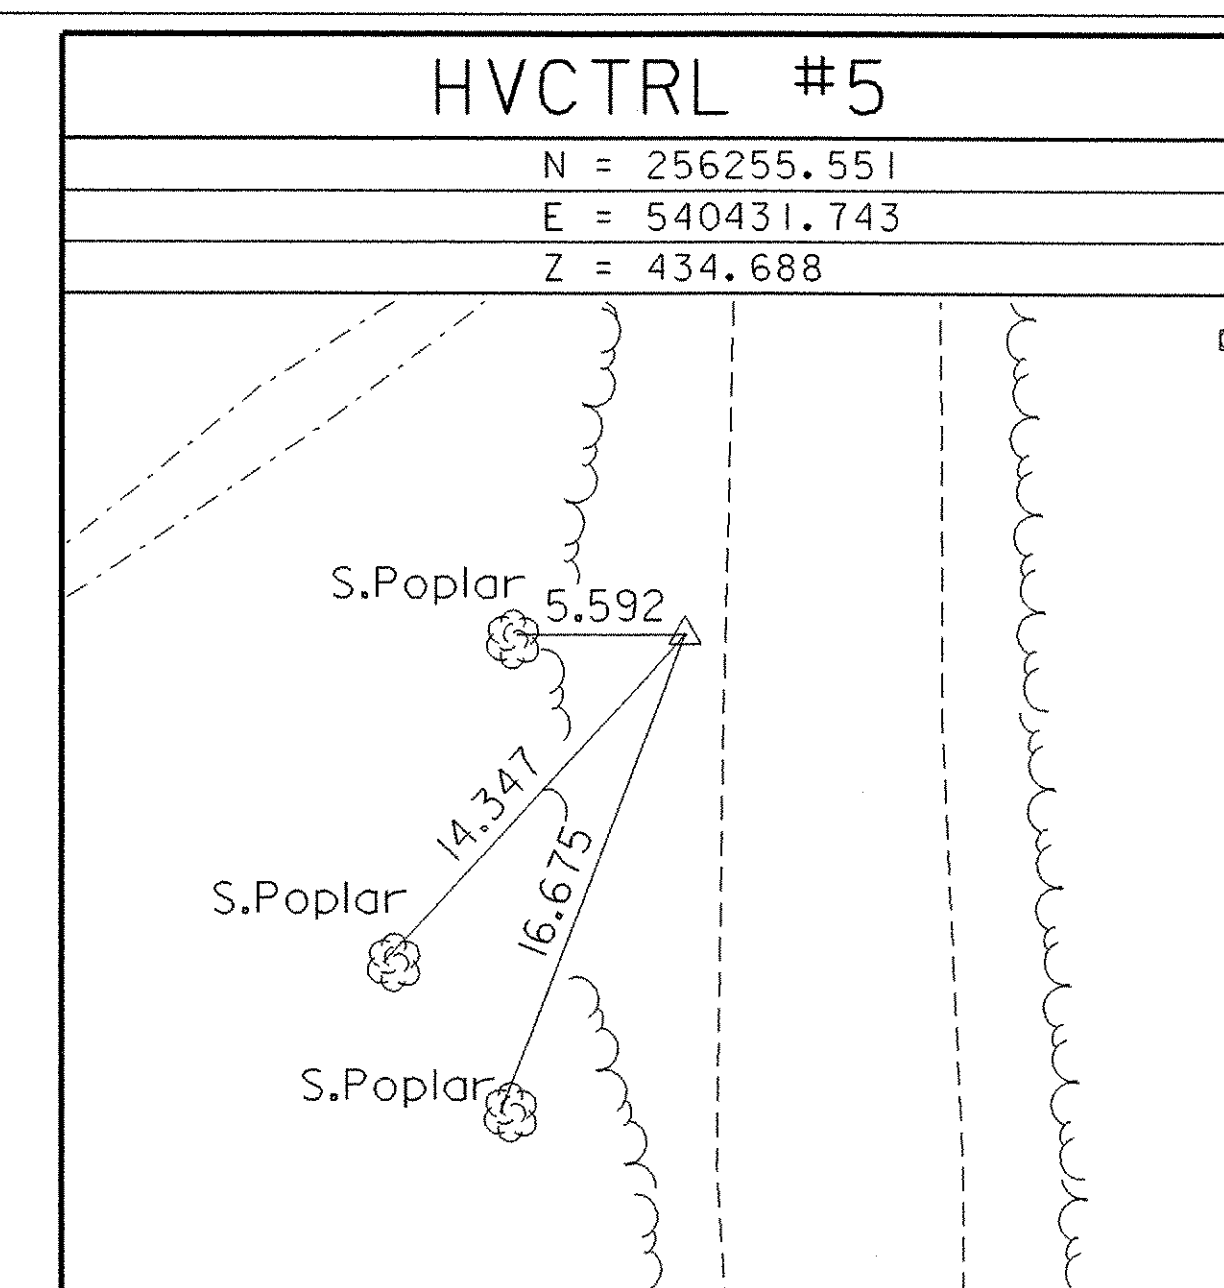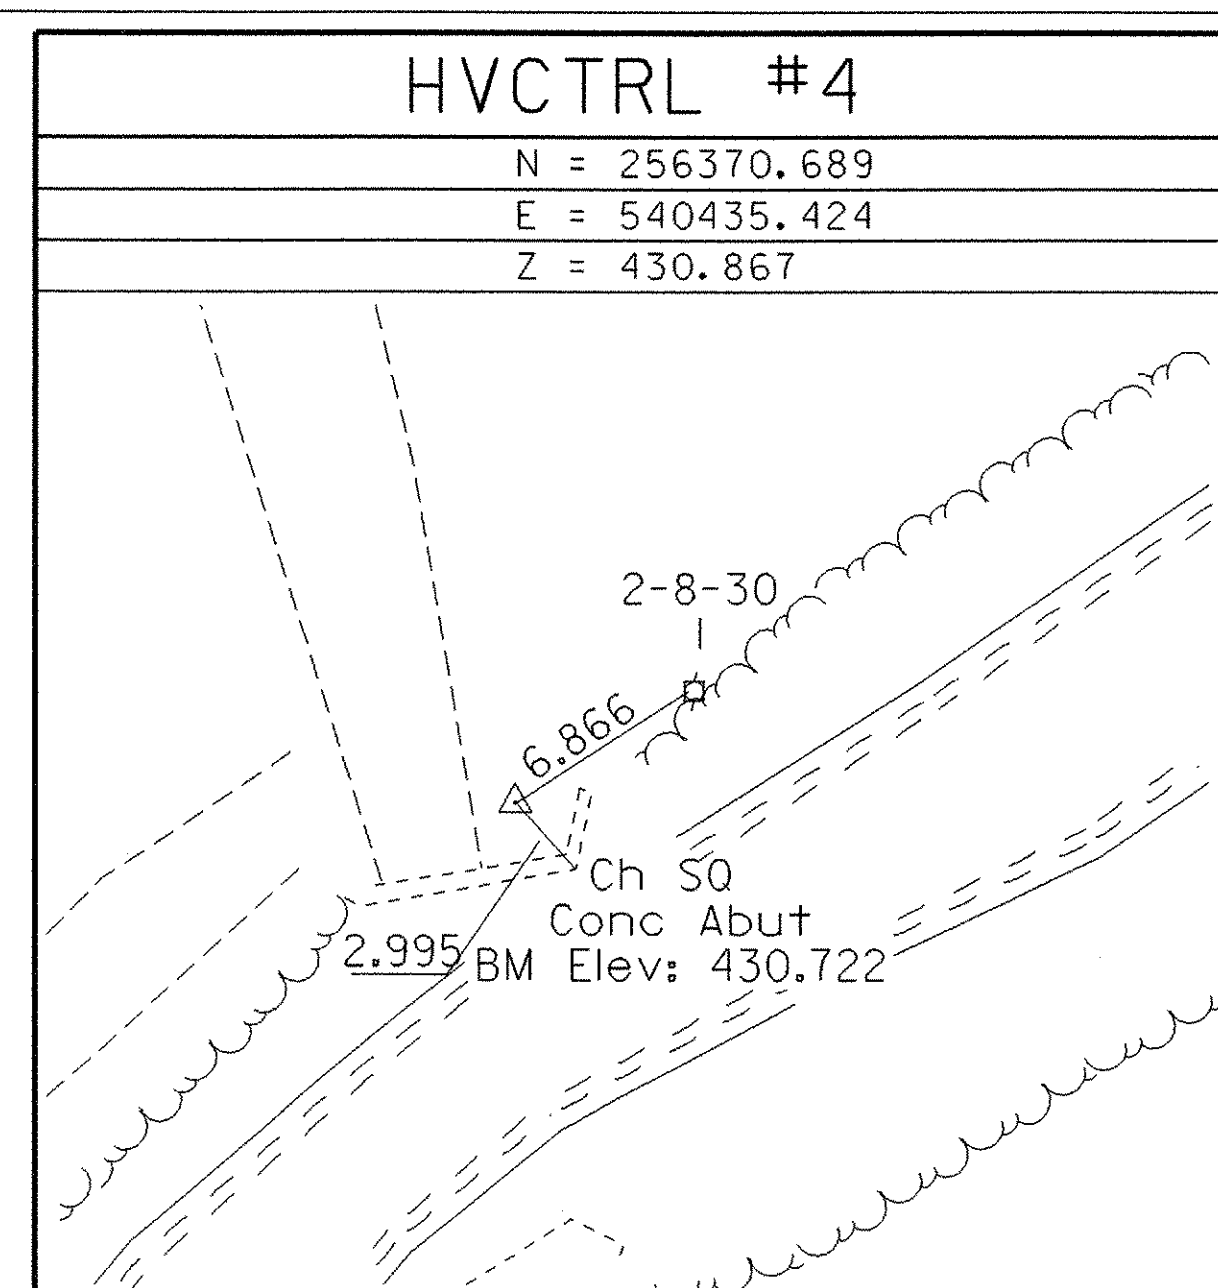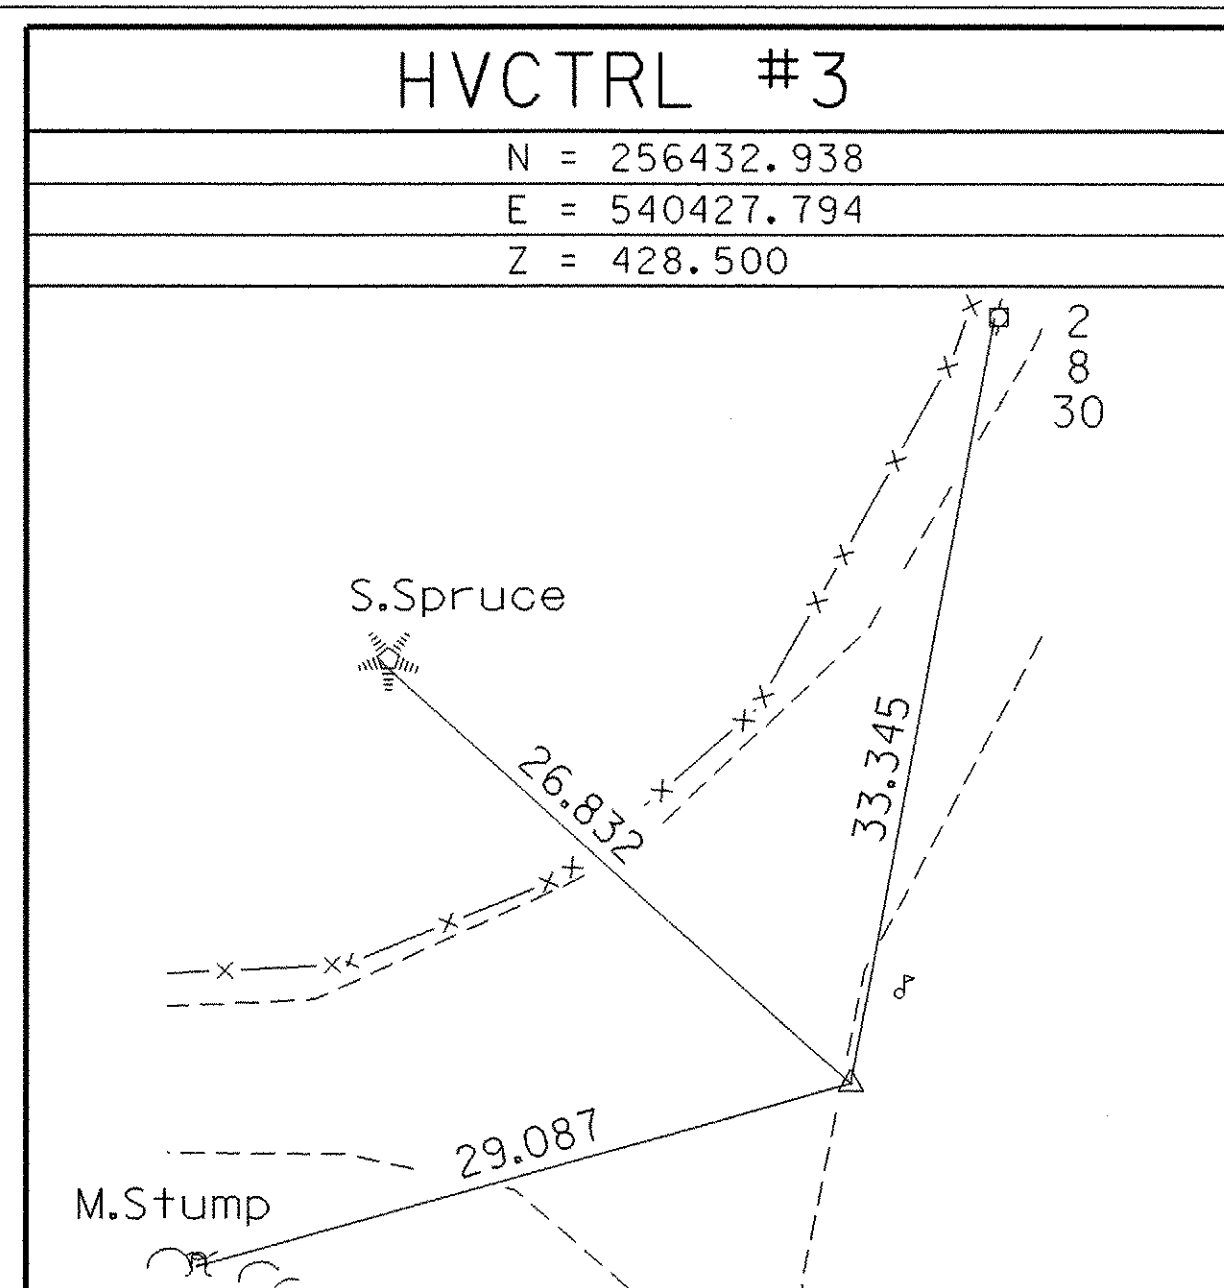

ALIGNMENT TIES

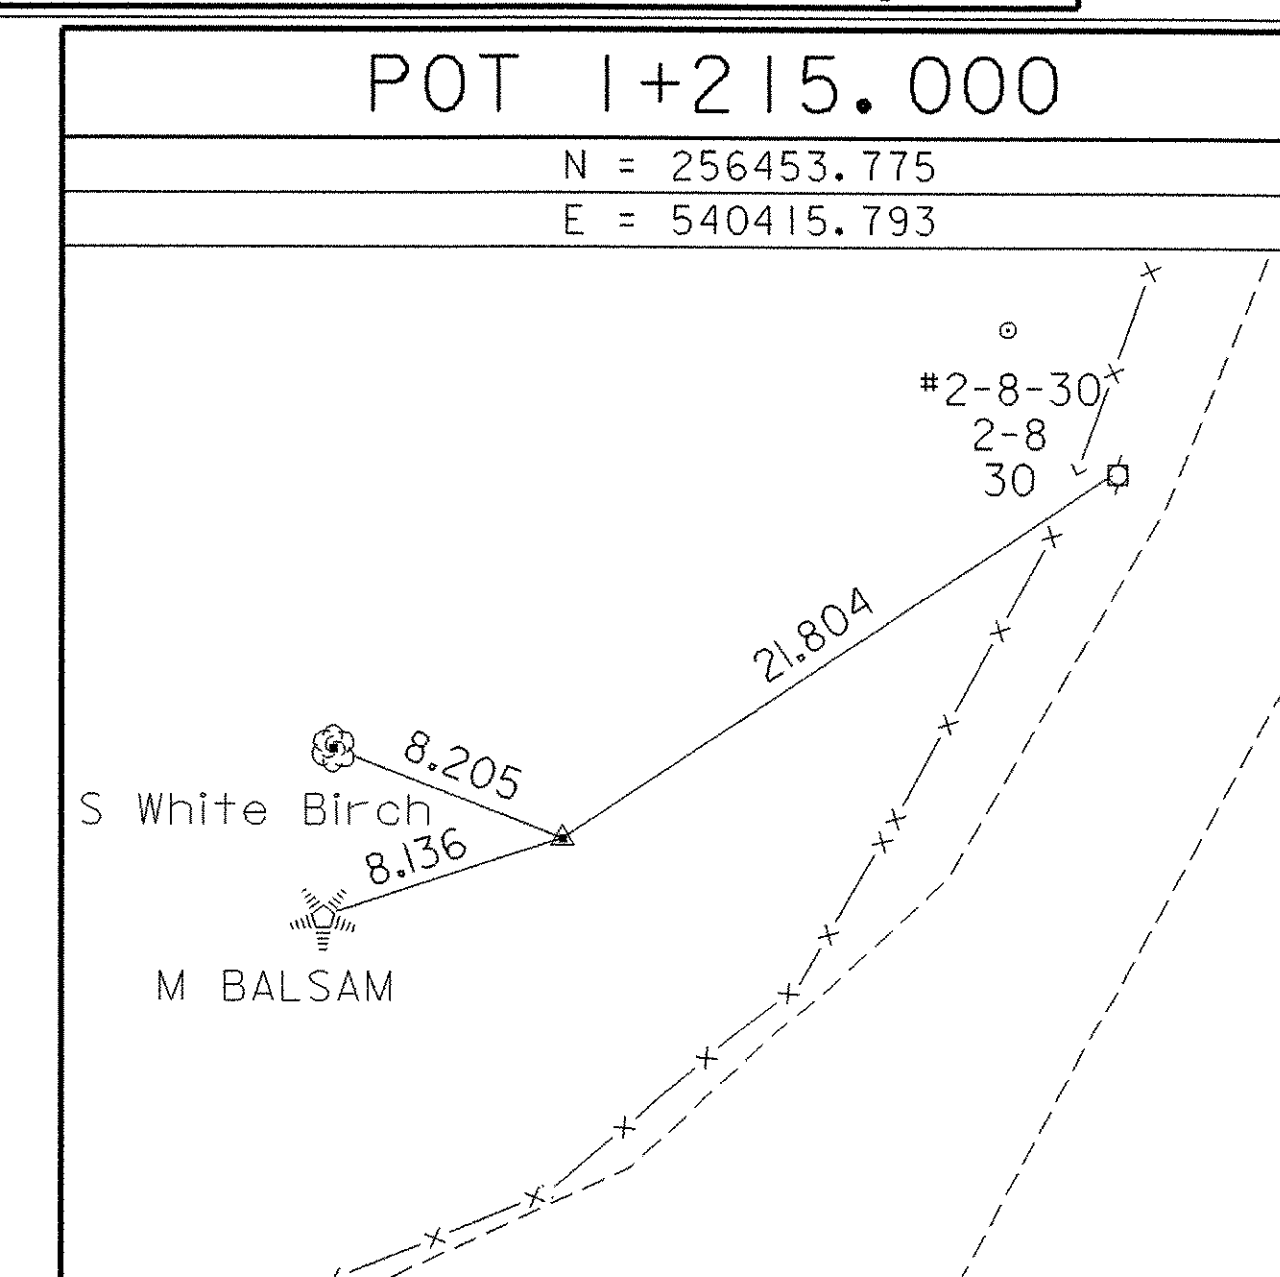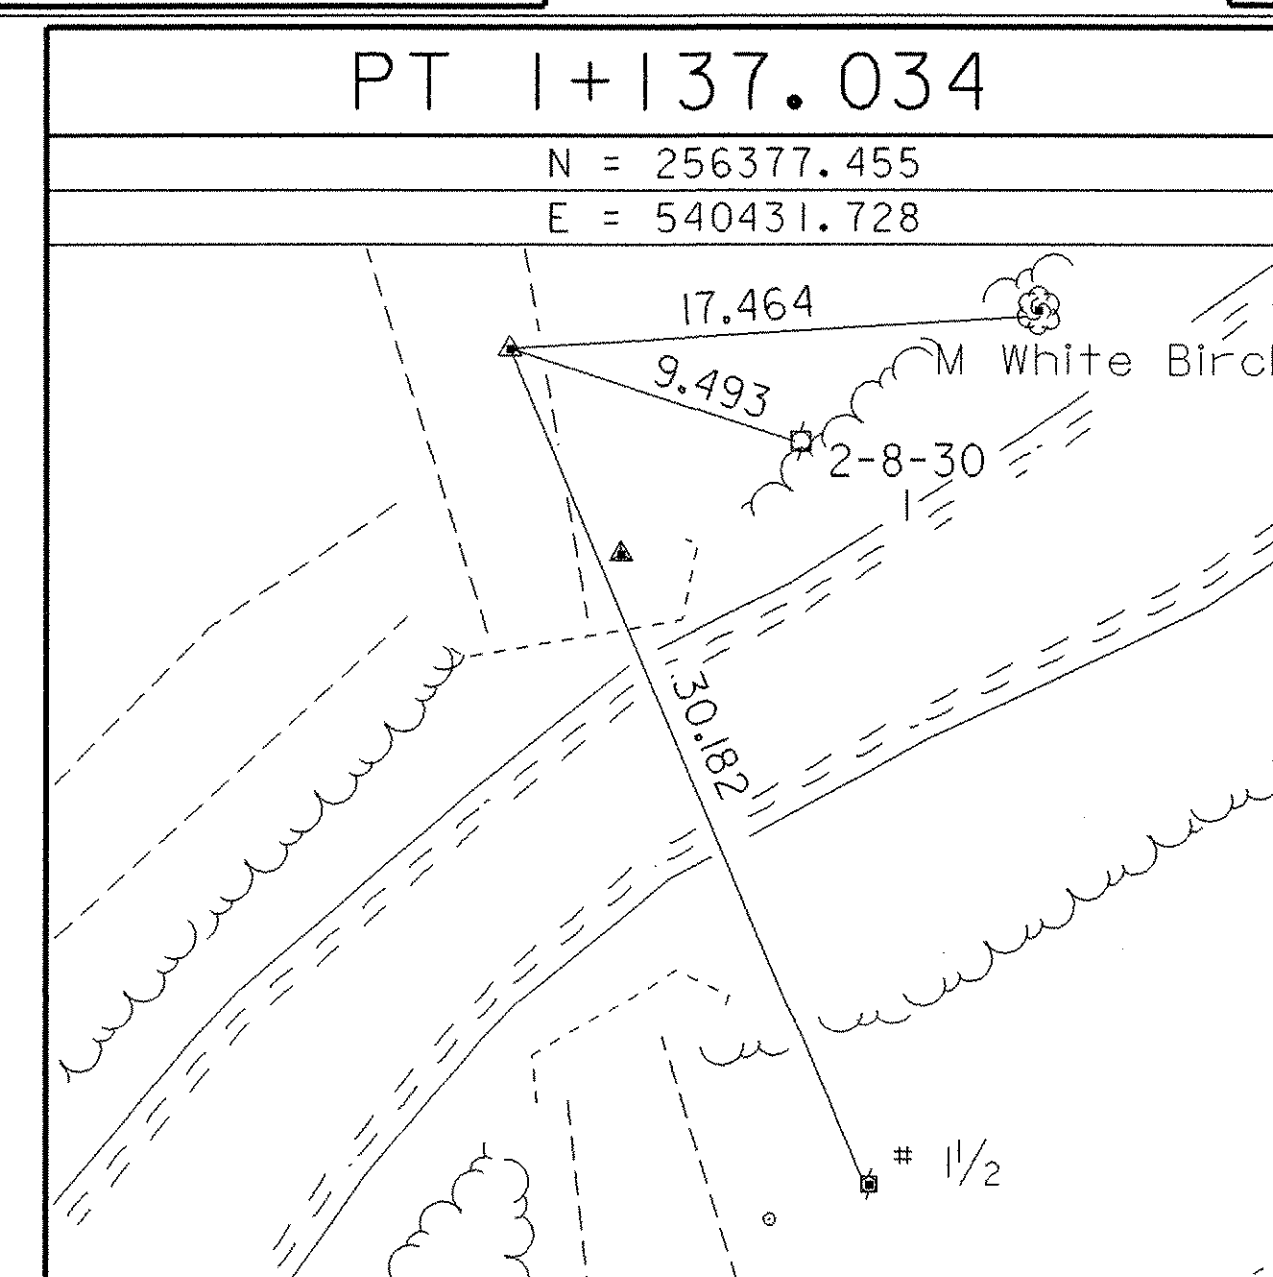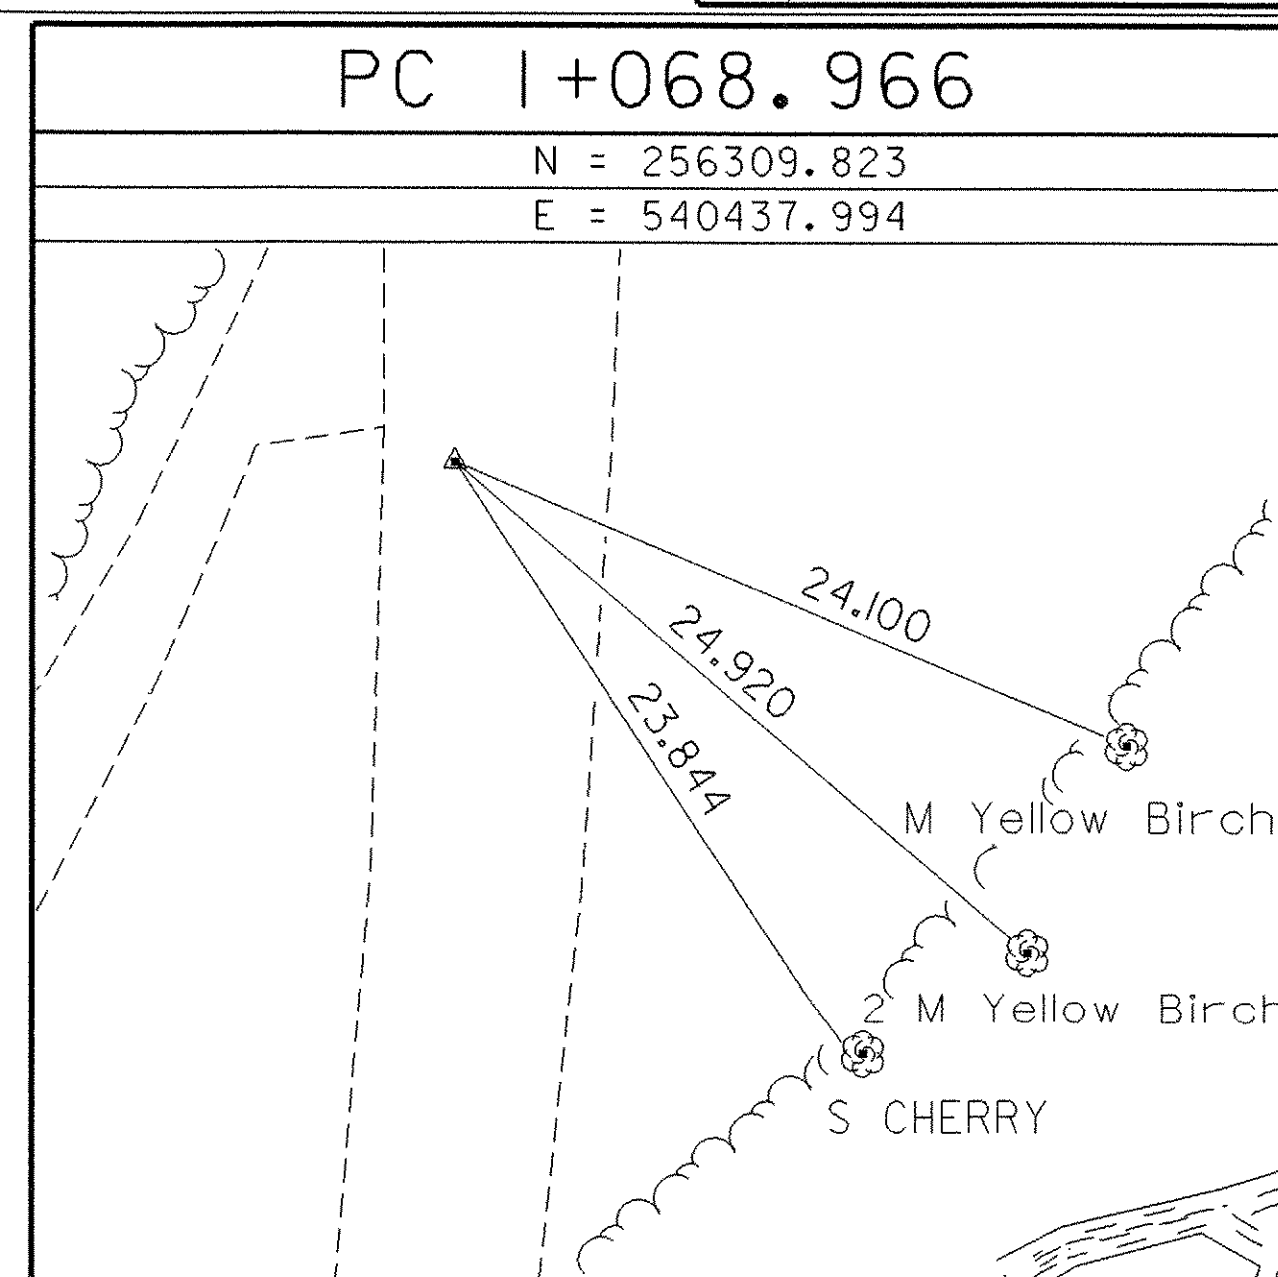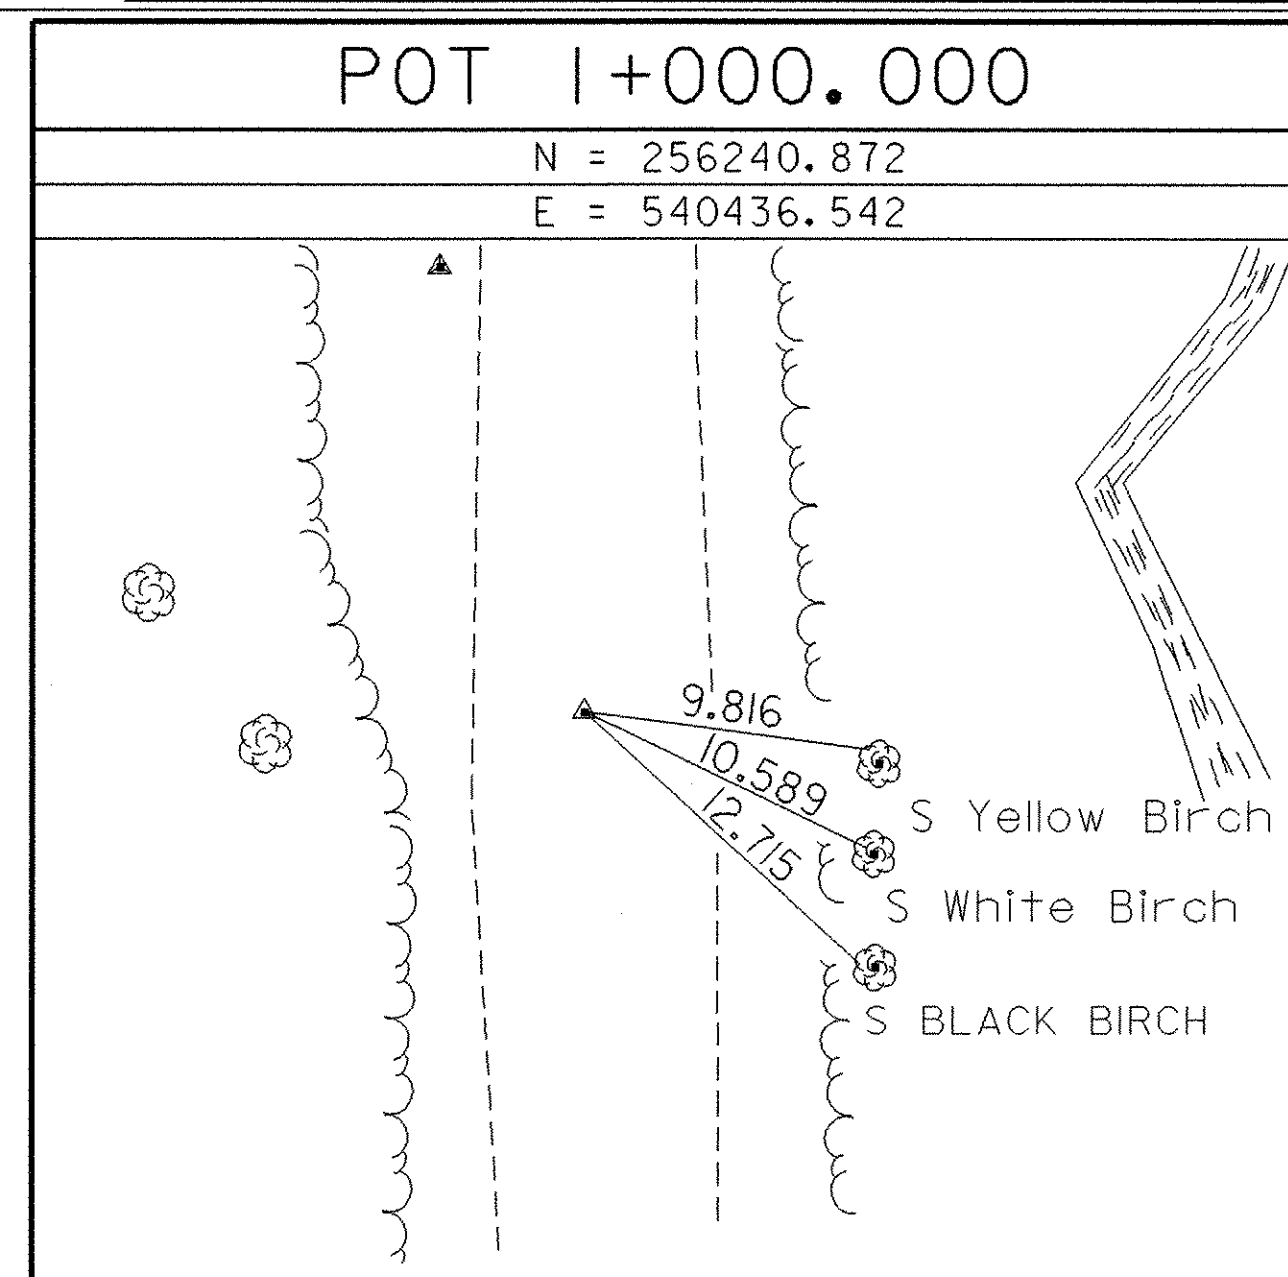

* Main Traverse completed 11/04/94 by L.Orvis P.C. & R.Bullock
* Alignment staked and Tied 12/20/05 by R.Gilman P.C. & P.Winters

DATUM
VERTICAL NAVD 88
HORIZONTAL NAD 83 (92)

TIE SHEET

PROJECT NAME: Charleston
PROJECT NUMBER: BRO 1449 (2)

FILE NAME: 93J051\survey\93J051.tie.dgn
PROJECT LEADER: M. EVANS-MONGEON
DESIGNED BY:
IPARM: sj051tie.i
PLOT DATE: 13-APR-2006
DRAWN BY: R. Bullock
CHECKED BY:
SHEET 10 OF 50