

32



REINFORCING DETAILS ABUTMENT #2

SCALE 1:250

34

TYPICAL 3&4 WINGWALL REINFORCING PLACEMENT

N.T.S.

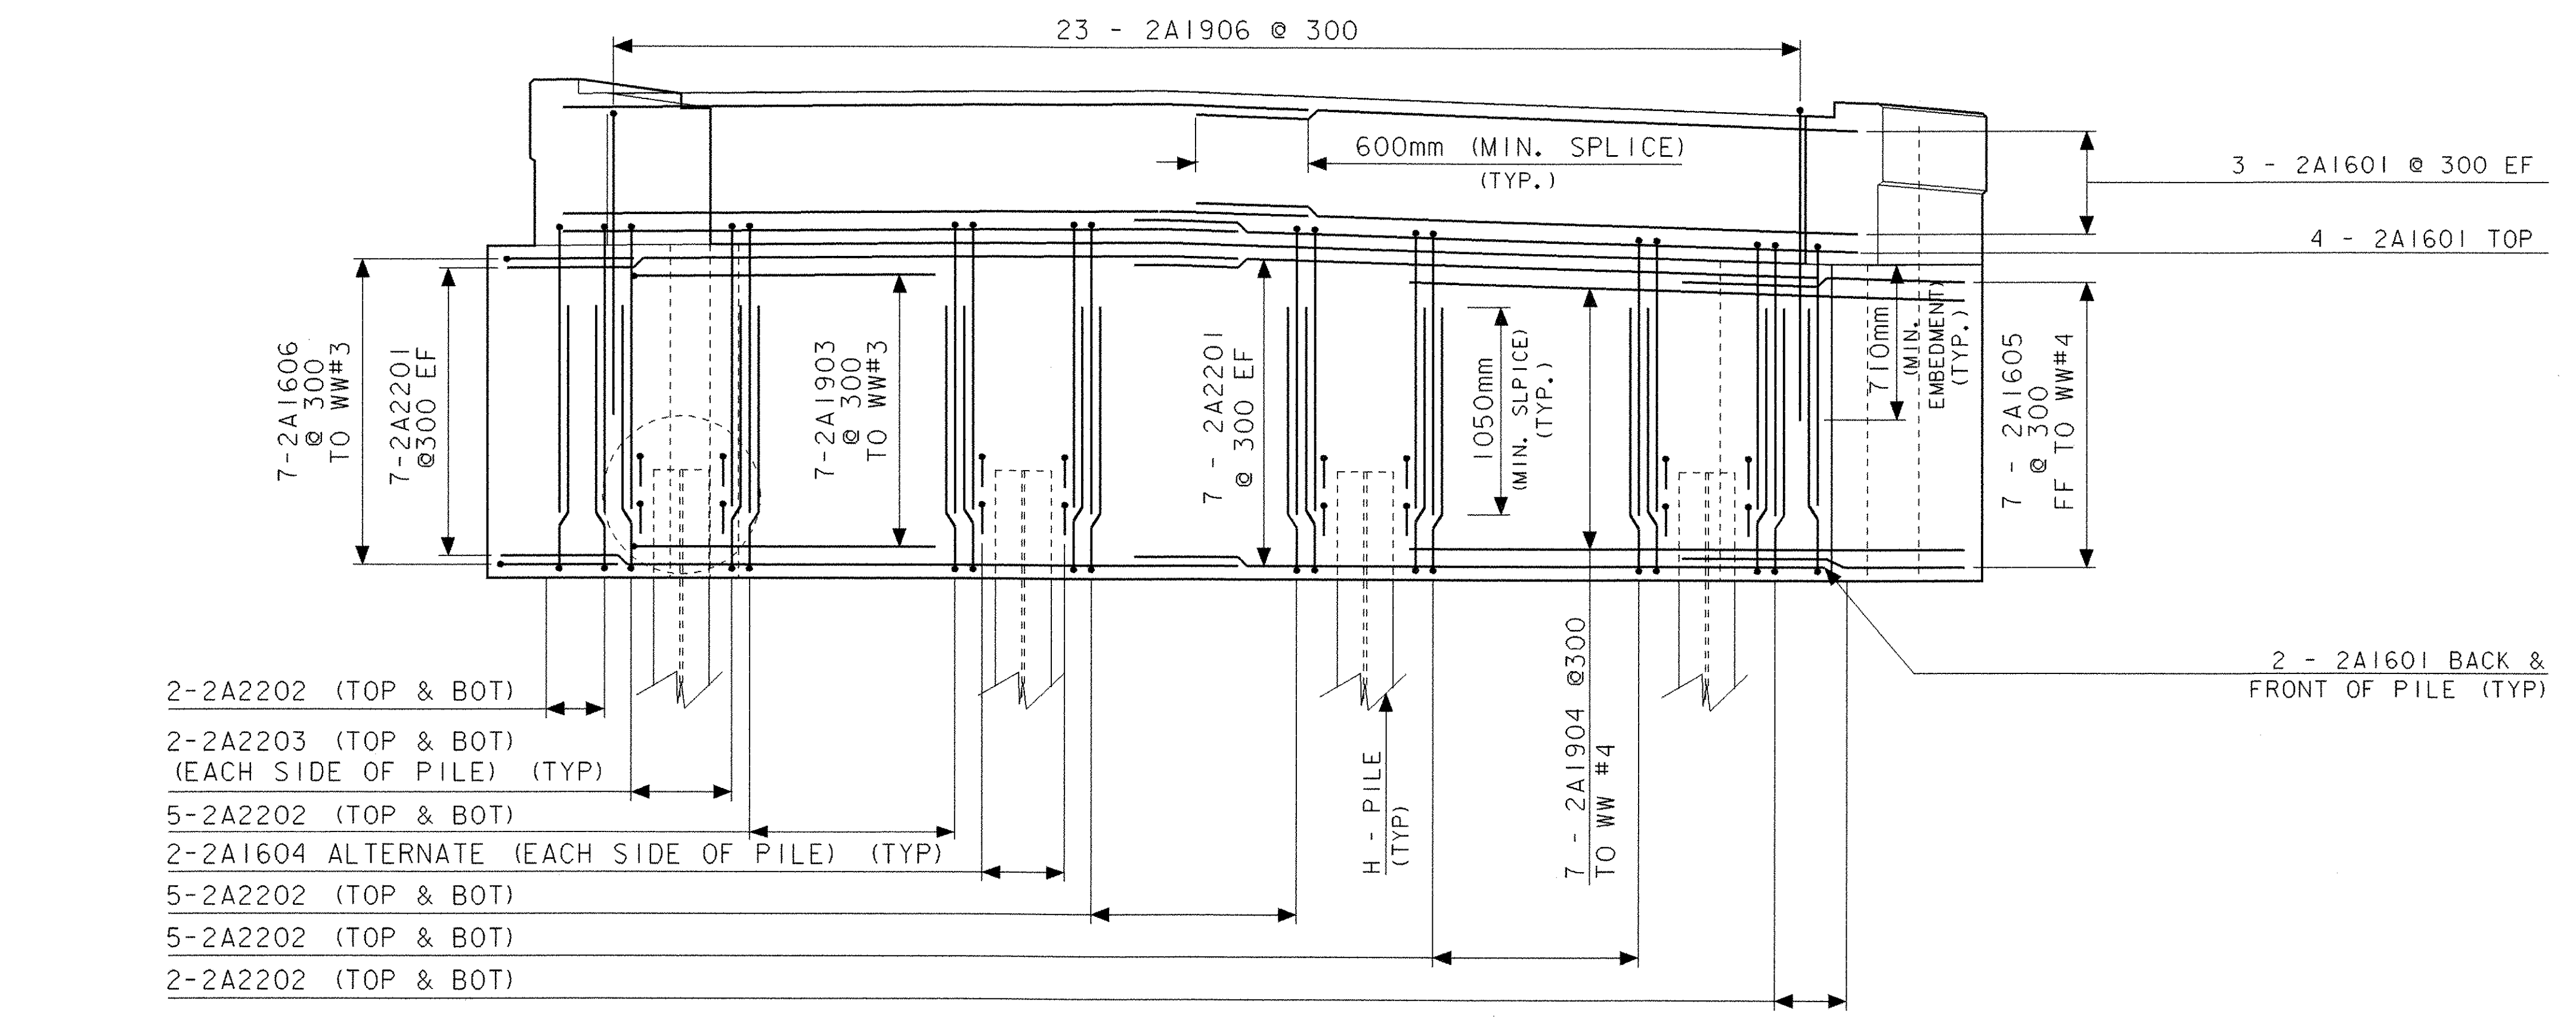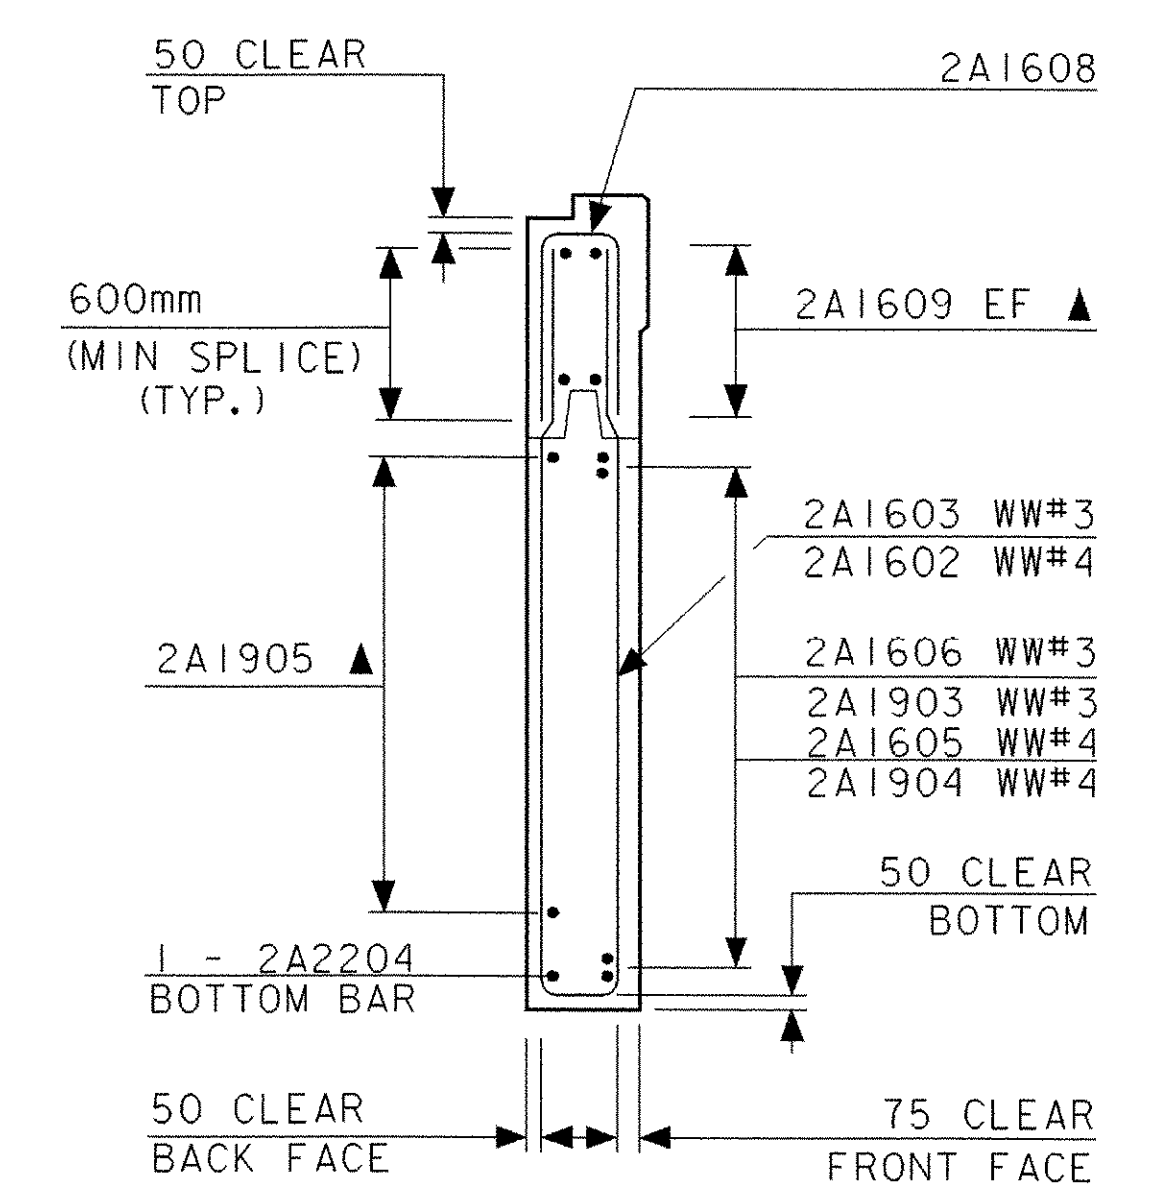

33

ELEVATION VIEW REINFORCING ABUTMENT #2

SCALE 1:250

NF - NEAR FACE
FF - FAR FACE
EF - EACH FACE

ABUTMENT #2 REINFORCING DETAILS	
PROJECT NAME:	CHARLESTON
PROJECT NUMBER:	BRO 1449 (22)
FILE NAME:	93J051/STR/sj05lab+.dgn
PROJECT MANAGER:	M. EVANS-MONGEON
DESIGNED BY:	G. COLGROVE
IPARM:	sj05labr2.i
PLOT DATE:	13-APR-2006
DRAWN BY:	G. ROKES
CHECKED BY:	S. SCRIBNER
SHEET 39 OF 50	