


STATE OF VERMONT AGENCY OF TRANSPORTATION

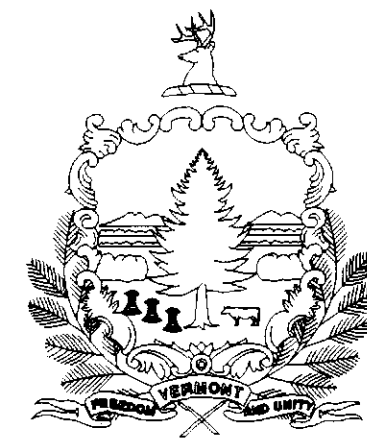


PROPOSED IMPROVEMENT TOWN OF GUILFORD COUNTY OF WINDHAM

ROUTE NO : T.H. 13 CLASS 3 BRIDGE NO : 56



PROJECT LOCATION : BEGINNING ON T.H. 13, 0.1 KILOMETER WEST OF THE EXISTING INTERSECTION OF T.H. 1 AND T.H. 13 AND PROCEEDING SOUTH-EASTERLY 0.8 KILOMETER ALONG REALIGNED T.H. 13.

PROJECT DESCRIPTION : THE PROJECT WILL REPLACE THE EXISTING BRIDGE WITH A NEW CONCRETE SLAB BRIDGE ON A NEW ALIGNMENT AND INCLUDE RELATED APPROACH ROADWAY AND CHANNEL WORK.

LENGTH OF STRUCTURE : 9.000 METERS.
LENGTH OF ROADWAY : 72.770 METERS.
LENGTH OF PROJECT : 81.770 METERS.

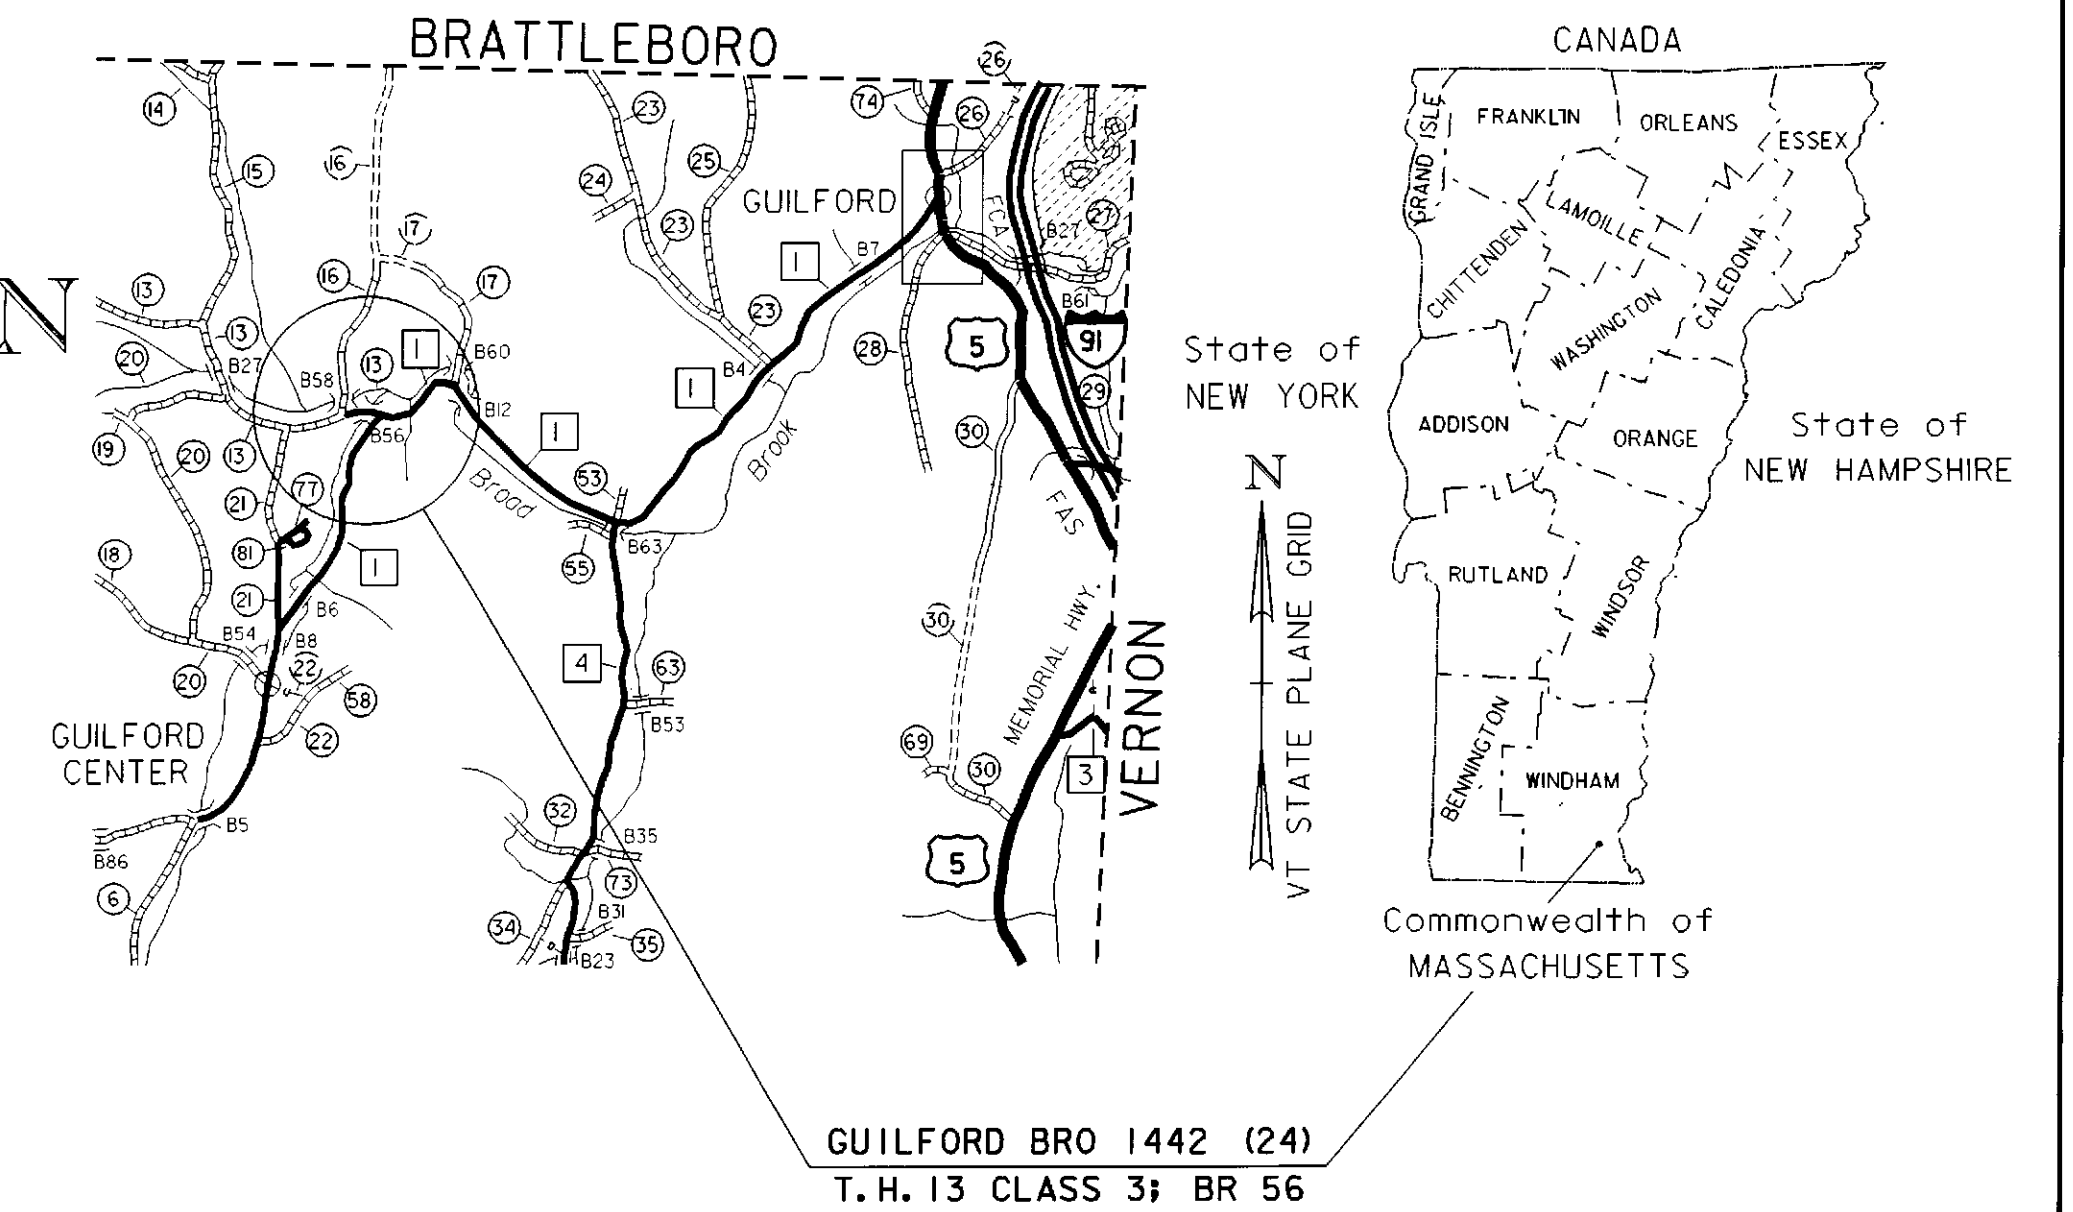

RECORD PLANS	
CONTRACTOR:	RENAUD BROTHERS, INC. - VERNON, VT
RESIDENT ENGINEER:	FRED ROSS
CONSTRUCTION BEGAN:	JULY 21, 2008
CONSTRUCTION COMPLETE:	JULY 19, 2009
RECORD PLANS BY:	FRED ROSS & CRAIG PIERCE
I HEREBY CERTIFY THAT ALL THE CONSTRUCTION REQUIRED BY THIS SET OF DRAWINGS HAS BEEN ACCOMPLISHED AS INDICATED HEREIN.	
BY:	<i>[Signature]</i> RESIDENT ENGINEER
DATE:	7-25-11
NOTE: Any further information concerning final quantities, amounts or other details relative to this project may be found at Central Files in the electronic archives.	

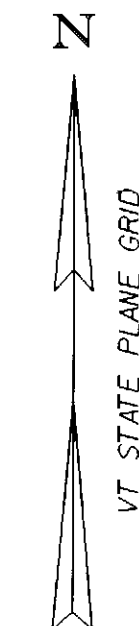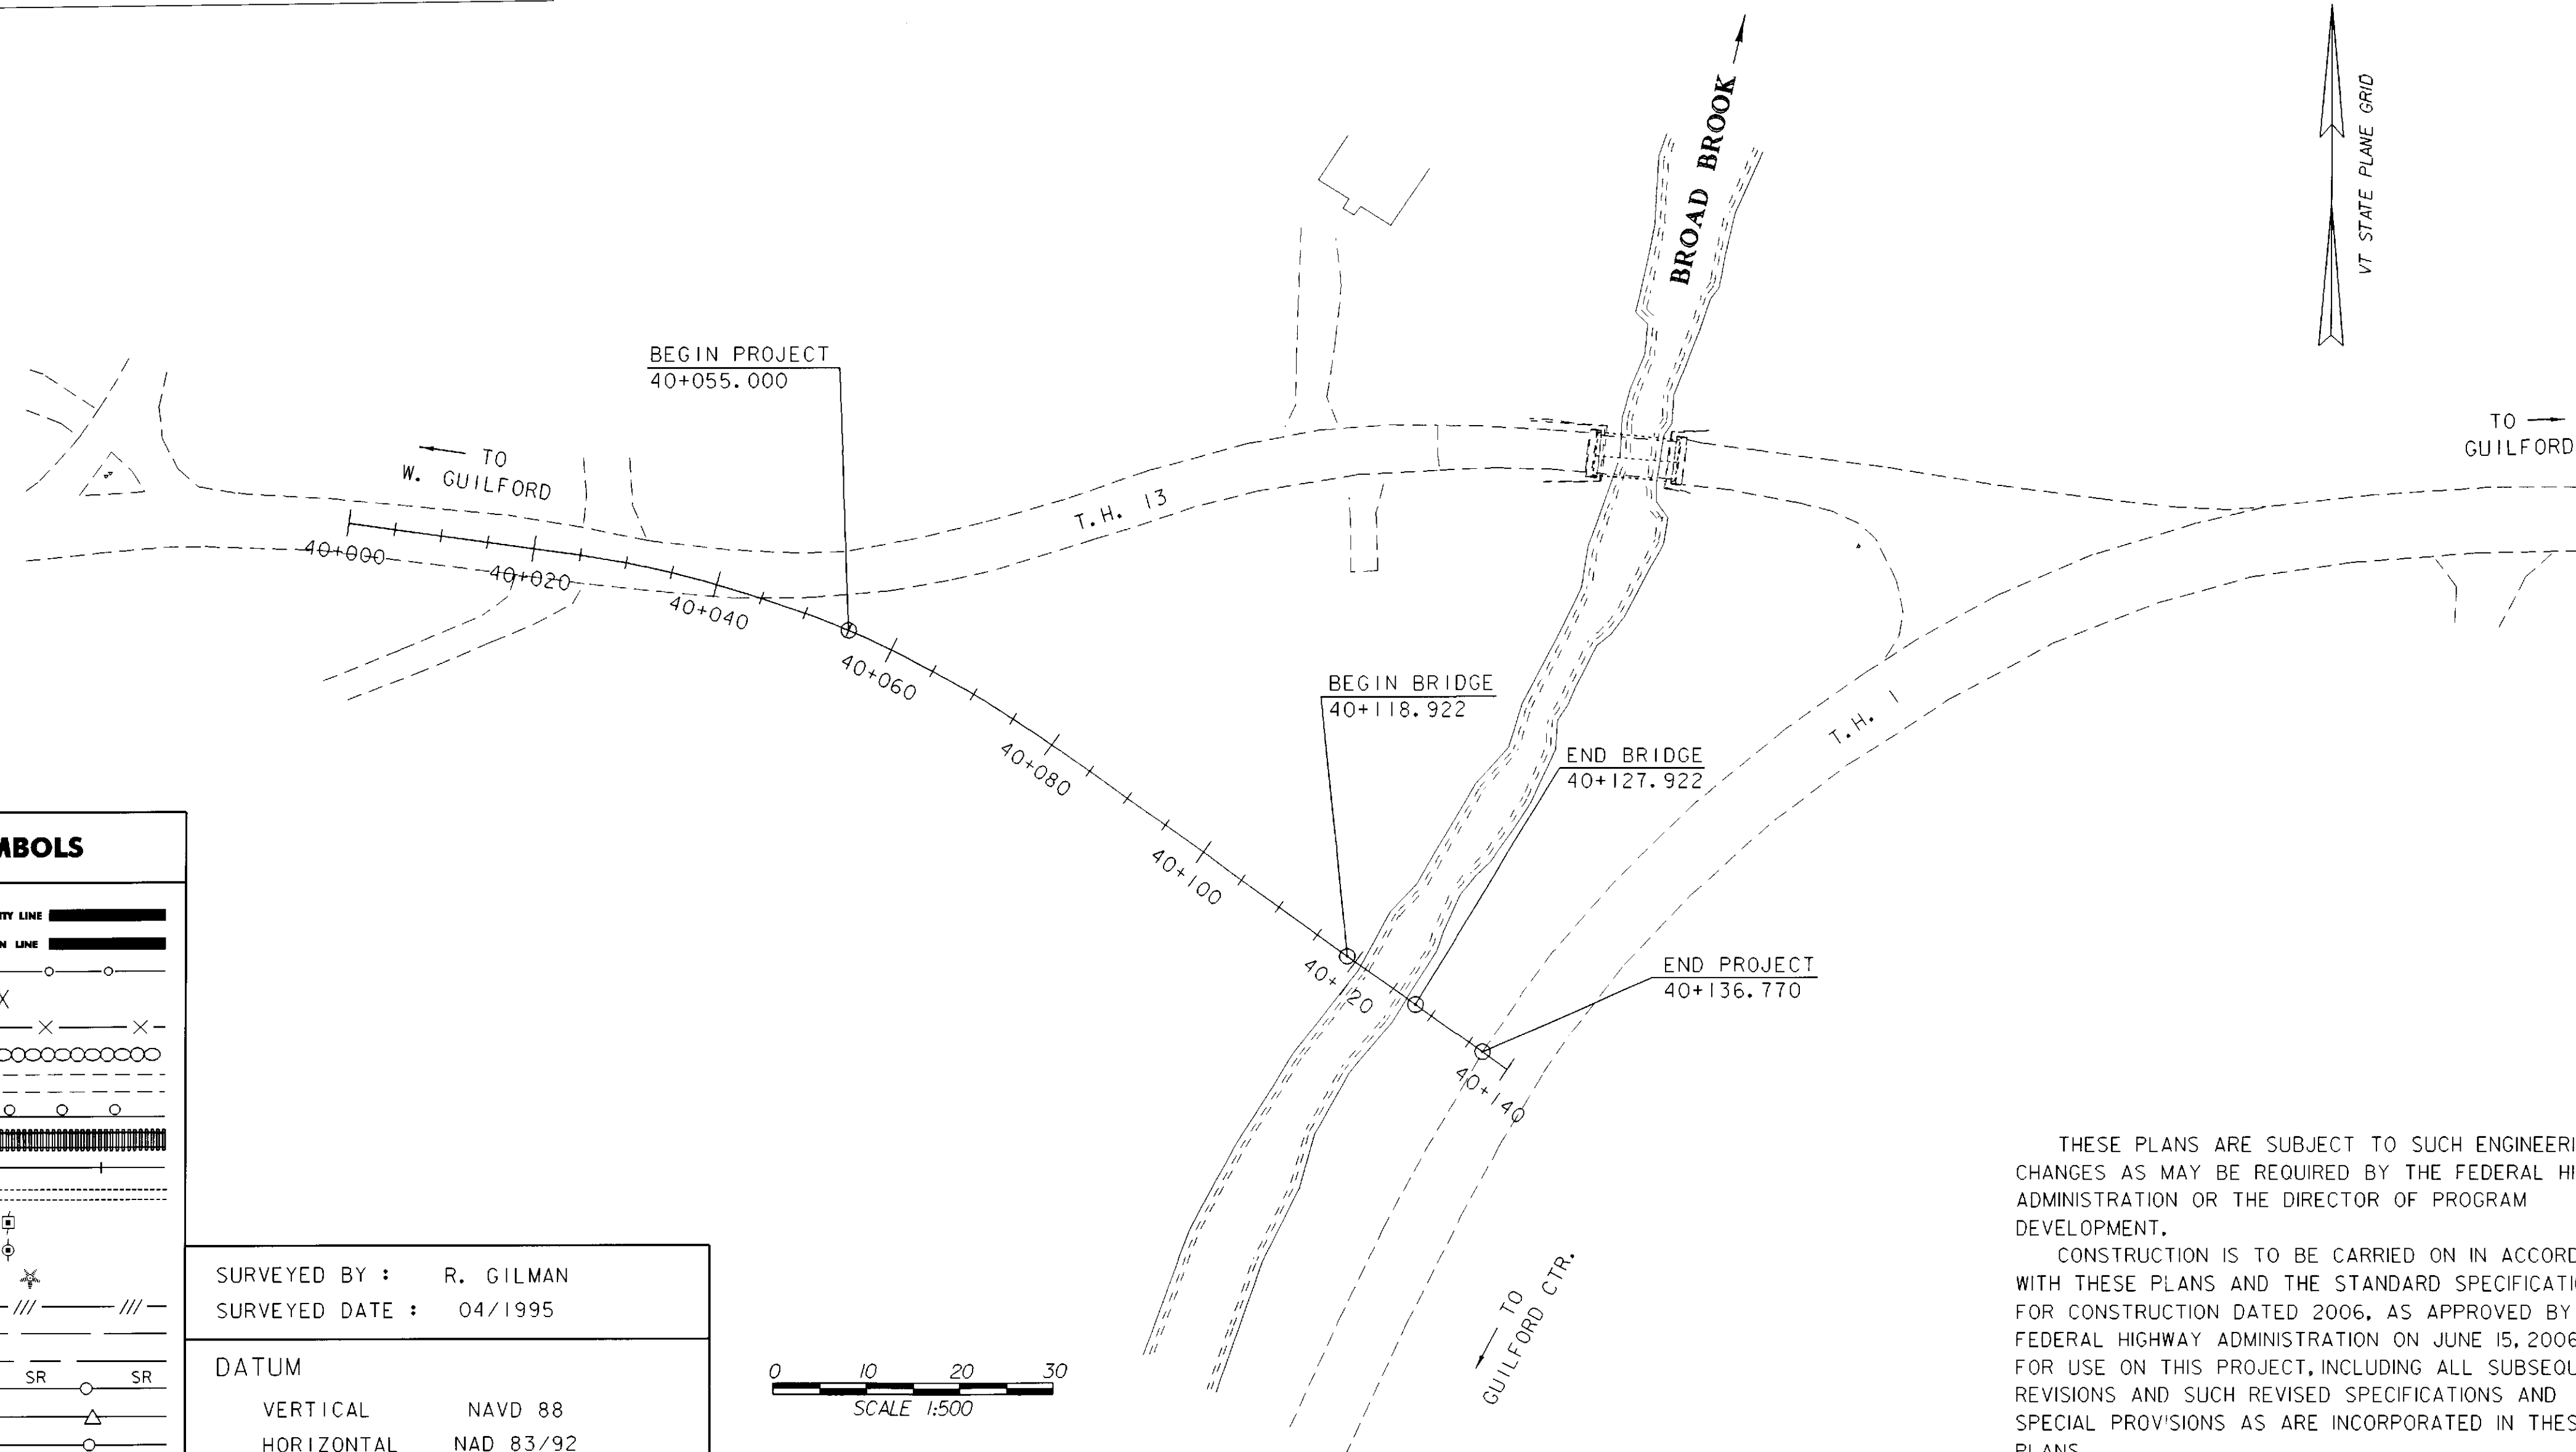


CONVENTIONAL SYMBOLS

COUNTY LINE	
TOWN LINE	
LIMITS OF ACCESS	
POINT OF ACCESS	
FENCE LINE	
STONE WALL	
TRAVELED WAY	
GUARD RAIL	
RAILROAD	
SURVEY LINE	
CULVERT	
POWER POLE	
TELEPHONE POLE	
TREES	
CONTROL OF ACCESS	
PROPERTY LINE	
R.O.W. TAKING LINE	
SLOPE RIGHTS	
TOP OF CUT	
TOE OF SLOPE	

SURVEYED BY : R. GILMAN
SURVEYED DATE : 04/1995

DATUM
VERTICAL NAVD 88
HORIZONTAL NAD 83/92

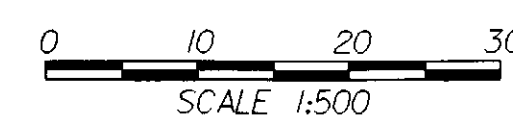

UNLESS NOTED OTHERWISE
STATIONS ARE IN KILOMETERS
ELEVATIONS ARE IN METERS
DIMENSIONS ARE IN MILLIMETERS

THESE PLANS ARE SUBJECT TO SUCH ENGINEERING CHANGES AS MAY BE REQUIRED BY THE FEDERAL HIGHWAY ADMINISTRATION OR THE DIRECTOR OF PROGRAM DEVELOPMENT.

CONSTRUCTION IS TO BE CARRIED ON IN ACCORDANCE WITH THESE PLANS AND THE STANDARD SPECIFICATIONS FOR CONSTRUCTION DATED 2006, AS APPROVED BY THE FEDERAL HIGHWAY ADMINISTRATION ON JUNE 15, 2006 FOR USE ON THIS PROJECT, INCLUDING ALL SUBSEQUENT REVISIONS AND SUCH REVISED SPECIFICATIONS AND SPECIAL PROVISIONS AS ARE INCORPORATED IN THESE PLANS.

DIRECTOR OF PROGRAM DEVELOPMENT	
APPROVED: <i>[Signature]</i>	DATE: 3-10-2011
PROJECT MANAGER : R. R. WHITCOMB	
PROJECT NAME : GUILFORD	
PROJECT NUMBER : BRO 1442 (24)	
SHEET 1 OF 59 SHEETS	