
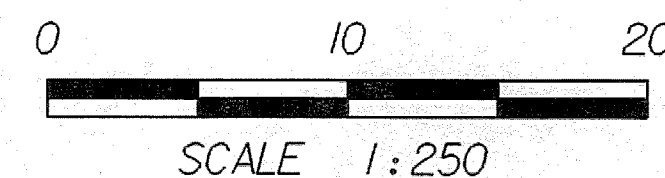


~~ELIMINATED~~
~~STEEL BEAM GUARD RAIL, GALVANIZED~~
~~CHAN 50+123.7 RT CHAN 50+140.6 RT~~

ANCHOR FOR STEEL BEAM RAIL
 CHAN 50+138.3 RT
 +066

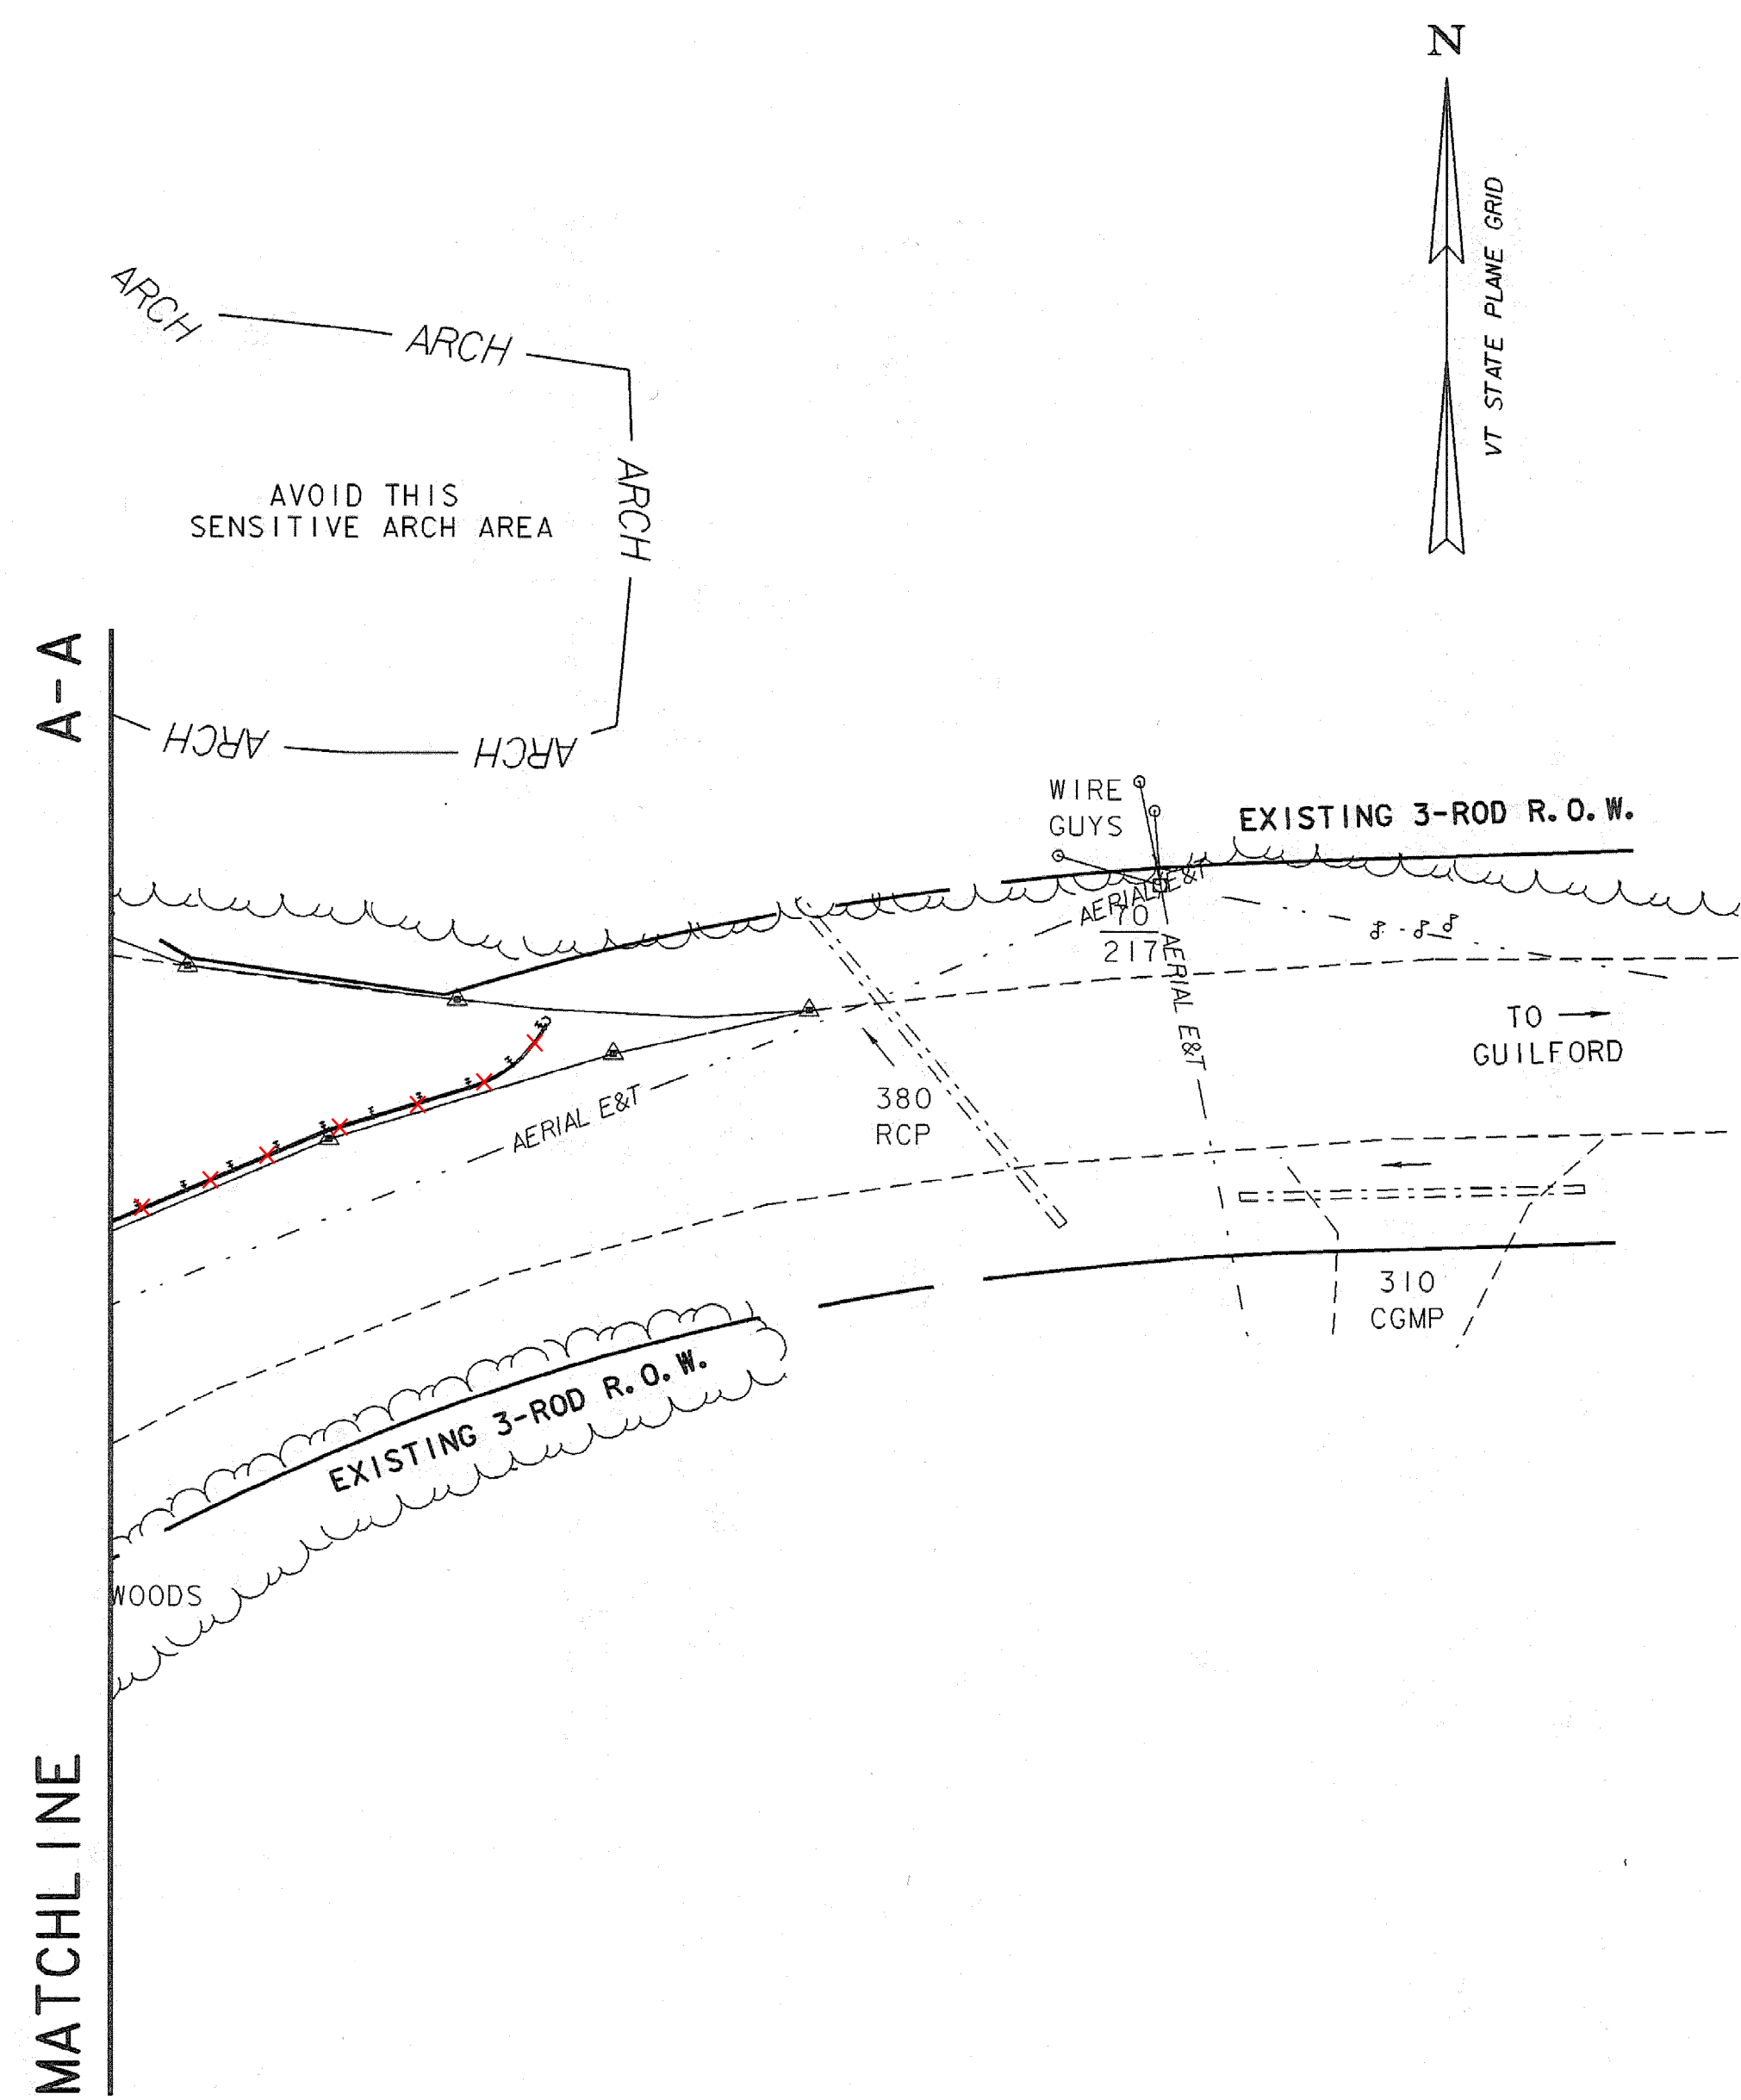

LAYOUT PLAN 2

PROJECT NAME: GUILFORD	PLOT DATE: 15-APR-2008
PROJECT NUMBER: BRO 1442(24)	DRAWN BY: L. BULLOCK
FILE NAME: sj076102.i	CHECKED BY: T. LACKEY
PROJECT LEADER: R. WHITCOMB	SHEET 14 OF 59
DESIGNED BY: J. PERRIGO	
94J076\Structures\sj076bdr.dgn	