


Profile

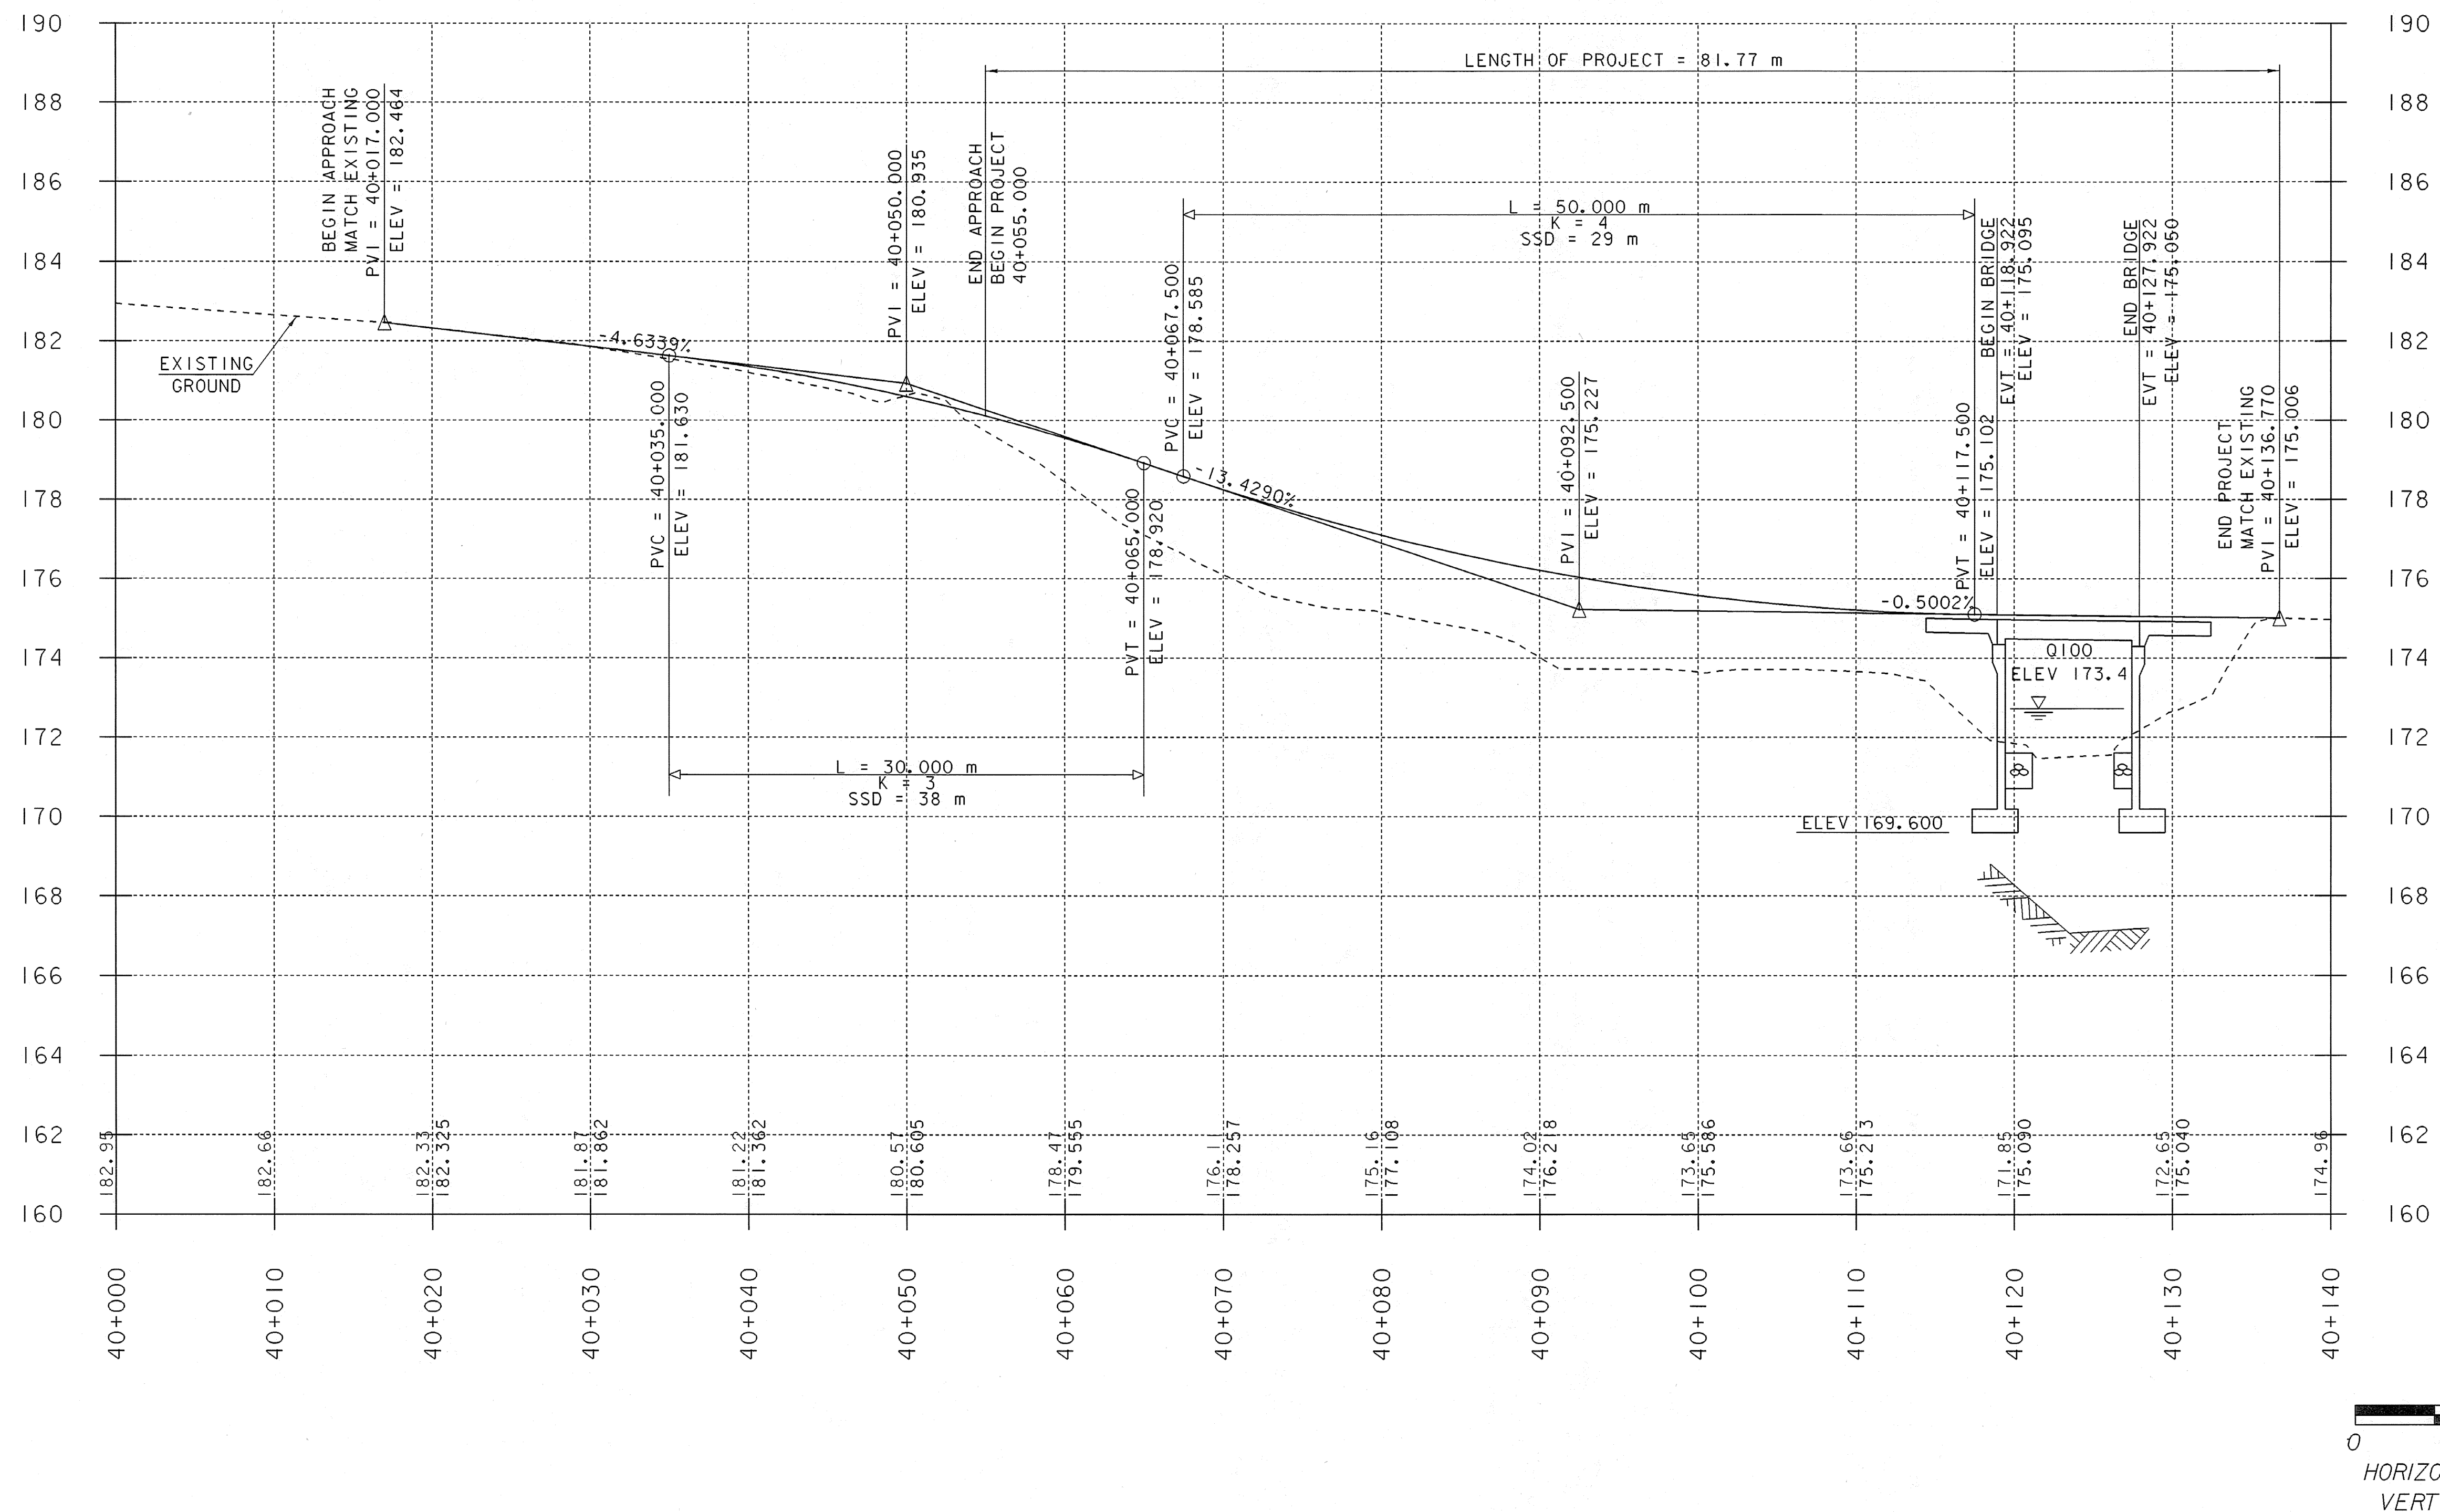

MAINLINE PROFILE

NOTES:

- ELEVATIONS SHOWN TO THE NEAREST HUNDREDTH METER ARE EXISTING GROUND ALONG CENTERLINE.
- ELEVATIONS SHOWN TO THE NEAREST THOUSANDTH METER ARE FINAL GRADE ALONG CENTERLINE.

PROJECT NAME:	GUILFORD	PLOT DATE:	15-APR-2008
PROJECT NUMBER:	BRO 1442(24)	DRAWN BY:	T. LACKEY
FILE NAME:	sj076pfl1	DESIGNED BY:	T. LACKEY
PROJECT LEADER:	R. WHITCOMB	CHECKED BY:	J. PERRIGO
94\076\Structures\sj076xs3.dgn		SHEET	15 OF 59