







40 MEDIUM DUTY BITUMINOUS CONCRETE PAVEMENT, TYPE III OR IV (PG 58-28)
 40 MEDIUM DUTY BITUMINOUS CONCRETE PAVEMENT, TYPE III OR IV (PG 58-28)
 75 MEDIUM DUTY BITUMINOUS CONCRETE PAVEMENT, TYPE I OR II (PG 58-28)

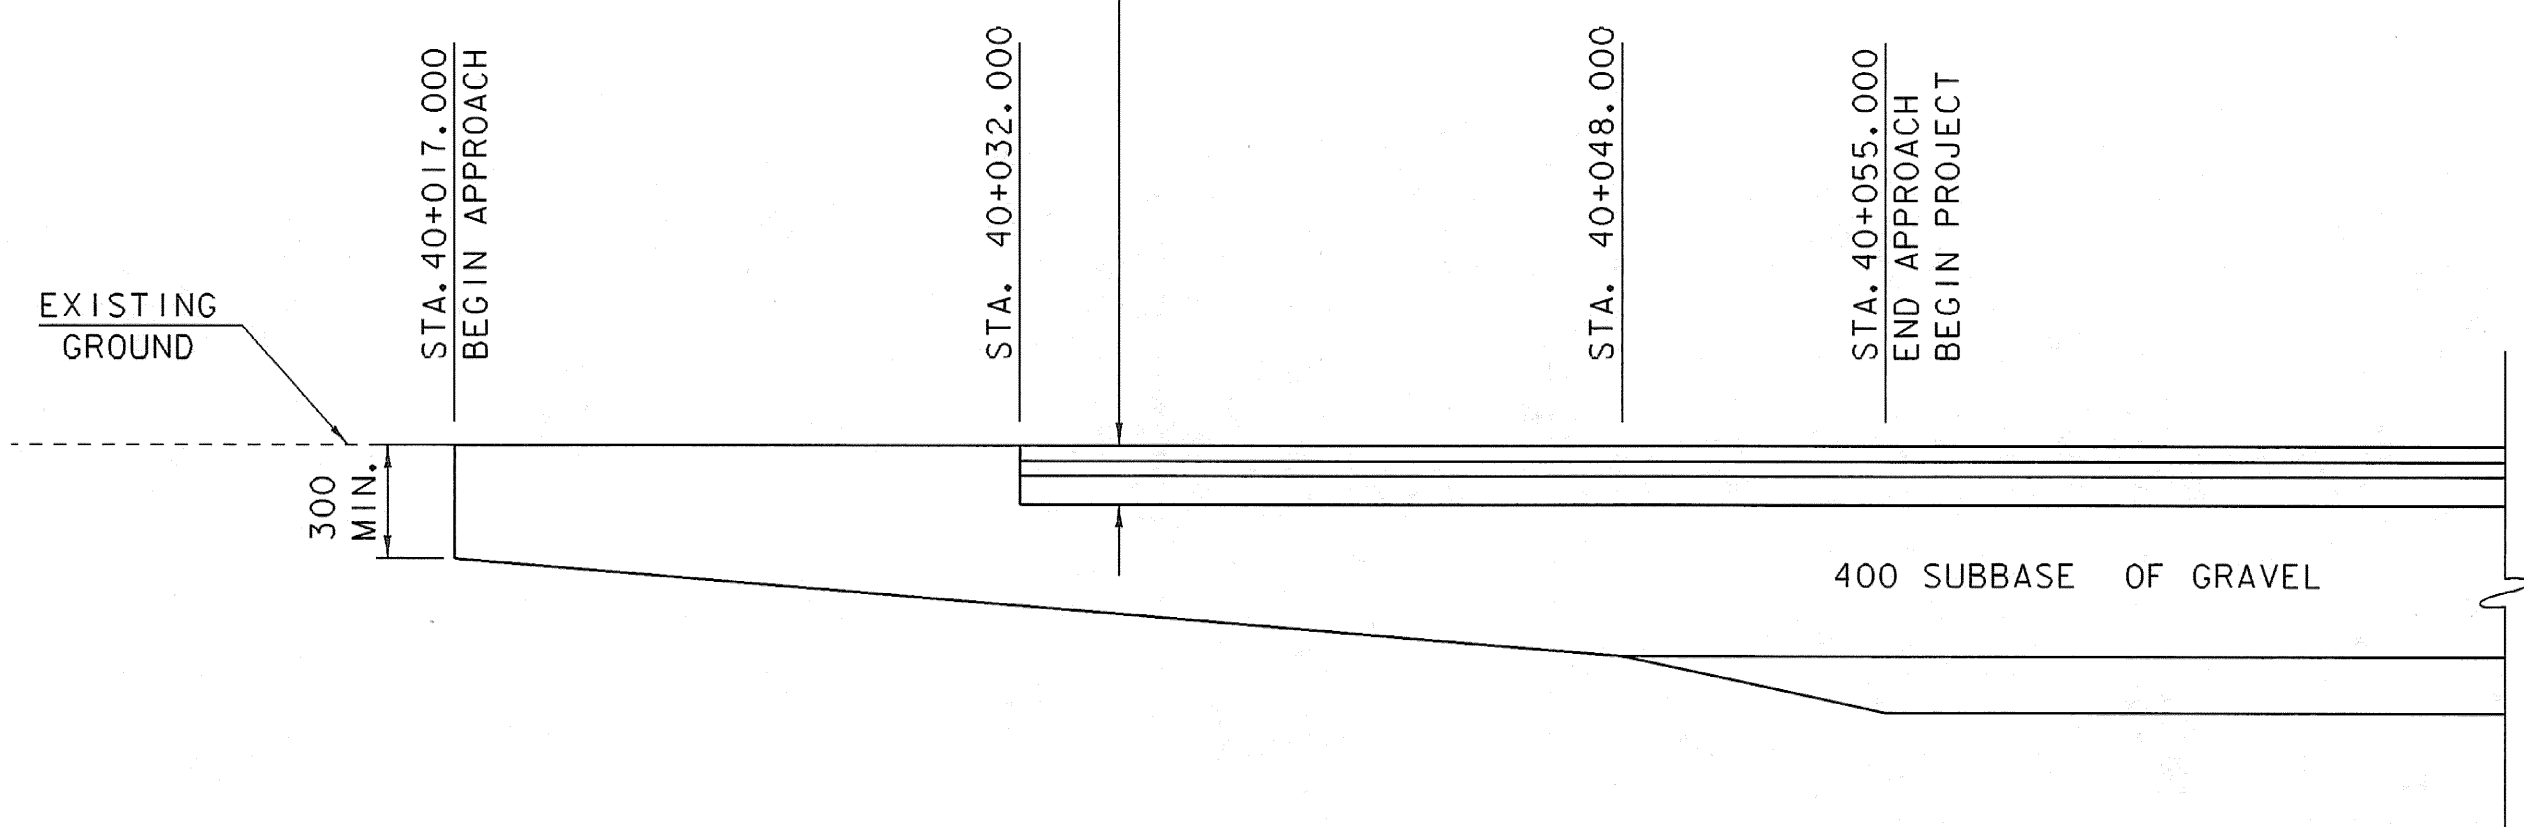

TH 13

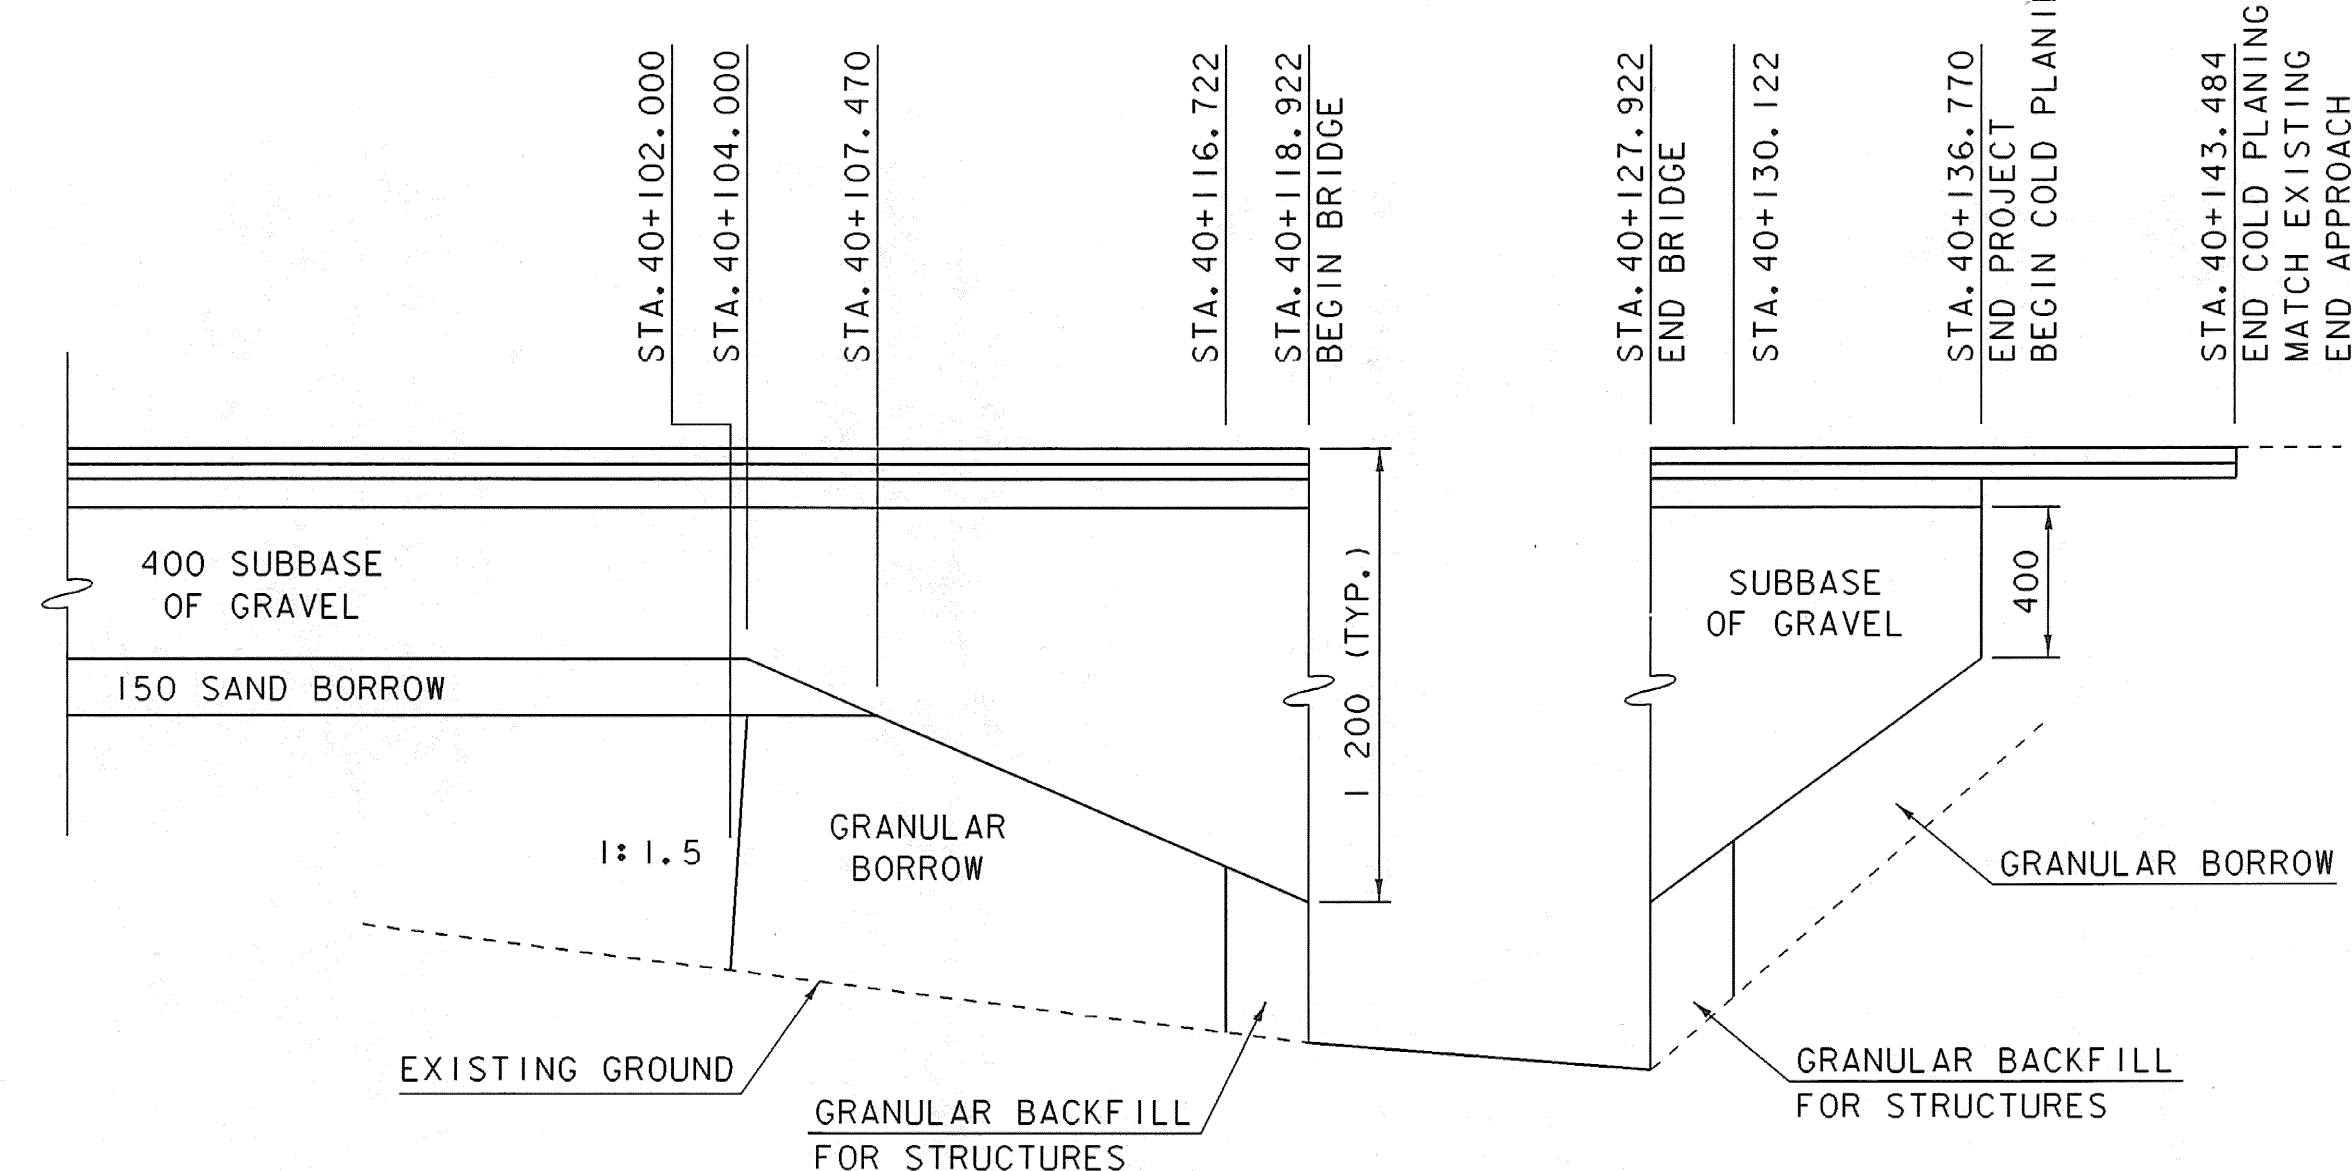

MATERIAL TRANSITION DETAILS

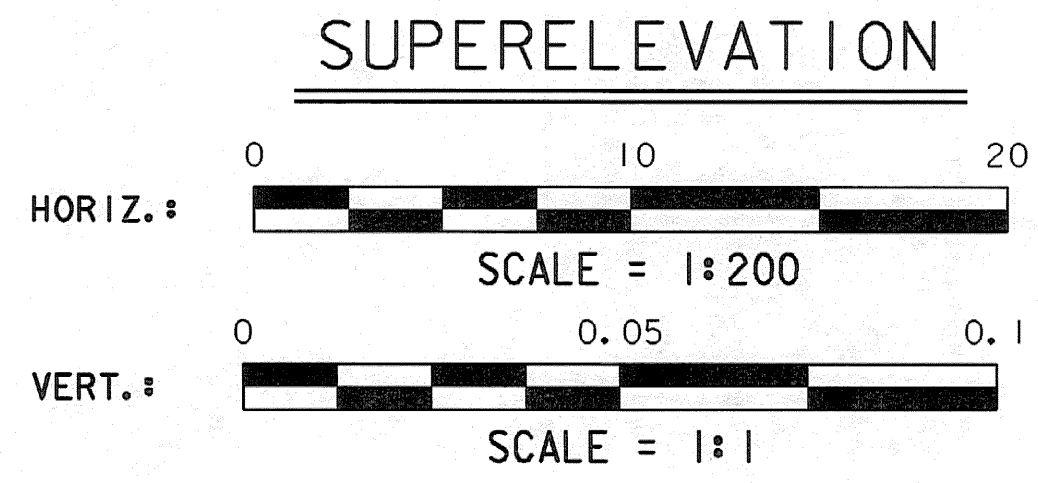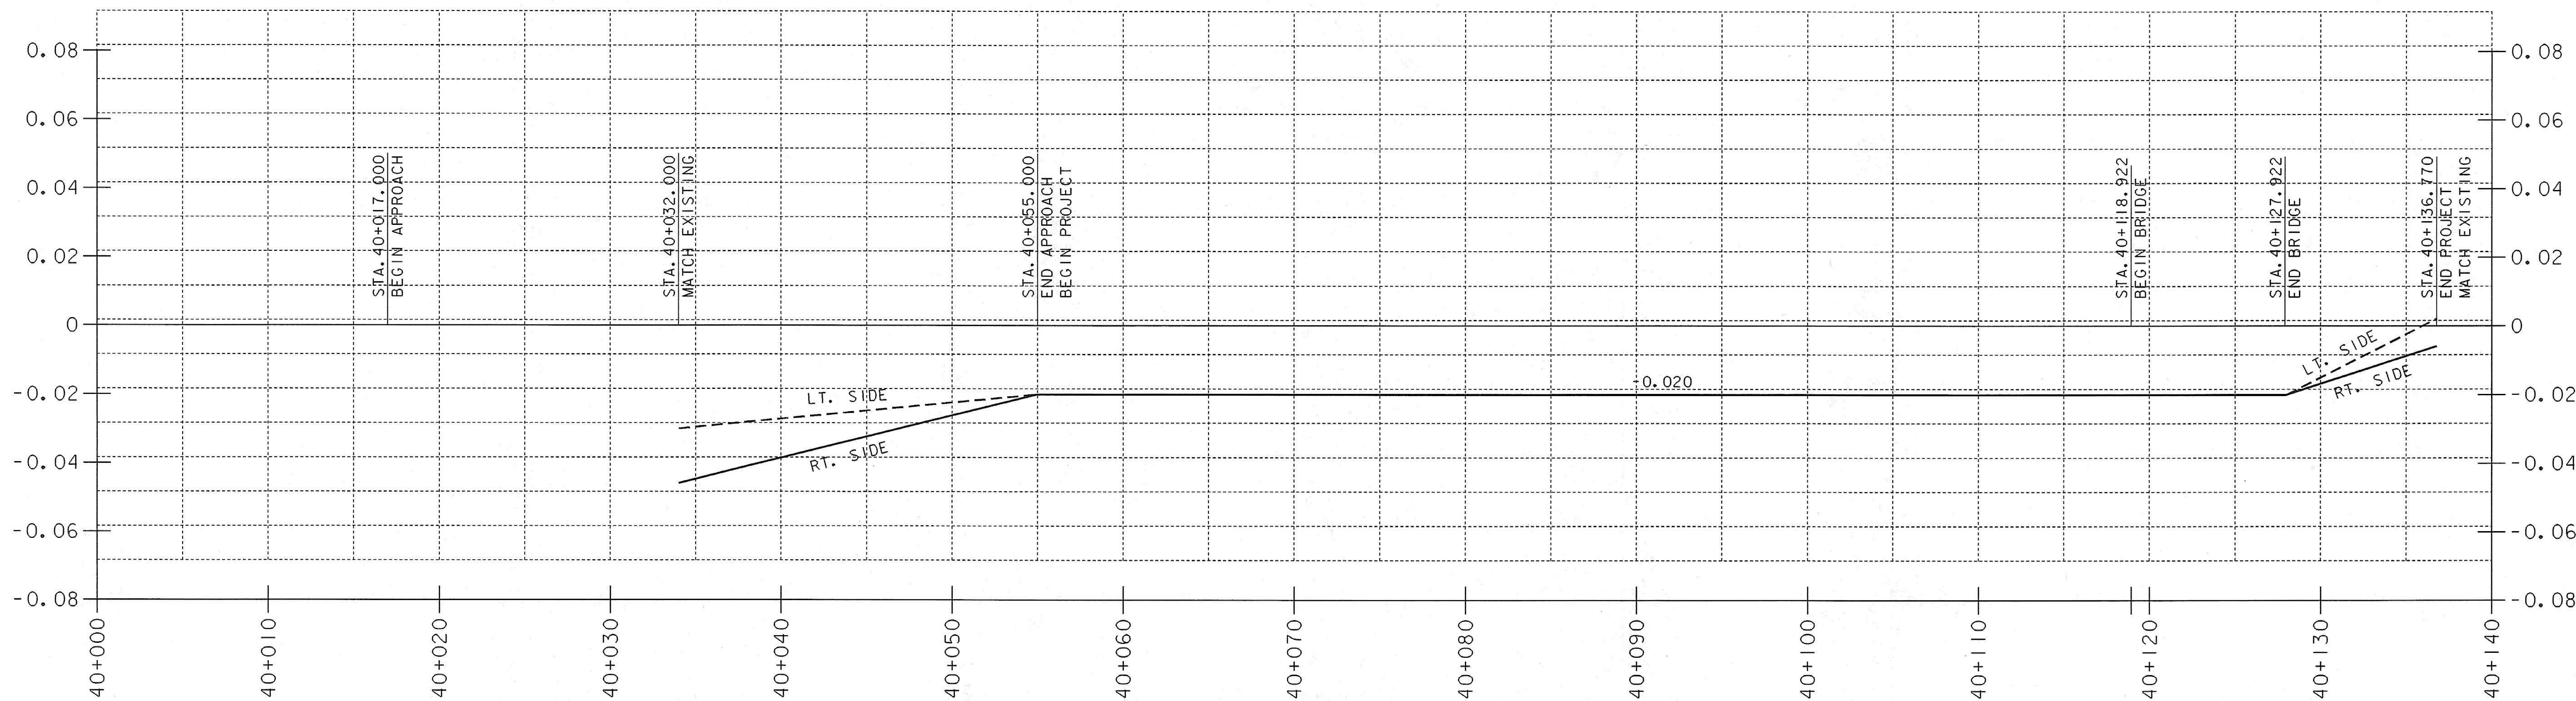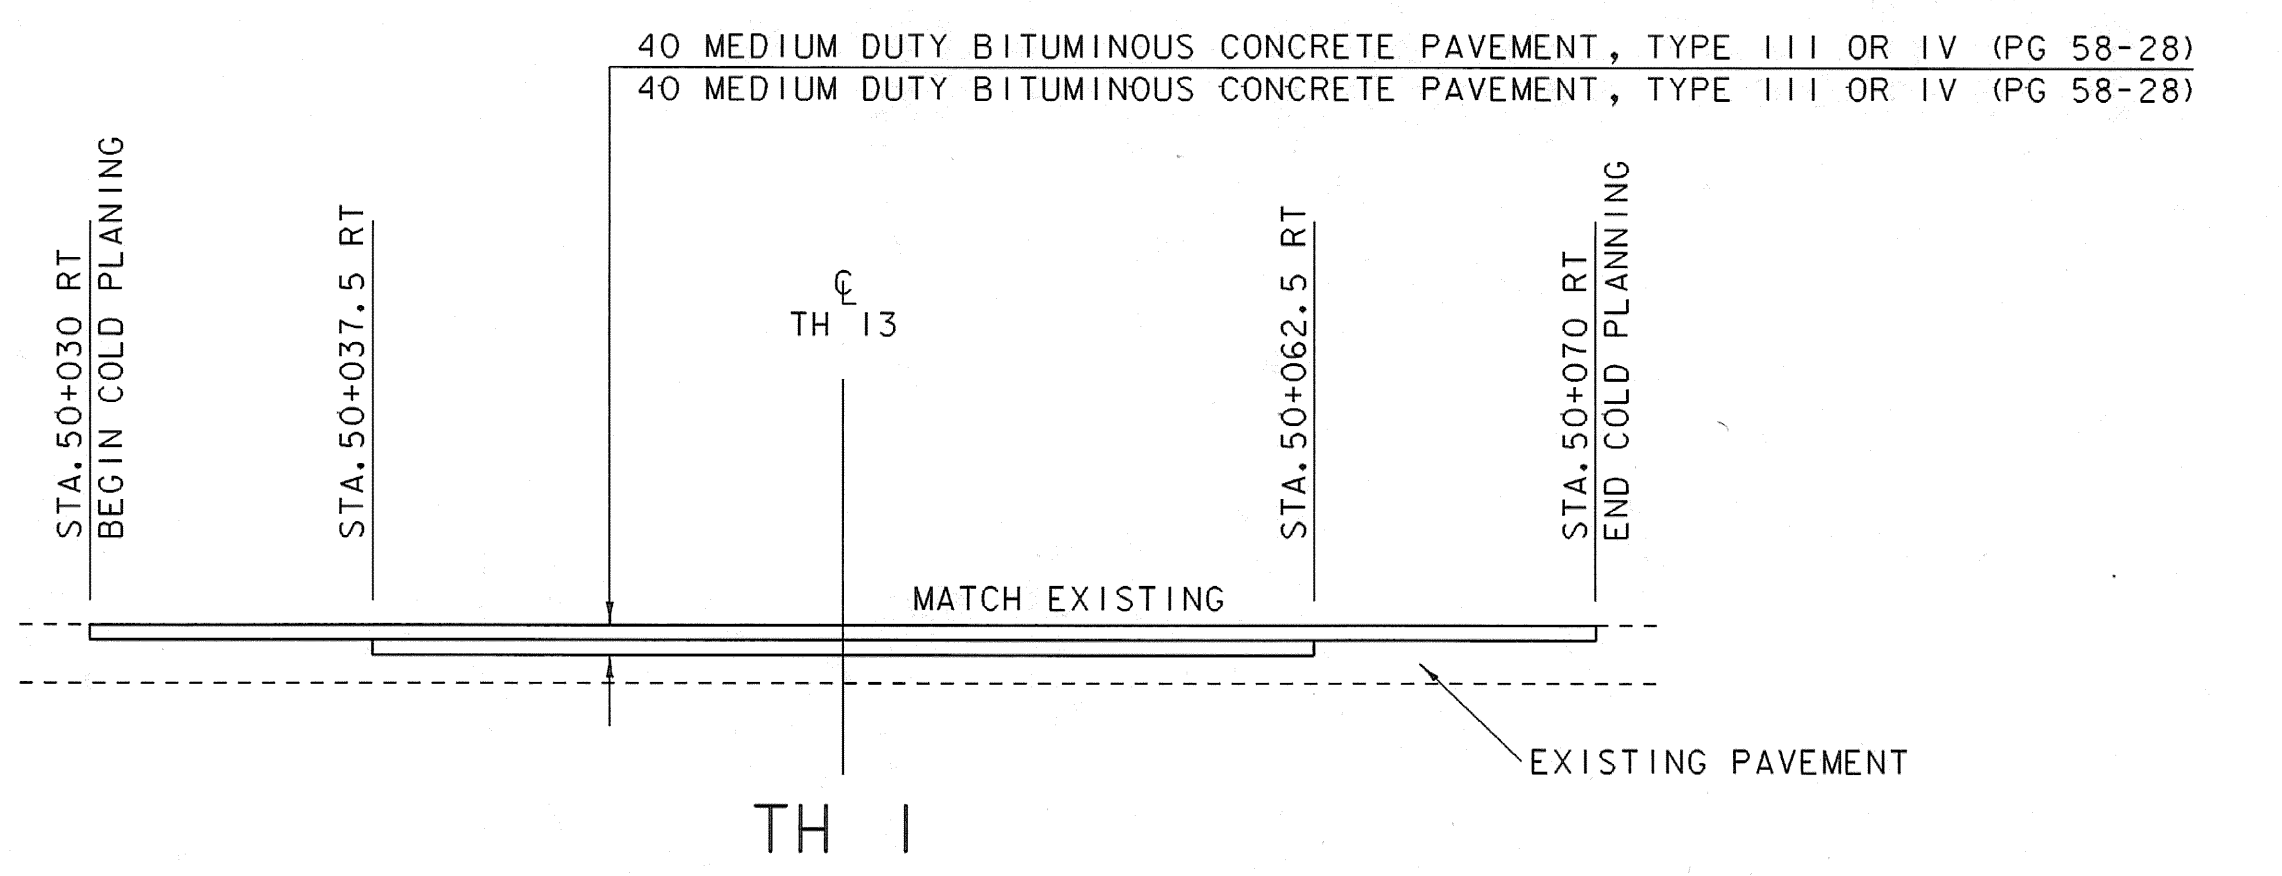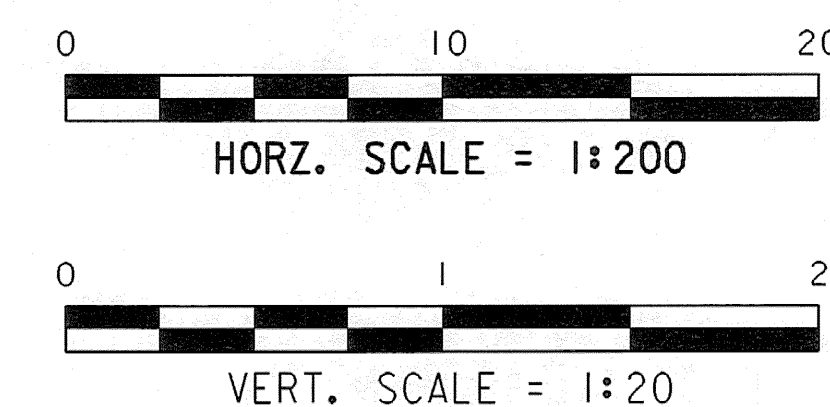

MATERIAL TRANSITION & SUPERELEVATION

PROJECT NAME:	GUILFORD	PLOT DATE:	15-APR-2008
PROJECT NUMBER:	BRO 1442(24)	DRAWN BY:	T. LACKEY
FILE NAME:	sj076mat.i	CHECKED BY:	J. PERRIGO
PROJECT LEADER:	R. WHITCOMB	SHEET	17 OF 59
DESIGNED BY:	T. LACKEY		
94j076\structures\sj076xs3.dgn			