

**REMOVING SIGNS**  
CHAN 50+117.3 RT

**2 - 100 MM WHITE LINE**  
ML 40+017 TO 40+130

**TRAFFIC SIGNS, TYPE A**

ML 40+065.3 LT  
ML 40+132.3 RT  
ML 40+133.9 LT  
T.H. 1 NORTH LT (SEE NEXT SHEET)  
T.H. 1 SOUTH RT (SEE THIS SHEET)  
CL 50+130 RT



**2 - 100 MM YELLOW LINE**  
ML 40+017 TO 40+130



**600 MM STOP BAR**  
ML 40+135 RT

**ERECTING SALVAGED SIGNS**


ML 40+132.3 RT

**LEGEND**

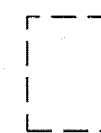-  EXISTING SIGNS
-  NEW SIGNS
- R REMOVE
- R&S REMOVE AND SALVAGE
- N NEW
- S SALVAGE

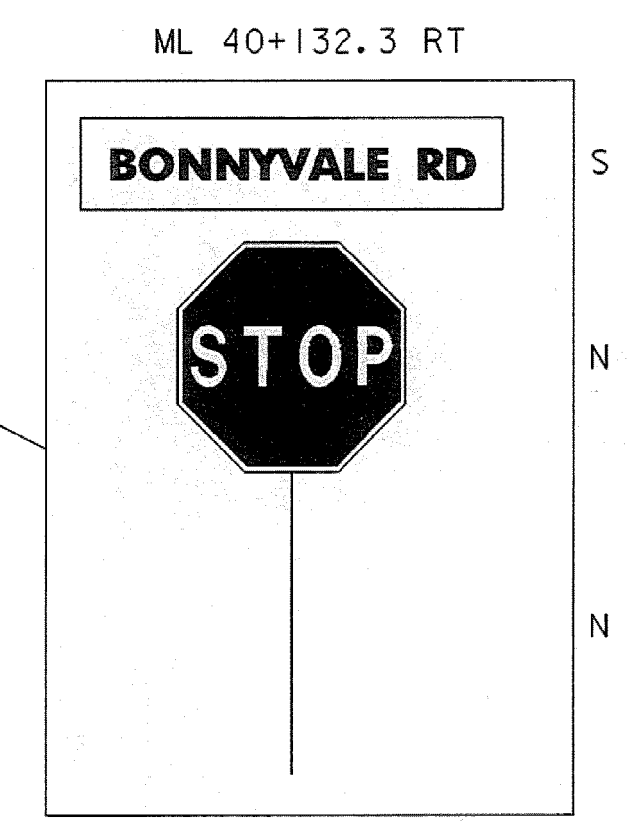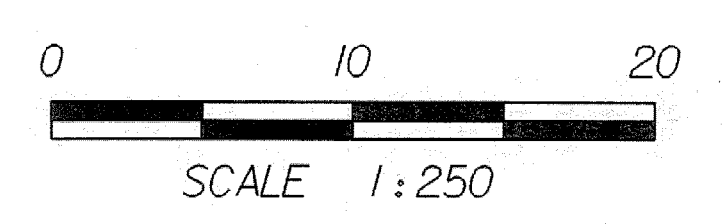

PLACE SIGN 120M - 145M SOUTH ALONG T.H. 1 FROM NEW INTERSECTION

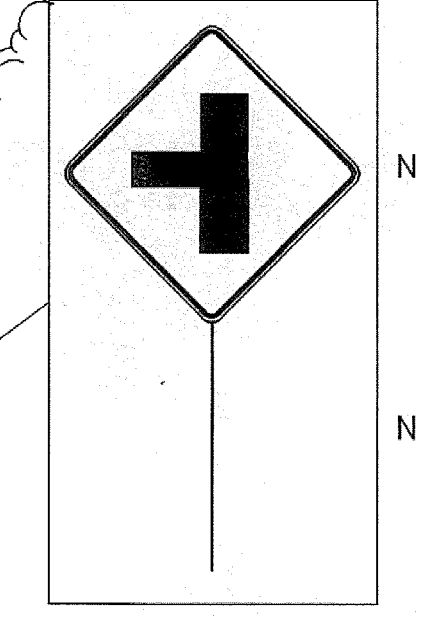

**TRAFFIC SIGN LAYOUT PLAN 1**

PROJECT NAME:	GUILFORD	PLOT DATE:	15-APR-2008
PROJECT NUMBER:	BRO 1442(24)	DRAWN BY:	L. BULLOCK
FILE NAME:	sj076+01.I	DESIGNED BY:	J. PERRIGO
		CHECKED BY:	T. LACKEY
			SHEET 18 OF 59