



PLAN

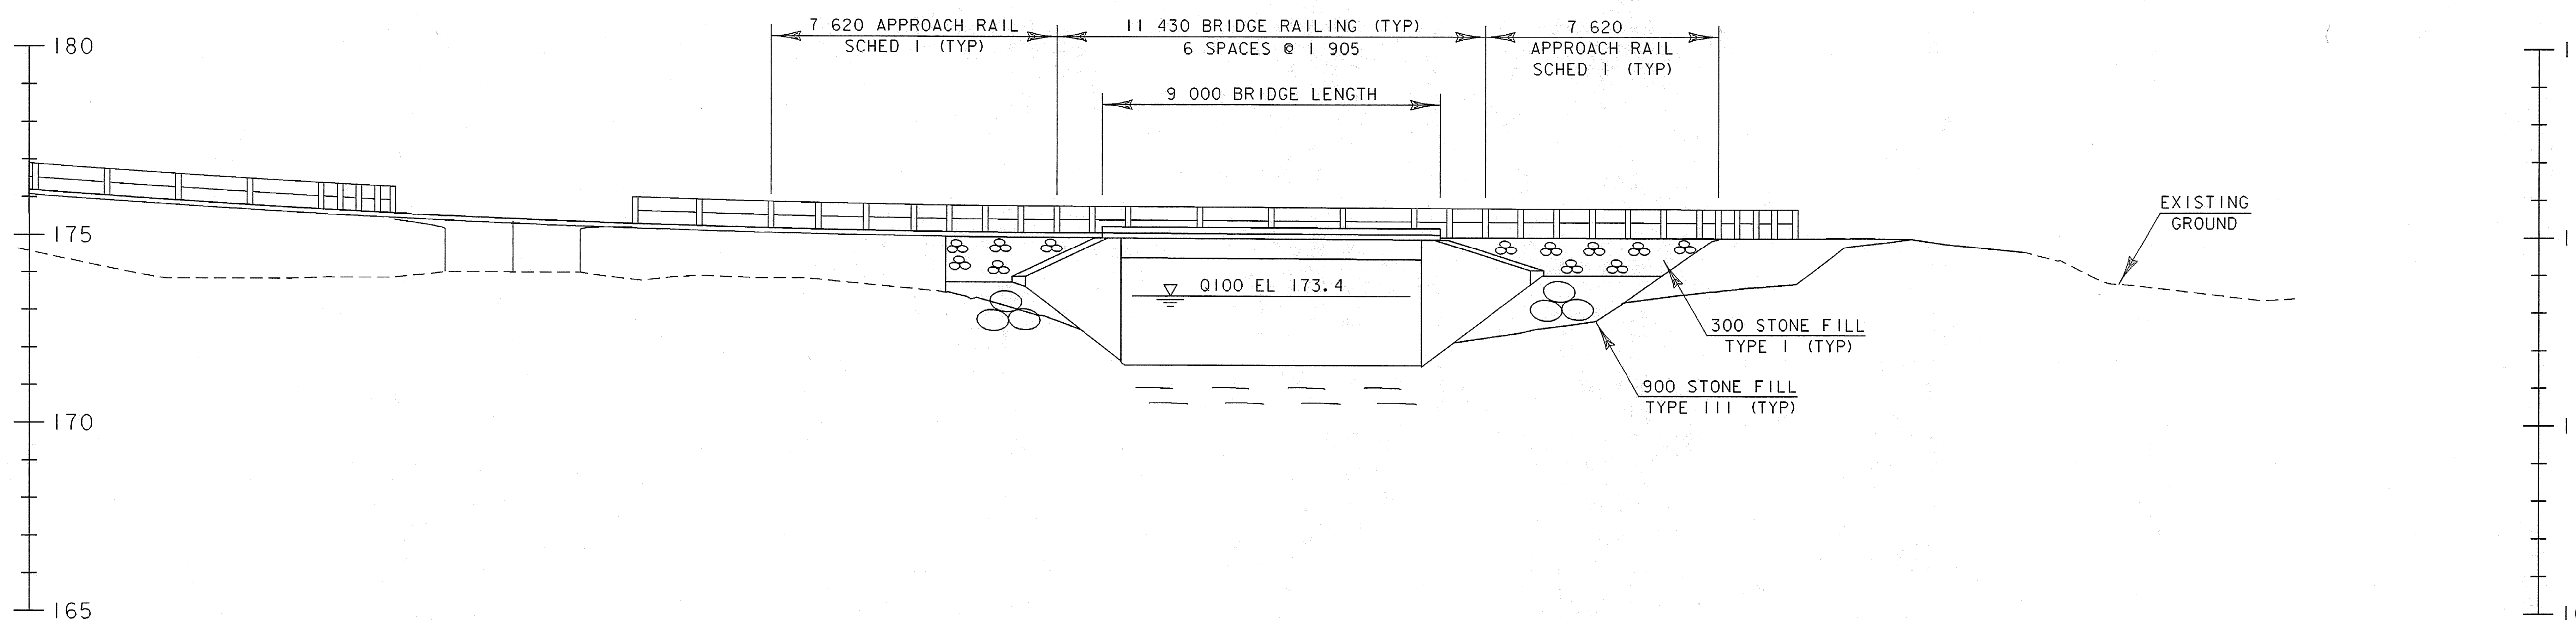

ELEVATION

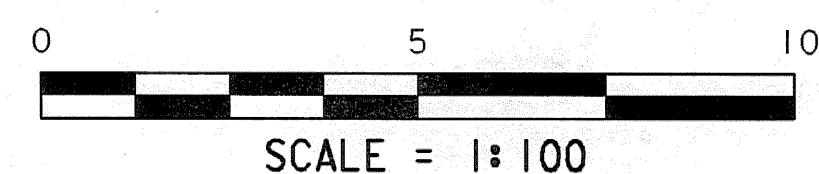

PLAN AND ELEVATION

PROJECT NAME:	GUILFORD	PLOT DATE:	01-MAY-2008
PROJECT NUMBER:	BRO 1442(24)	DRAWN BY:	T. LACKEY
FILE NAME:	sj076pe.i	CHECKED BY:	J. PERRIGO
PROJECT LEADER:	R. WHITCOMB	SHEET	23 OF 59
DESIGNED BY:	T. LACKEY		
94\076\Structures\sj076pe.dgn			