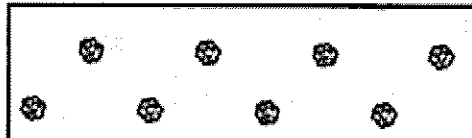
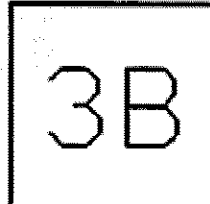
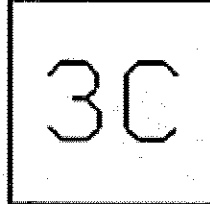
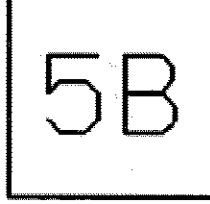


LEGEND

 SHRUB & SAPLING TREE BED

SOIL TYPES

AG ——— SOIL LIMIT

-  Quonset & Warwick
2 to 8% Slope
k=0.20
low erodibility
-  Quonset & Warwick
8 to 15% Slope
k = 0.20
moderate erodibility
-  Windsor Loamy Fine Sand
2 to 8% Slope
k=0.17
low erodibility

DATUM
VERTICAL: NAVD 88
HORIZONTAL: NAD 83/92

