


SET CONSTRUCTION FORMS TO THIS CAMBER

CAMBER DIAGRAM

NTS

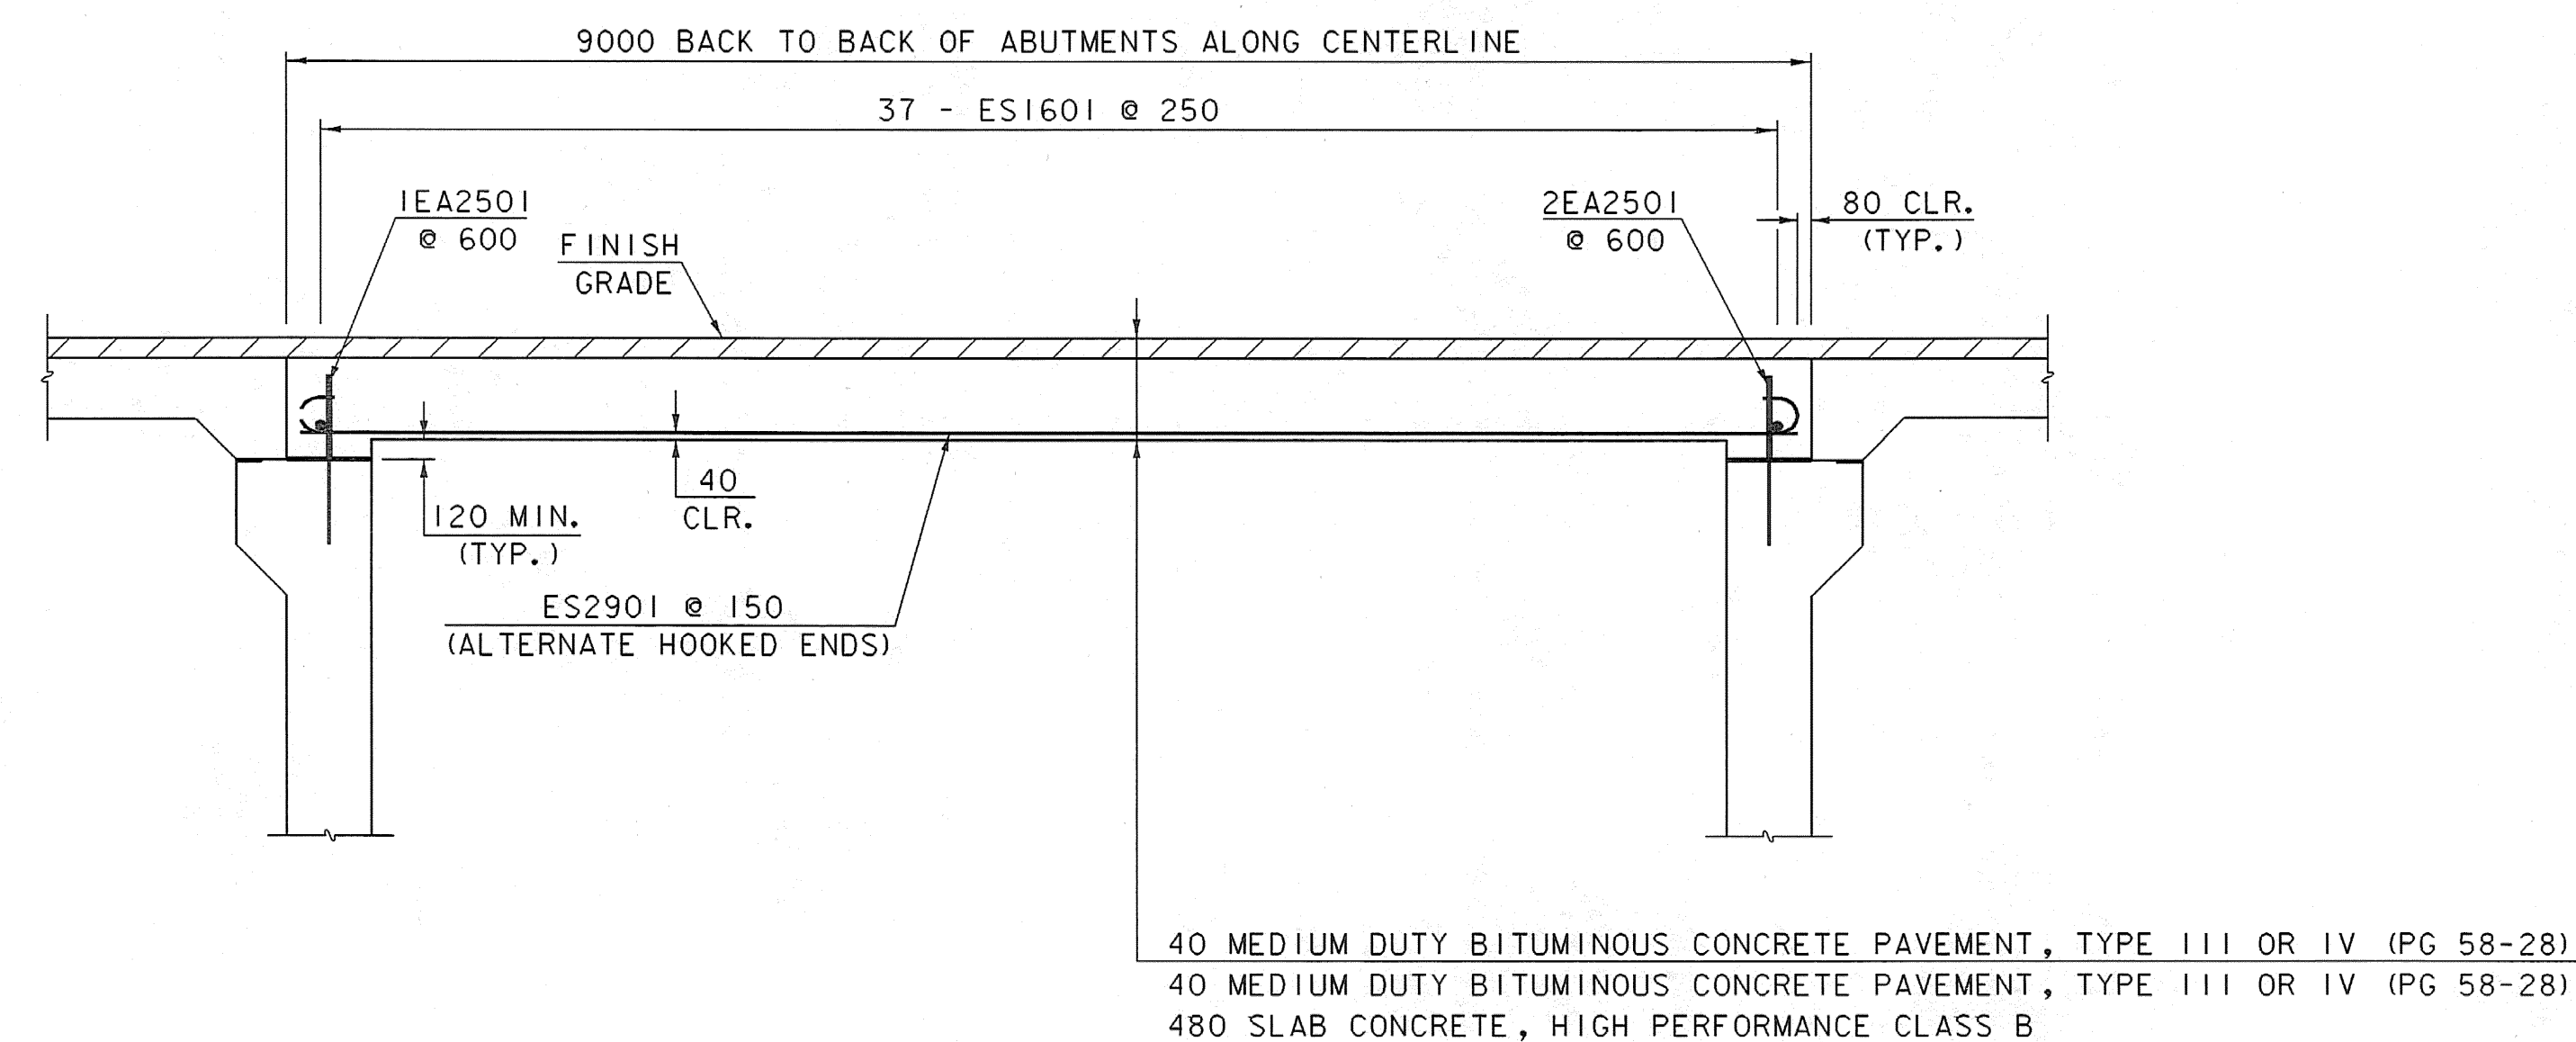

NOTE:

NF = NEAR FACE
 FF = FAR FACE
 EF = EACH FACE
 ▲ = CUT TO FIT IN FIELD
 80 CLR. UNLESS OTHERWISE SPECIFIED ON THE PLANS.

SLAB REINFORCING DETAILS

PROJECT NAME:	GUILFORD	PLOT DATE:	15-APR-2008
PROJECT NUMBER:	BRO 1442(24)	DRAWN BY:	L. BULLOCK
FILE NAME:	sj076+y2.1	CHECKED BY:	T. LACKEY
PROJECT LEADER:	R. WHITCOMB	SHEET	35 OF 59
DESIGNED BY:	J. PERRIGO		
94j076\Structures\sj076sup.dgn			