

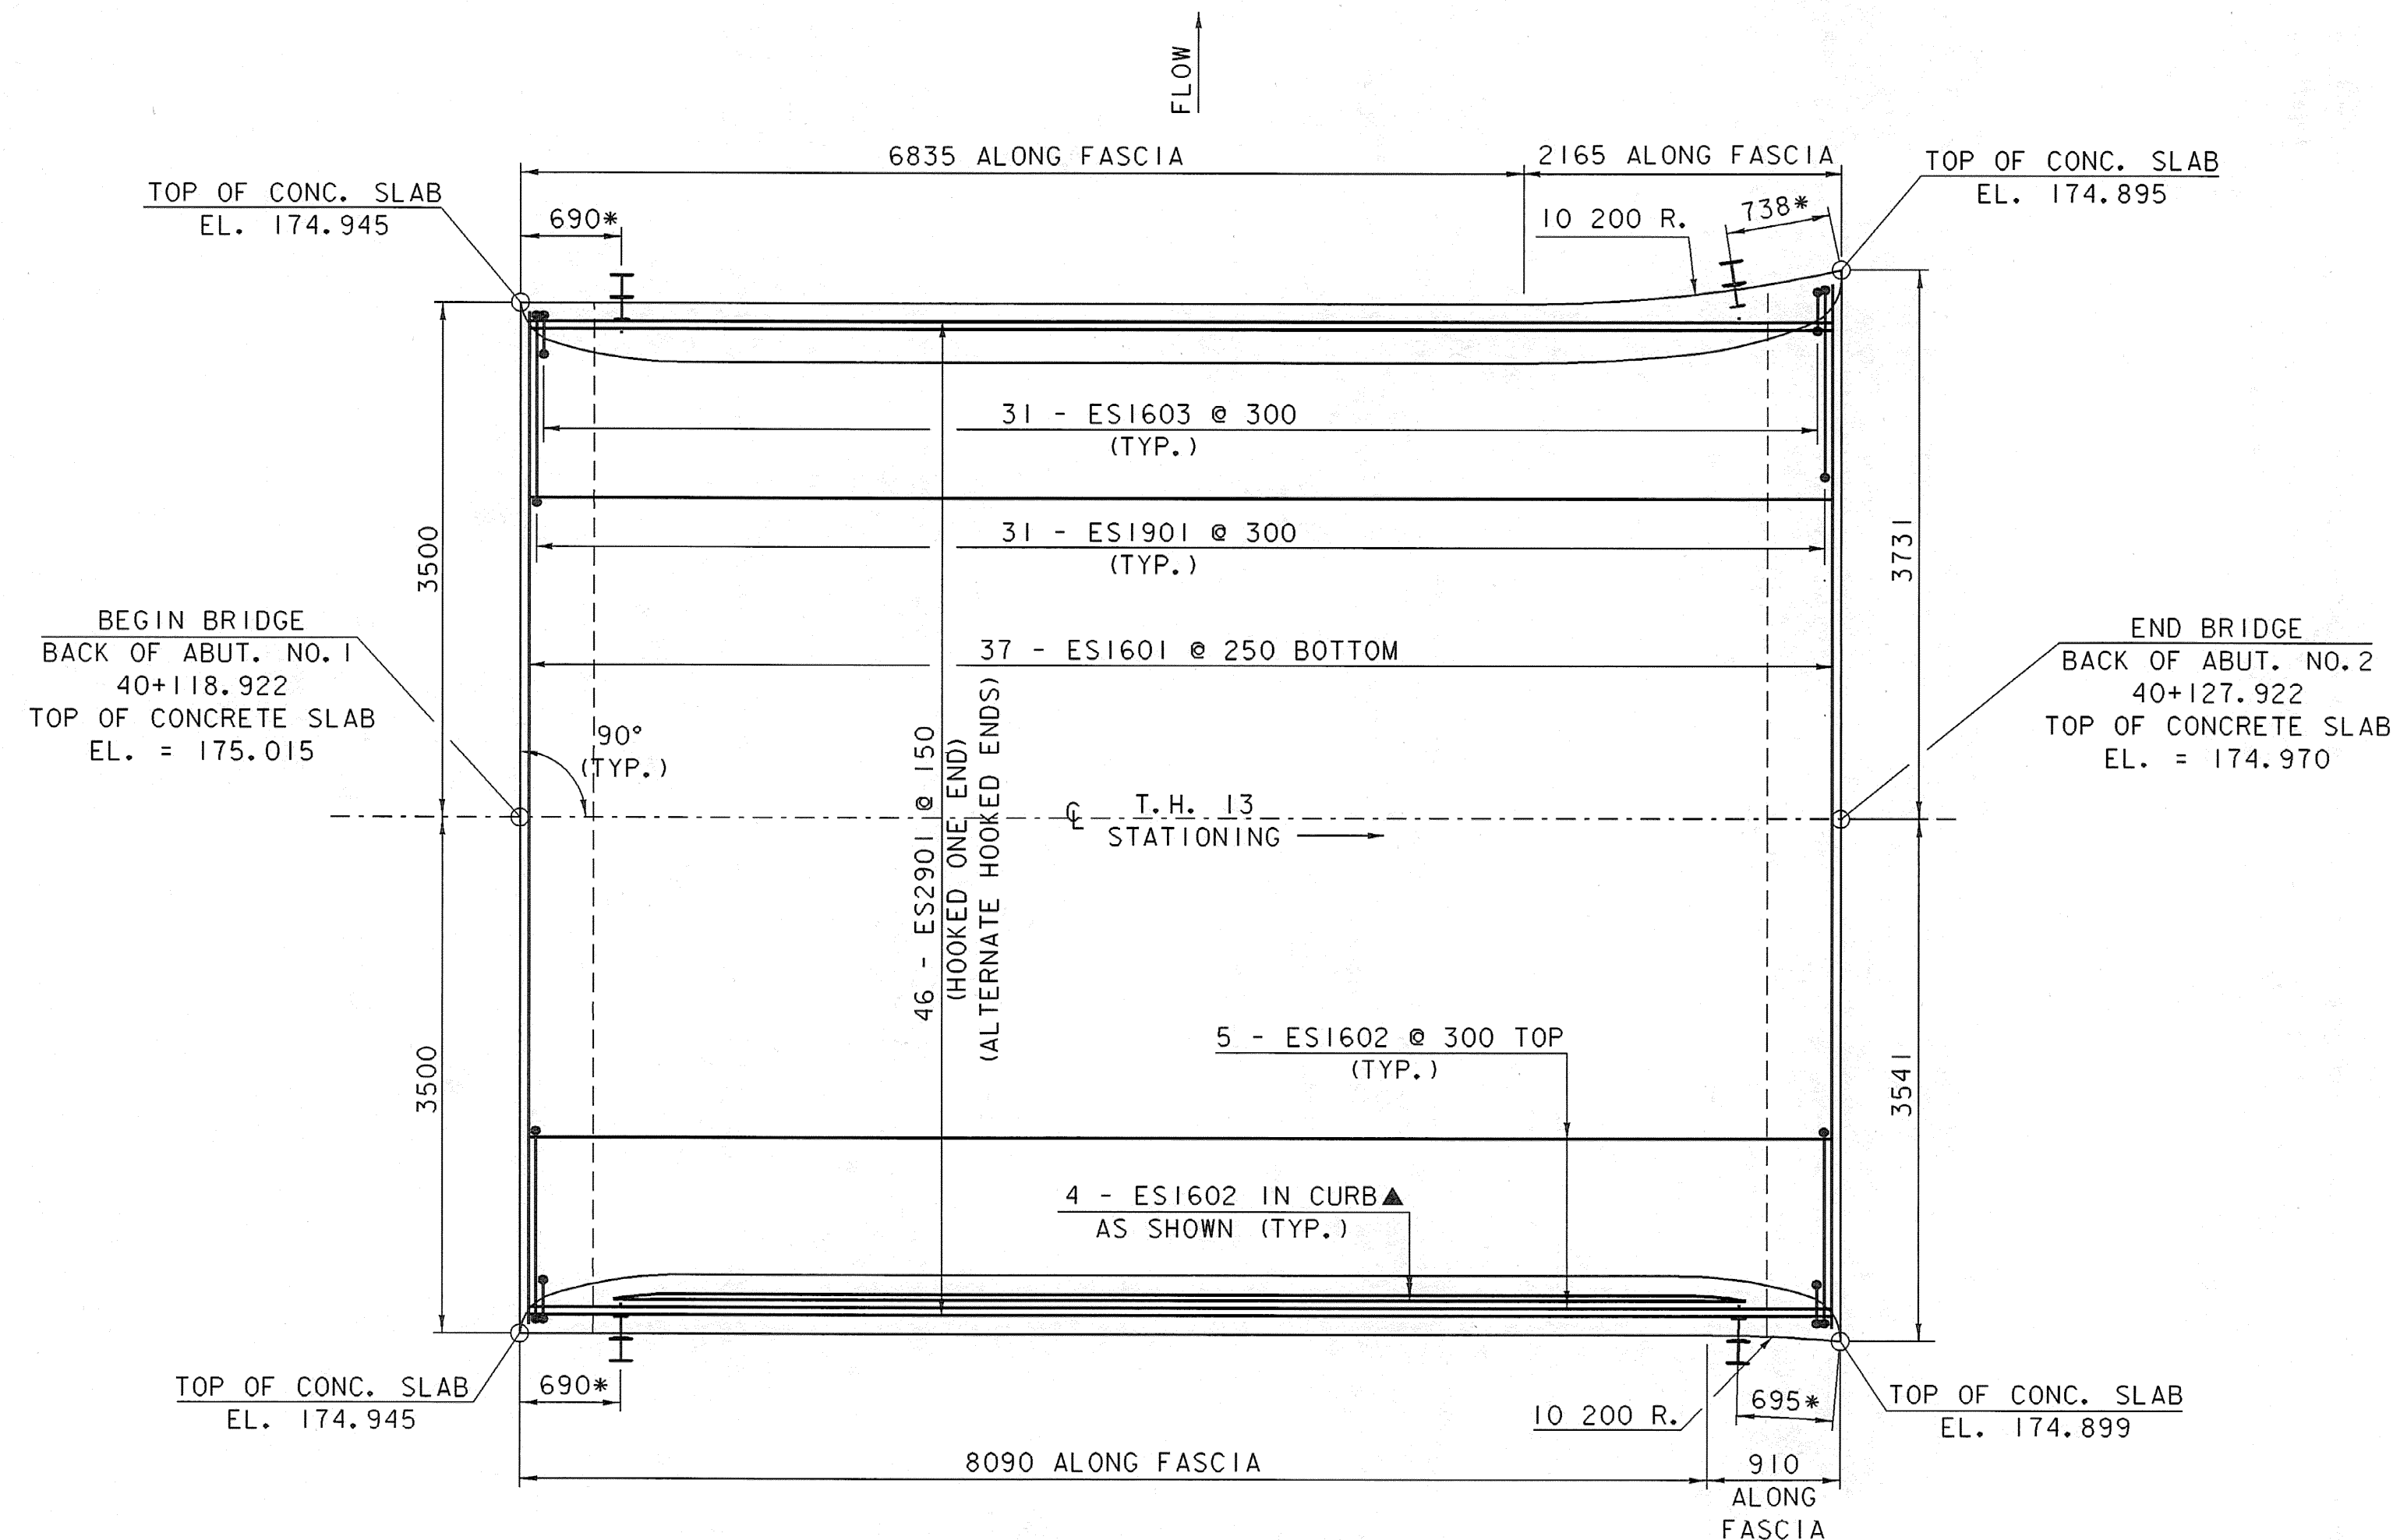


* DISTANCE MEASURED ALONG FASCIA

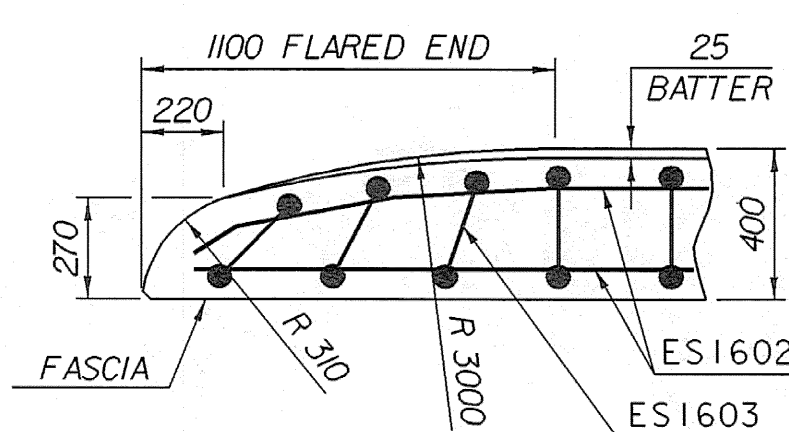


DECK REINFORCING PLAN

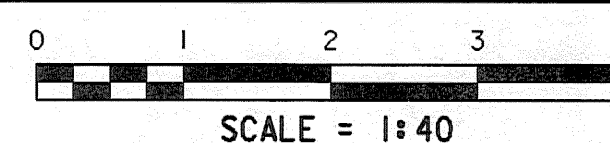

FLARED END FOR 400 CURB

BARS SHALL BE TURNED AS REQUIRED TO FIT FLARED ENDS

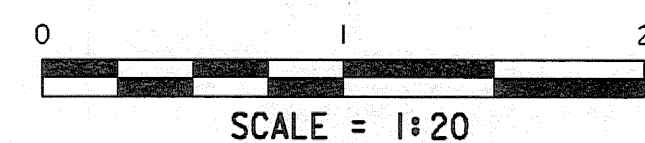

NOTE:

- NF = NEAR FACE
- FF = FAR FACE
- EF = EACH FACE
- ▲ = CUT TO FIT IN FIELD
- 80 CLR. UNLESS OTHERWISE SPECIFIED ON THE PLANS.

DECK REINFORCING PLAN

PROJECT NAME: GUILFORD
PROJECT NUMBER: BRO 1442(24)

FILE NAME: sj076+y2.1
PROJECT LEADER: R. WHITCOMB
DESIGNED BY: J. PERRIGO
94\076\Structures\sj076sup.dgn

PLOT DATE: 15-APR-2008
DRAWN BY: L. BULLOCK
CHECKED BY: T. LACKEY
SHEET 36 OF 59