

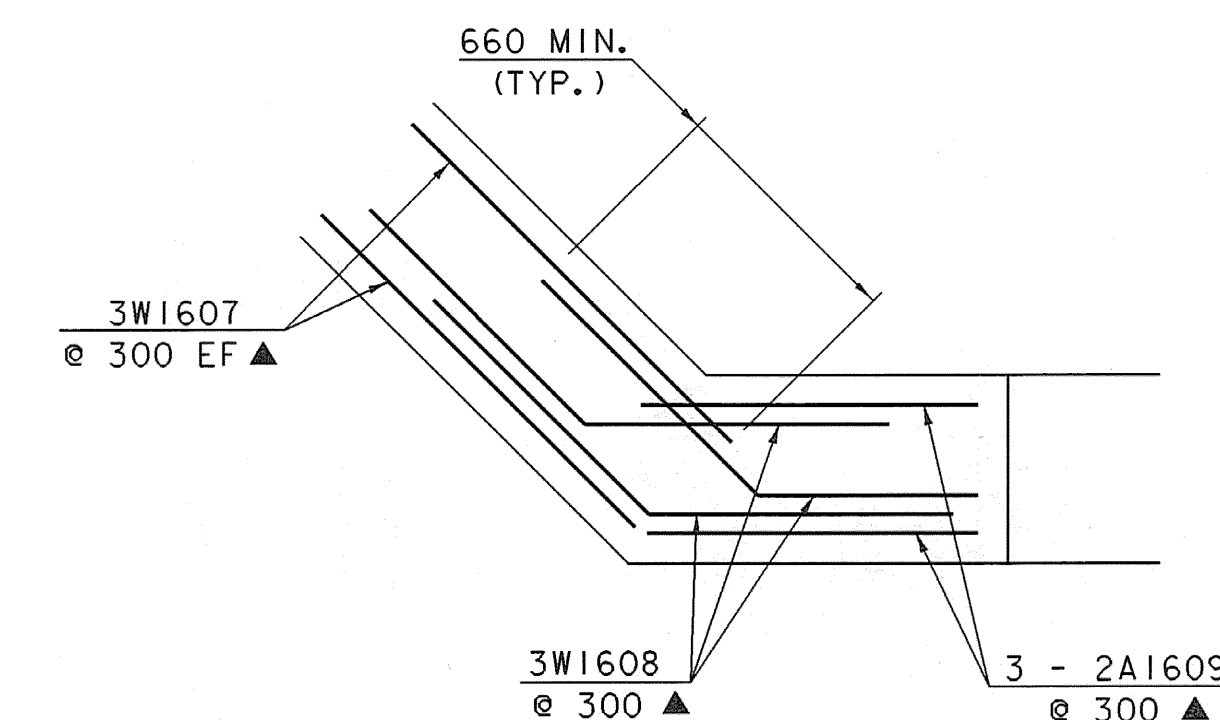
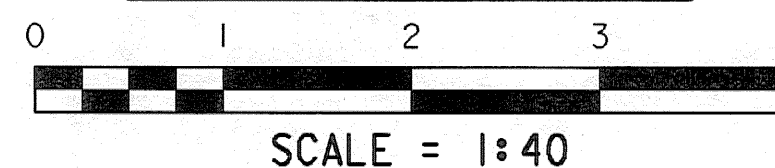



ABUTMENT NO. 2

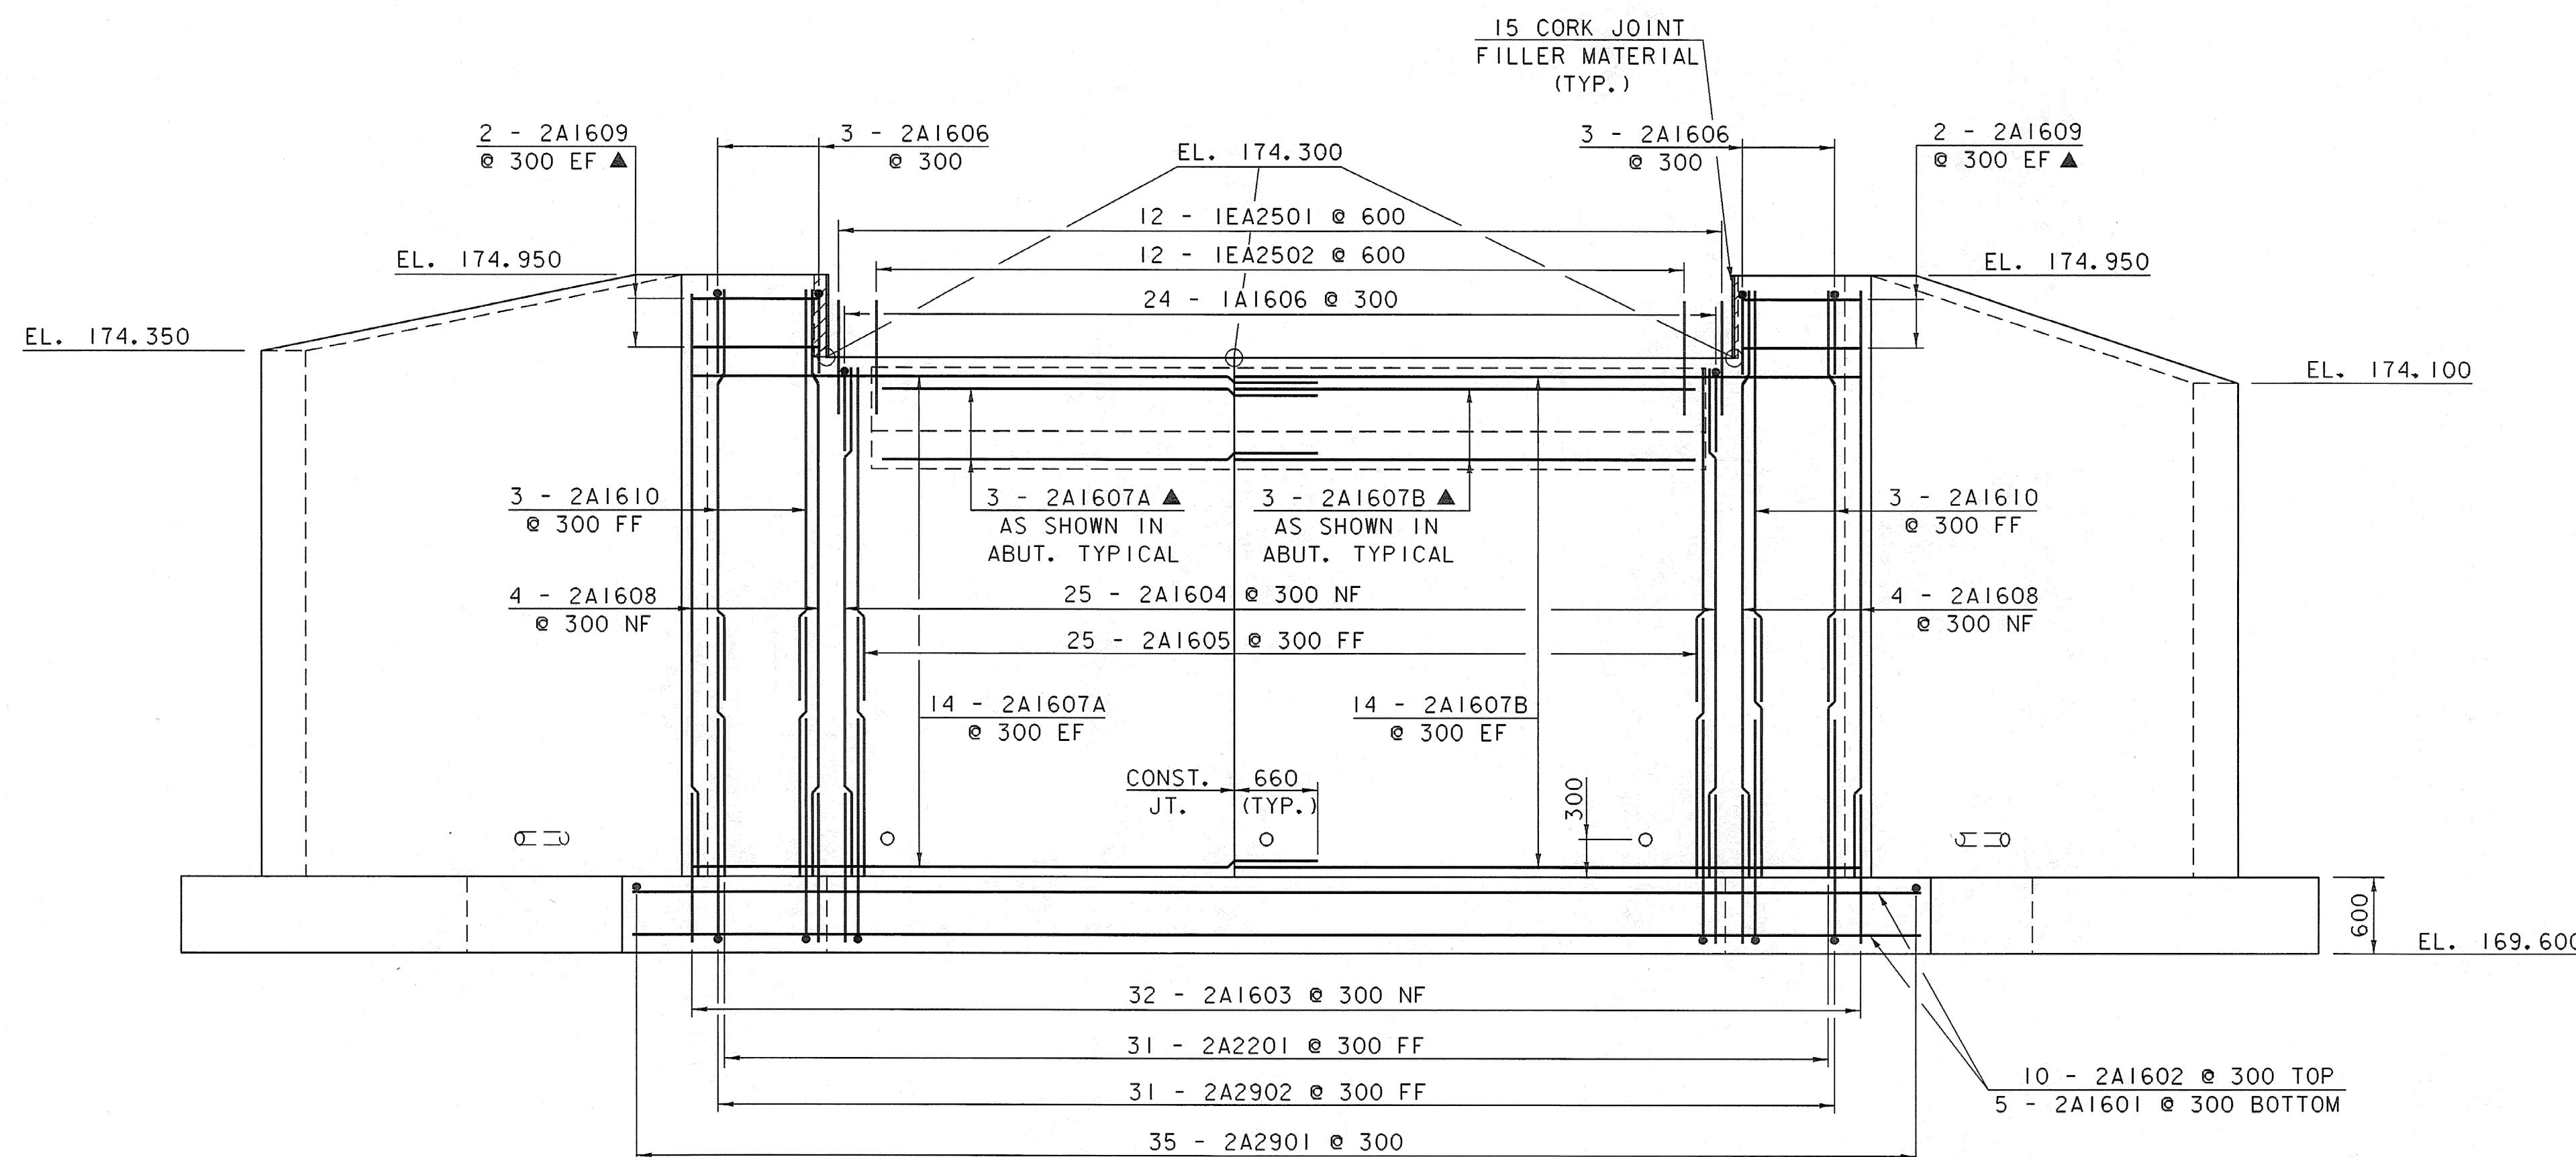

**WINGWALL NO. 3
CORNER REINFORCING DETAIL
BELOW BRIDGE SEAT**
(WINGWALL NOS. 1, 2, & 4 SIMILAR)

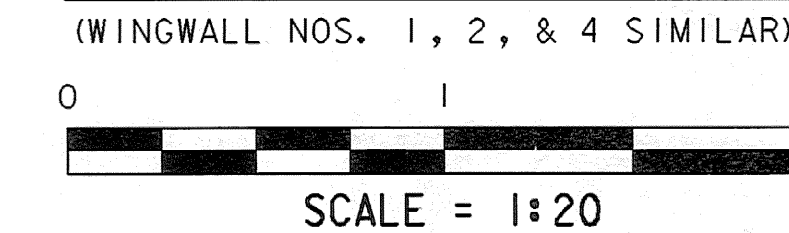

ABUTMENT NO. 2

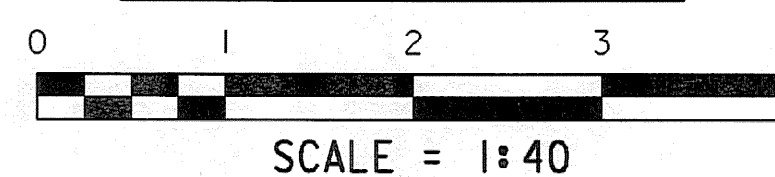

NOTE:

- NF = NEAR FACE
- FF = FAR FACE
- EF = EACH FACE
- ▲ = CUT TO FIT IN FIELD
- 80 CLR. UNLESS OTHERWISE SPECIFIED ON THE PLANS.

ABUTMENT 2 DETAILS

PROJECT NAME: GUILFORD	PLOT DATE: 15-APR-2008
PROJECT NUMBER: BRO 1442(24)	DRAWN BY: L. BULLOCK
FILE NAME: sj076ab2.1	CHECKED BY: T. LACKEY
PROJECT LEADER: R. WHITCOMB	SHEET 39 OF 59
DESIGNED BY: J. PERRIGO	
94J076\Structures\sj076ab.dgn	