

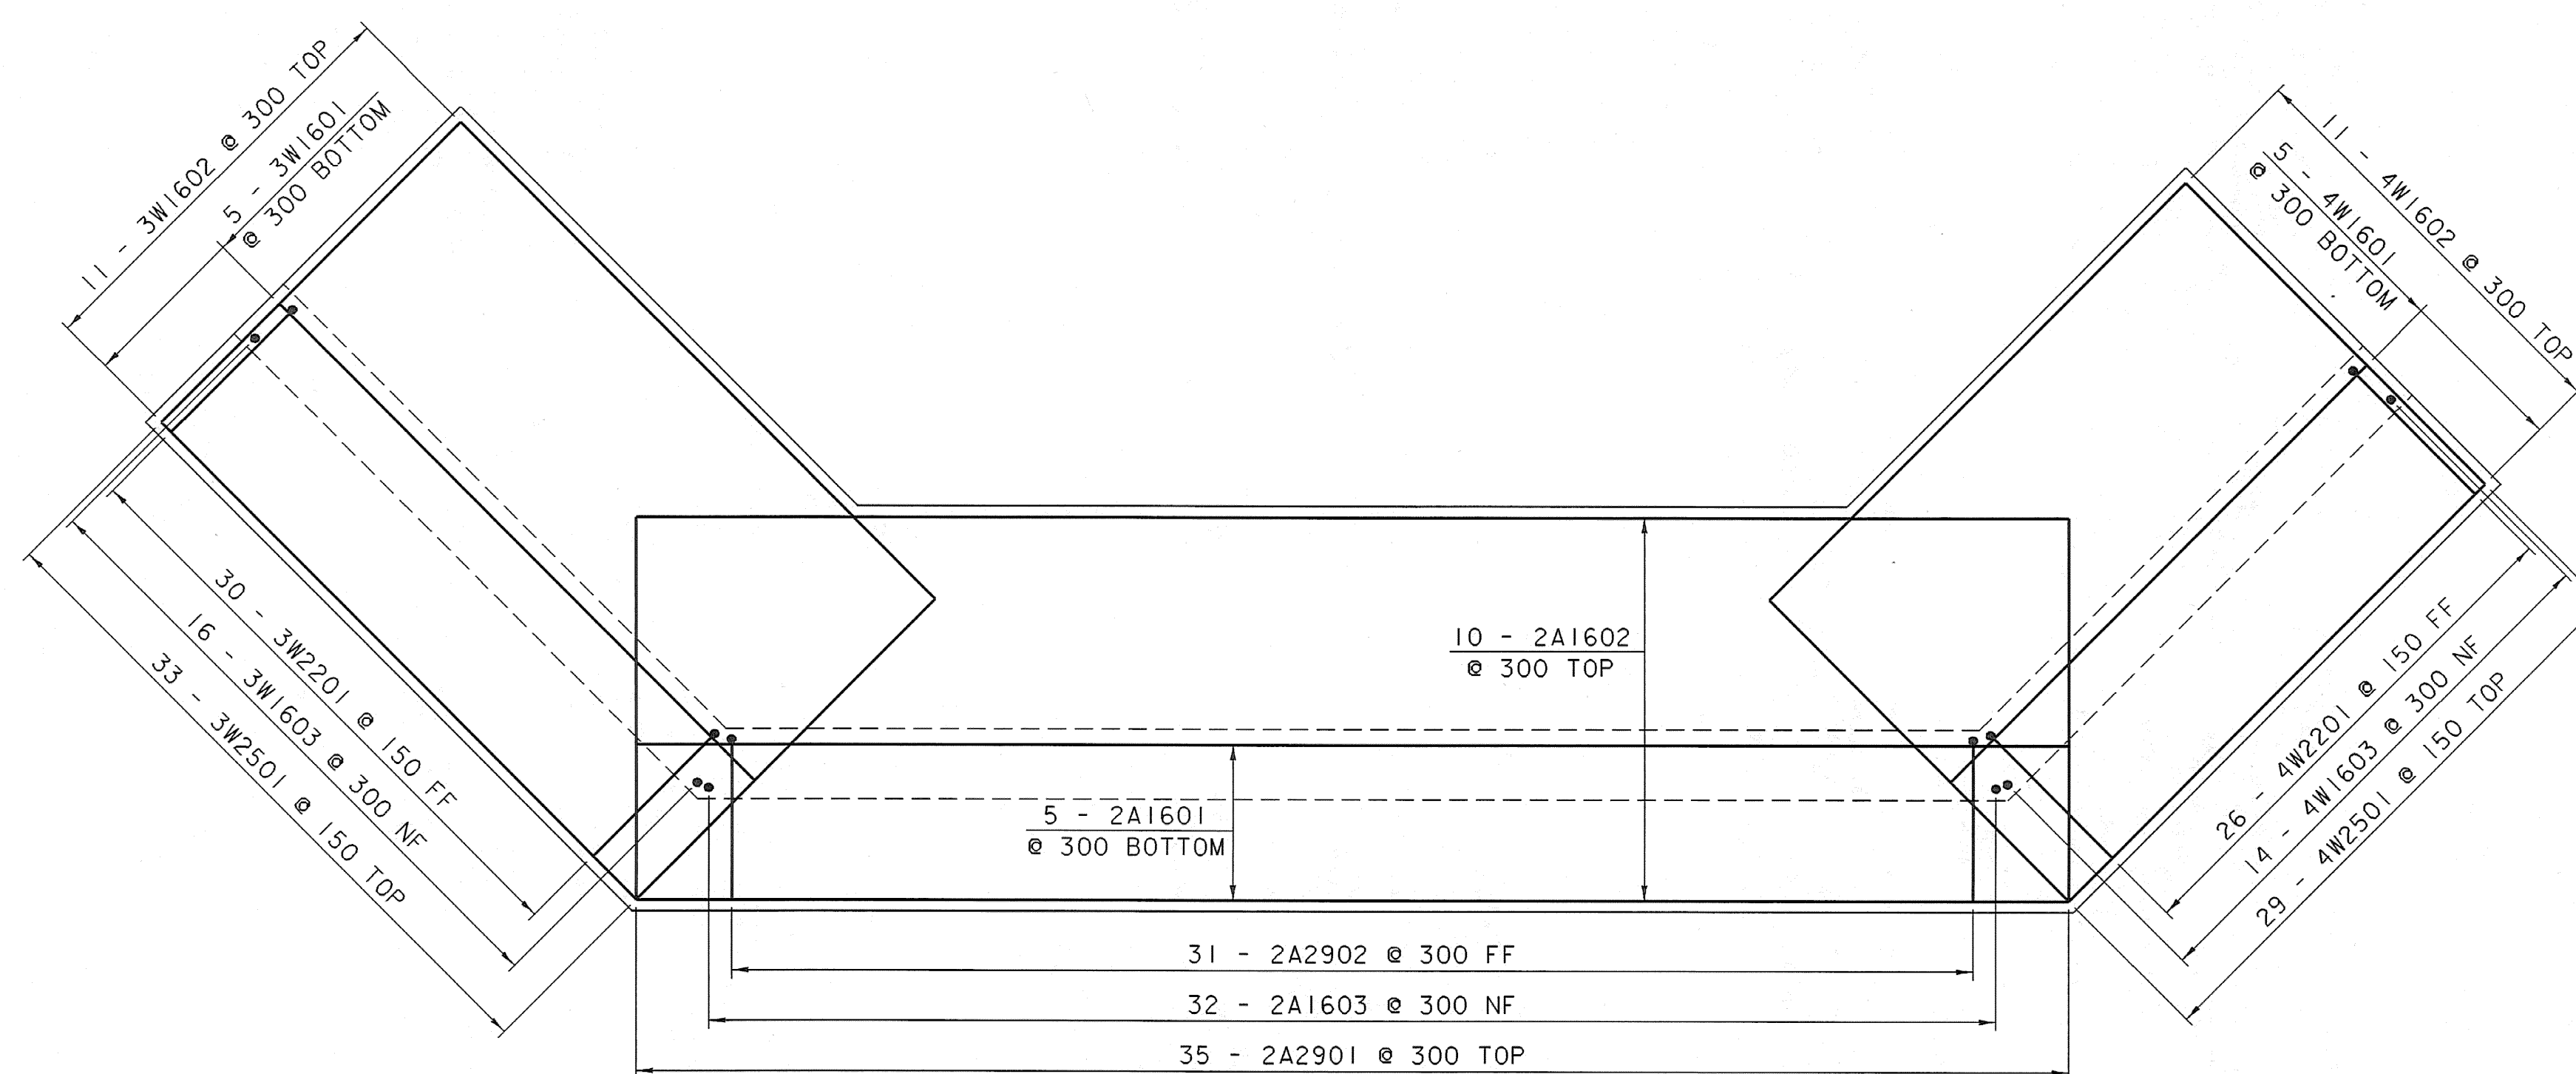


ABUTMENT NO. 1 FOOTING REINFORCING PLAN

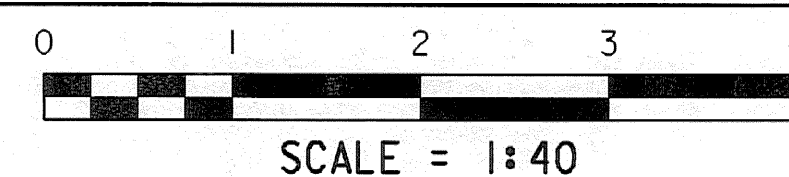

ABUTMENT NO. 2 FOOTING REINFORCING PLAN

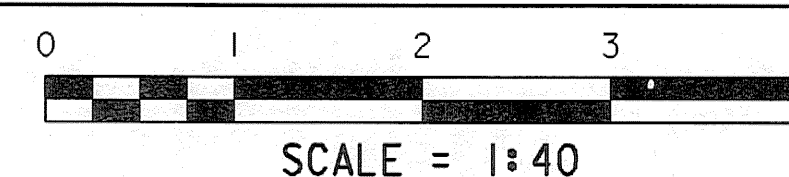

NOTE:

NF = NEAR FACE
 FF = FAR FACE
 EF = EACH FACE
 ▲ = CUT TO FIT IN FIELD
 80 CLR. UNLESS OTHERWISE
 SPECIFIED ON THE PLANS.

FOOTING REINFORCING DETAILS

| | |
|-------------------------------|--------------|
| PROJECT NAME: | GUILFORD |
| PROJECT NUMBER: | BRO 1442(24) |
| FILE NAME: | sj076fftg.i |
| PROJECT LEADER: | R. WHITCOMB |
| DESIGNED BY: | J. FERRIGO |
| 94J076\Structures\sj076ab.dgn | |
| PLOT DATE: | 15-APR-2008 |
| DRAWN BY: | L. BULLOCK |
| CHECKED BY: | T. LACKEY |
| SHEET | 40 OF 59 |