

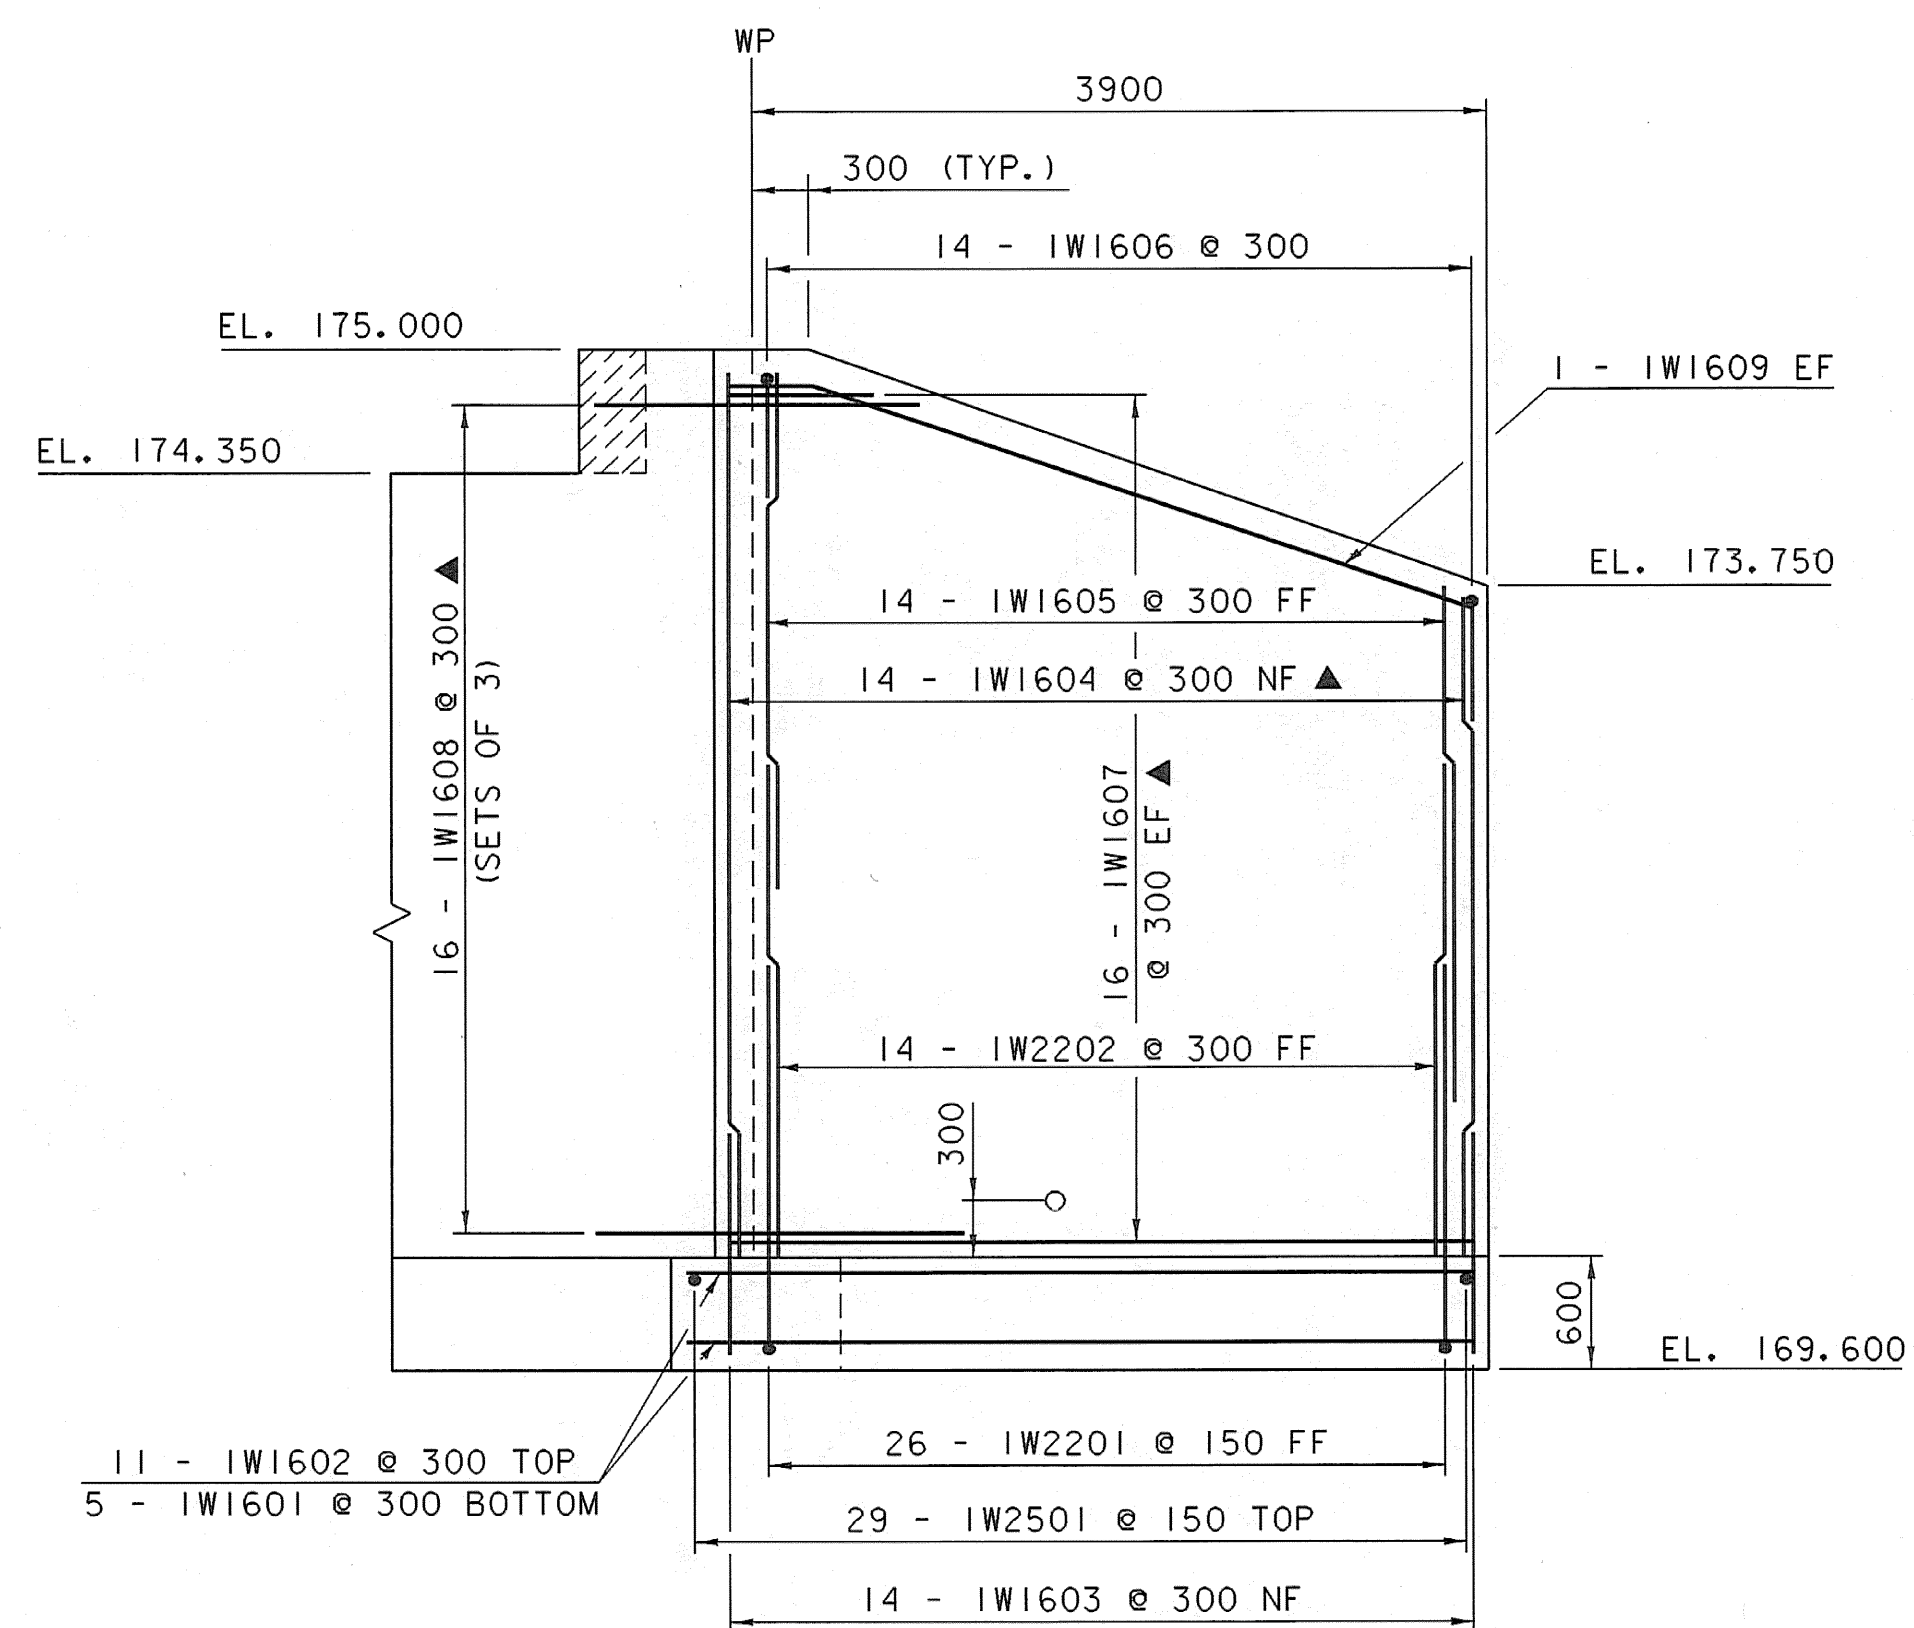
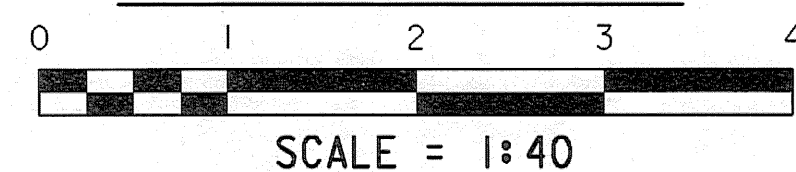




**WINGWALL NO. 2**

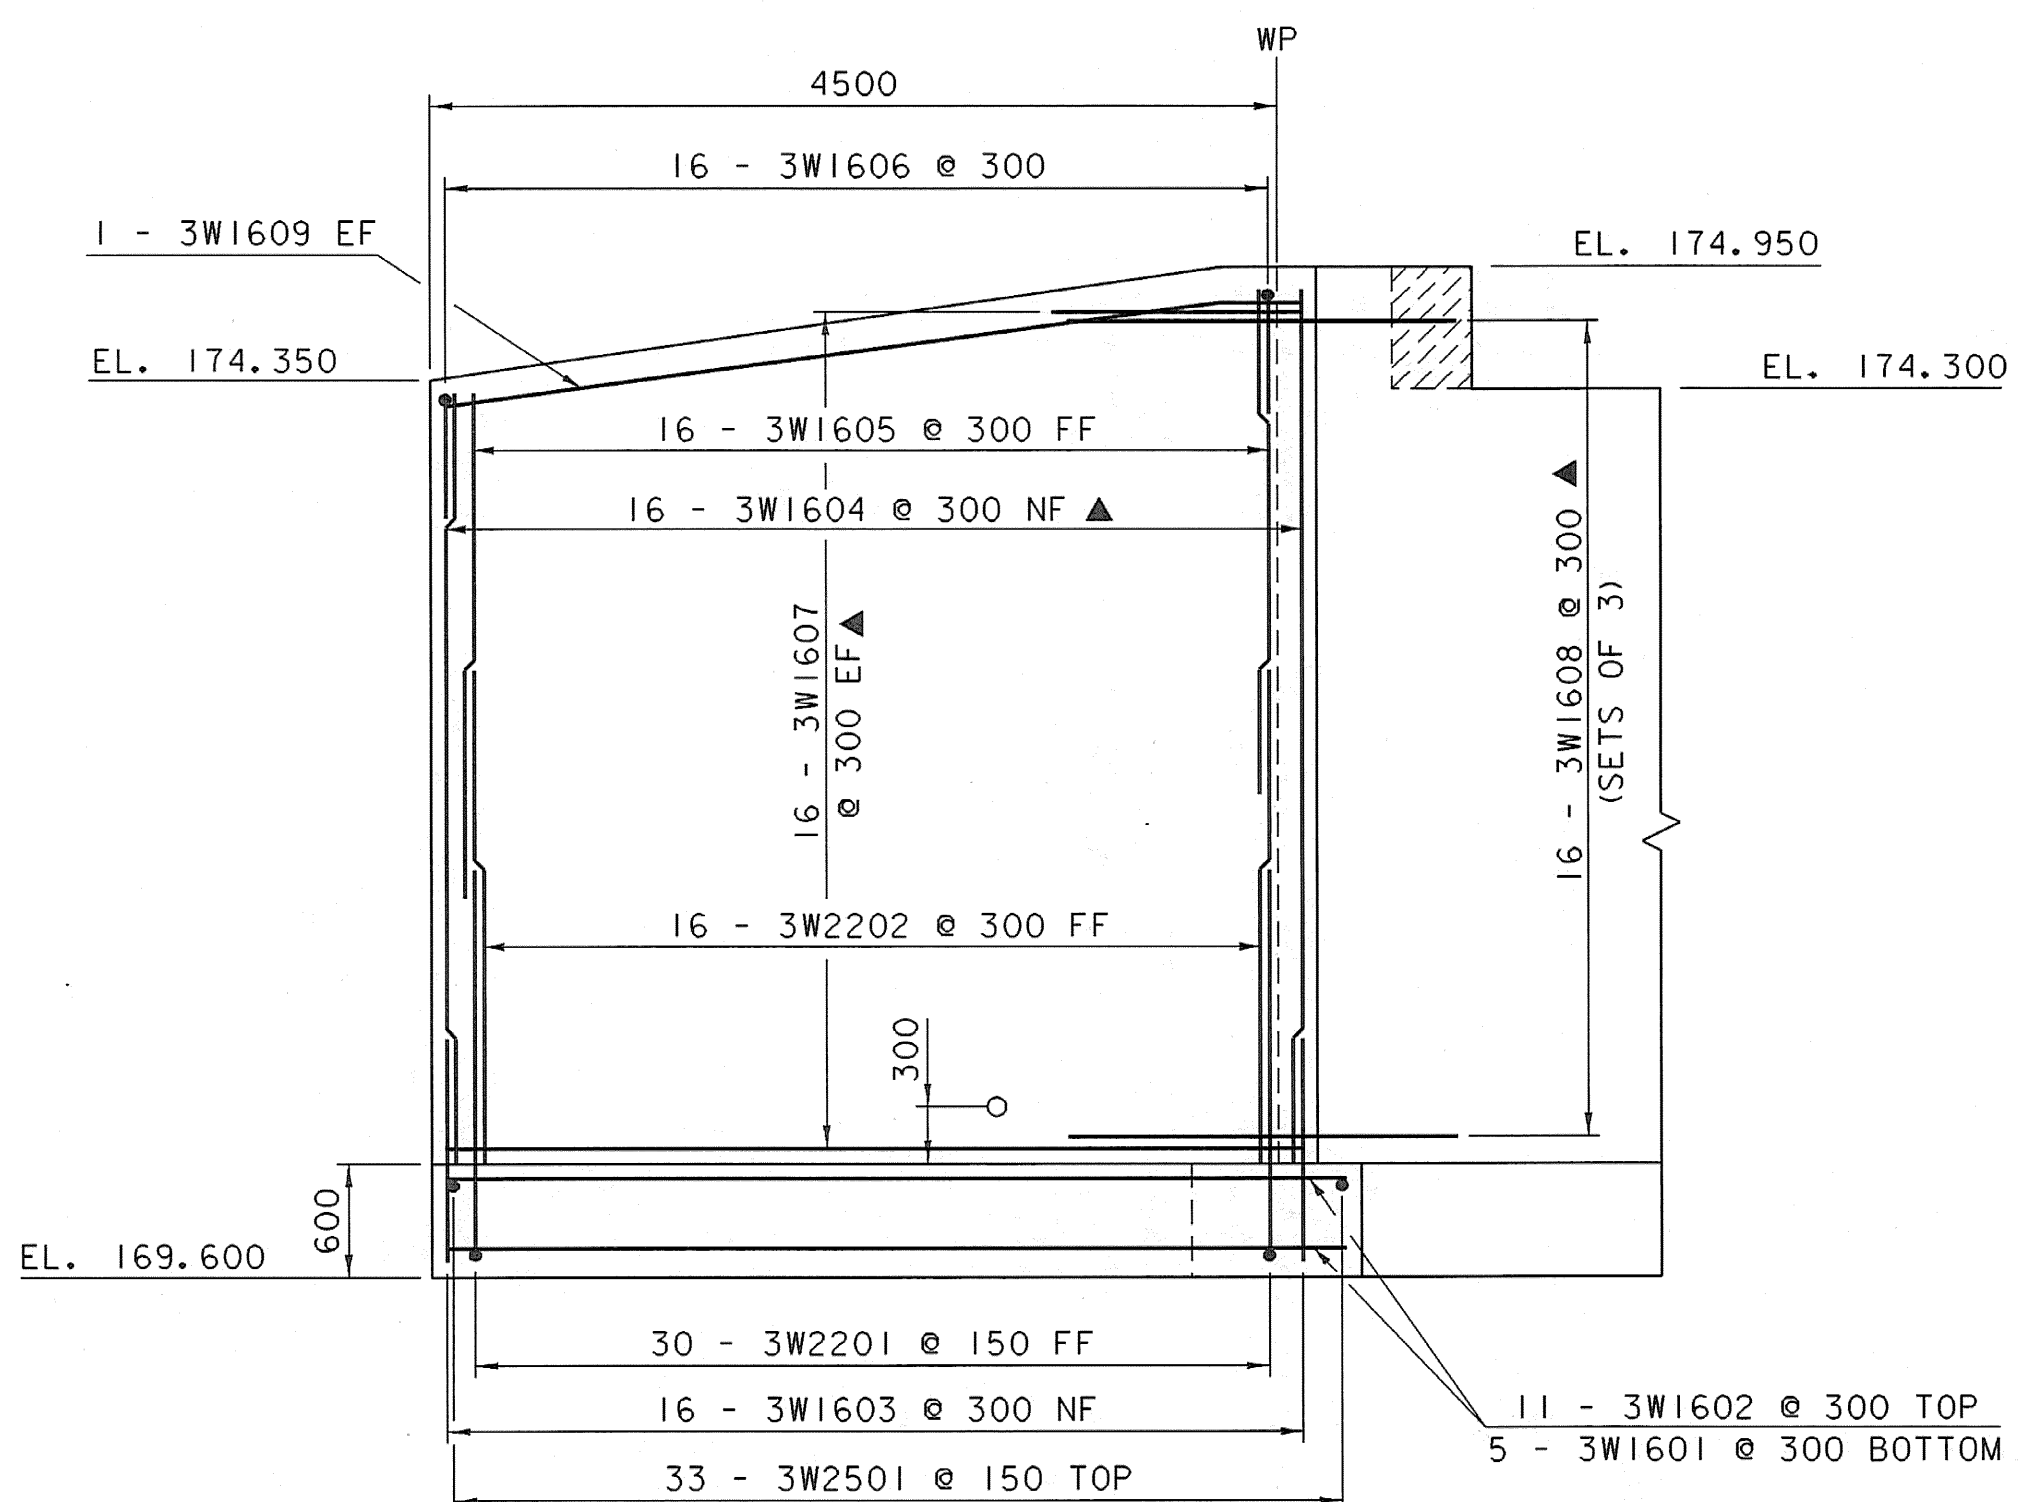



**WINGWALL NO. 1**

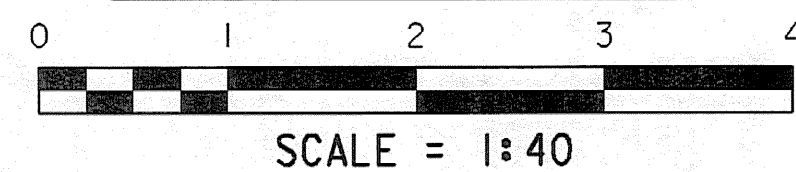


**WINGWALL NO. 3**

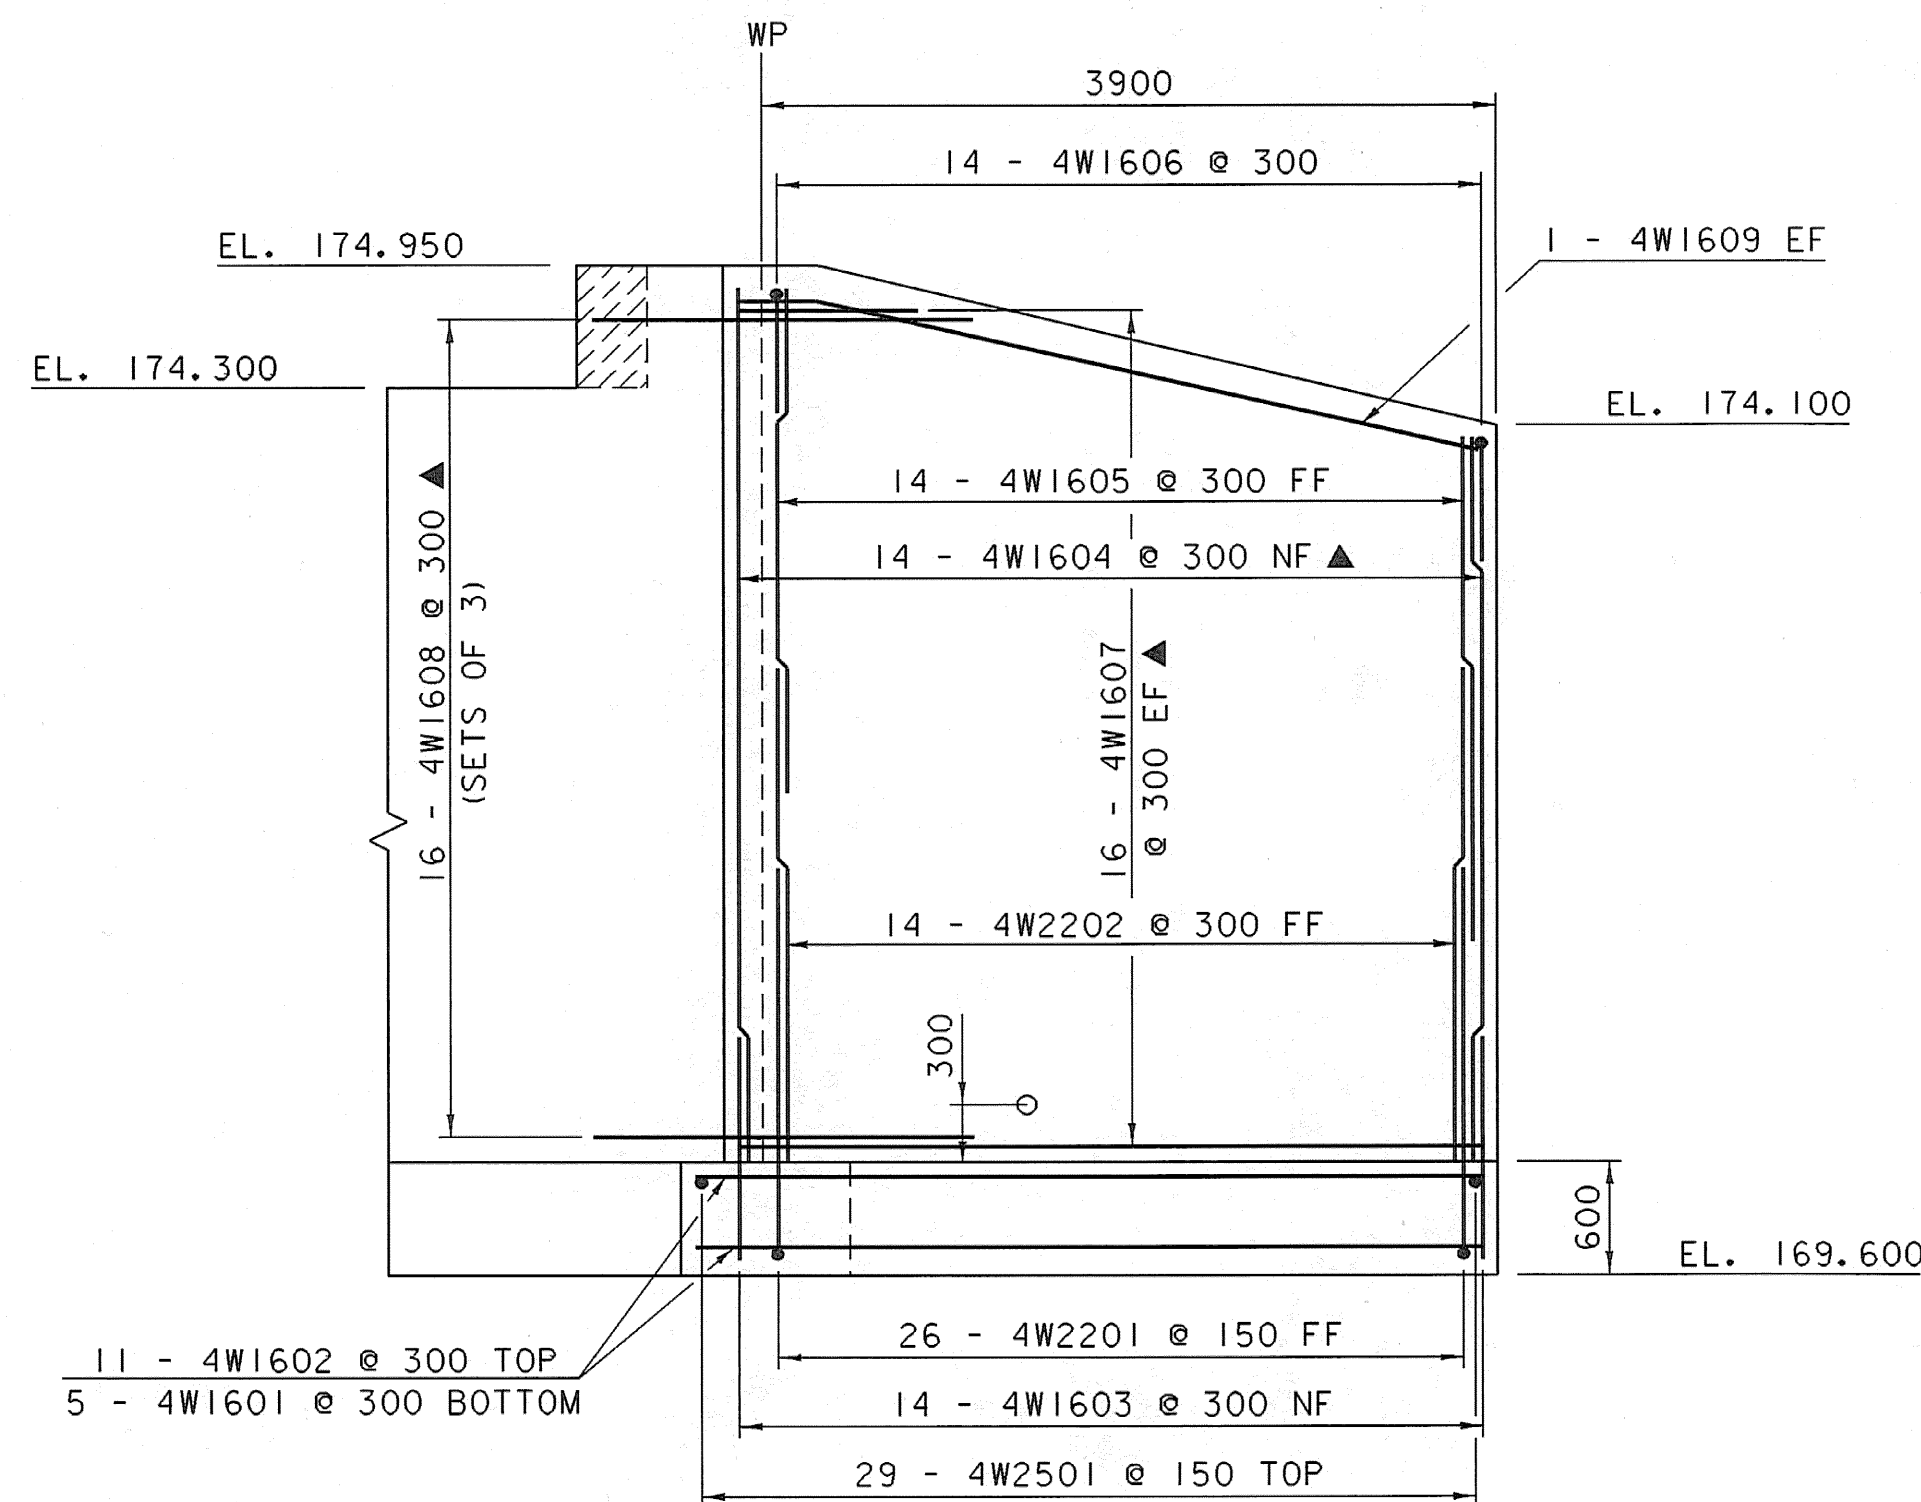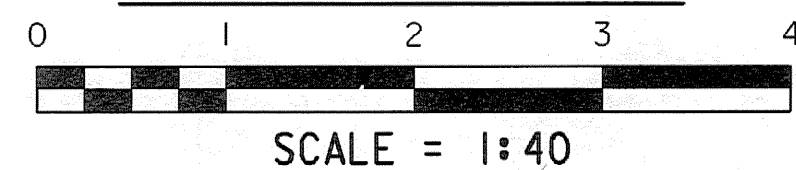

**WINGWALL NO. 4**

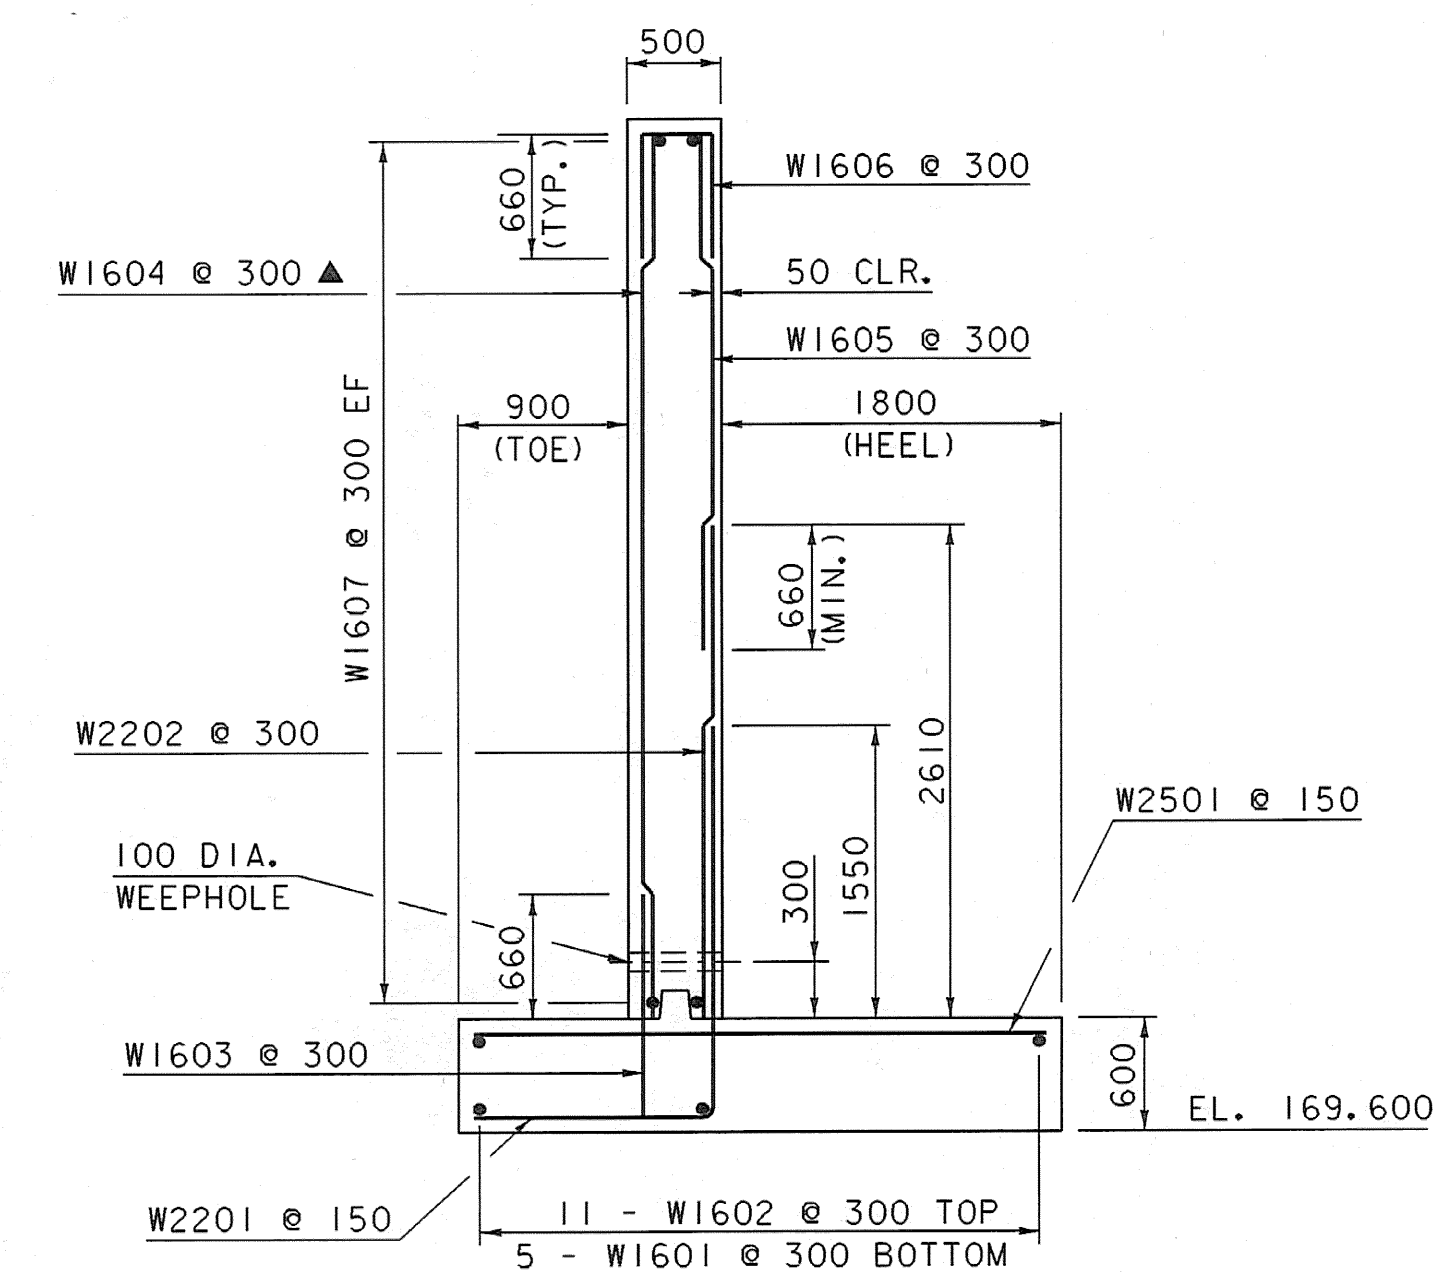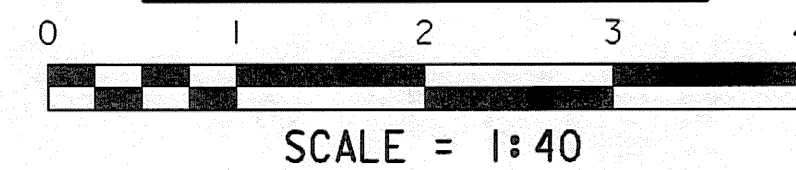

**WINGWALL TYPICAL**

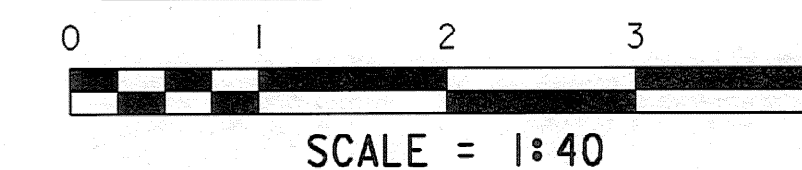

**NOTE:**

- NF = NEAR FACE
- FF = FAR FACE
- EF = EACH FACE
- ▲ = CUT TO FIT IN FIELD
- 80 CLR. UNLESS OTHERWISE SPECIFIED ON THE PLANS.

**WINGWALL DETAILS**

PROJECT NAME: GUILFORD	PLOT DATE: 15-APR-2008
PROJECT NUMBER: BRO 1442(24)	DRAWN BY: L. BULLOCK
FILE NAME: sj076ww.i	CHECKED BY: T. LACKEY
PROJECT LEADER: R. WHITCOMB	SHEET 41 OF 59
DESIGNED BY: J. PERRIGO	
94J076\Structures\sj076ww.dgn	