



40+017


40+017
~~BEGIN APPROACH~~
~~MATCH EXISTING~~

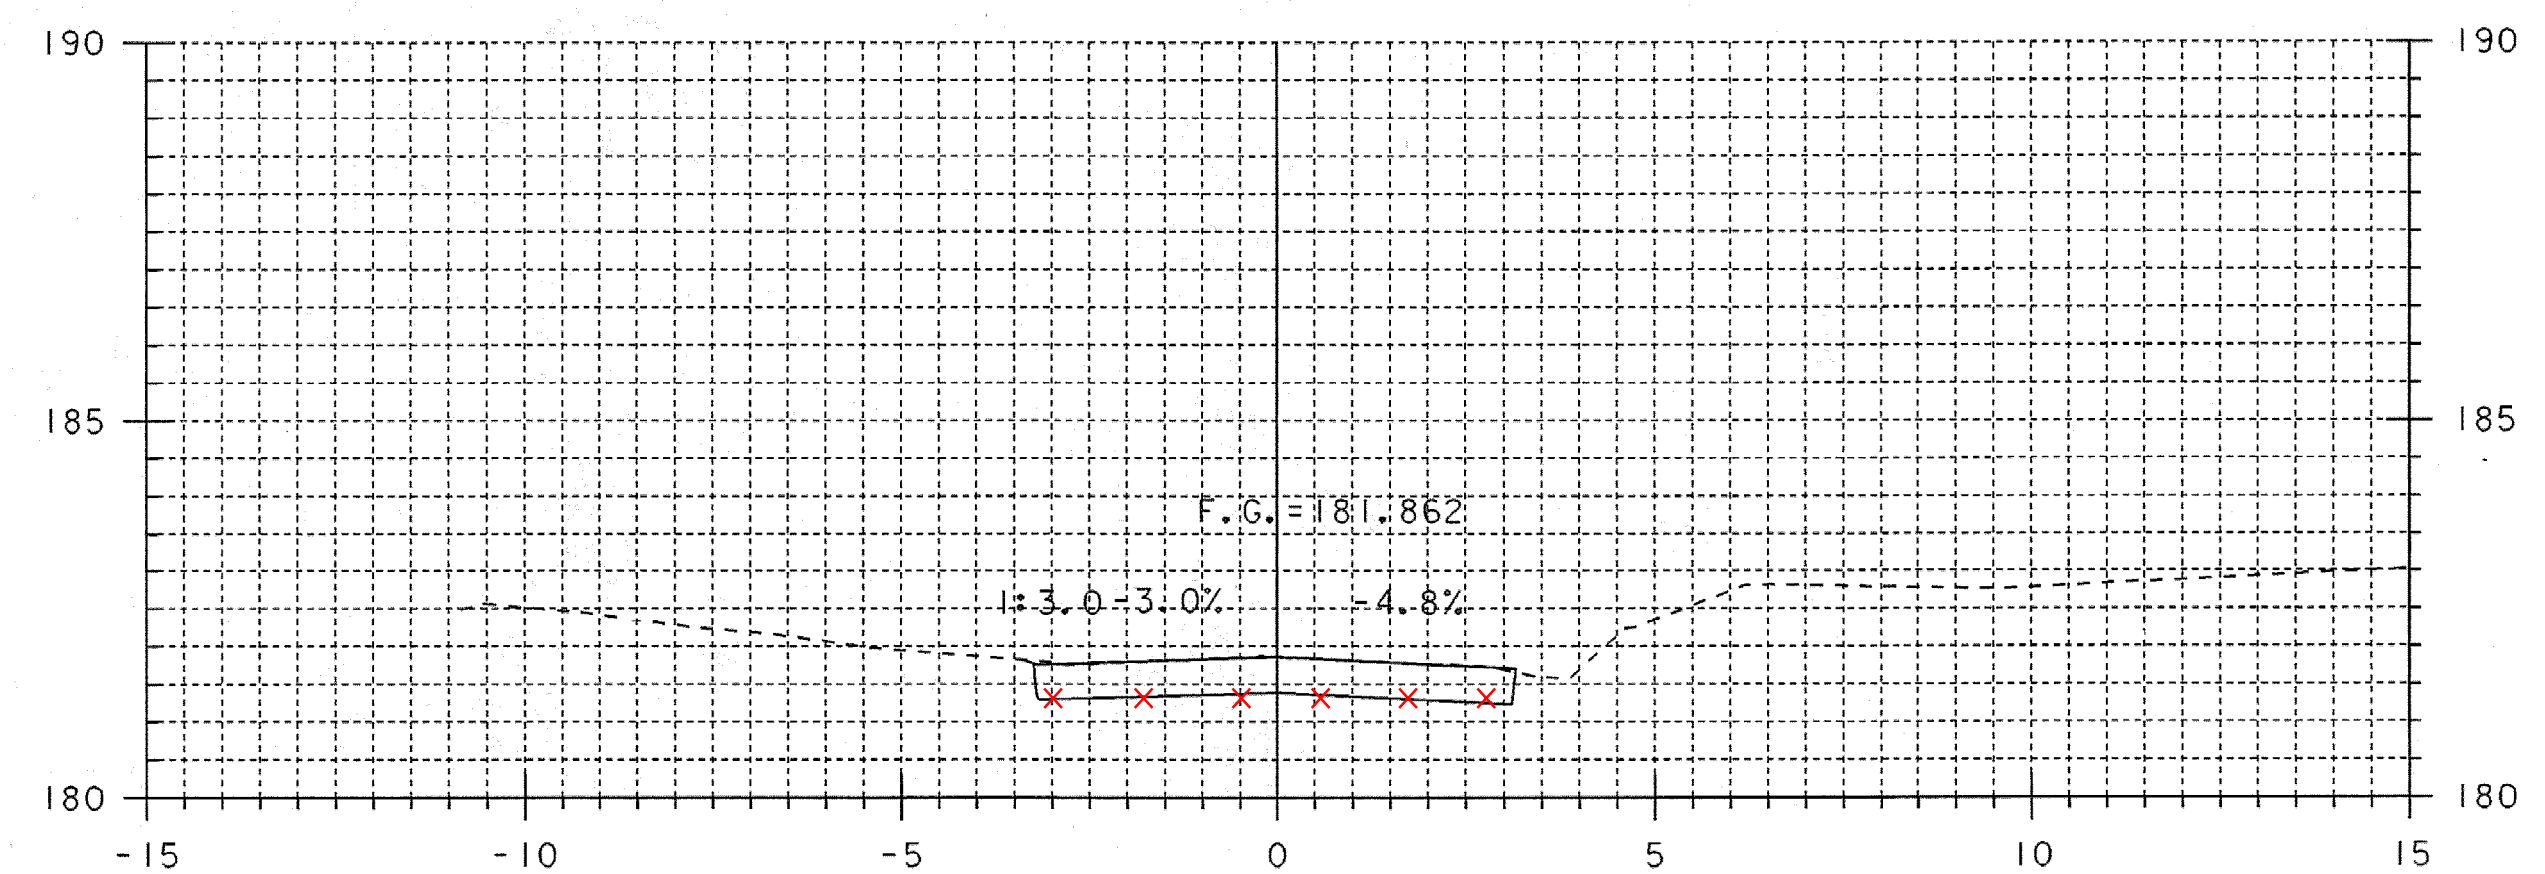

40+030

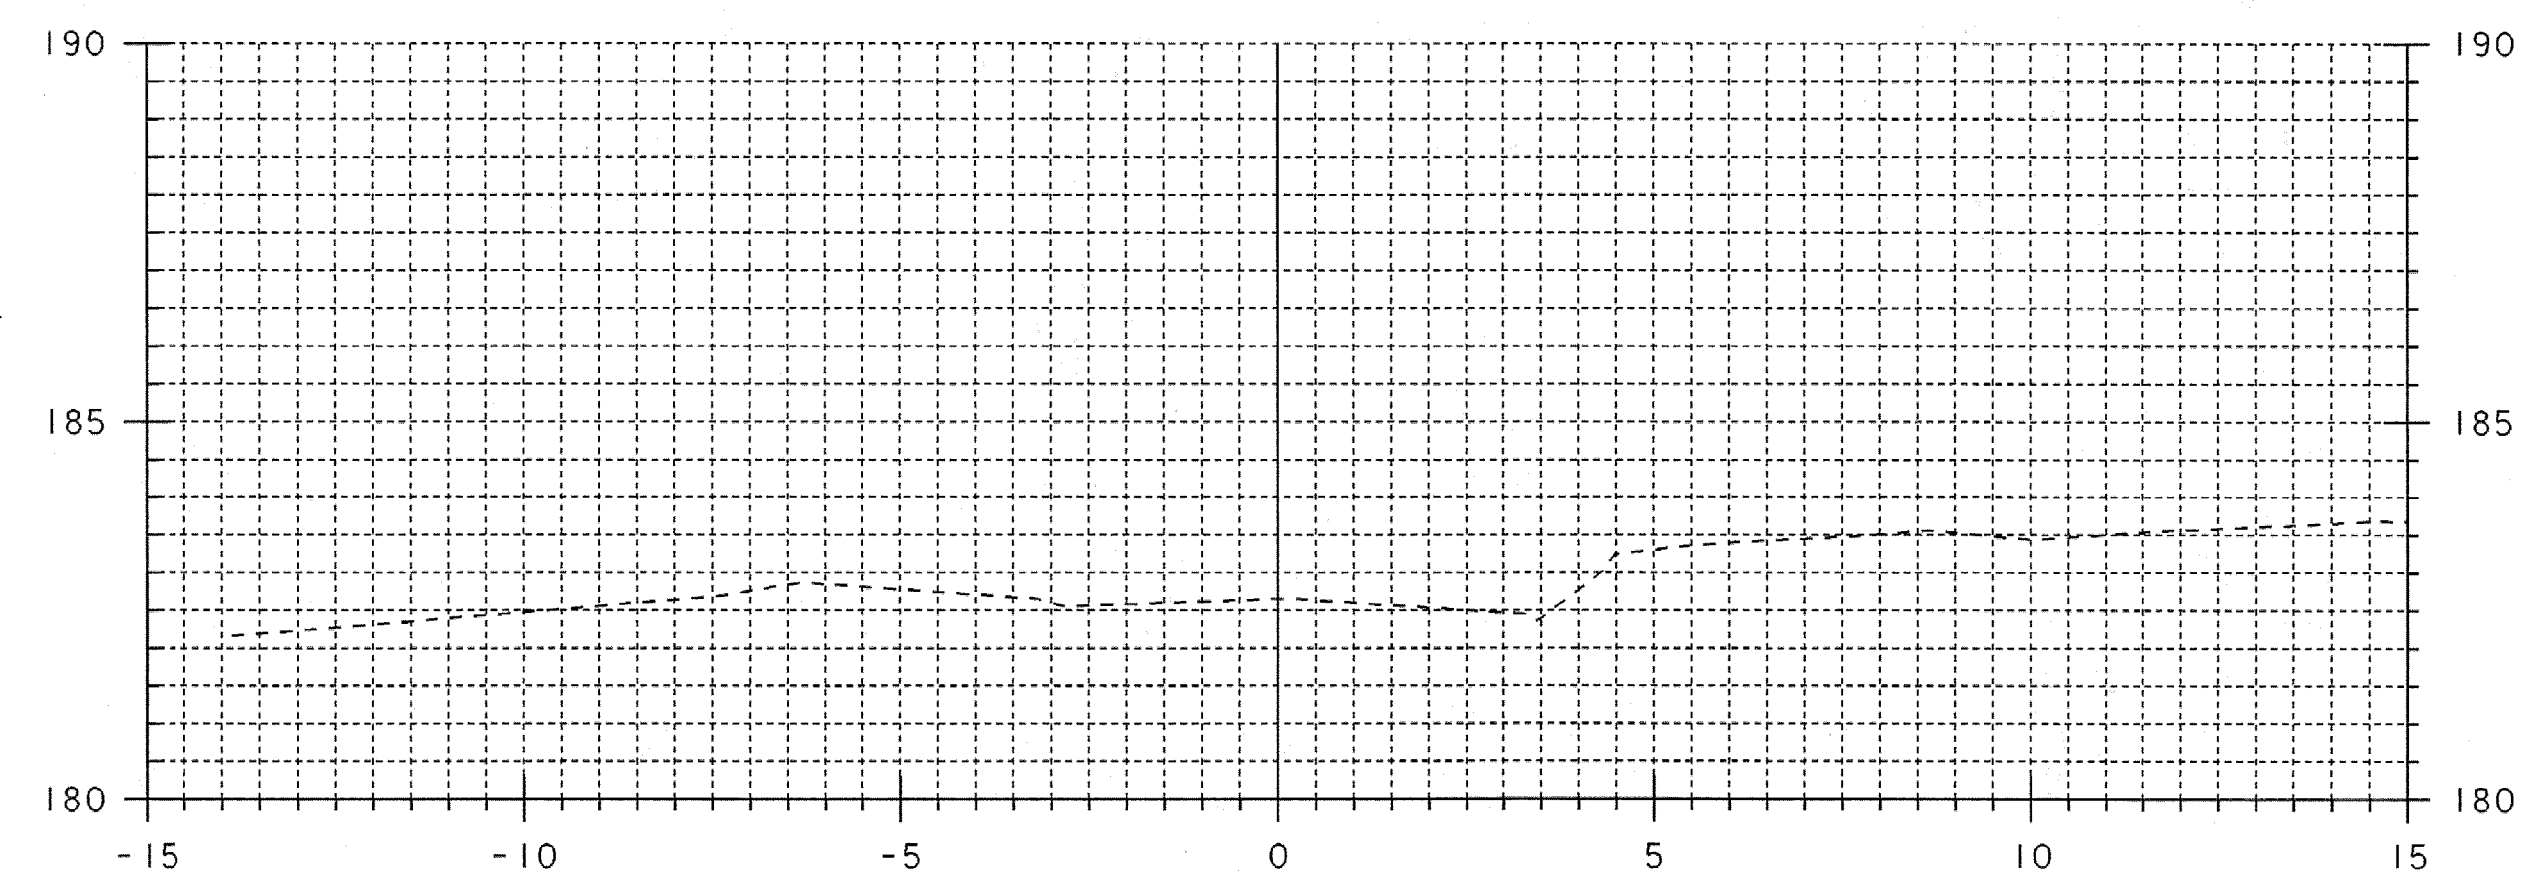


40+010

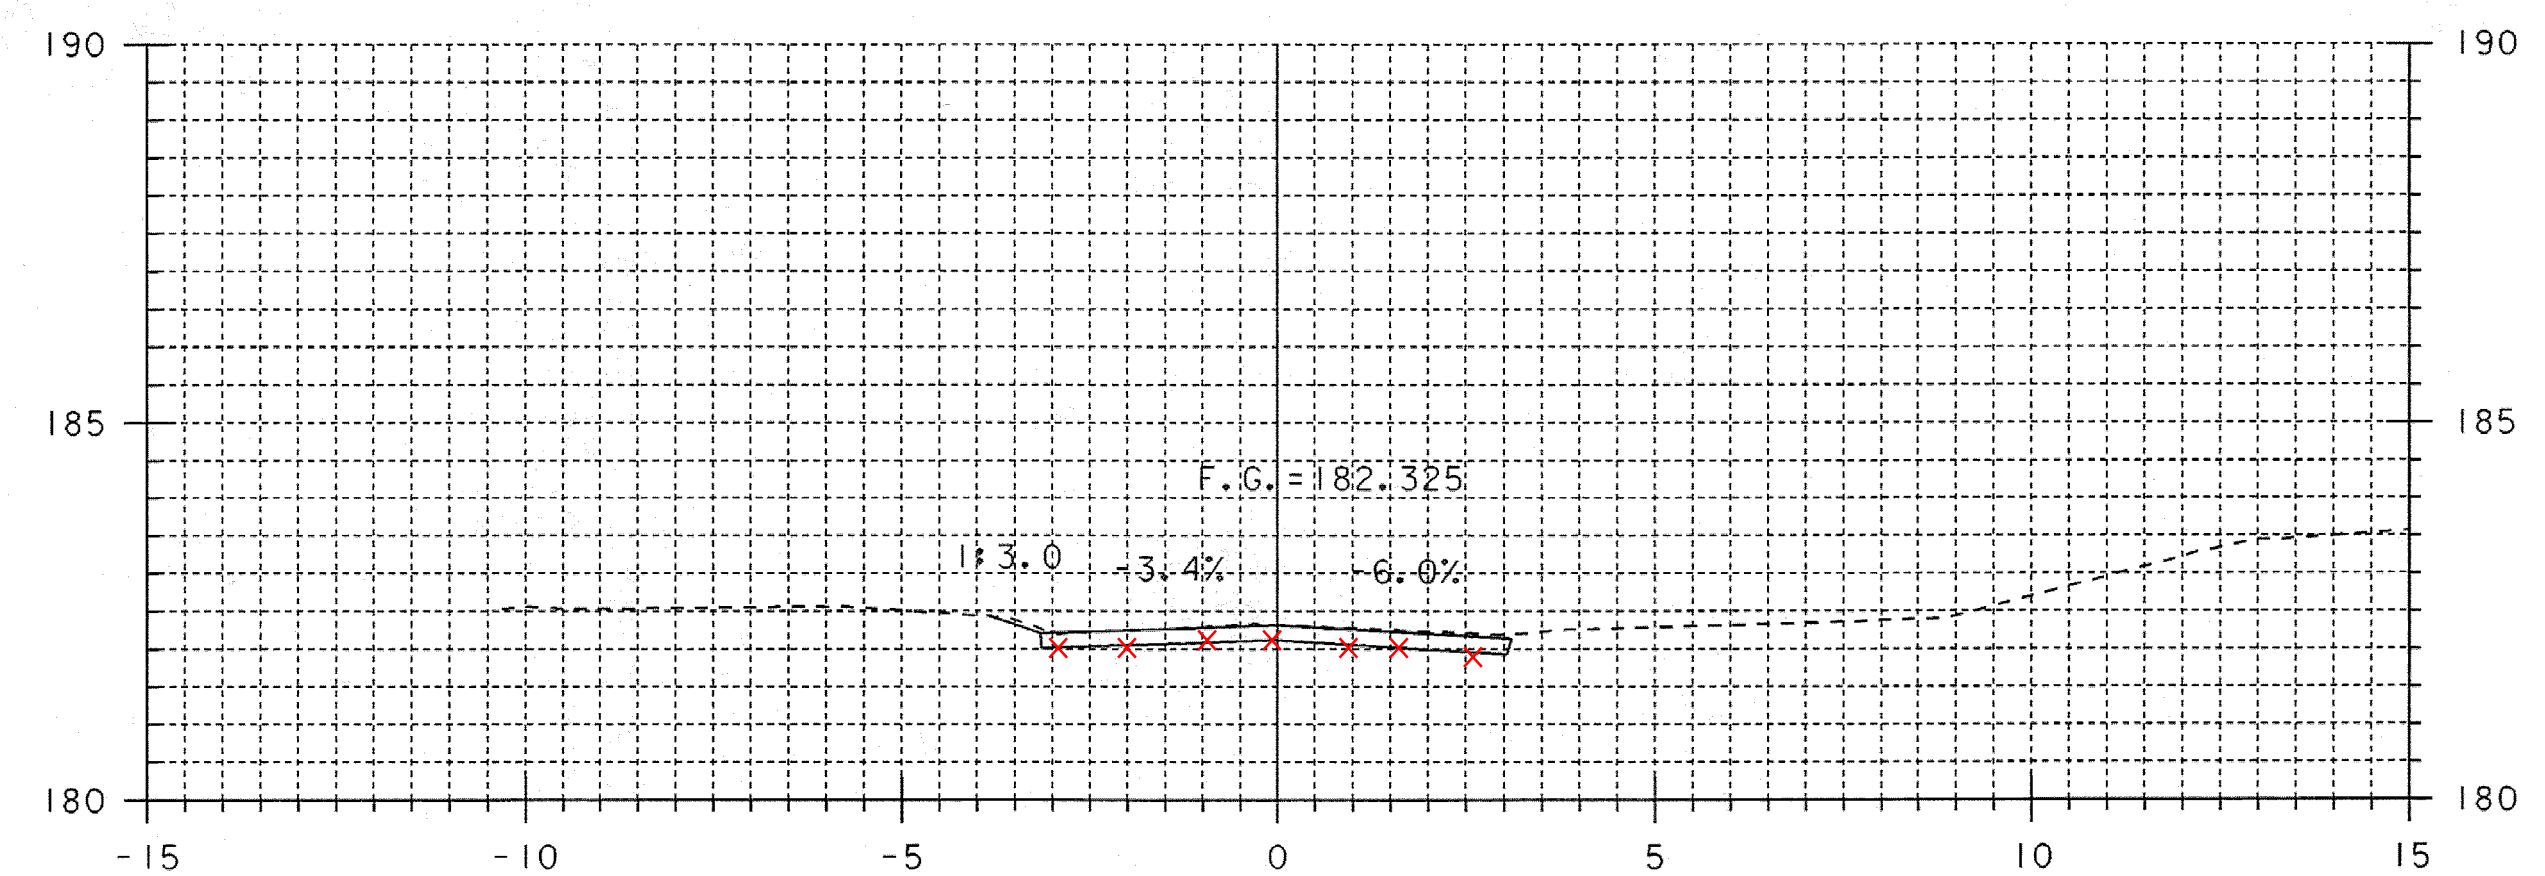

40+020

MAINLINE CROSS SECTIONS I

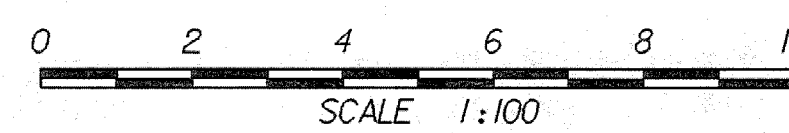

STA. 40+010 TO STA. 40+030

PROJECT NAME: GUILFORD	
PROJECT NUMBER: BRO 1442(24)	
FILE NAME: sj076m01.i	PLOT DATE: 15-APR-2008
PROJECT LEADER: R. WHITCOMB	DRAWN BY: T. LACKEY
DESIGNED BY: J. PERRIGO	CHECKED BY: T. LACKEY
94\076\Structures\sj076xs3.dgn	SHEET 44 OF 59