




40+042  
BEGIN AGGREGATE SURFACE COURSE

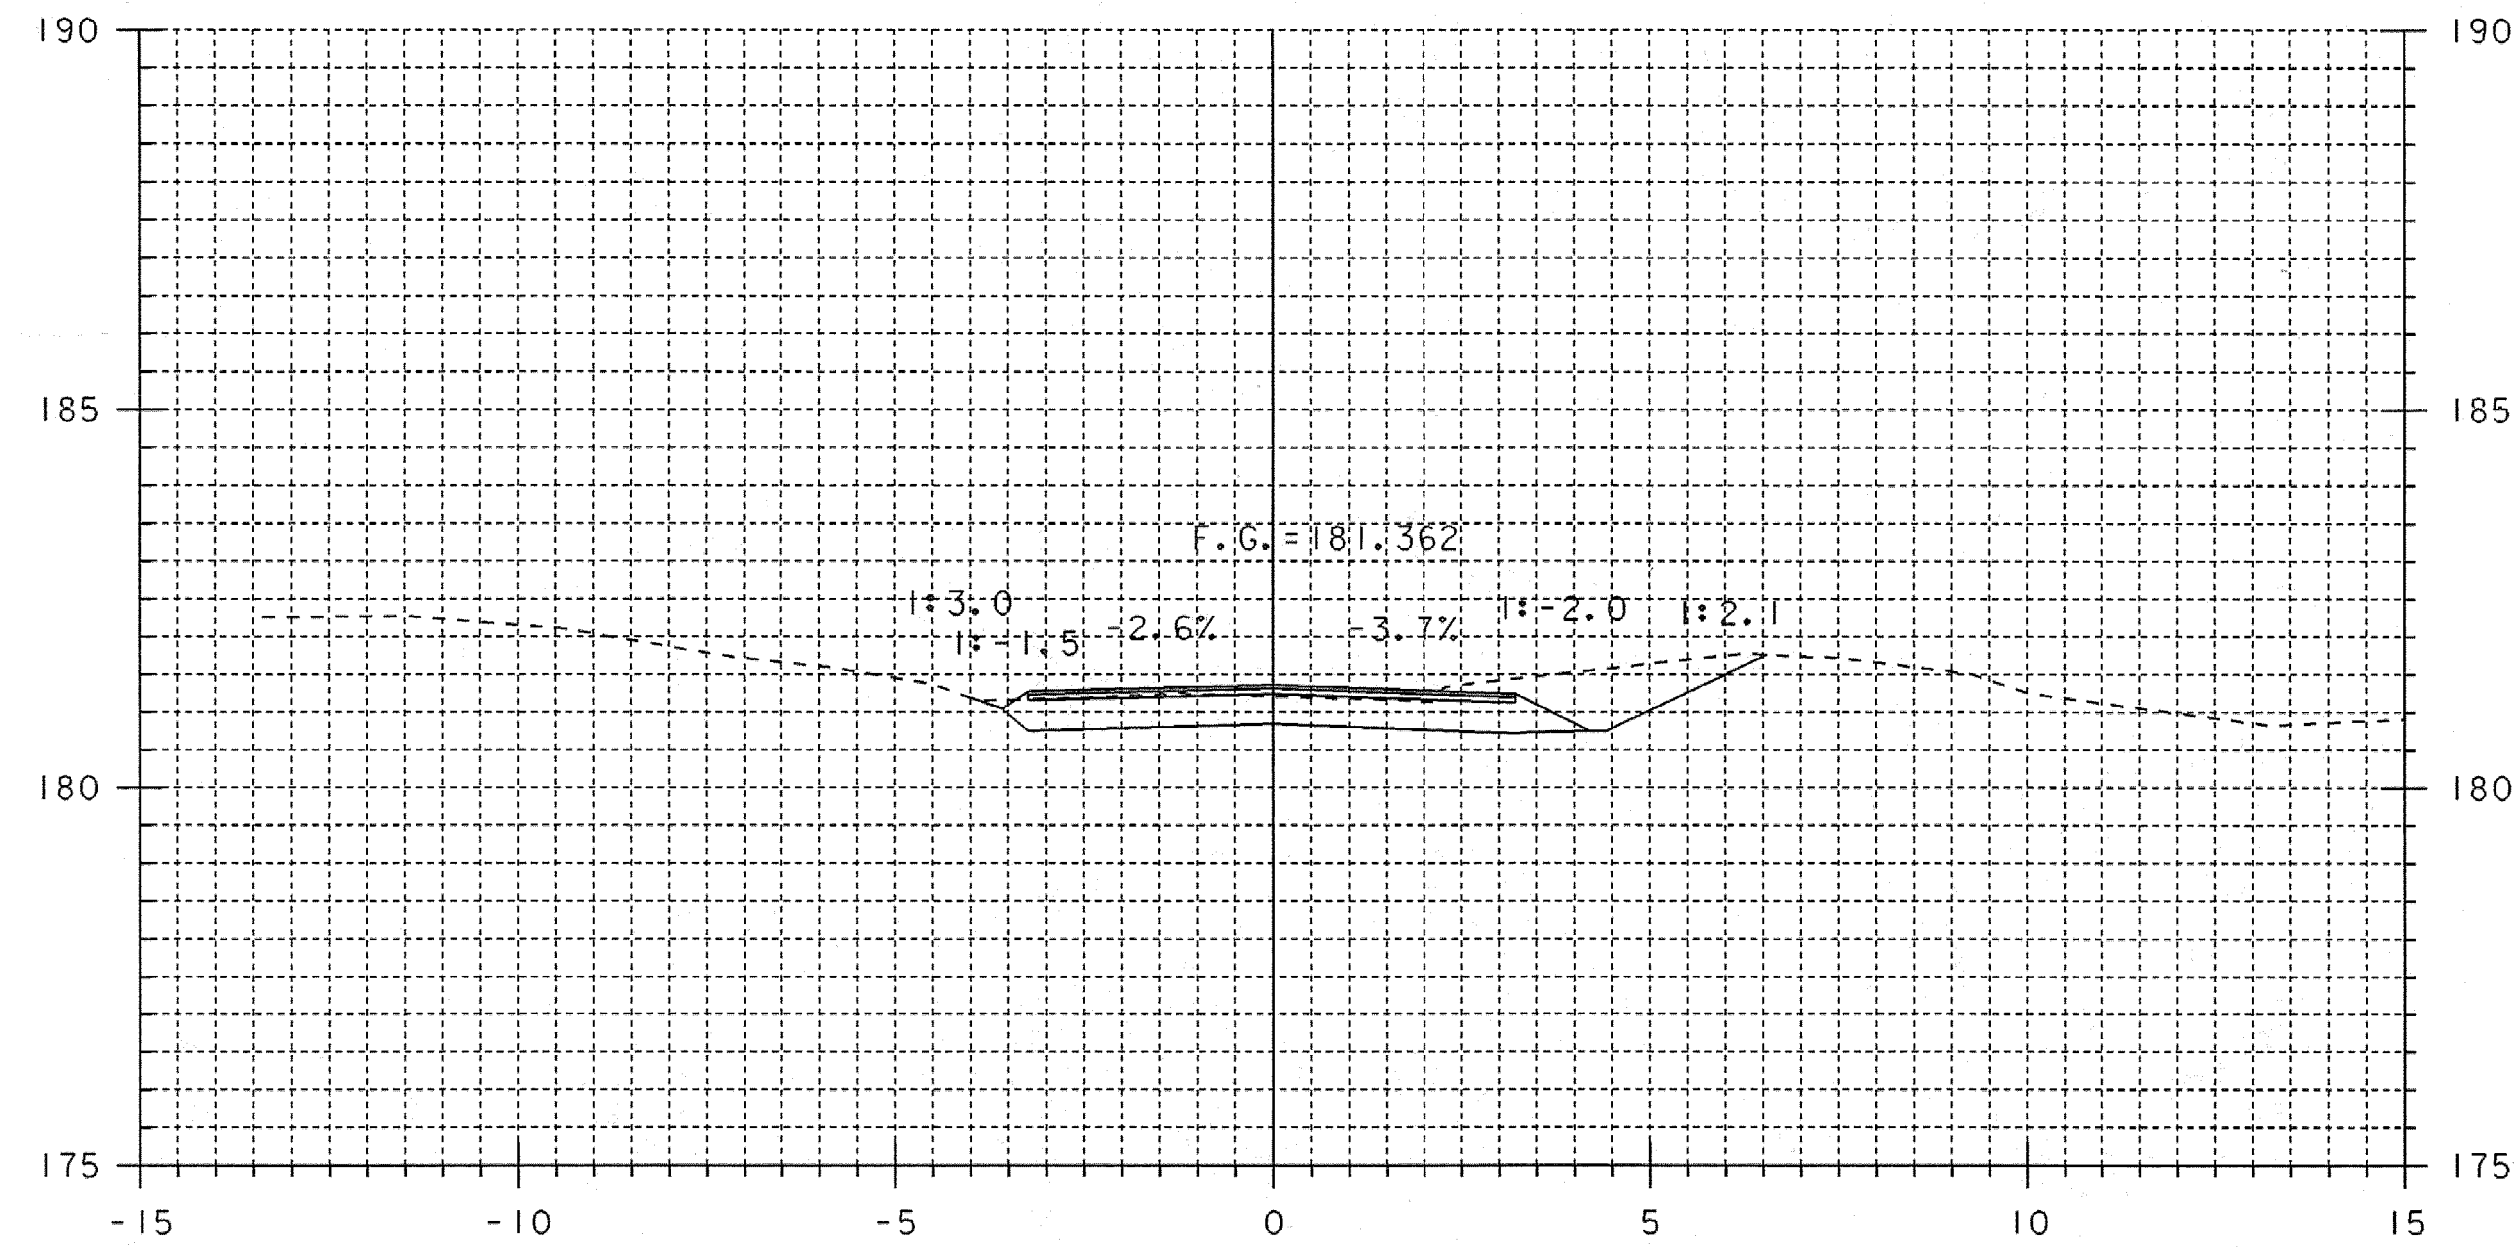

40+040

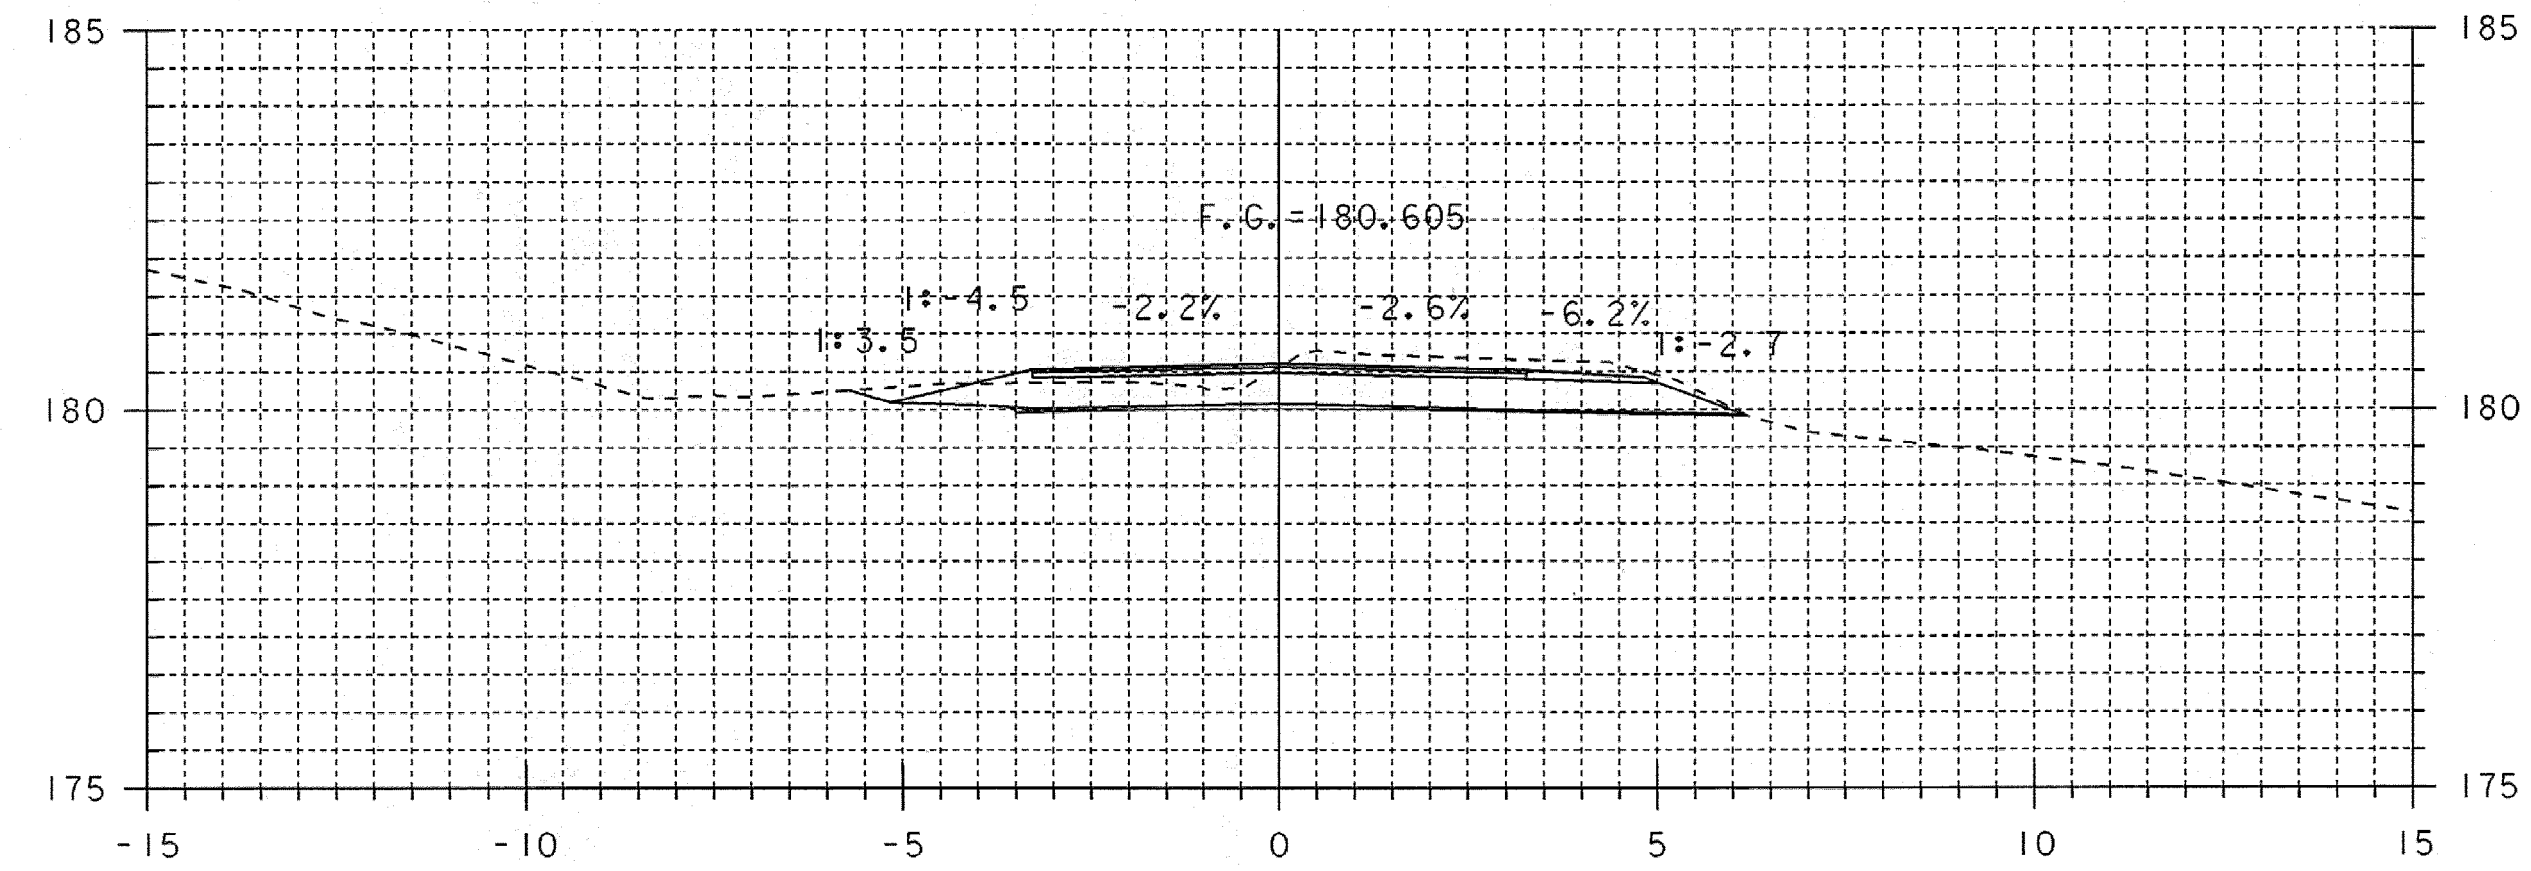


40+050

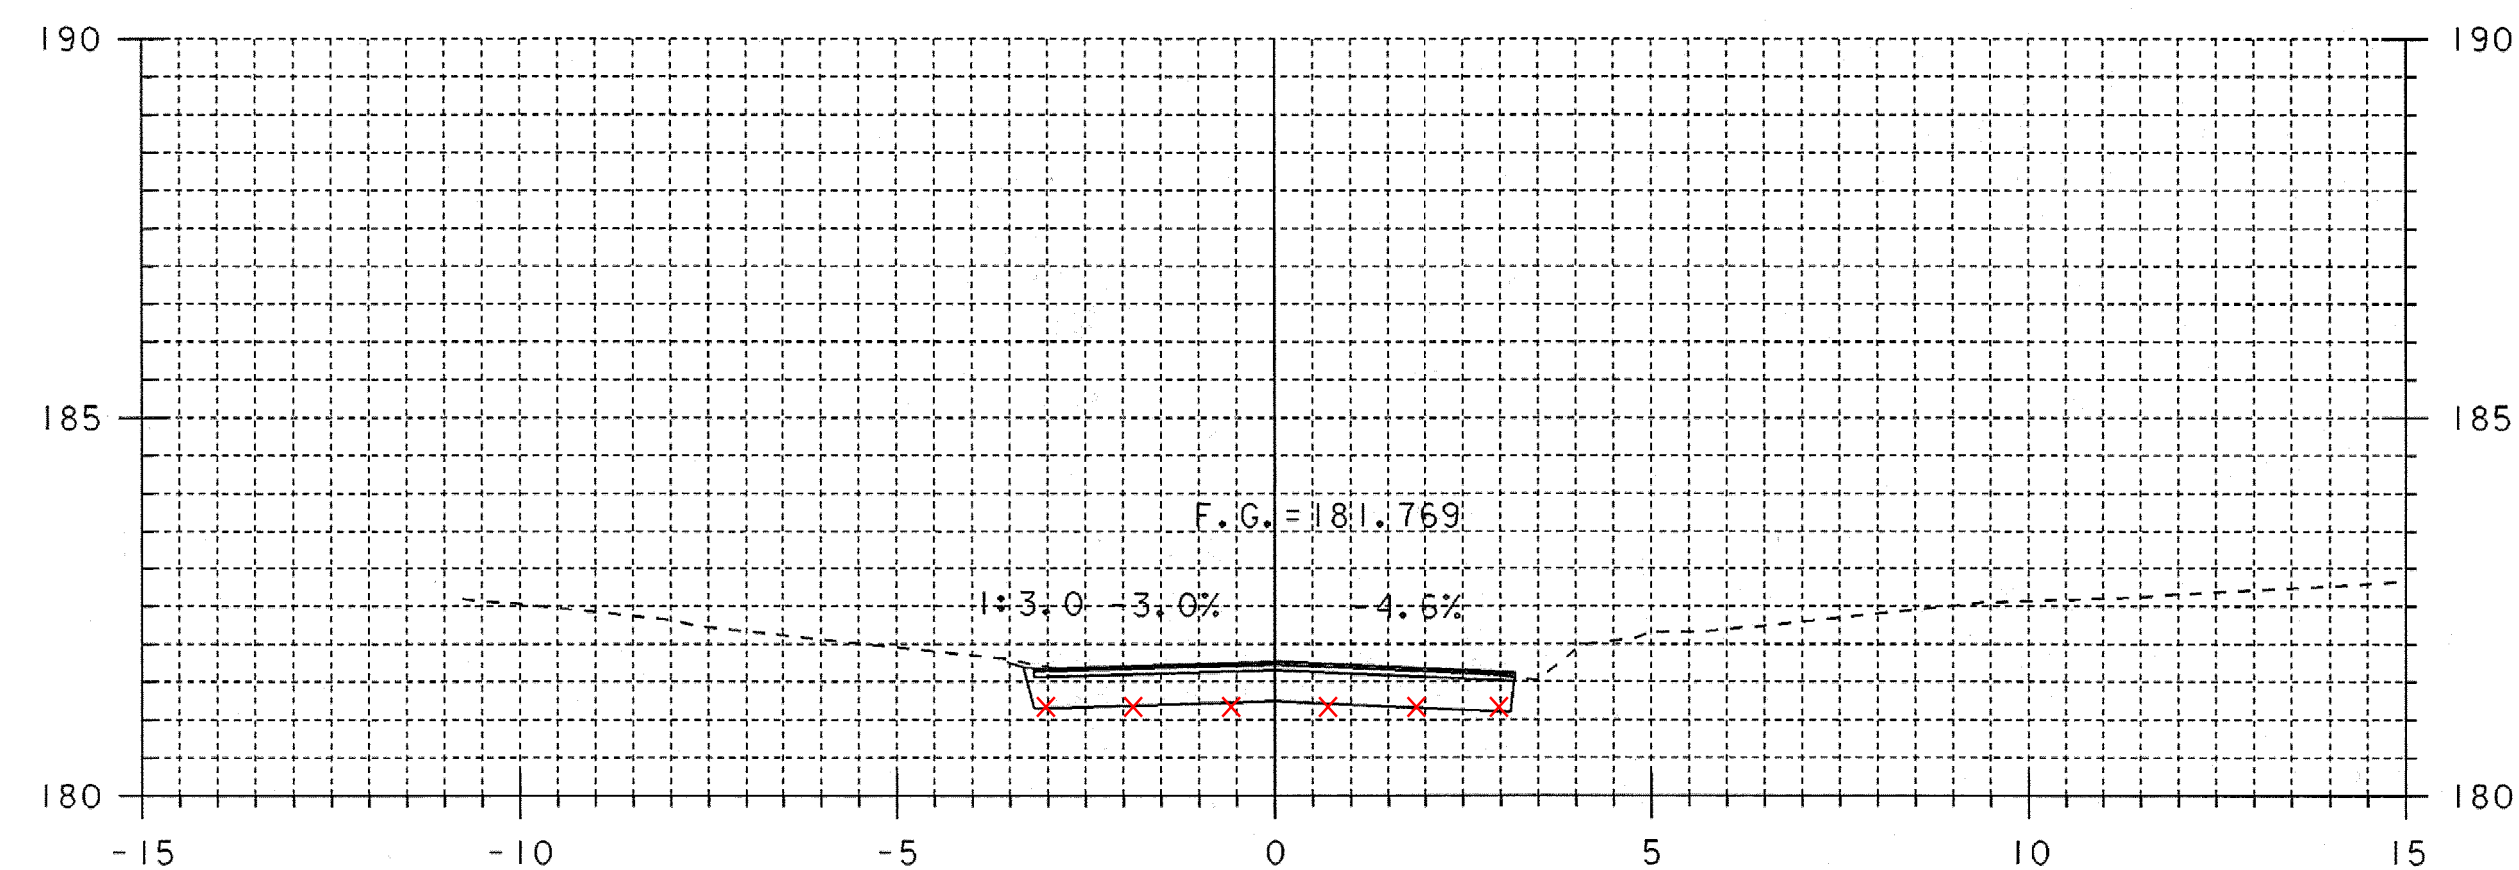

40+032


40+032  
~~BEGIN PAVEMENT~~  
MATCH EXISTING

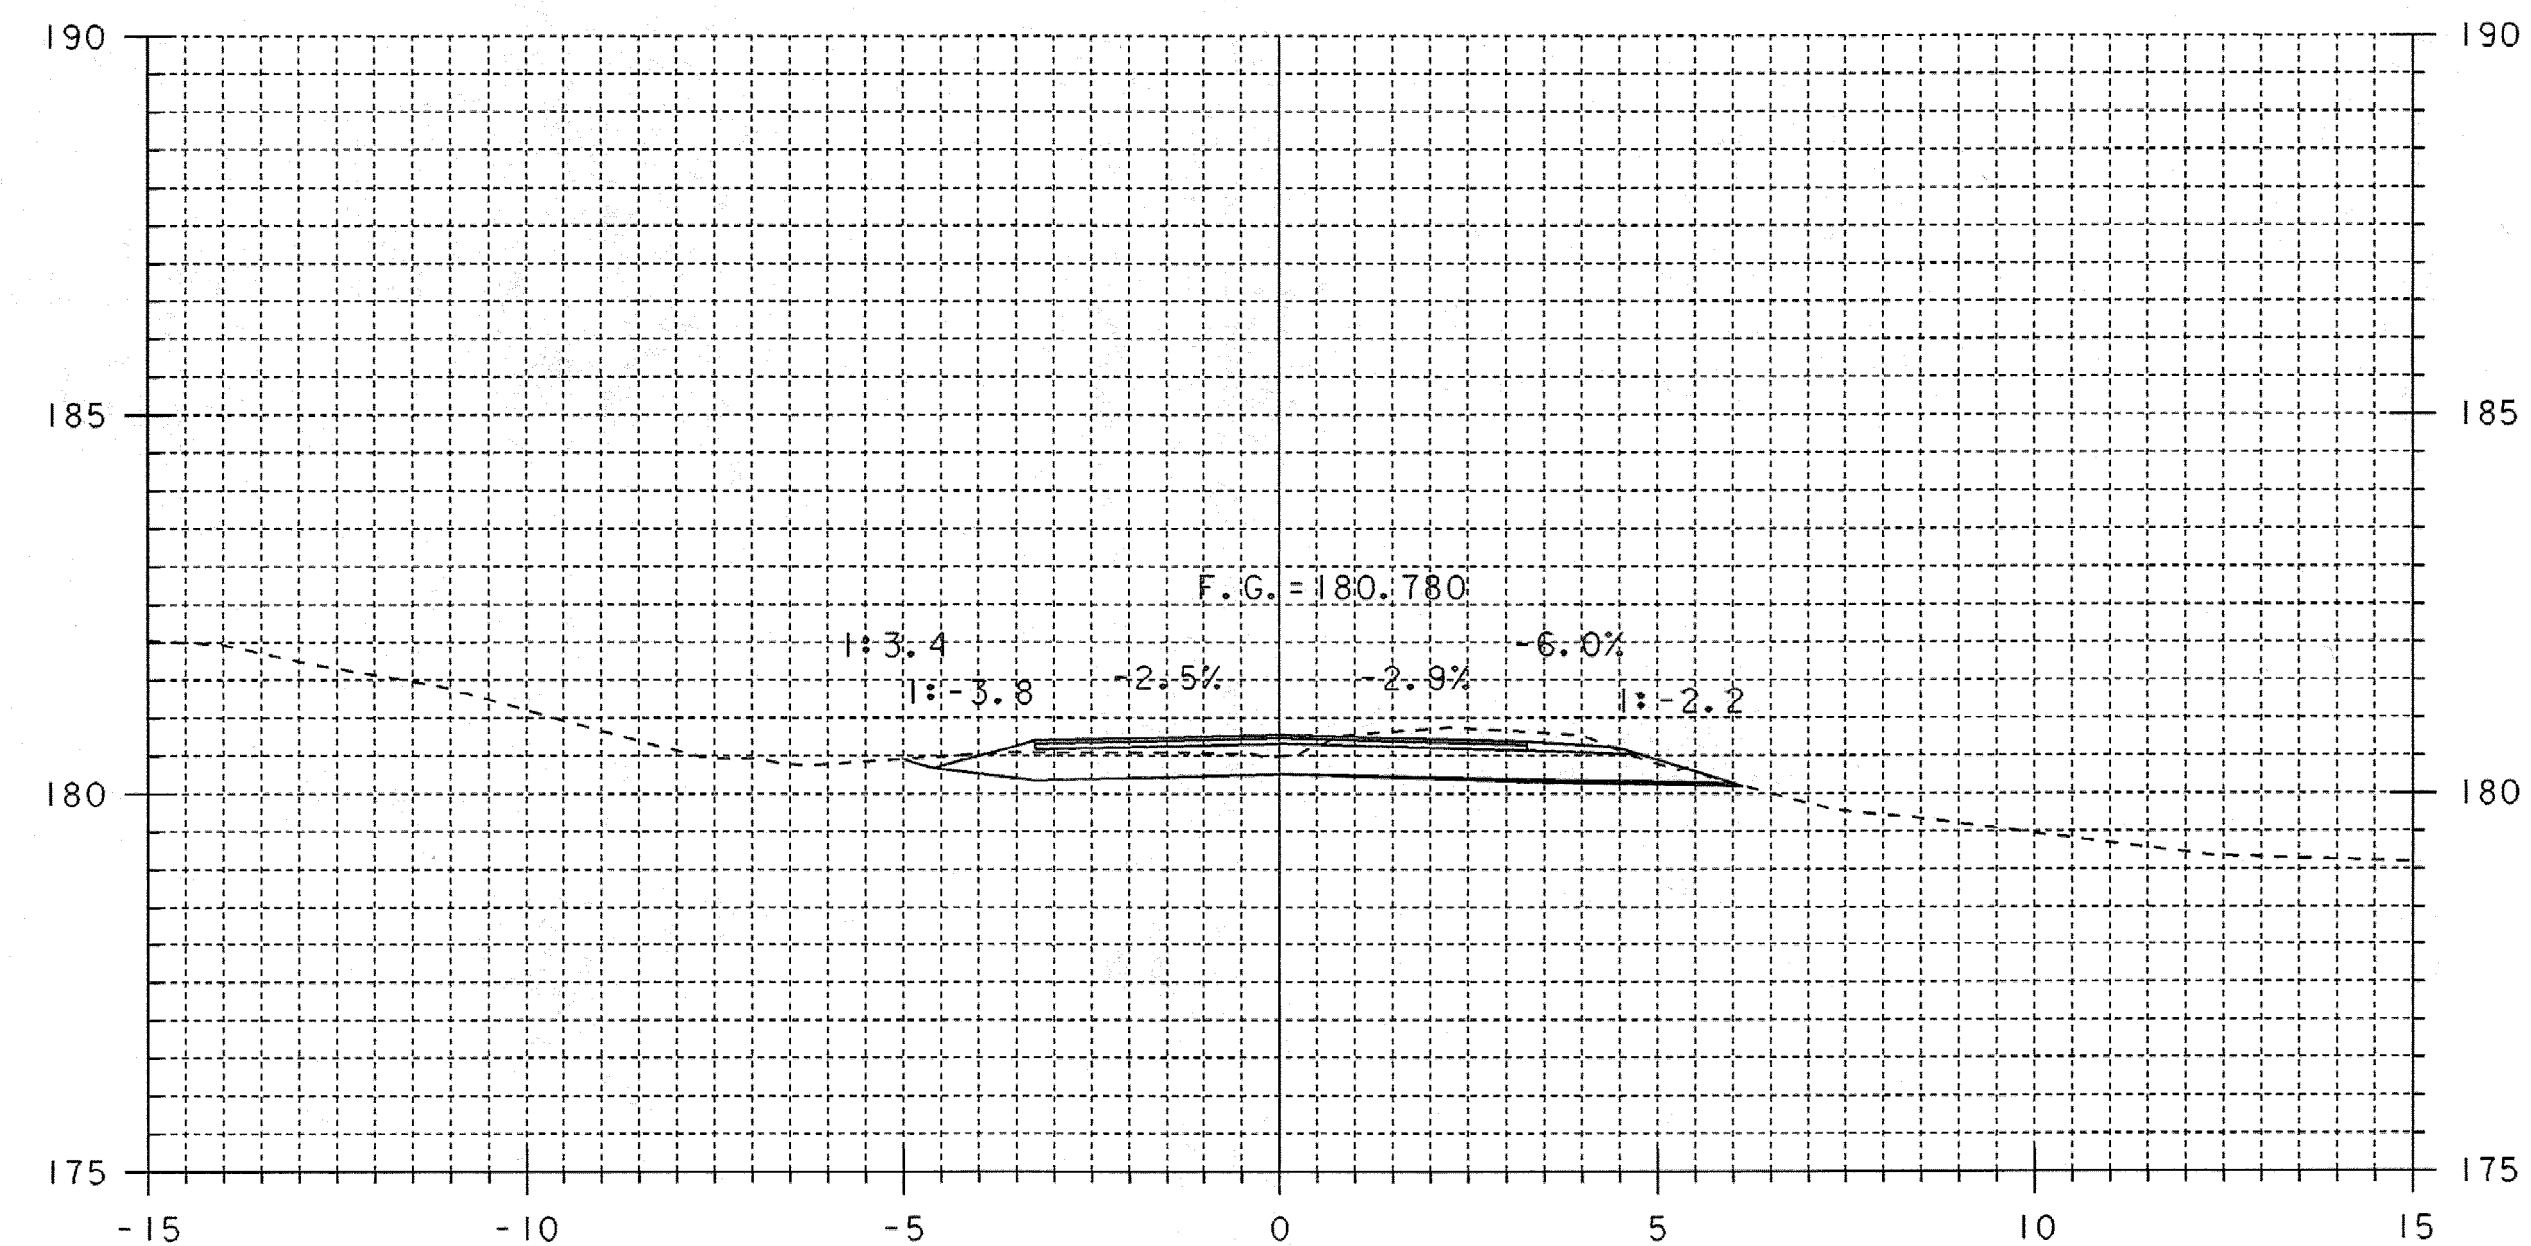

40+048

40+048  
BEGIN SAND BORROW

MAINLINE CROSS SECTIONS 2

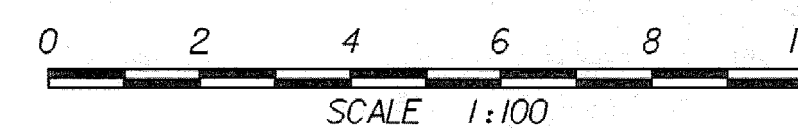

STA. 40+032 TO STA. 40+050

PROJECT NAME:	GUILFORD	PLOT DATE:	15-APR-2008
PROJECT NUMBER:	BRO 1442(24)	DRAWN BY:	T. LACKEY
FILE NAME:	sj076m02.i	DESIGNED BY:	J. PERRIGO
PROJECT LEADER:	R. WHITCOMB	CHECKED BY:	T. LACKEY
DESIGNED BY:	J. PERRIGO		
94J076\Structures\sj076xs3.dgn		SHEET	45 OF 59