



40+064.000
BEGIN AGGREGATE SURFACE COURSE

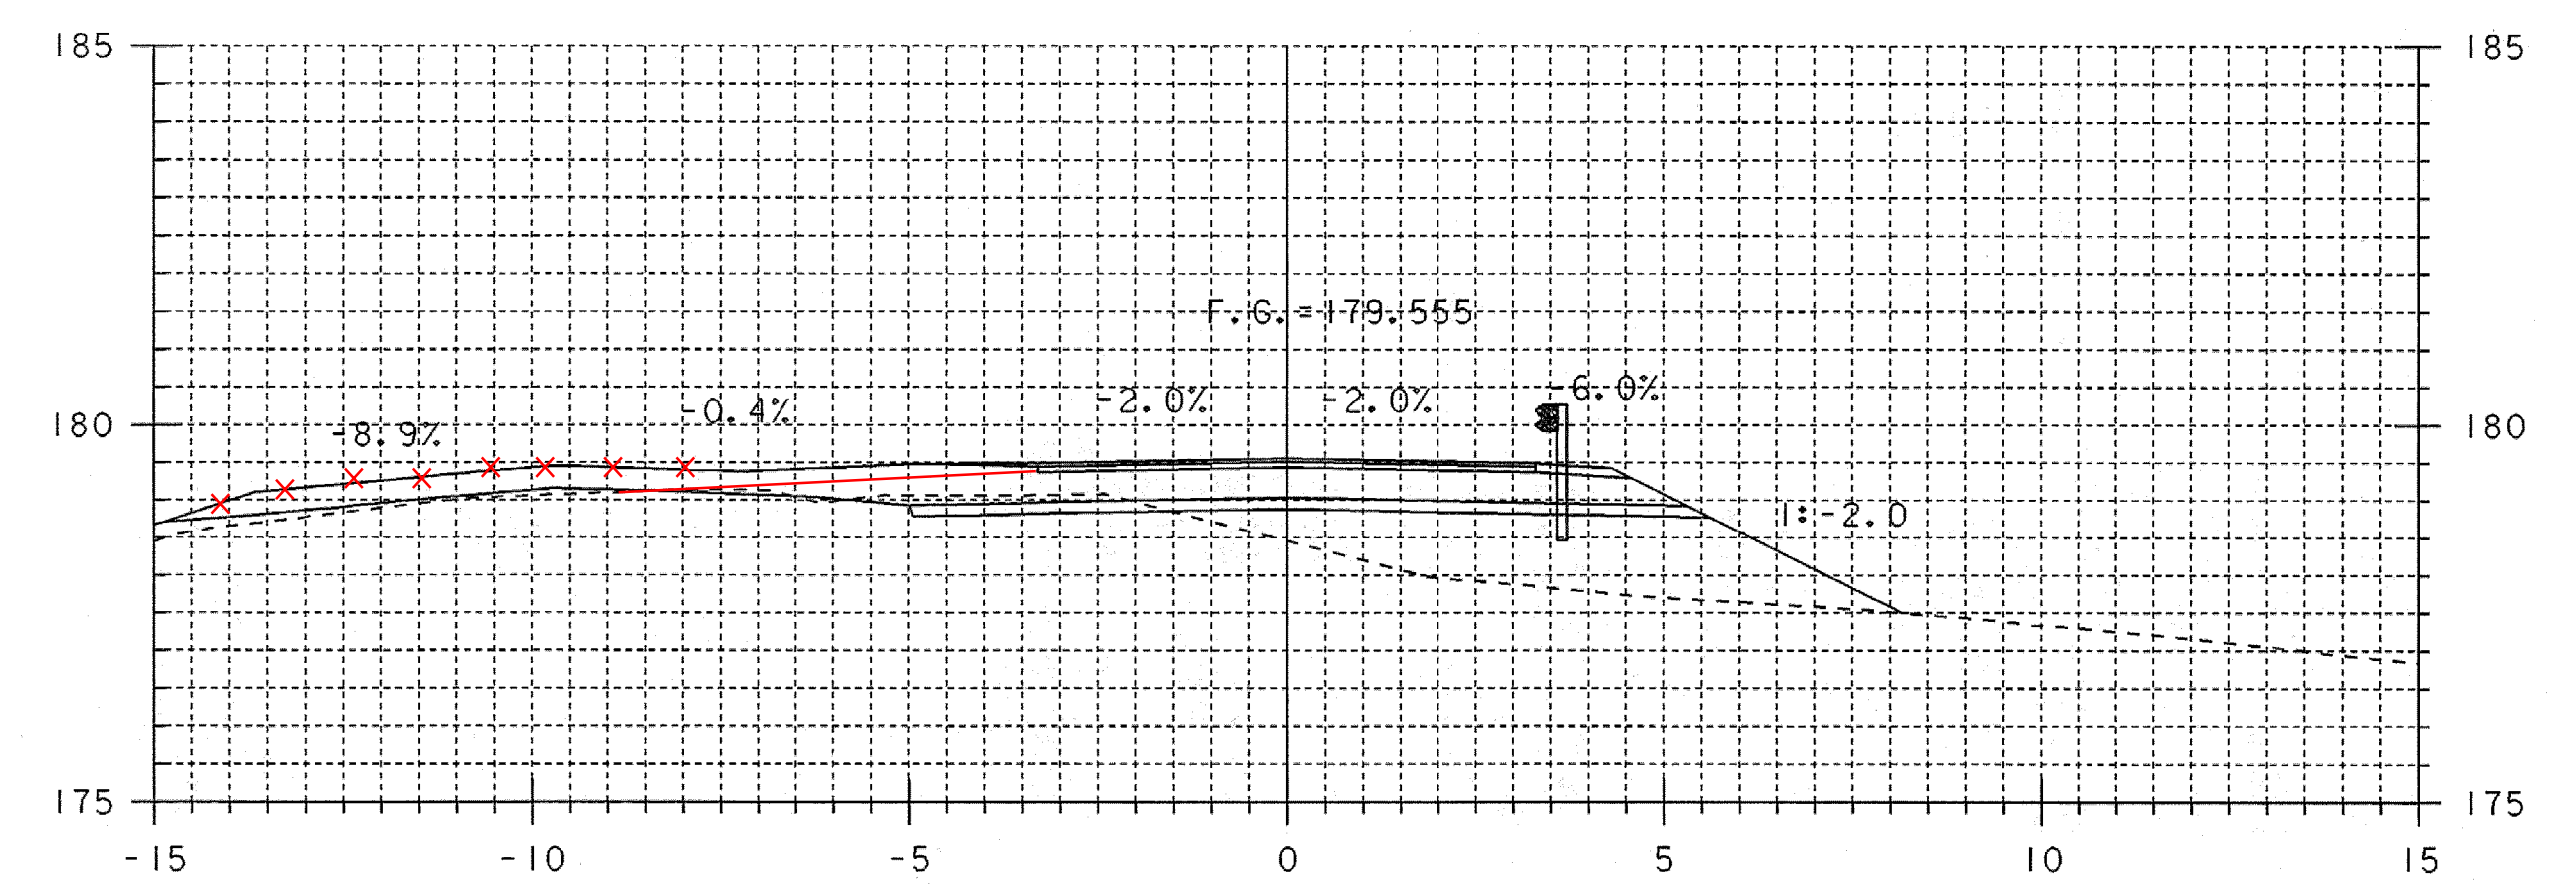


40+060

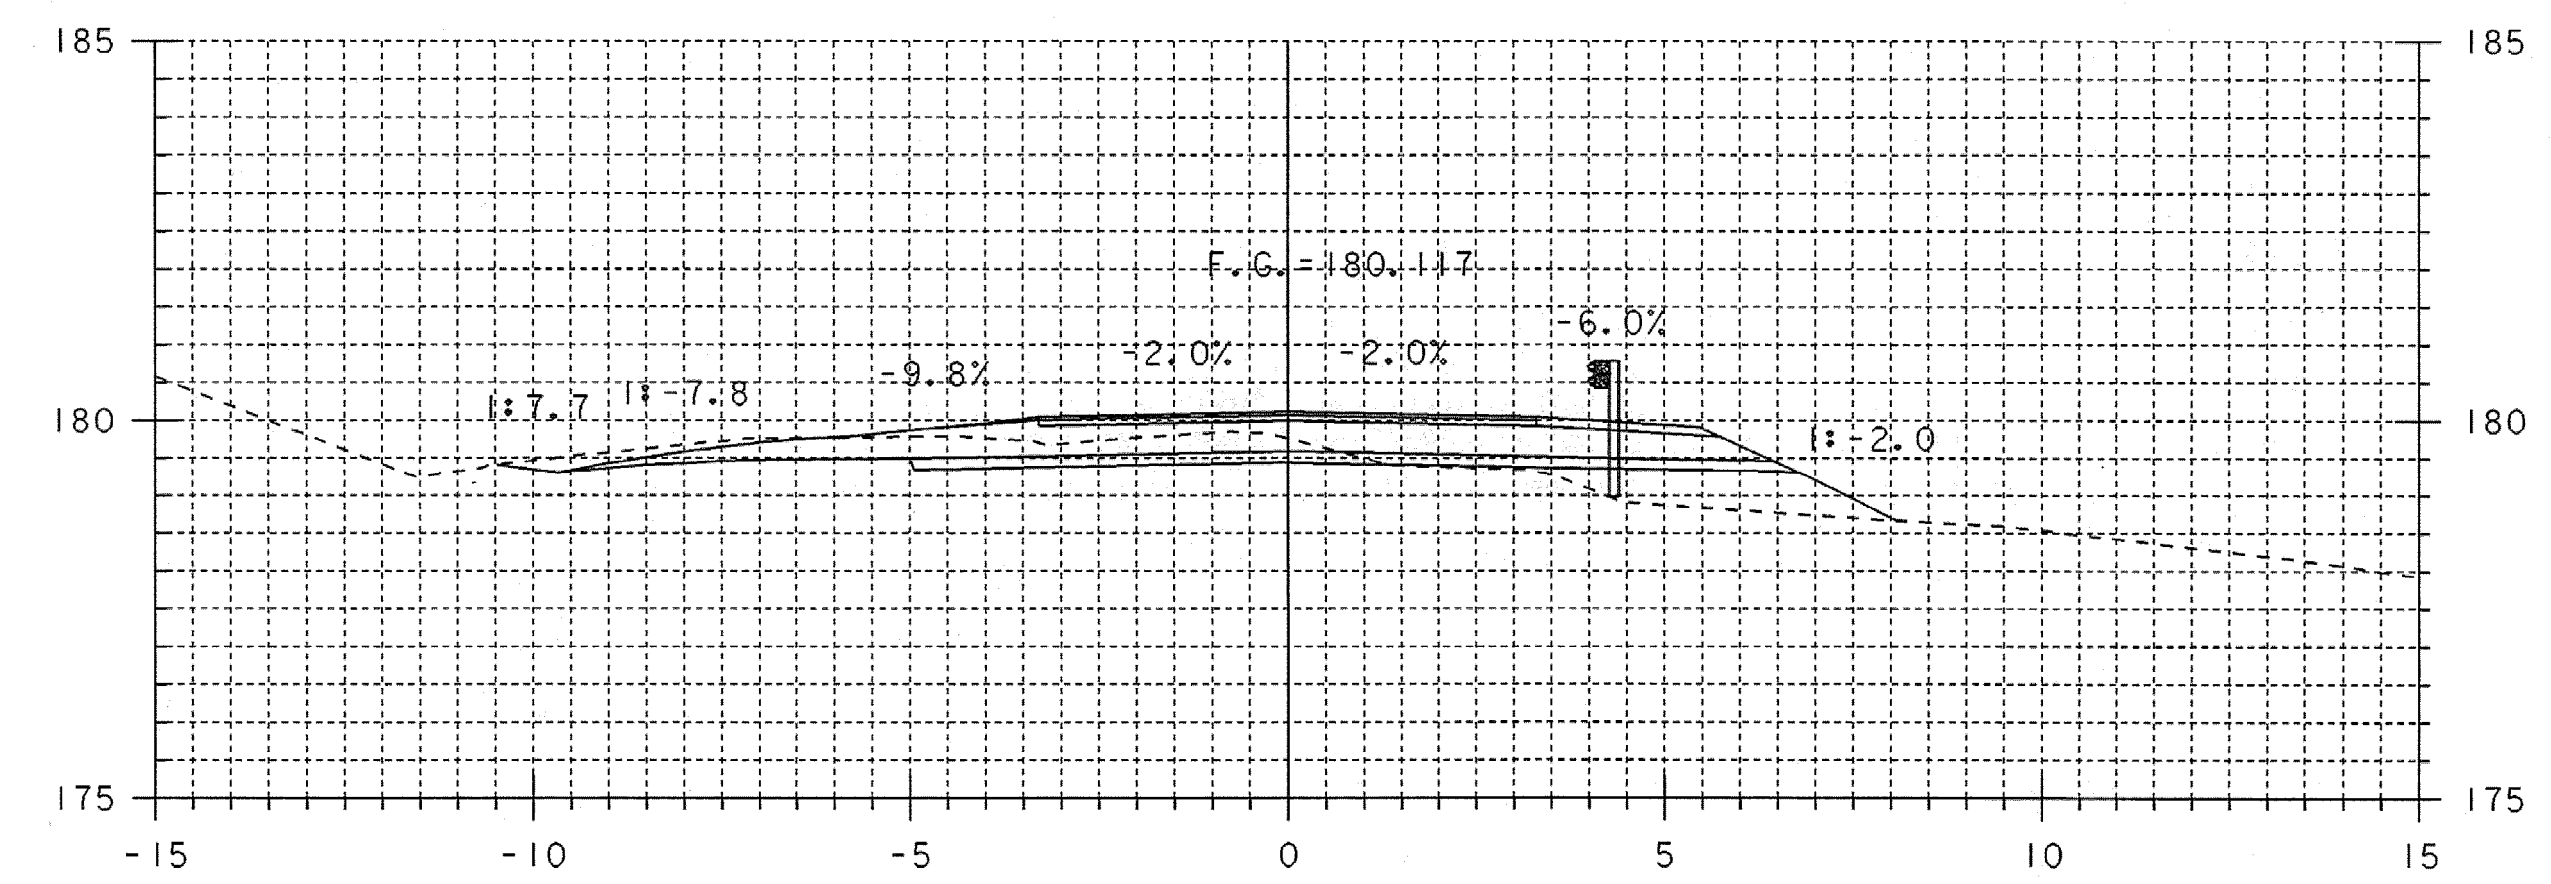


40+055

40+055.000
DRIVE 6+000.000
BEGIN PROJECT

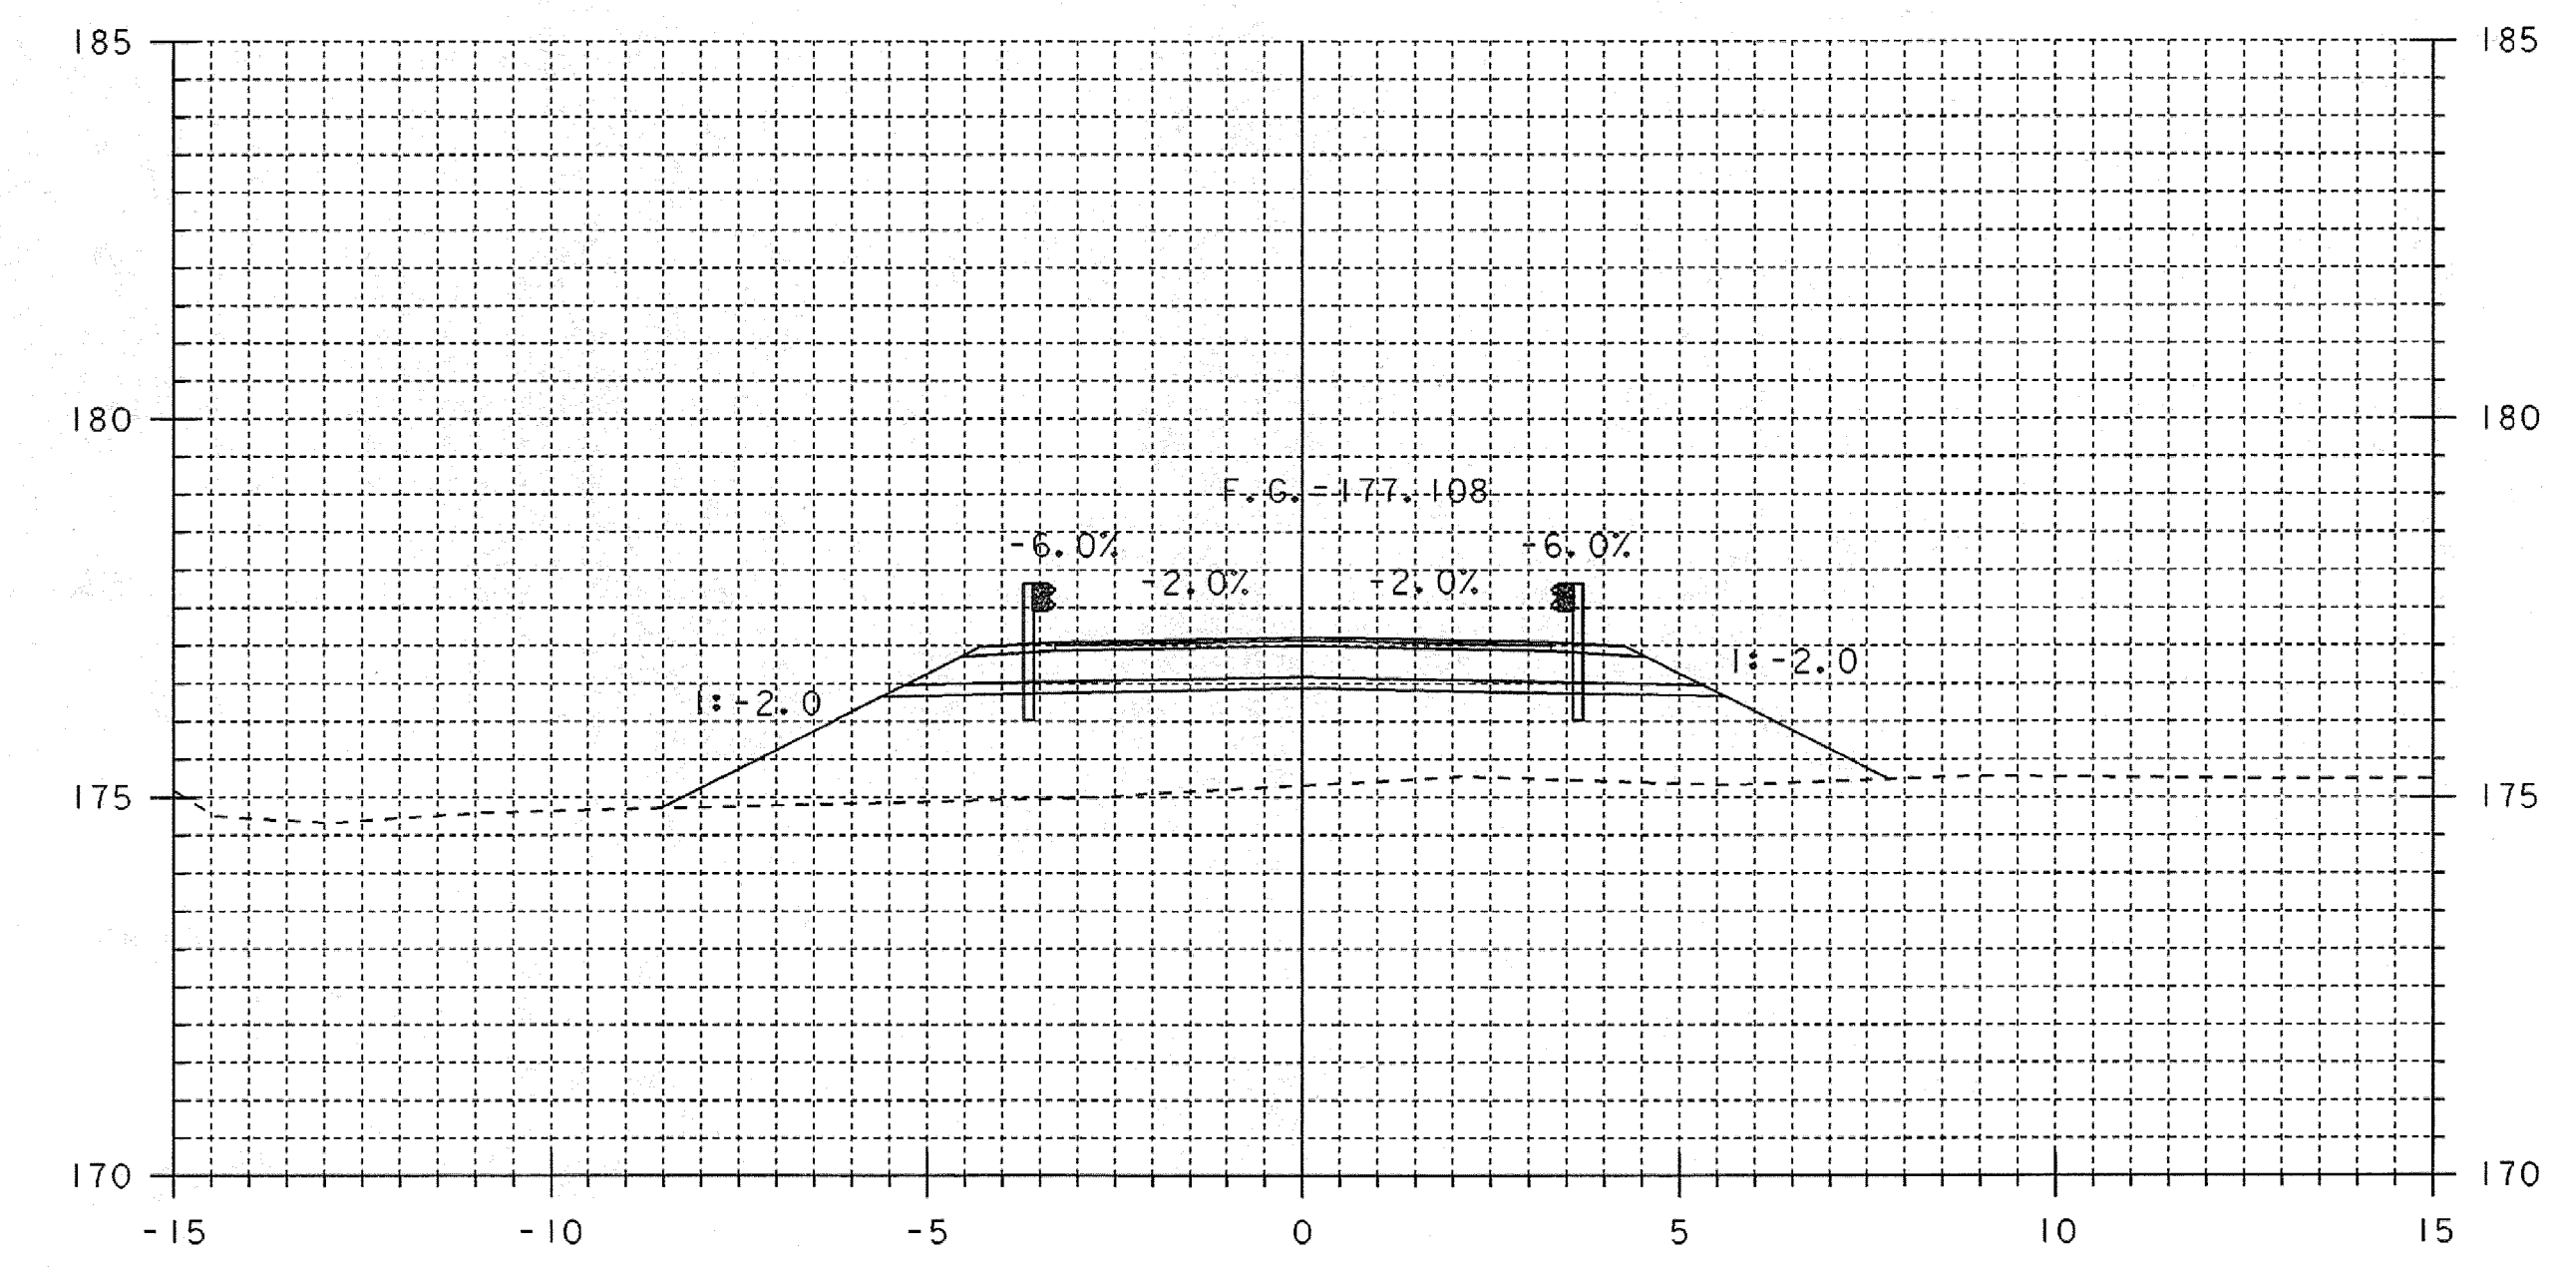


40+080

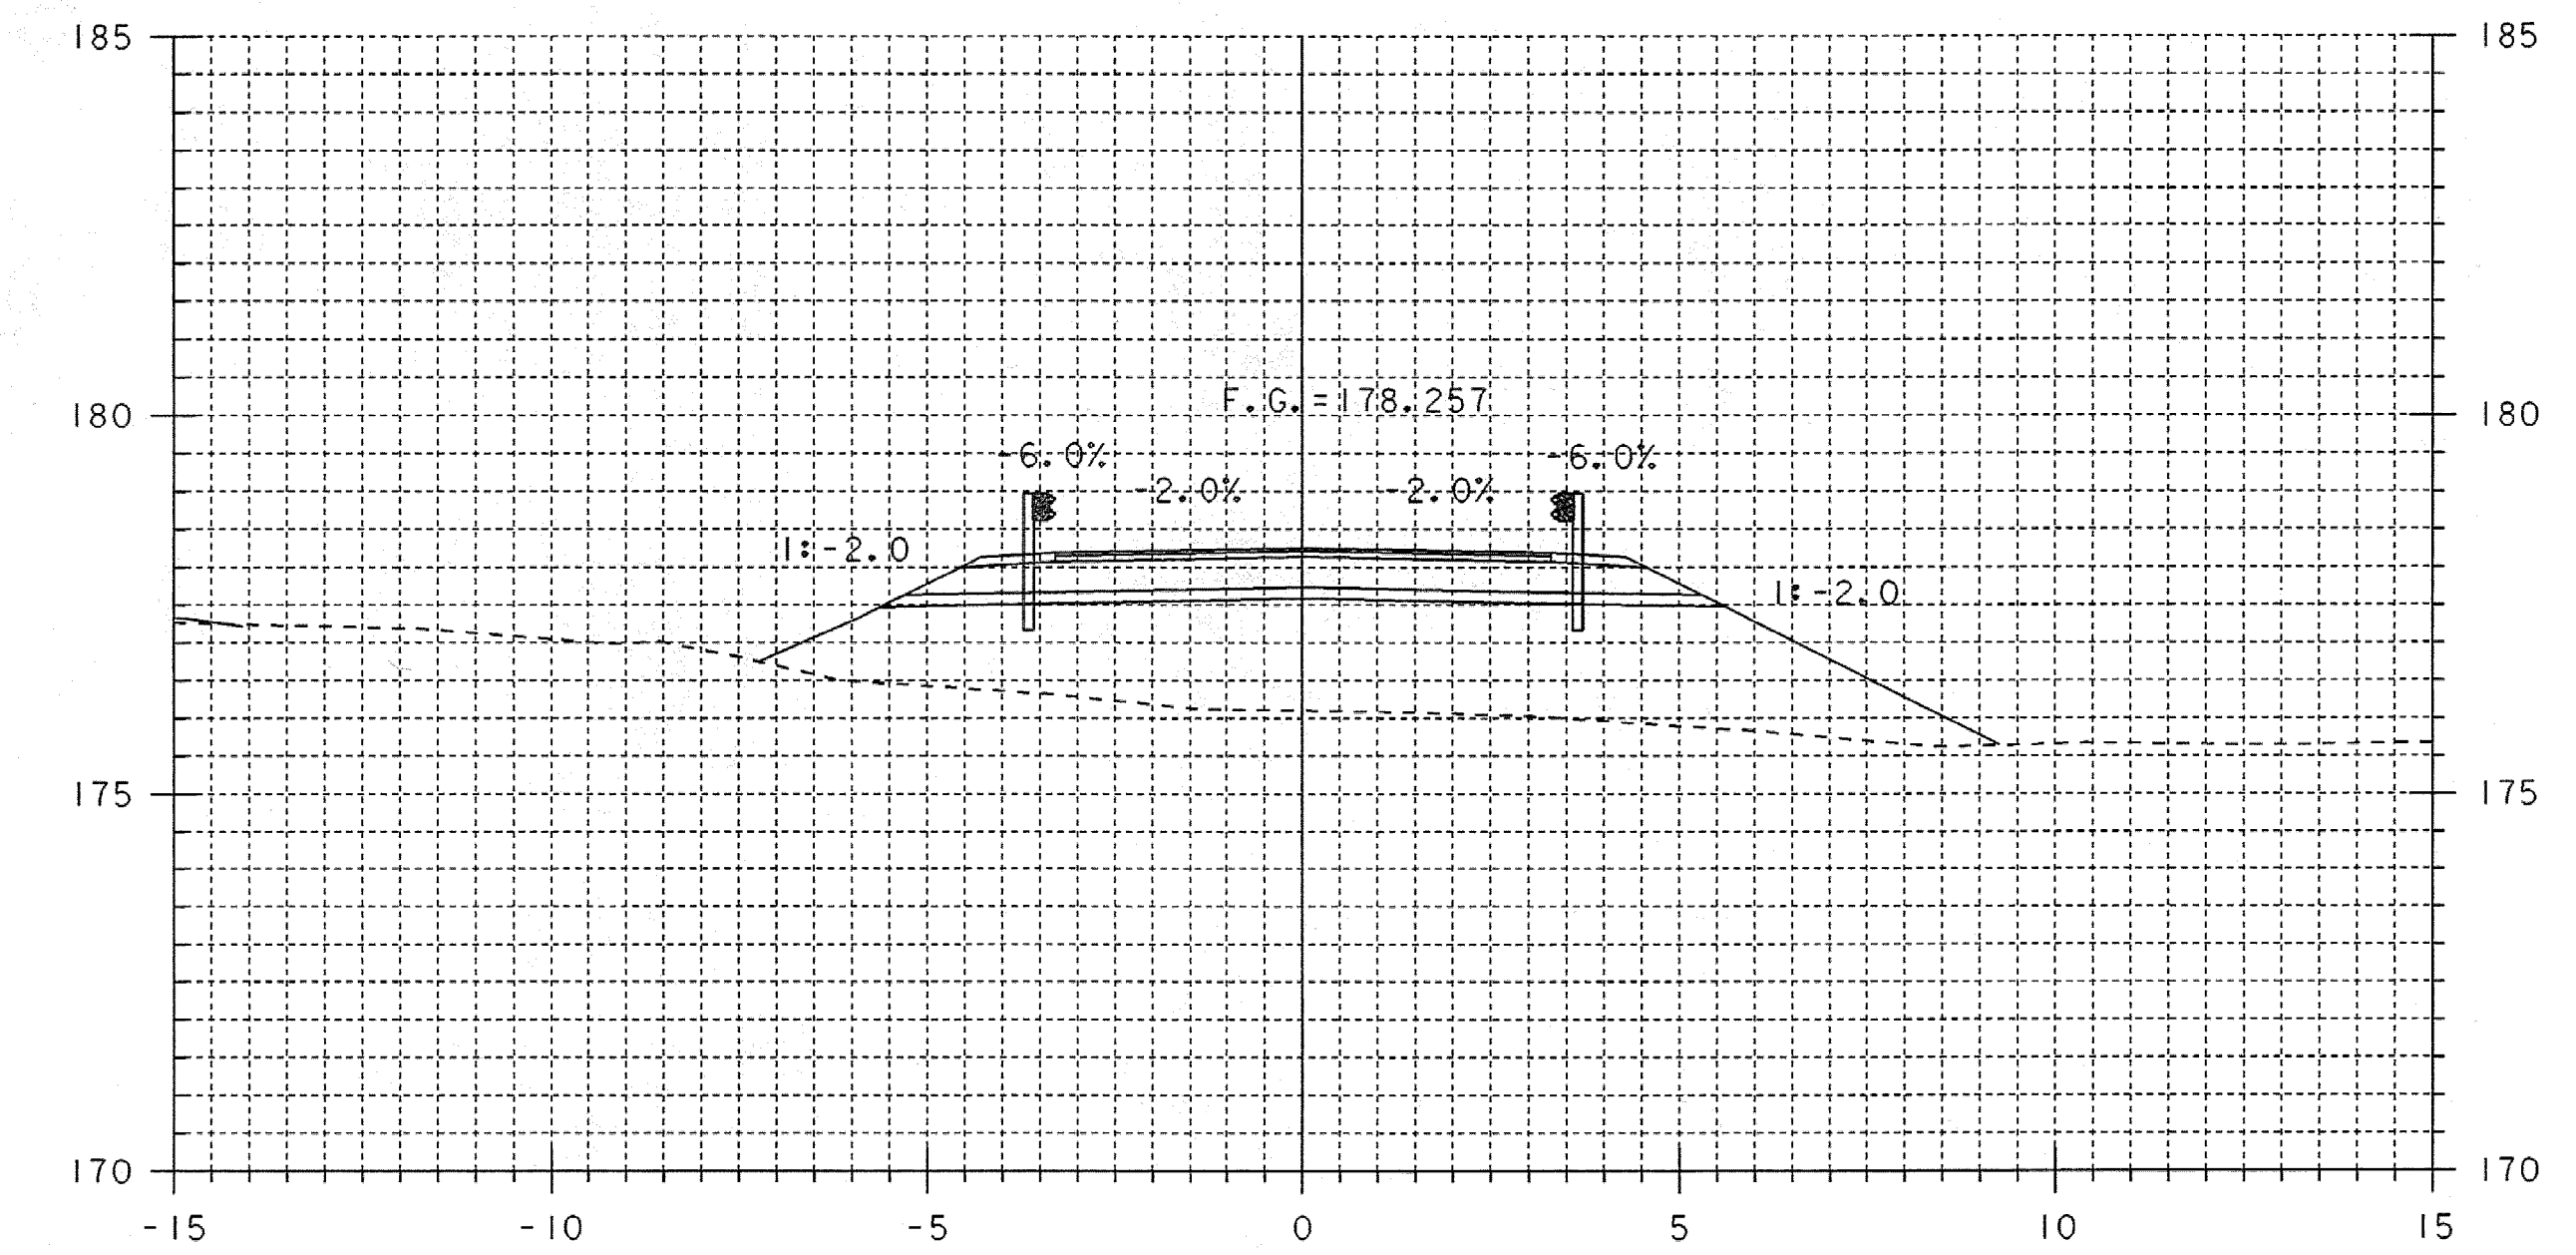

40+070

MAINLINE CROSS SECTIONS 3

PROJECT NAME: GUILFORD	PLOT DATE: 15-APR-2008
PROJECT NUMBER: BRO 1442(24)	DRAWN BY: T. LACKEY
FILE NAME: sj076m03.1	CHECKED BY: T. LACKEY
PROJECT LEADER: R. WHITCOMB	SHEET 46 OF 59
DESIGNED BY: J. PERRIGO	
94J076\Structures\sj076xs3.dgn	

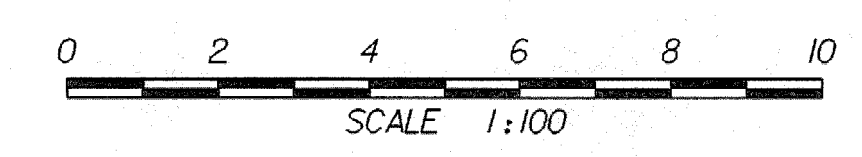

STA. 40+055 TO STA. 40+080