

40+107.470
END SAND BORROW


40+104.000
BEGIN SUBBASE TAPER

40+103.200 =
FIELD DRIVE 7+000.000

40+102
BEGIN GRANULAR BORROW

MAINLINE CROSS SECTIONS 4

PROJECT NAME:	GUILFORD	PLOT DATE:	15-APR-2008
PROJECT NUMBER:	BRO 1442(24)	DRAWN BY:	T. LACKEY
FILE NAME:	sj076m04.i	DESIGNED BY:	J. PERRIGO
PROJECT LEADER:	R. WHITCOMB	CHECKED BY:	T. LACKEY
94J076\Structures\sj076xs3.dgn		SHEET	47 OF 59

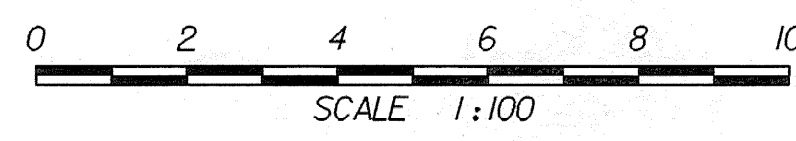

STA. 40+090 TO STA. 40+110