

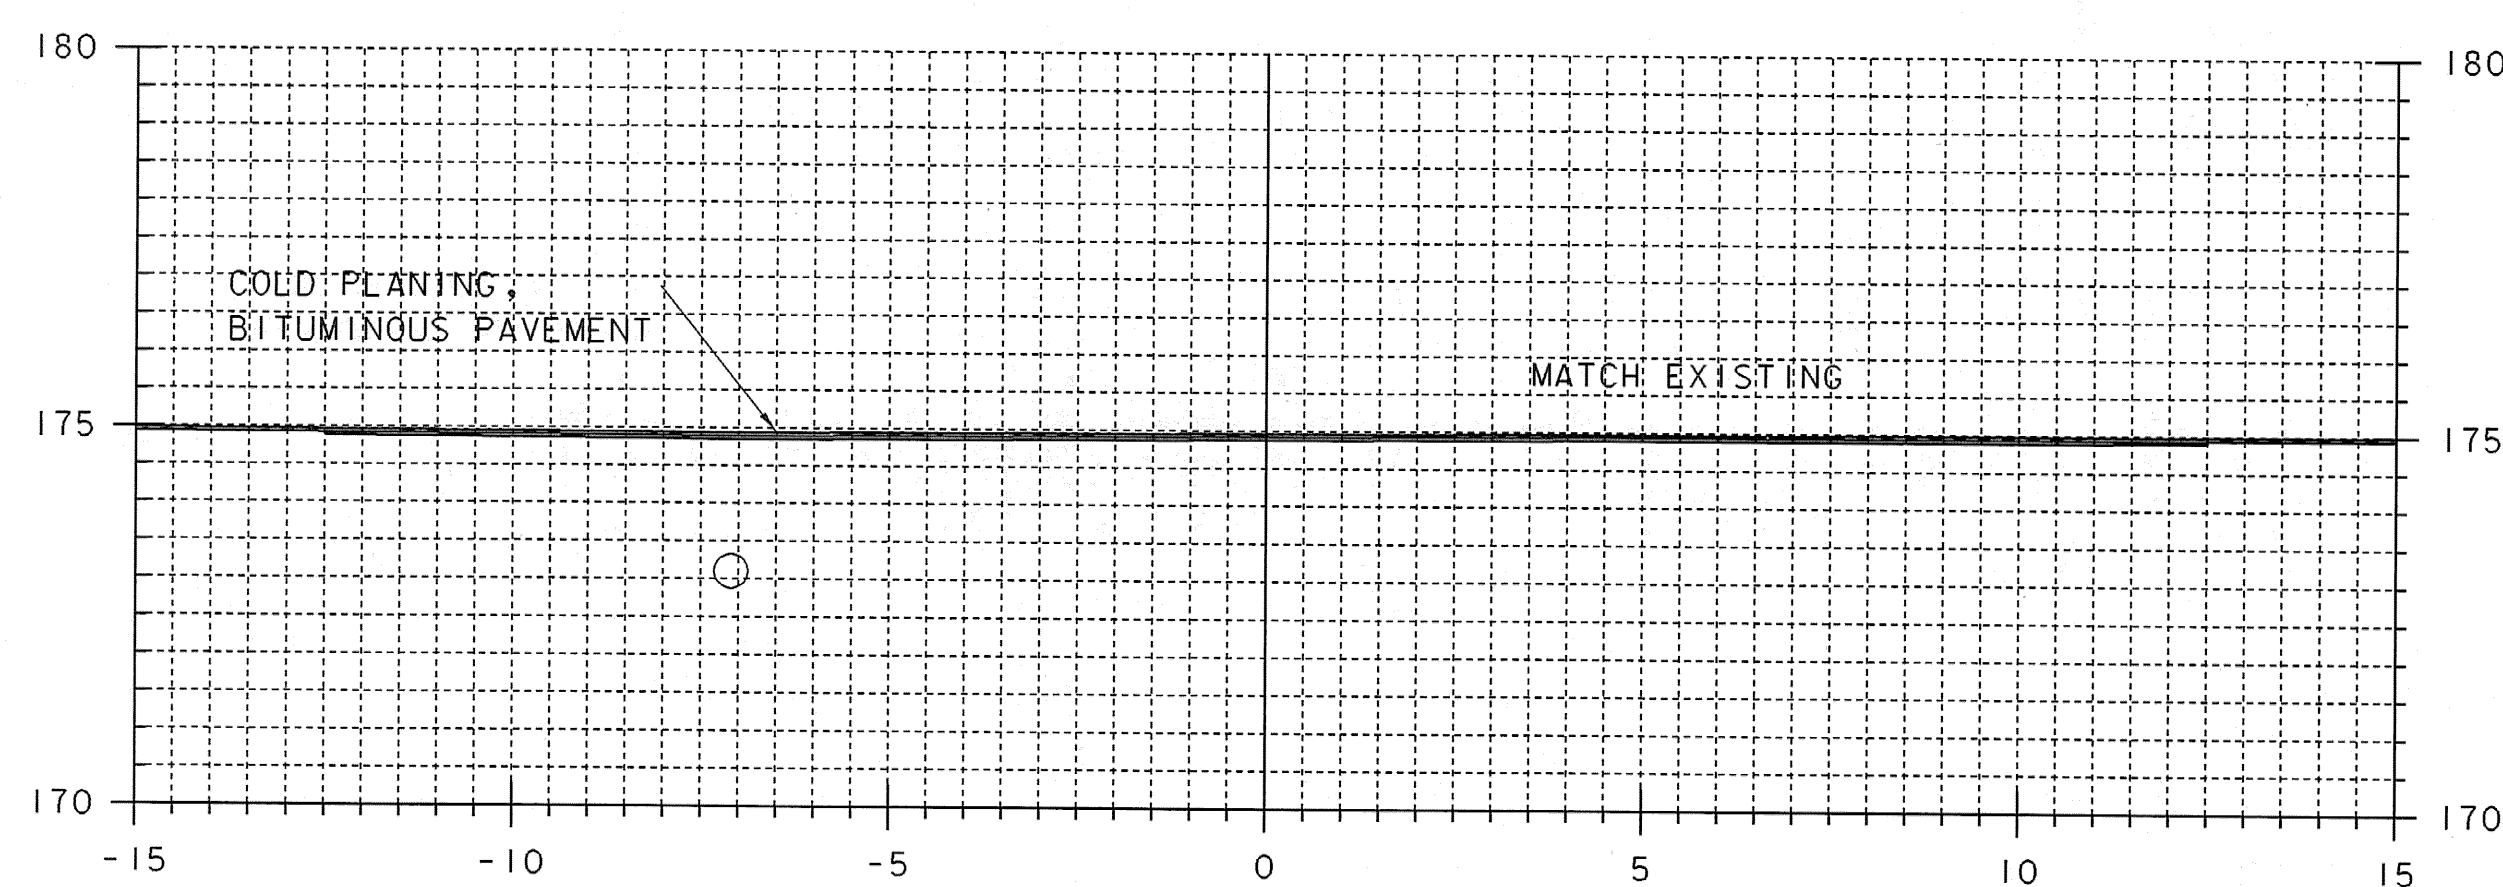


CULVERT TYPICAL CROSS SECTION
ACROSS T.H. 1



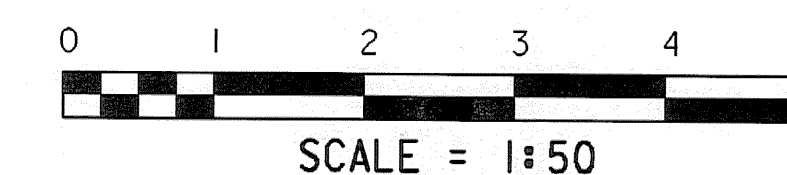


40+140

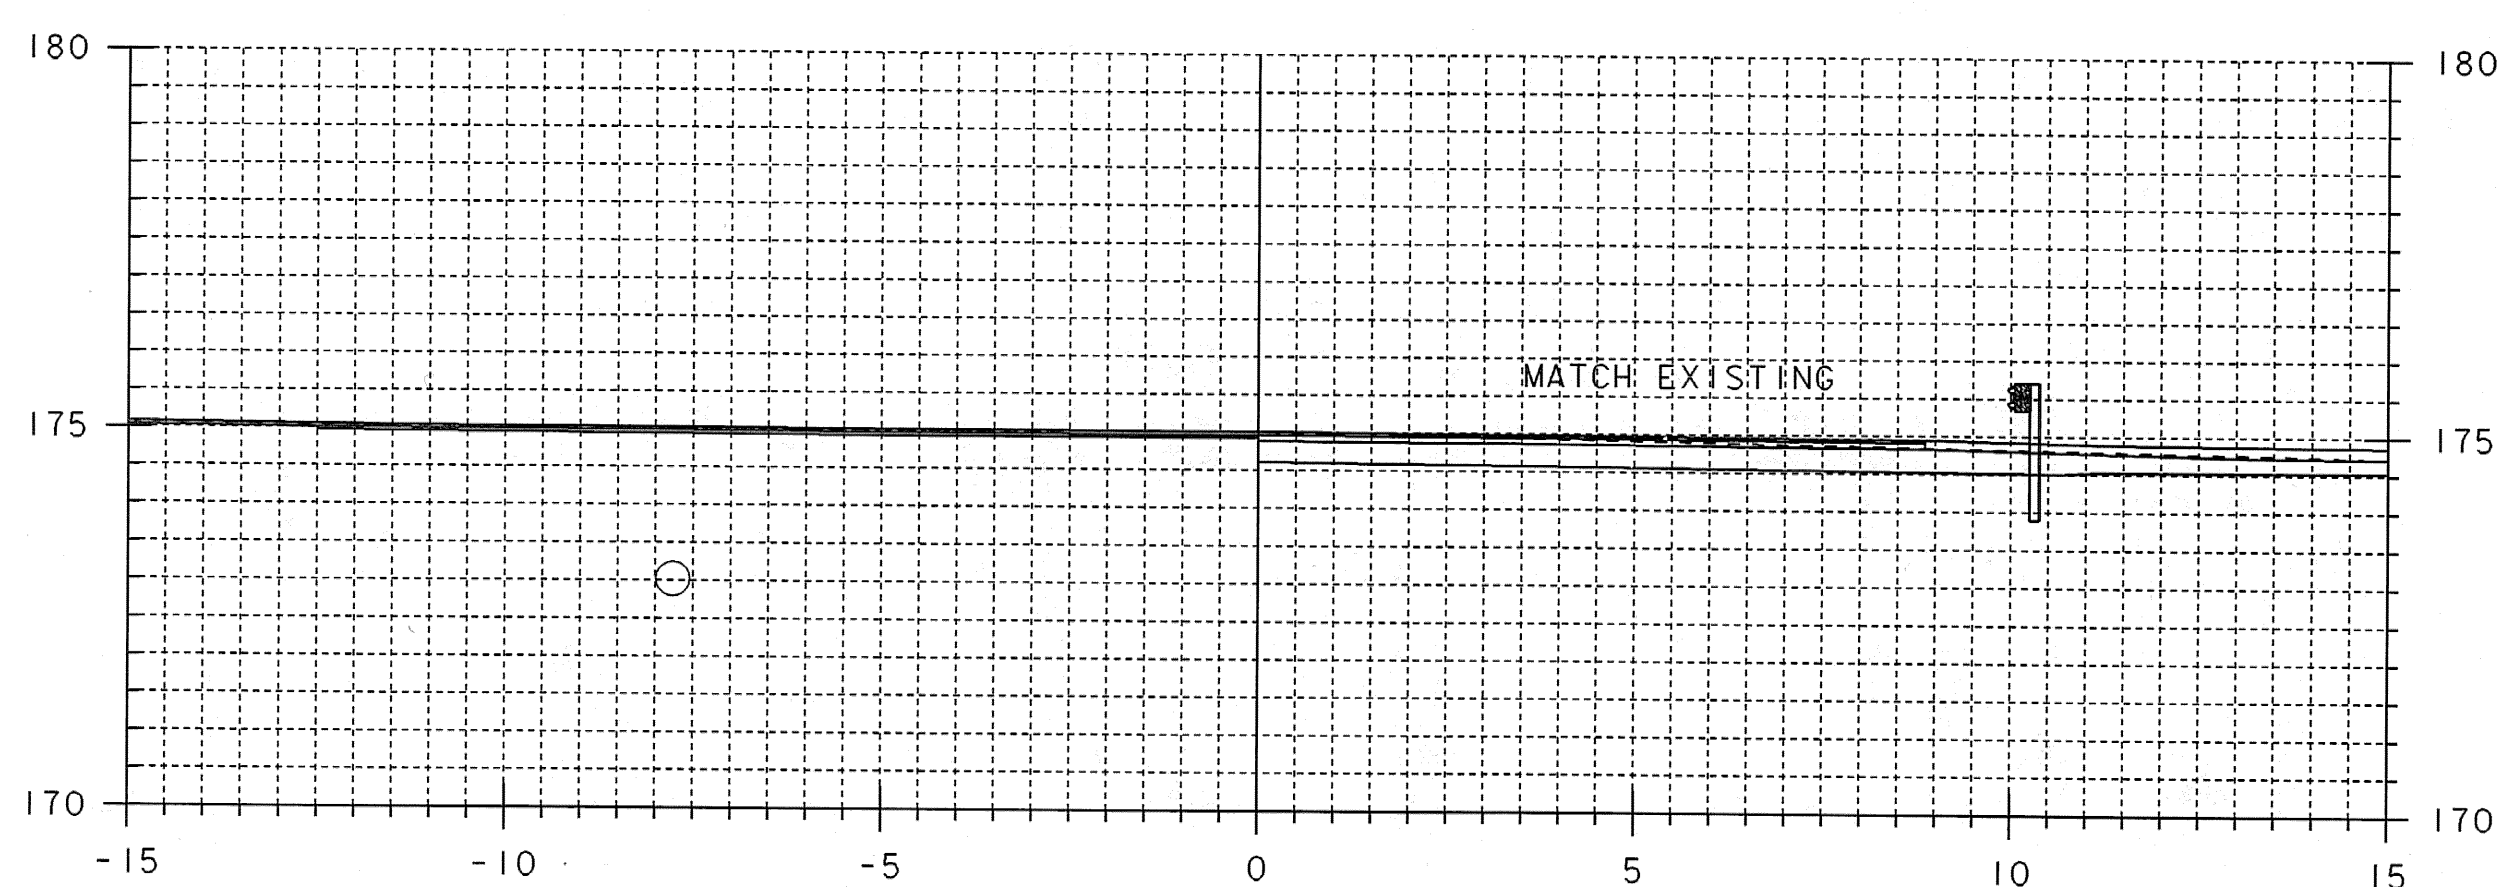

40+136.770

40+136.770
END PROJECT

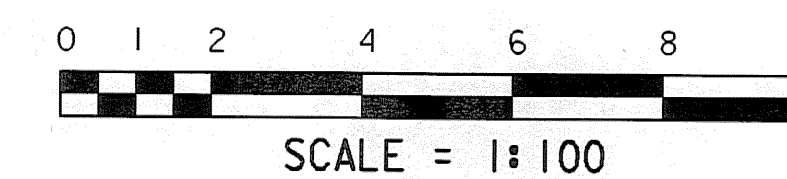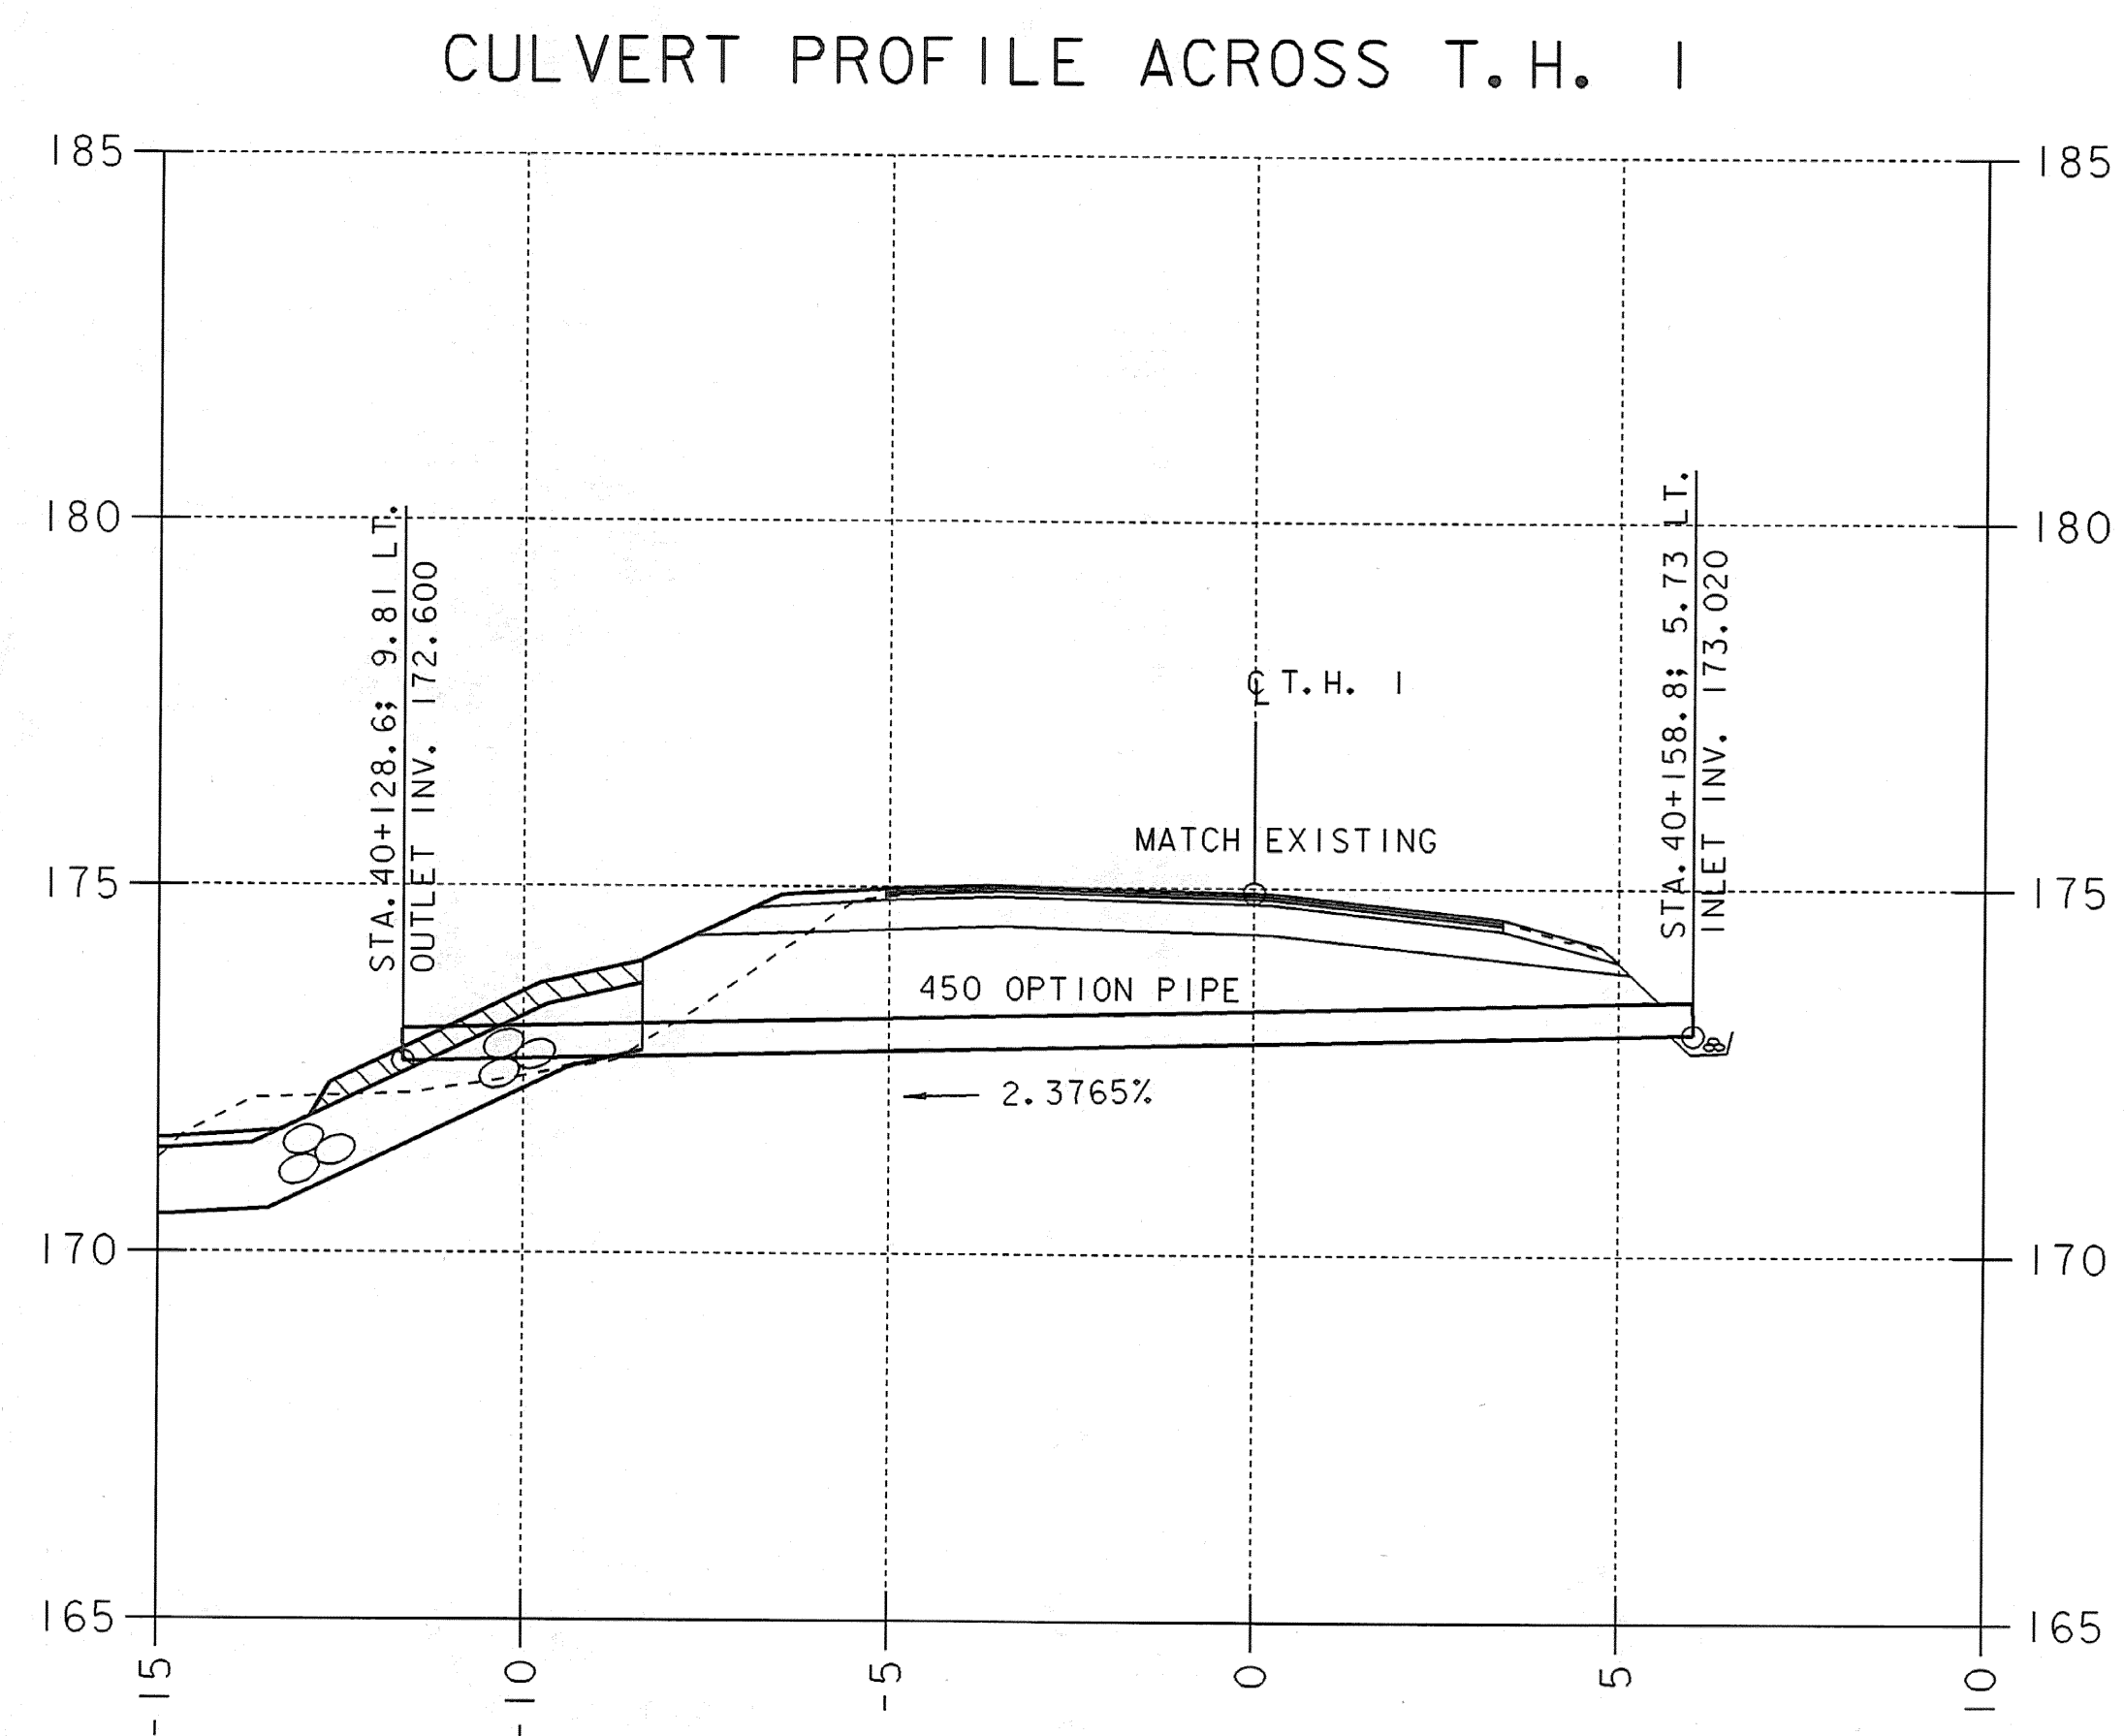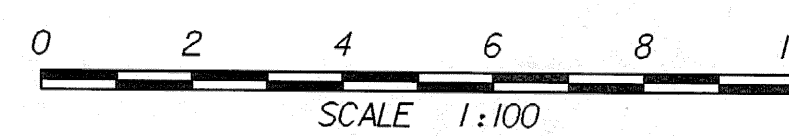

MAINLINE CROSS SECTIONS 6

STA. 40+137 TO STA. 40+140

PROJECT NAME:	GUILFORD	PLOT DATE:	15-APR-2008
PROJECT NUMBER:	BRO 1442(24)	DRAWN BY:	T. LACKEY
FILE NAME:	sj076m06.1	CHECKED BY:	T. LACKEY
PROJECT LEADER:	R. WHITCOMB	SHEET	49 OF 59
DESIGNED BY:	J. PERRIGO		
94\076\Structures\sj076xs3.dgn			