




LEFT DRIVE (OLD BONNYVALE RD) AS WAS - NO NEW GRAVEL, ETC.

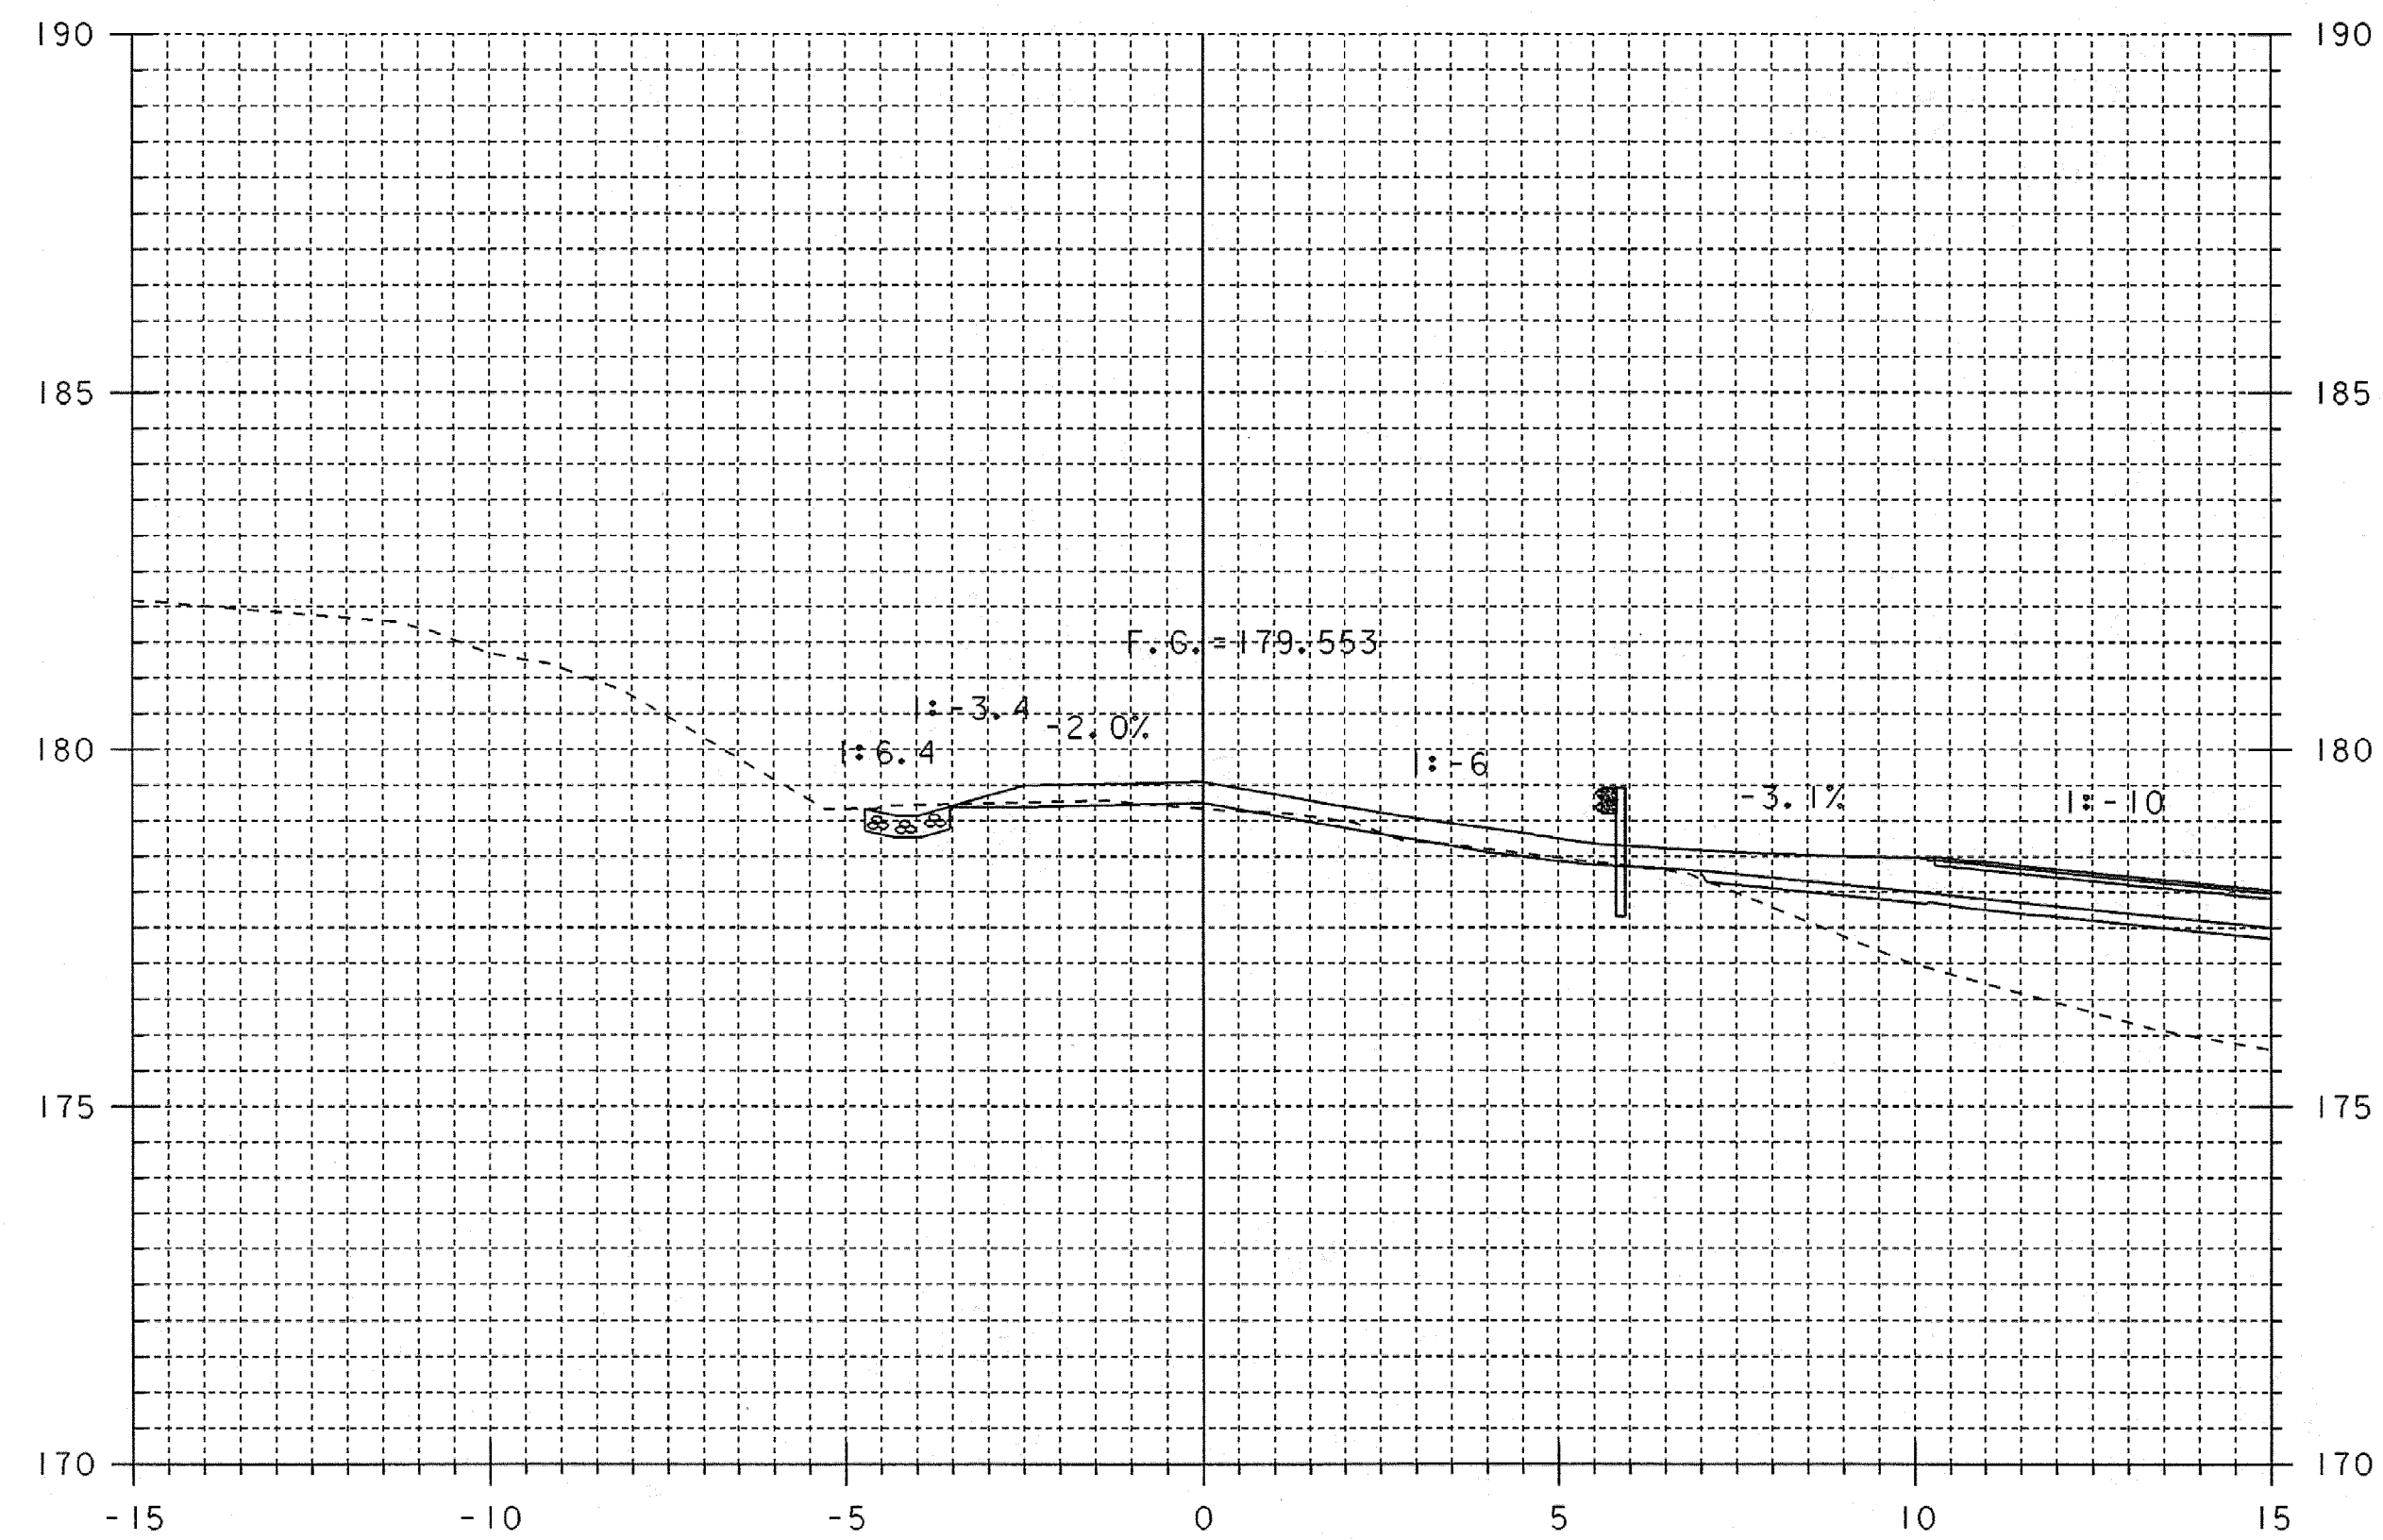


6+010

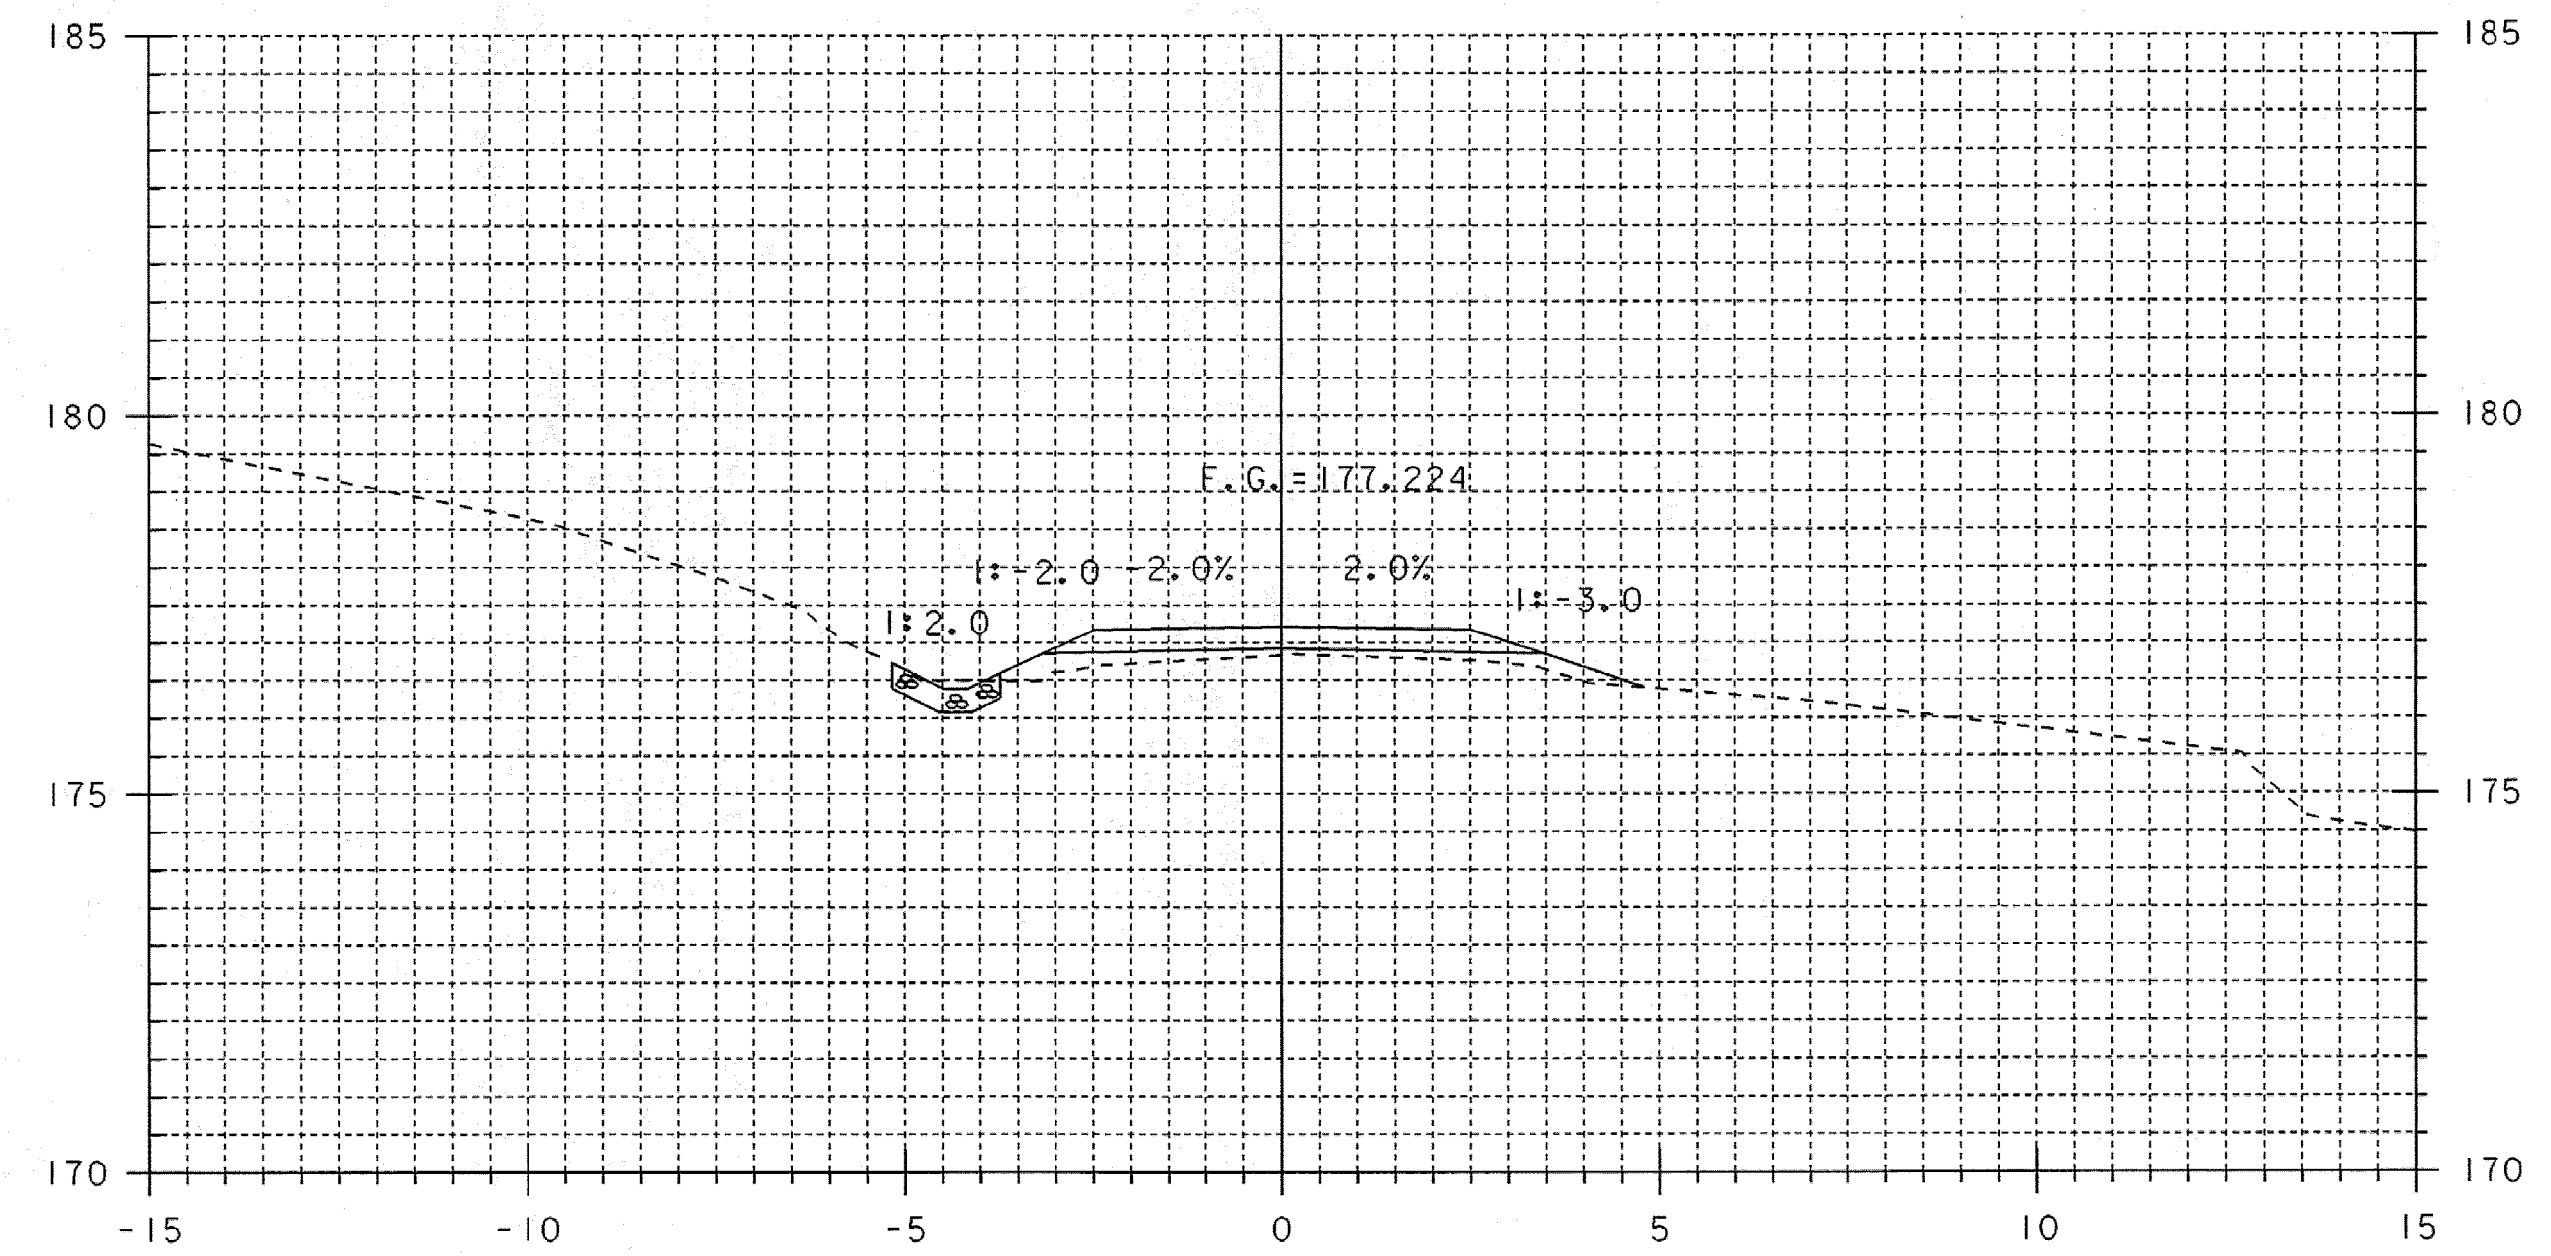

6+030

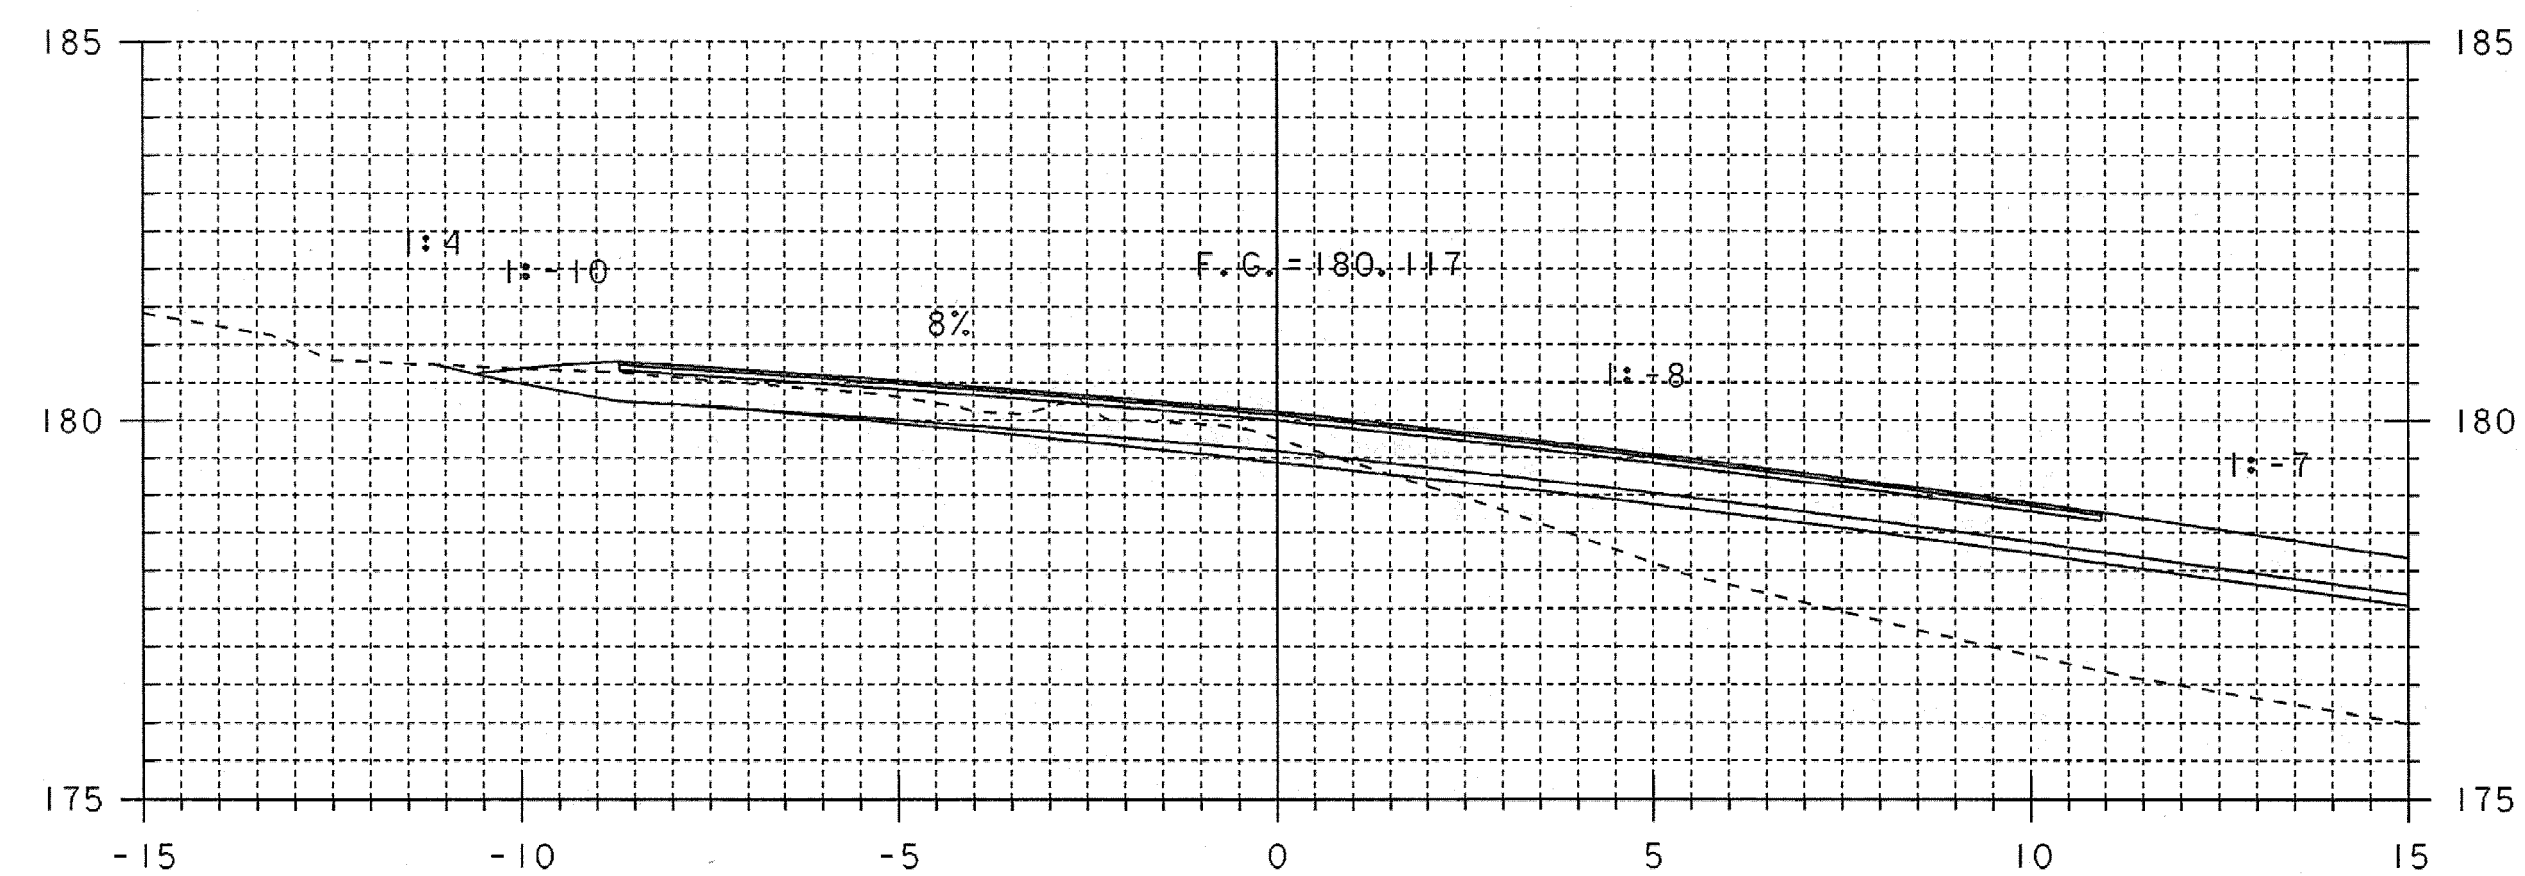


6+000

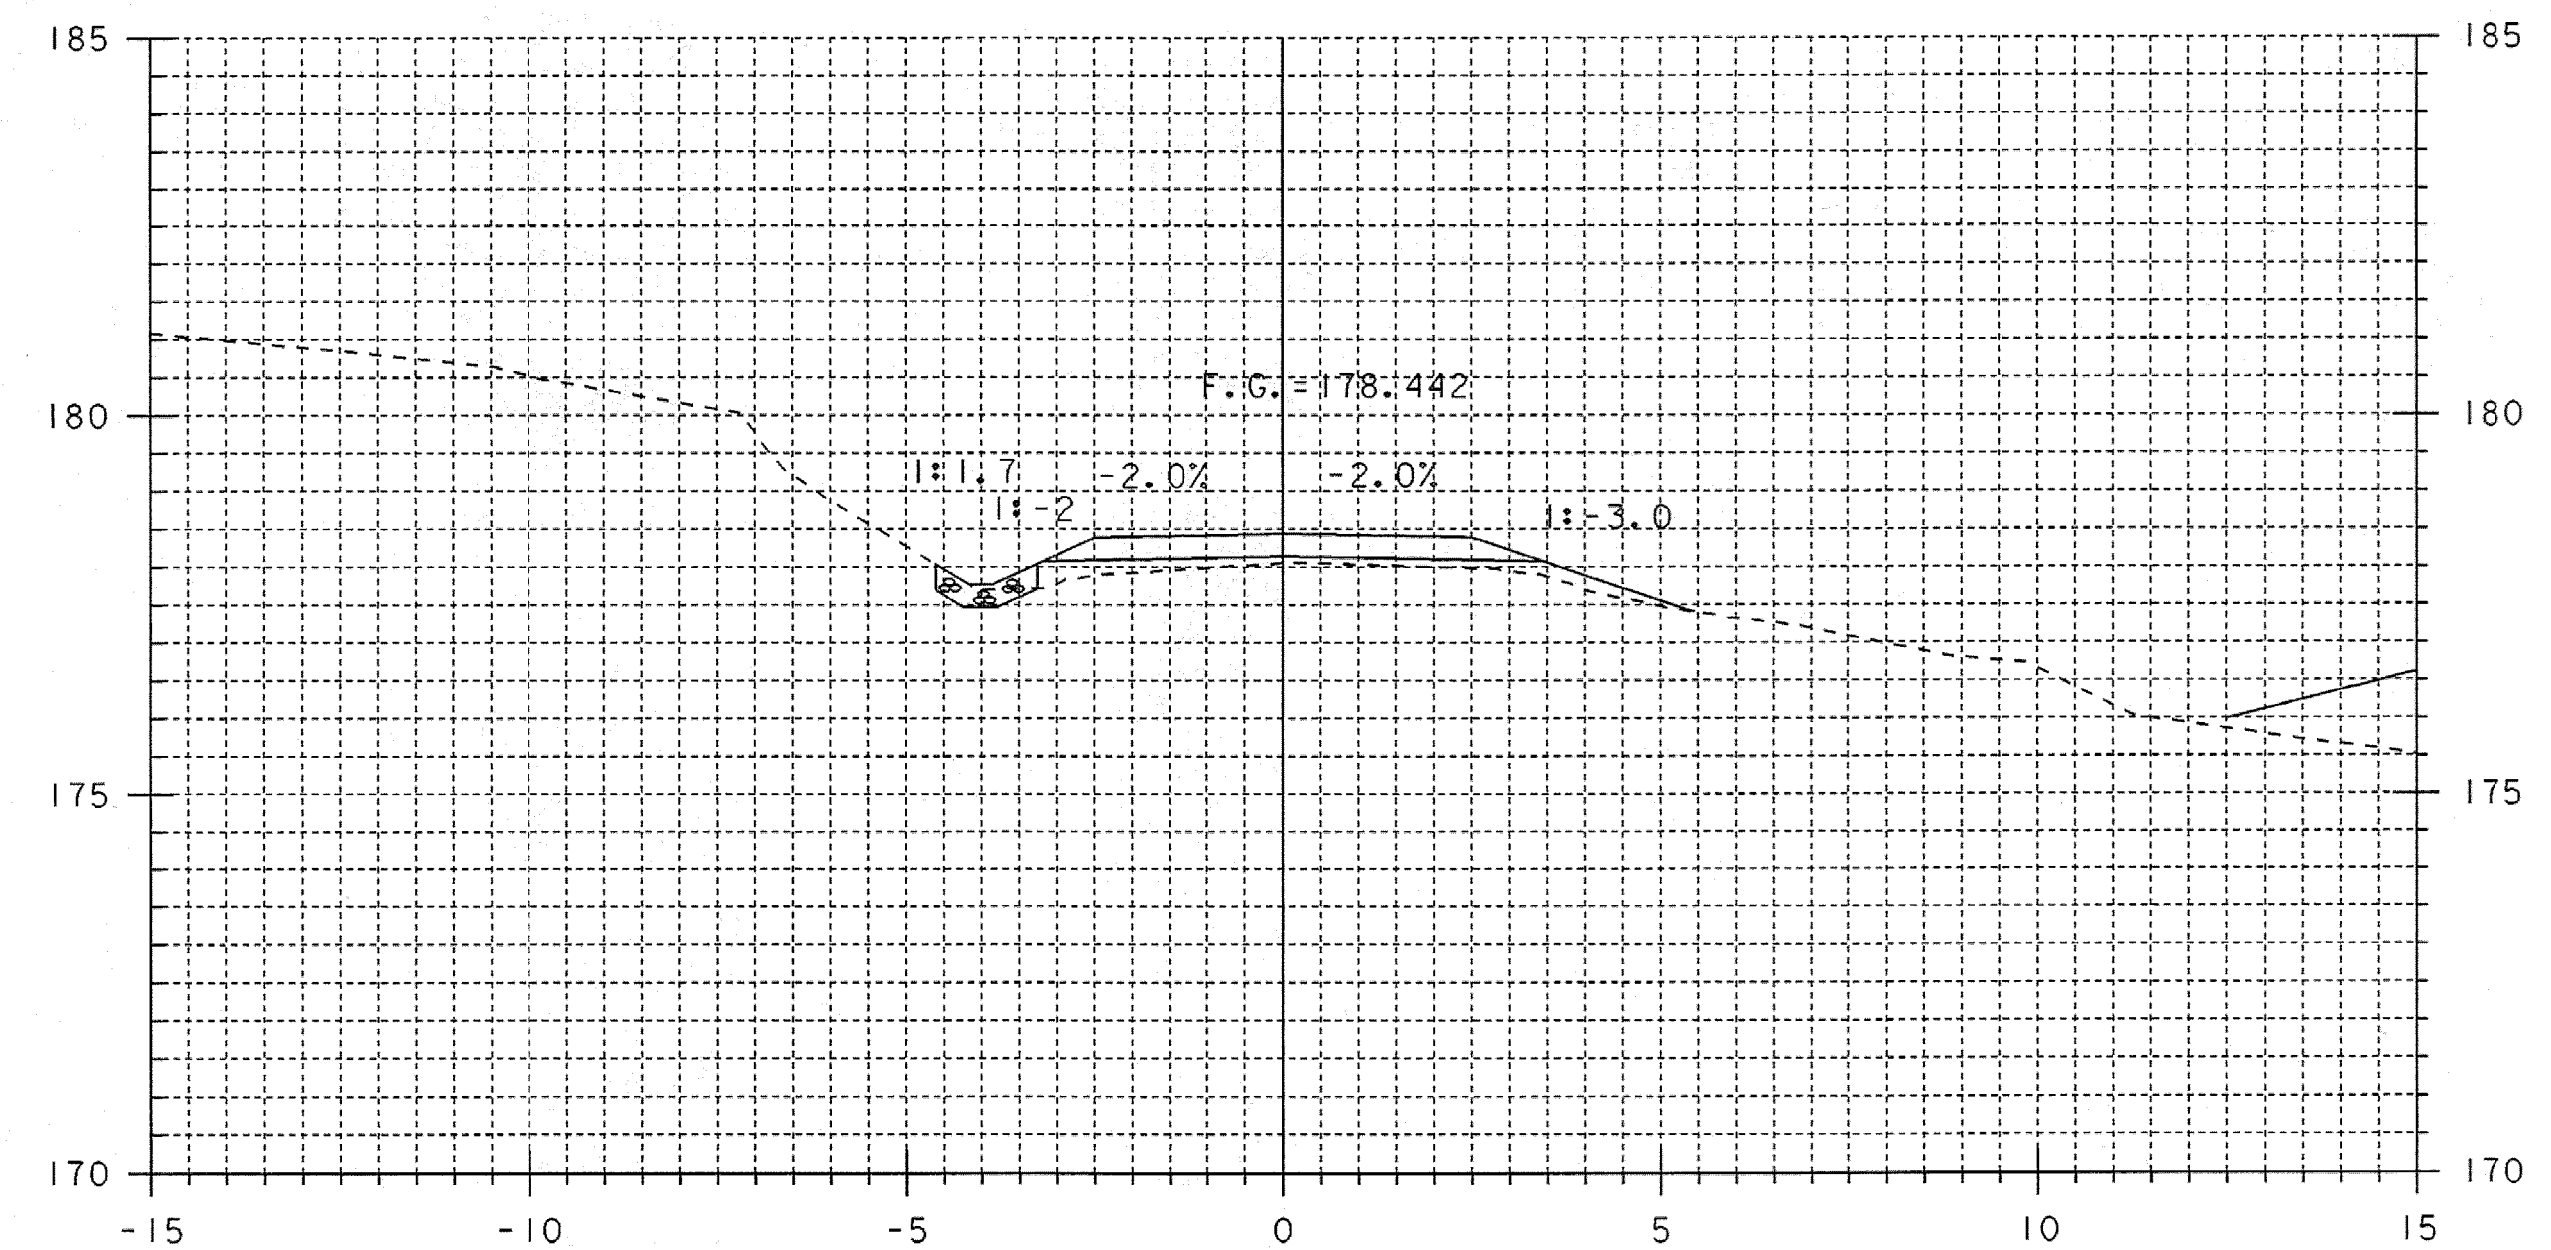

6+020

6+000
BEGIN DRIVE 1
MATCH PROPOSED MAINLINE

DRIVE CROSS SECTIONS 1

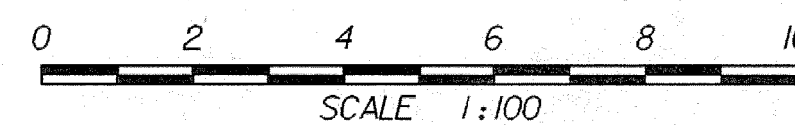

STA. 6+000 TO STA. 6+030

PROJECT NAME:	GUILFORD	PLOT DATE:	15-APR-2008
PROJECT NUMBER:	BRO 1442(24)	DRAWN BY:	T. LACKEY
FILE NAME:	sj076d01.i	DESIGNED BY:	J. PERRIGO
PROJECT LEADER:	R. WHITCOMB	CHECKED BY:	T. LACKEY
94J076\Structures\sj076xs3.dgn		SHEET	50 OF 59