




6+050

6+045
END DRIVE
MATCH EXISTING

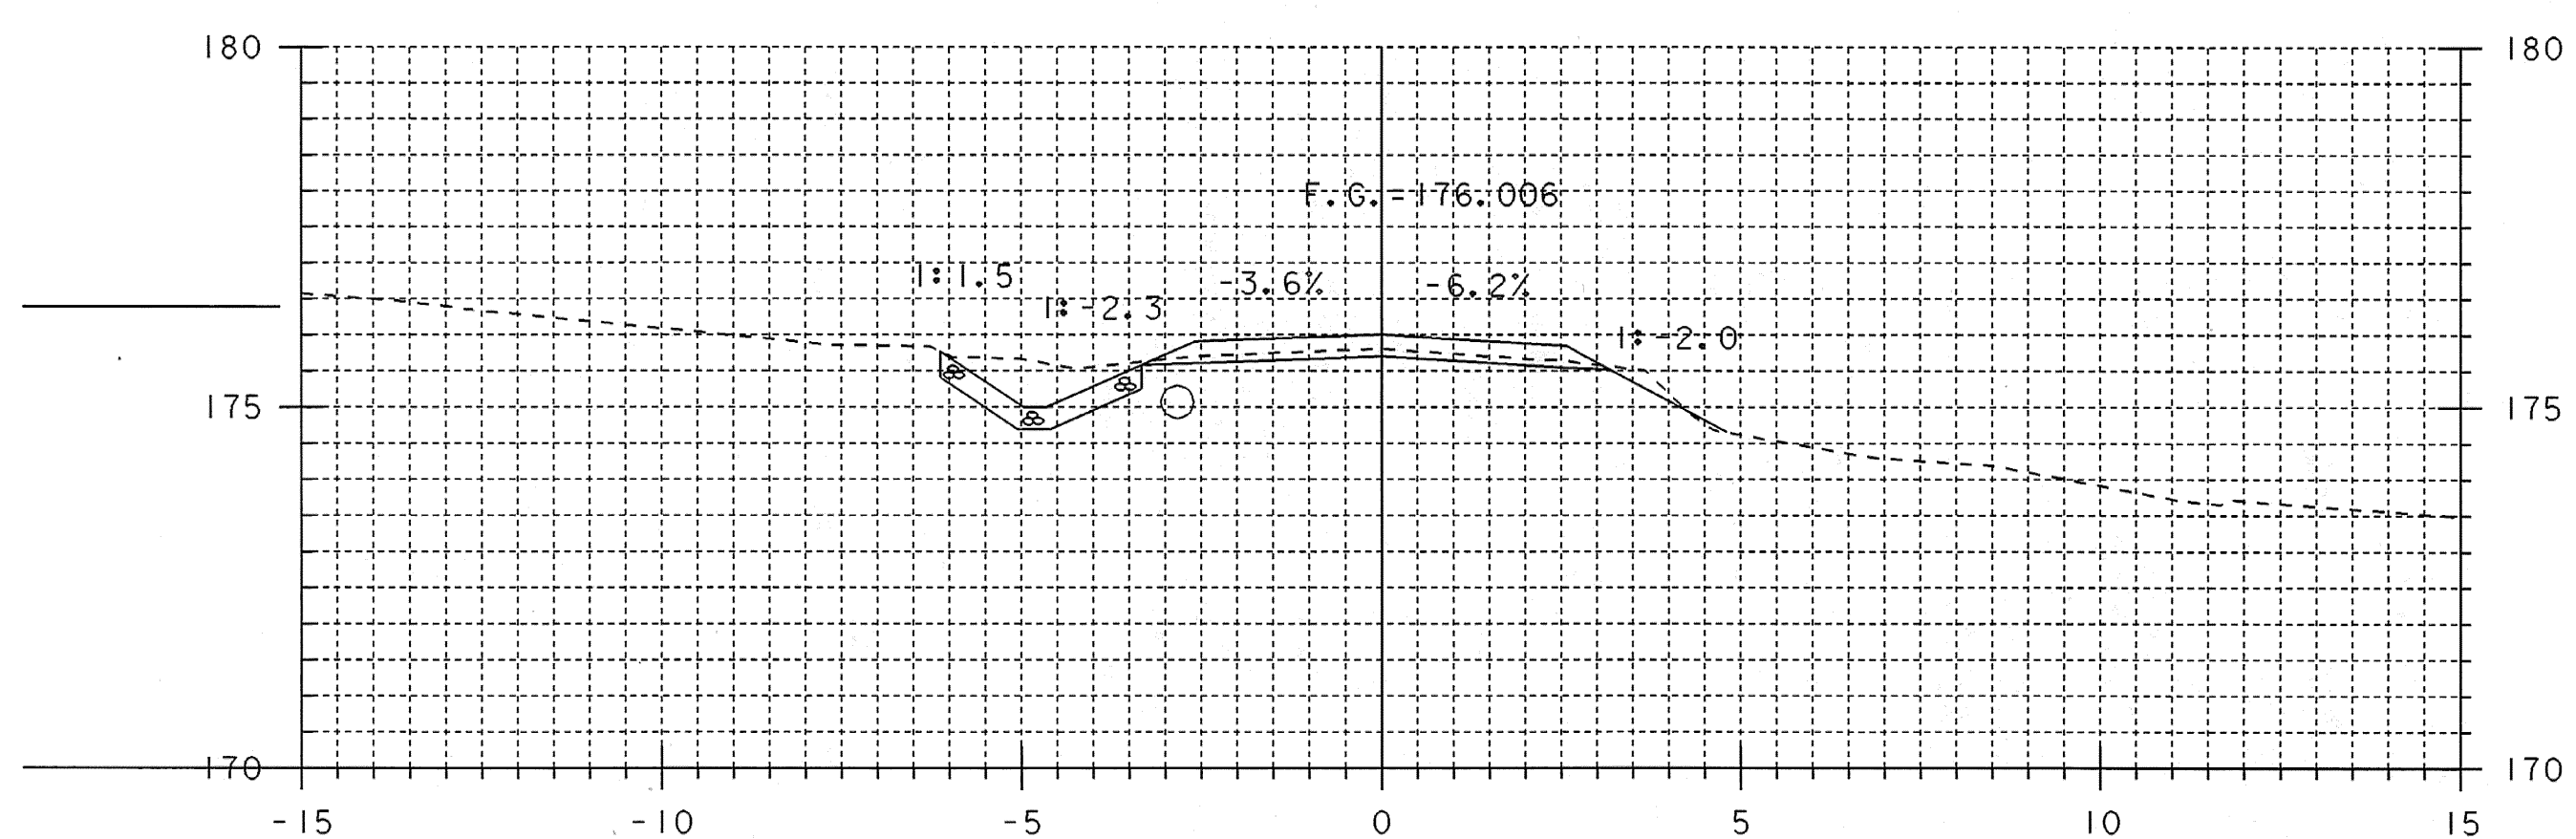

6+040

CULVERT PROFILE AT DRIVE STA. 6+041.160

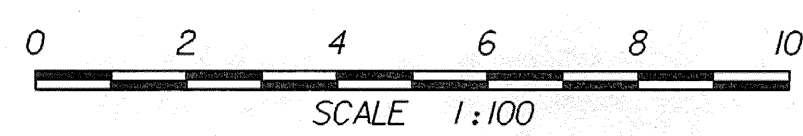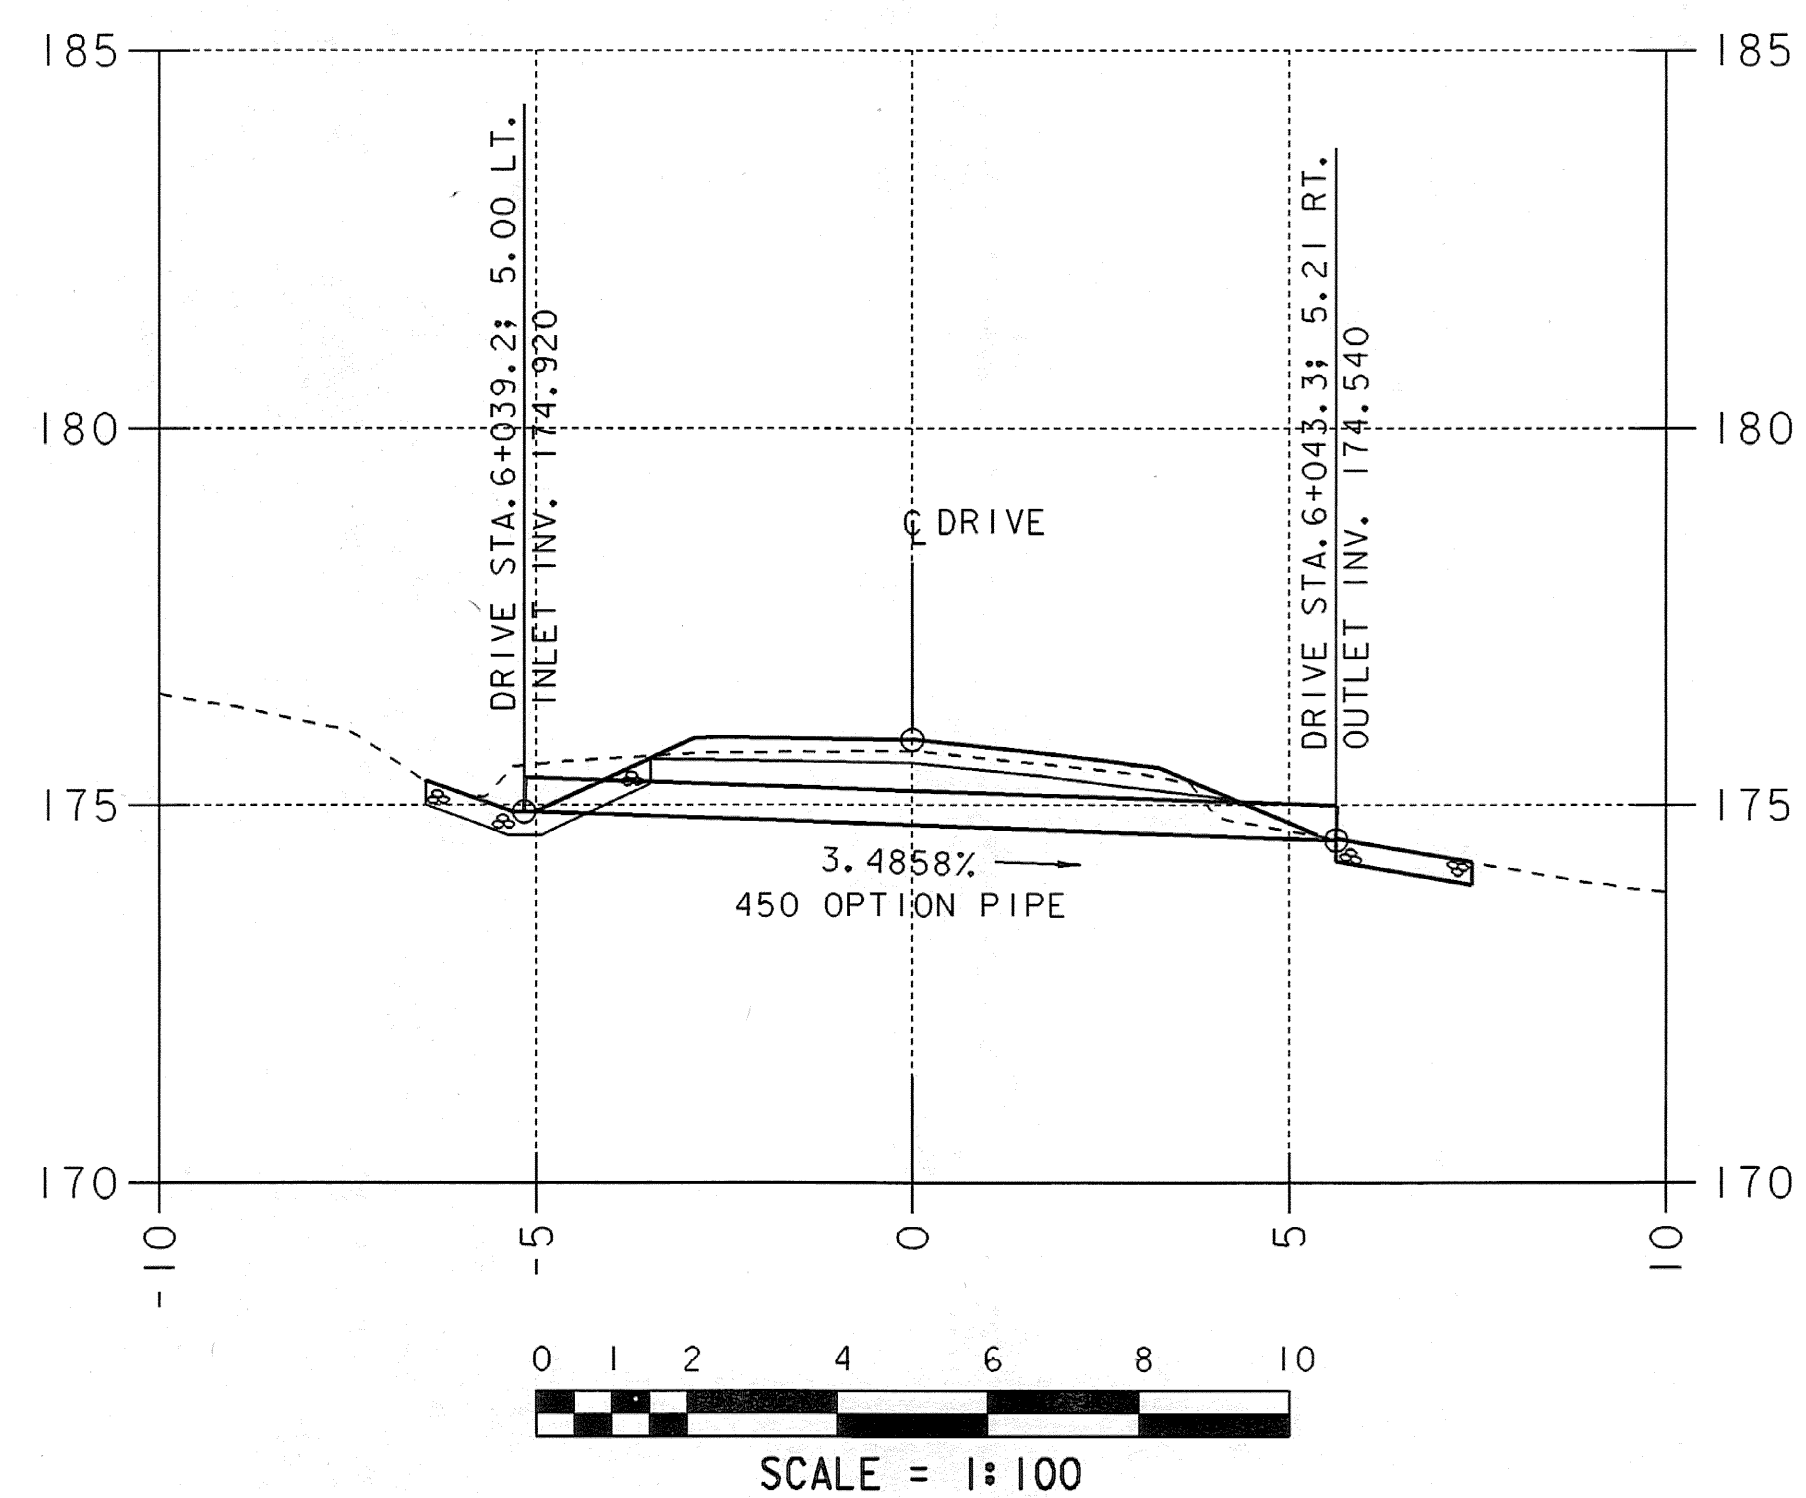

STA. 6+040 TO STA. 6+050

DRIVE CROSS SECTIONS 2

PROJECT NAME:	GUILFORD	PLLOT DATE:	15-APR-2008
PROJECT NUMBER:	BRO 1442(24)	DRAWN BY:	T. LACKEY
FILE NAME:	sj076d02.j	DESIGNED BY:	J. PERRIGO
PROJECT LEADER:	R. WHITCOMB	CHECKED BY:	T. LACKEY
94J076\Structures\sj076xs3.dgn		SHEET	51 OF 59