



50+105.00

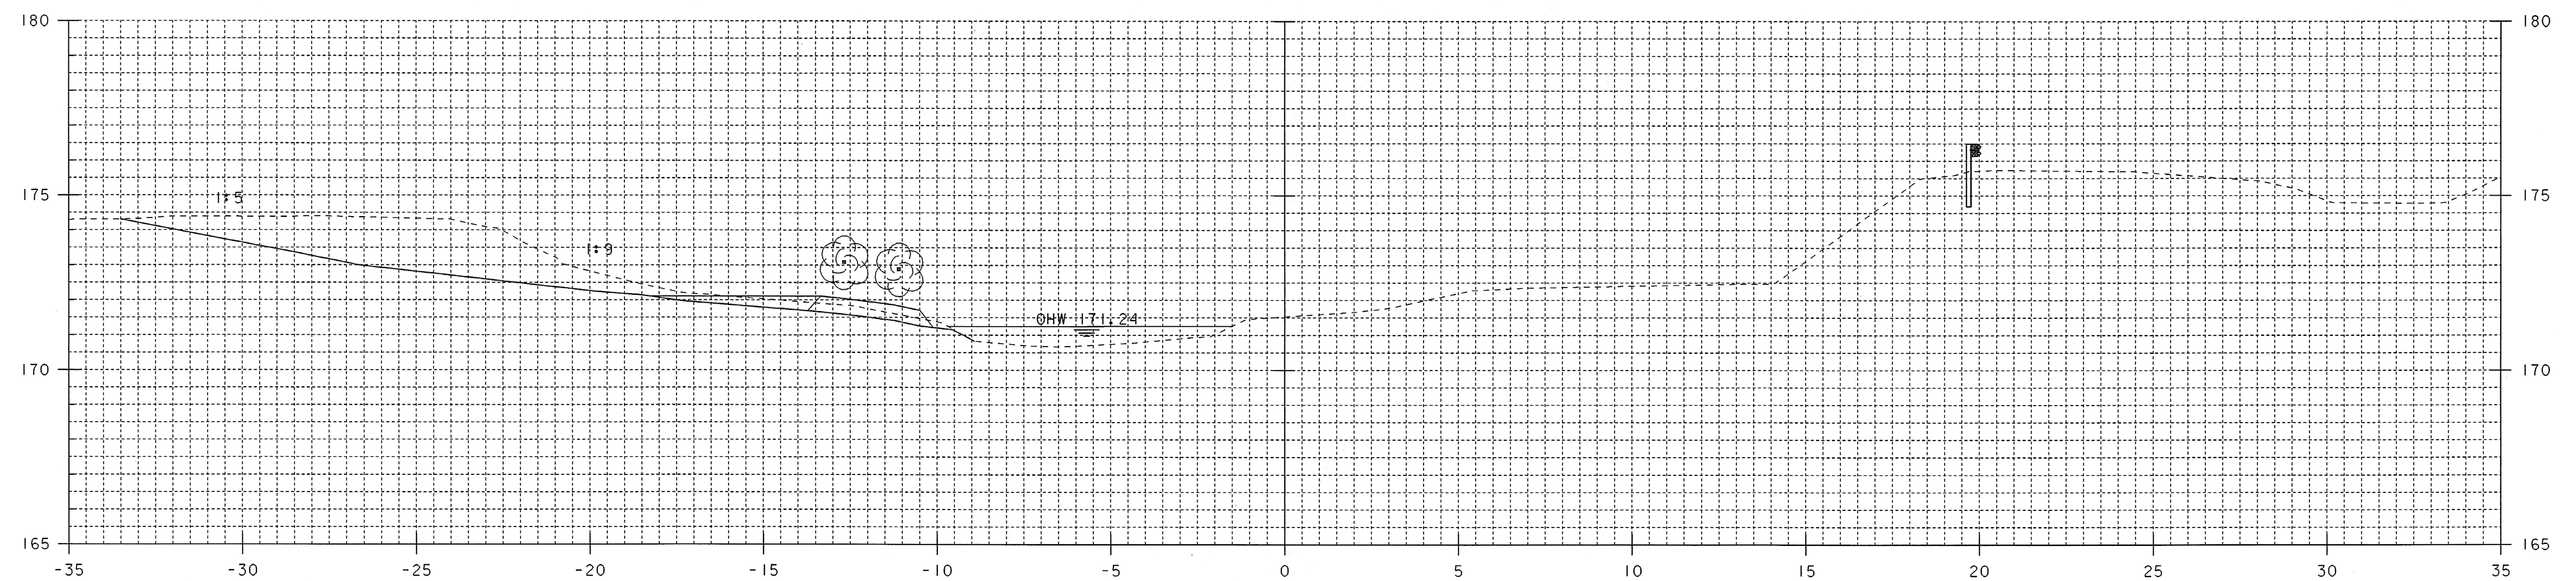

50+098
BEGIN LANDSCAPING

50+100.00

CHANNEL CROSS SECTIONS 5

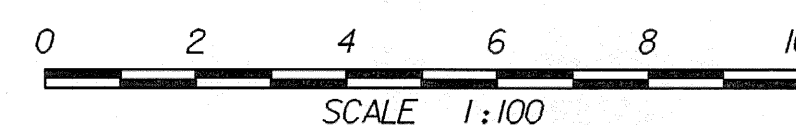

STA. 50+100 TO STA. 50+105

PROJECT NAME:	GUILFORD	PLOT DATE:	15-APR-2008
PROJECT NUMBER:	BRO 1442(24)	DRAWN BY:	T. LACKEY
FILE NAME:	sj076c05.i	DESIGNED BY:	J. PERRIGO
PROJECT LEADER:	R. WHITCOMB	CHECKED BY:	T. LACKEY
94\076\Structures\sj076xs3.dgn		SHEET	56 OF 59