


50+114
 END LANDSCAPING
 END UNCLASSIFIED EXCAVATION


50+115.00

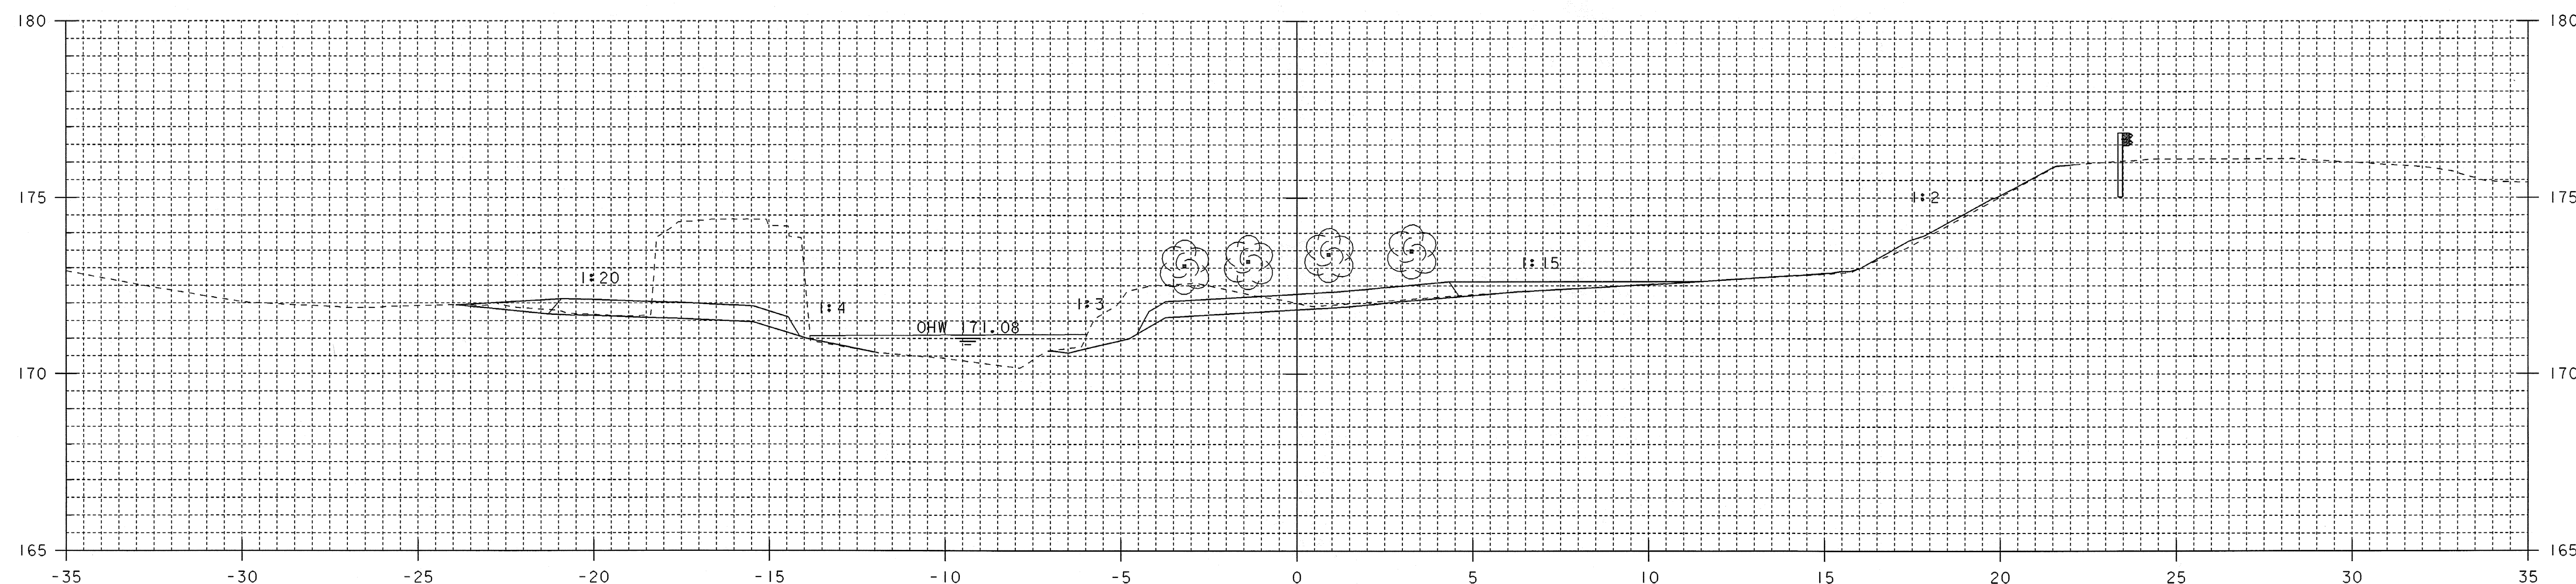

50+108
 BEGIN LANDSCAPING
 BEGIN UNCLASSIFIED EXCAVATION

50+110.00

CHANNEL CROSS SECTIONS 6

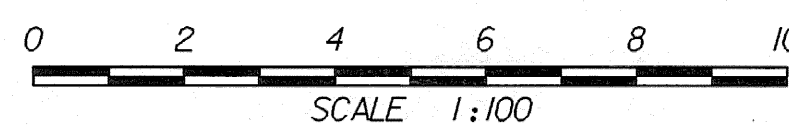

STA. 50+110 TO STA. 50+115

PROJECT NAME:	GUILFORD	PLOT DATE:	15-APR-2008
PROJECT NUMBER:	BRO 1442(24)	DRAWN BY:	T. LACKEY
FILE NAME:	sj076c06.i	CHECKED BY:	T. LACKEY
PROJECT LEADER:	R. WHITCOMB	SHEET	57 OF 59
DESIGNED BY:	J. PERRIGO		
94J076\Structures\sj076xs3.dgn			