


STA. 50+042.000 TO STA. 50+043.000

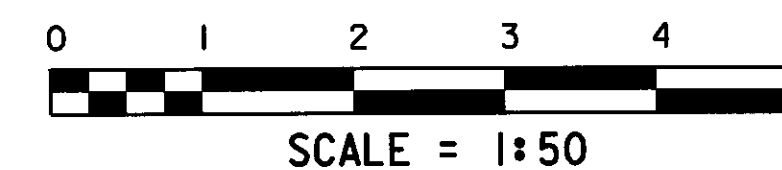

PROJECT NAME:	GUILFORD	Project sheet 2 of 3
PROJECT NUMBER:	BRO 1442(24)	
FILE NAME:	s\j076\c\2.1	PLOT DATE: 04-MAR-2009
PROJECT LEADER:	R. WHITCOMB	DRAWN BY: T. LACKEY
DESIGNED BY:		CHECKED BY:
94\j076\Structures\s\j076xs3.dgn		SHEET 2 OF 9