


STA. 50+044.000 TO STA. 50+045.500

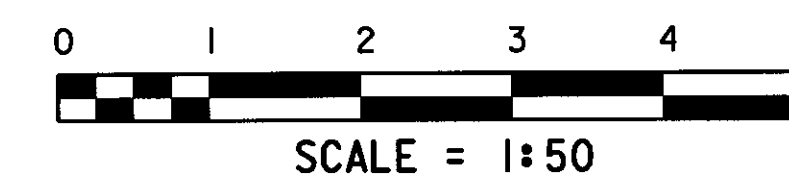

PROJECT NAME:	GUILFORD	Project sheet #3 of 9
PROJECT NUMBER:	BRO 1442(24)	
FILE NAME:	s\J076cd3.1	PLOT DATE: 04-MAR-2009
PROJECT LEADER:	R. WHITCOMB	DRAWN BY: T. LACKEY
DESIGNED BY:		CHECKED BY:
94\J076\Structures\s\J076xs3.dgn		SHEET 3 OF 9