


STA. 50+047.000 TO STA. 50+050.000

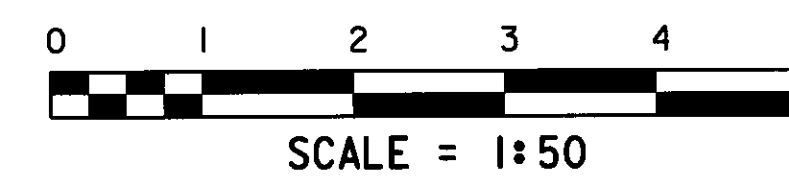

PROJECT NAME: GUILFORD	PROJECT SHEET #: 01 03
PROJECT NUMBER: BRO 1442(24)	
FILE NAME: sJ076cl4.1	PLOT DATE: 04-MAR-2009
PROJECT LEADER: R. WHITCOMB	DRAWN BY: T. LACKEY
DESIGNED BY:	CHECKED BY:
94J076\Structures\sJ076xs3.dgn	SHEET 4 OF 9