


STA. 50+053.000 TO STA. 50+054.500

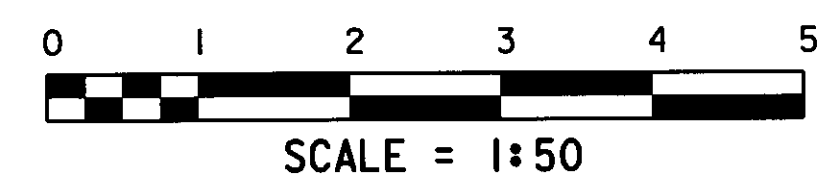

PROJECT NAME: GUILFORD	PROJECT SHEET #5 of 28
PROJECT NUMBER: BRO 1442(24)	
FILE NAME: s\076cl5.1	PLOT DATE: 04-MAR-2009
PROJECT LEADER: R. WHITCOMB	DRAWN BY: T. LACKEY
DESIGNED BY:	CHECKED BY:
94\076\structure\bro1442\bro1442.dgn	SHEET 5 OF 9