


STA. 50+056.000 TO STA. 50+056.500

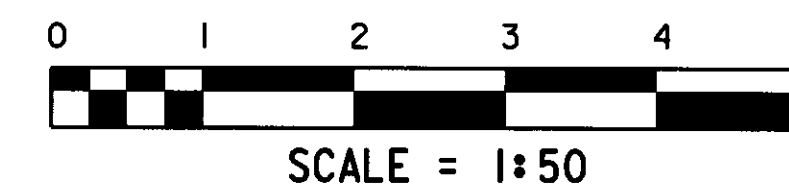

PROJECT NAME: GUILFORD	project sheet #6 of 29
PROJECT NUMBER: BRO 1442(24)	
FILE NAME: sj076c16.l	PLOT DATE: 04-MAR-2009
PROJECT LEADER: R. WHITCOMB	DRAWN BY: T. LACKEY
DESIGNED BY:	CHECKED BY:
94J076\Structures\sj076xs3.dgn	SHEET 6 OF 9