


STA. 50+057.000 TO STA. 50+058.000

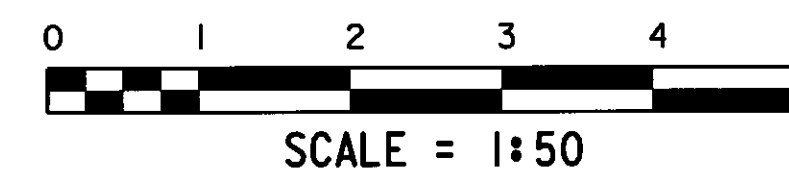

PROJECT NAME:	GUILFORD	Project sheet # of 13
PROJECT NUMBER:	BRO 1442(24)	
FILE NAME:	s\j076\c17.1	PLOT DATE: 04-MAR-2009
PROJECT LEADER:	R. WHITCOMB	DRAWN BY: T. LACKEY
DESIGNED BY:		CHECKED BY:
94\j076\Structures\s\j076xs3.dgn		SHEET 7 OF 9