


50+070.000

STA. 50+070.000 TO STA. 50+070.000

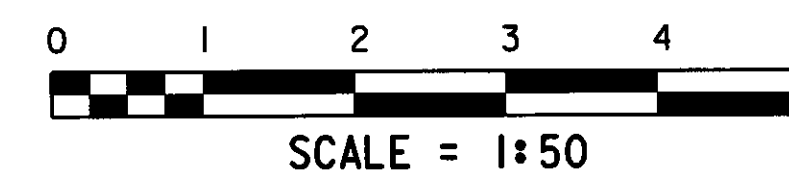

PROJECT NAME: GUILFORD	PLOT DATE: 04-MAR-2009
PROJECT NUMBER: BRO 1442(24) <i>Project sheet 40 of 28</i>	DRAWN BY: T. LACKEY
FILE NAME: sJ076cl9.1	CHECKED BY:
PROJECT LEADER: R. WHITCOMB	SHEET 9 OF 9
DESIGNED BY:	
94J076\Structures\sJ076xs3.dgn	