

10 9 8 7 6 5 4 3 2 1 0 1 2 3 4 5 6 7 8 9 10


Guilford BRD 1442(29)
 Old Bonnyvale Road Cross Sections
 project sheet #12 of 28

FINAL
 SURVEY
 NO. _____
 SURVEYED
 PLOTTED
 NOTE BOOK
 AREA CHECKED

ORIGINAL
 SURVEY
 NO. _____
 SURVEYED
 PLOTTED
 NOTE BOOK
 AREA CHECKED

174

172

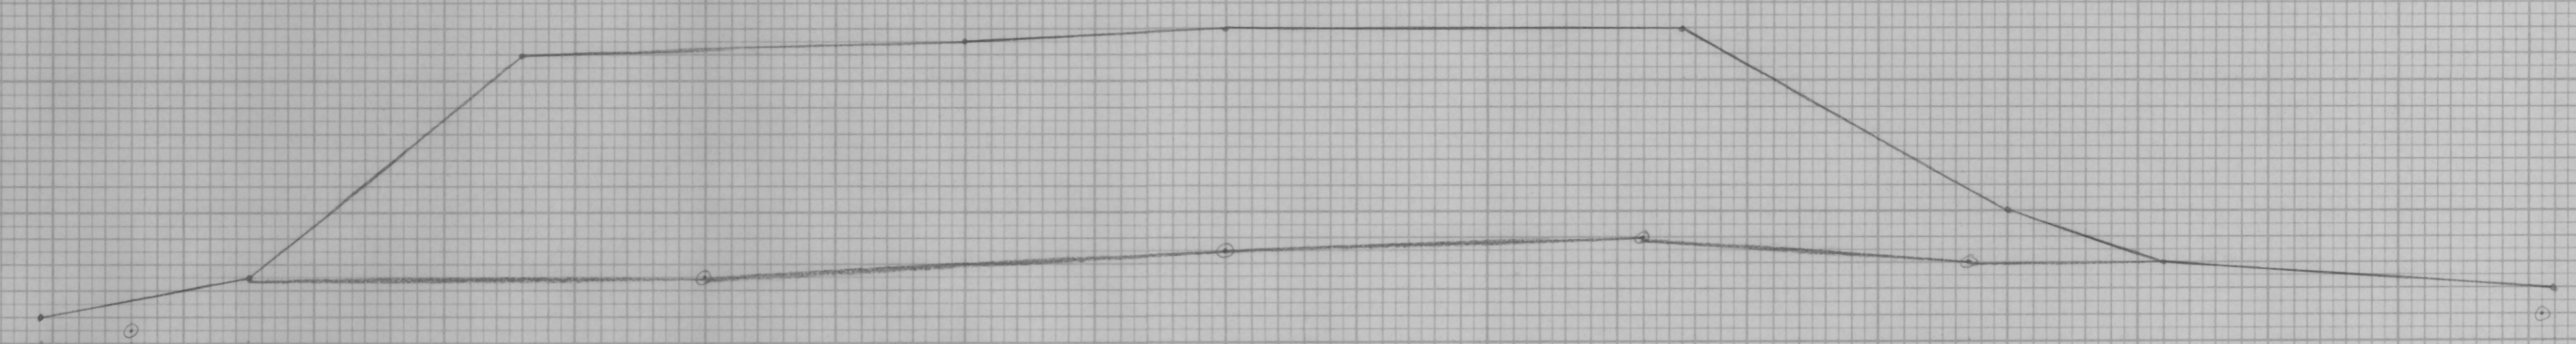

0+055


Unclassified Exc = 19.6 m²

174

172

174

172

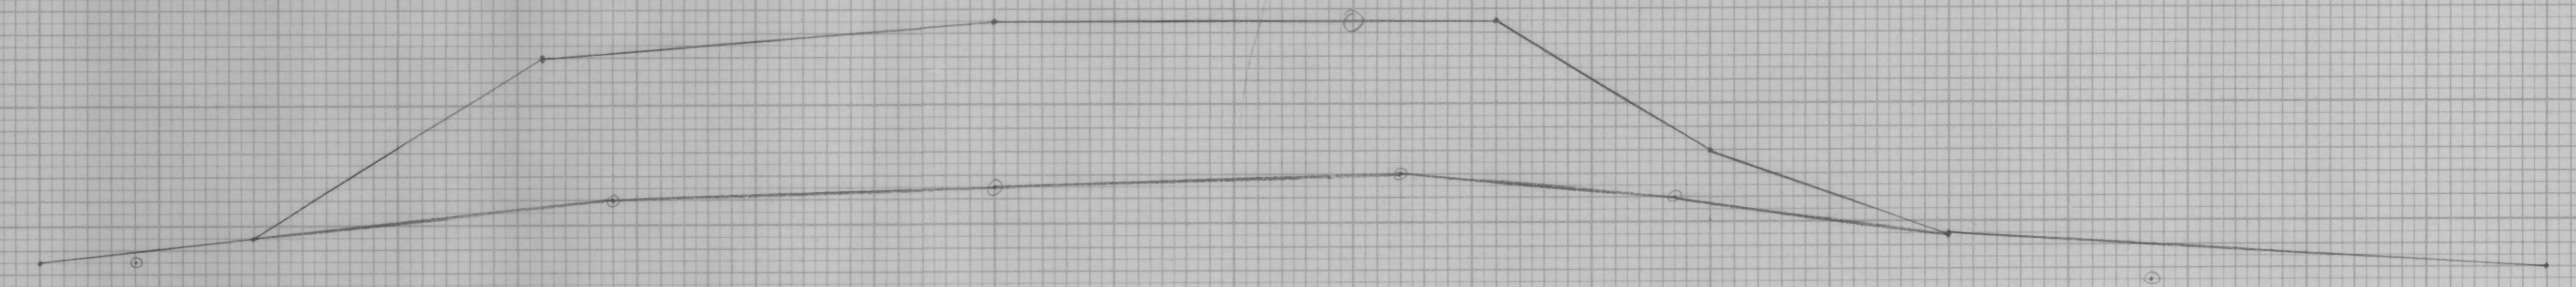

0+060


Unclassified Exc = 14.1 m²

174

172

174

172

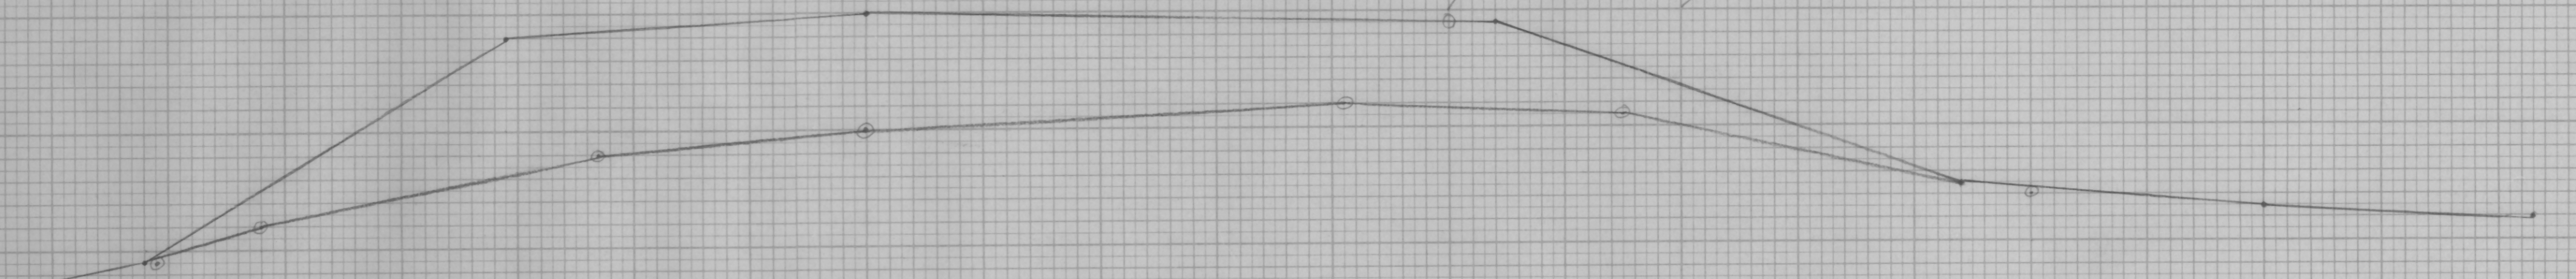

0+065

Unclassified Exc = 11.0 m²

174

172

1=65

4 = 2.61
 8 = 5.19
 4 = 2.60

for 1/4/08
 M.W.H. 1/26/10