


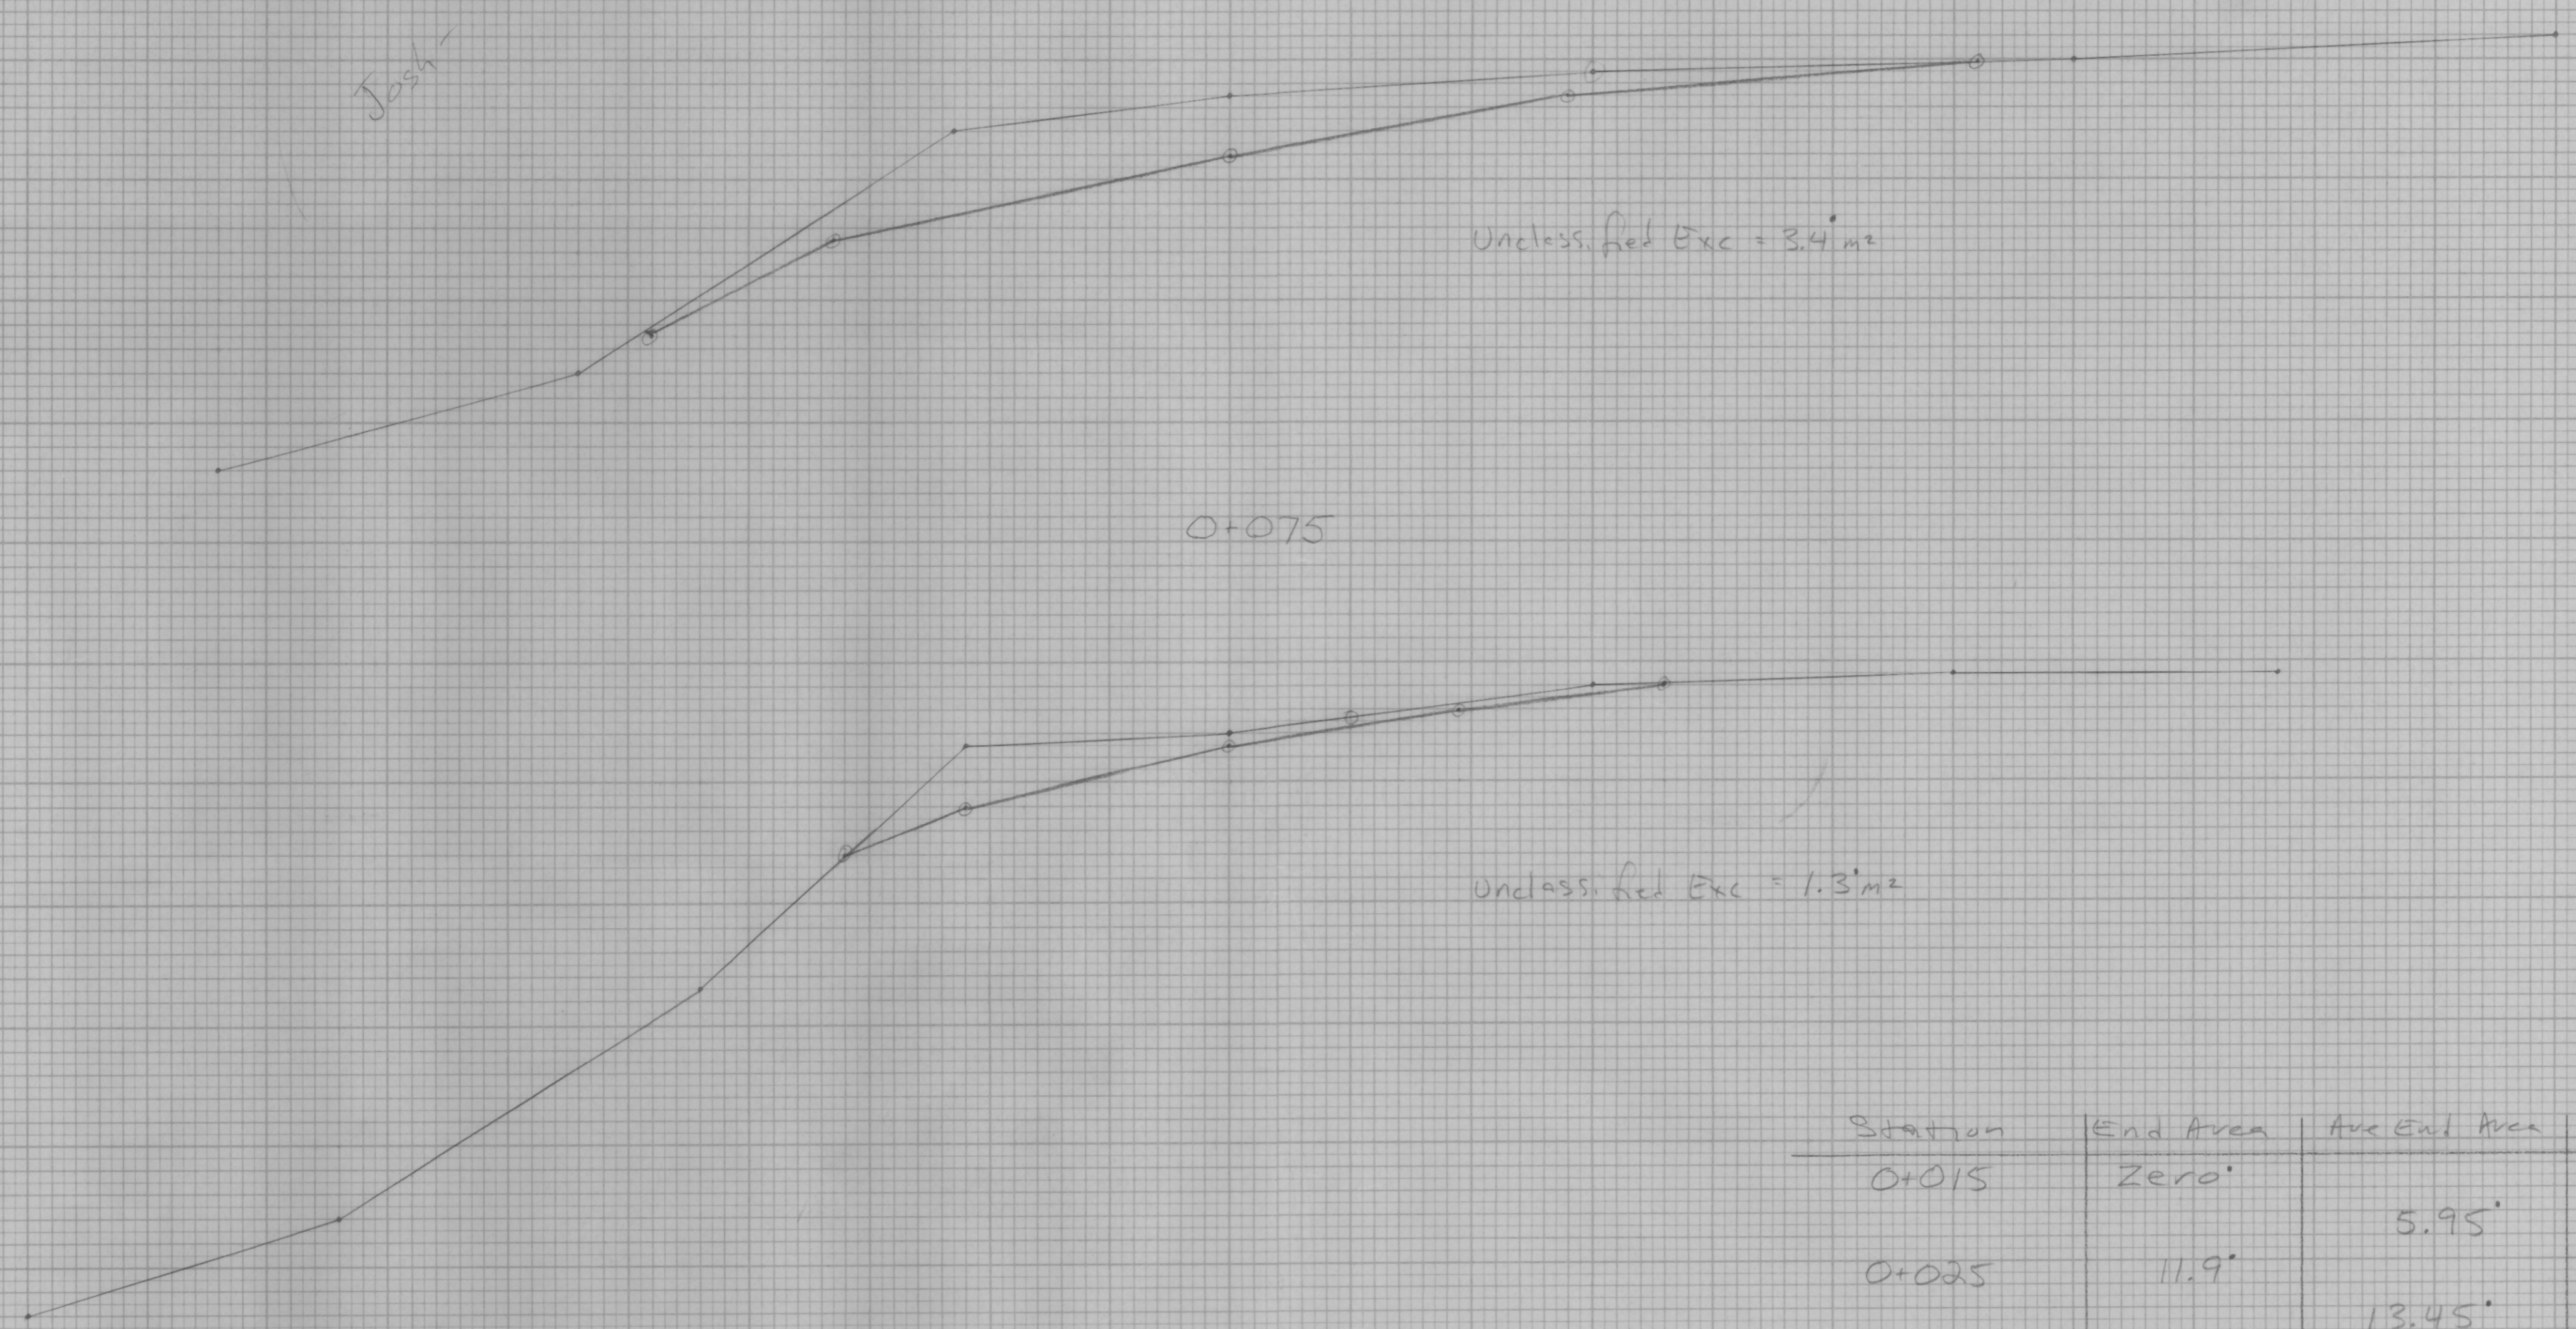

0+085
 Zero @ 0+100

Station	End Area	Ave End Area	Distance	Volume
0+015	Zero			
0+025	11.9'	5.95'	10'	59.5'
0+029	15.0'	13.45'	4'	53.8'
0+034	16.5'	15.75'	5'	78.8'
0+038(b&Rk)	20.4'	18.45'	4'	73.8'
0+045(butt A)	22.2'	21.6'	5'	108.0'
0+050	21.0'	20.3'	5'	101.5'
0+055	19.6'	16.85'	5'	84.3'
0+060	14.1'	12.35'	5'	62.8'
0+065	11.0'	7.2'	10'	72.0'
0+075	3.4'	2.35'	10'	23.5'
0+085	1.3'	0.65'	15'	9.8'
0+100	Zero			

total = 727.8 m³ fm 6-4-03
 M. W. H. 11/26/10