


GEOTEXTILE FOR SILT FENCE  
13+50, RT - 17+50, RT


**MEACH COVE REAL ESTATE TRUST;  
ANATASIOS PARAFESTAS, TRUSTEE**

**1A**

BOSTWICK ROAD CURVE DATA CURVE #1	
PI	= 17+04.97
Δ	= 33°04'46.1"LT
R	= 950.00'
T	= 282.12'
L	= 548.48'
E	= 41.01'
BANK	= 5%

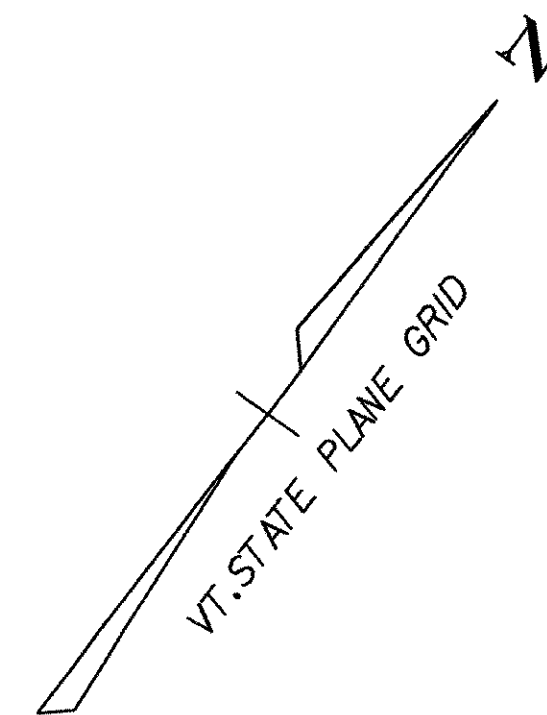

STA 13+60.00  
BEGIN PROJECT BRO 1445 (30)  
END APPROACH CONSTRUCTION

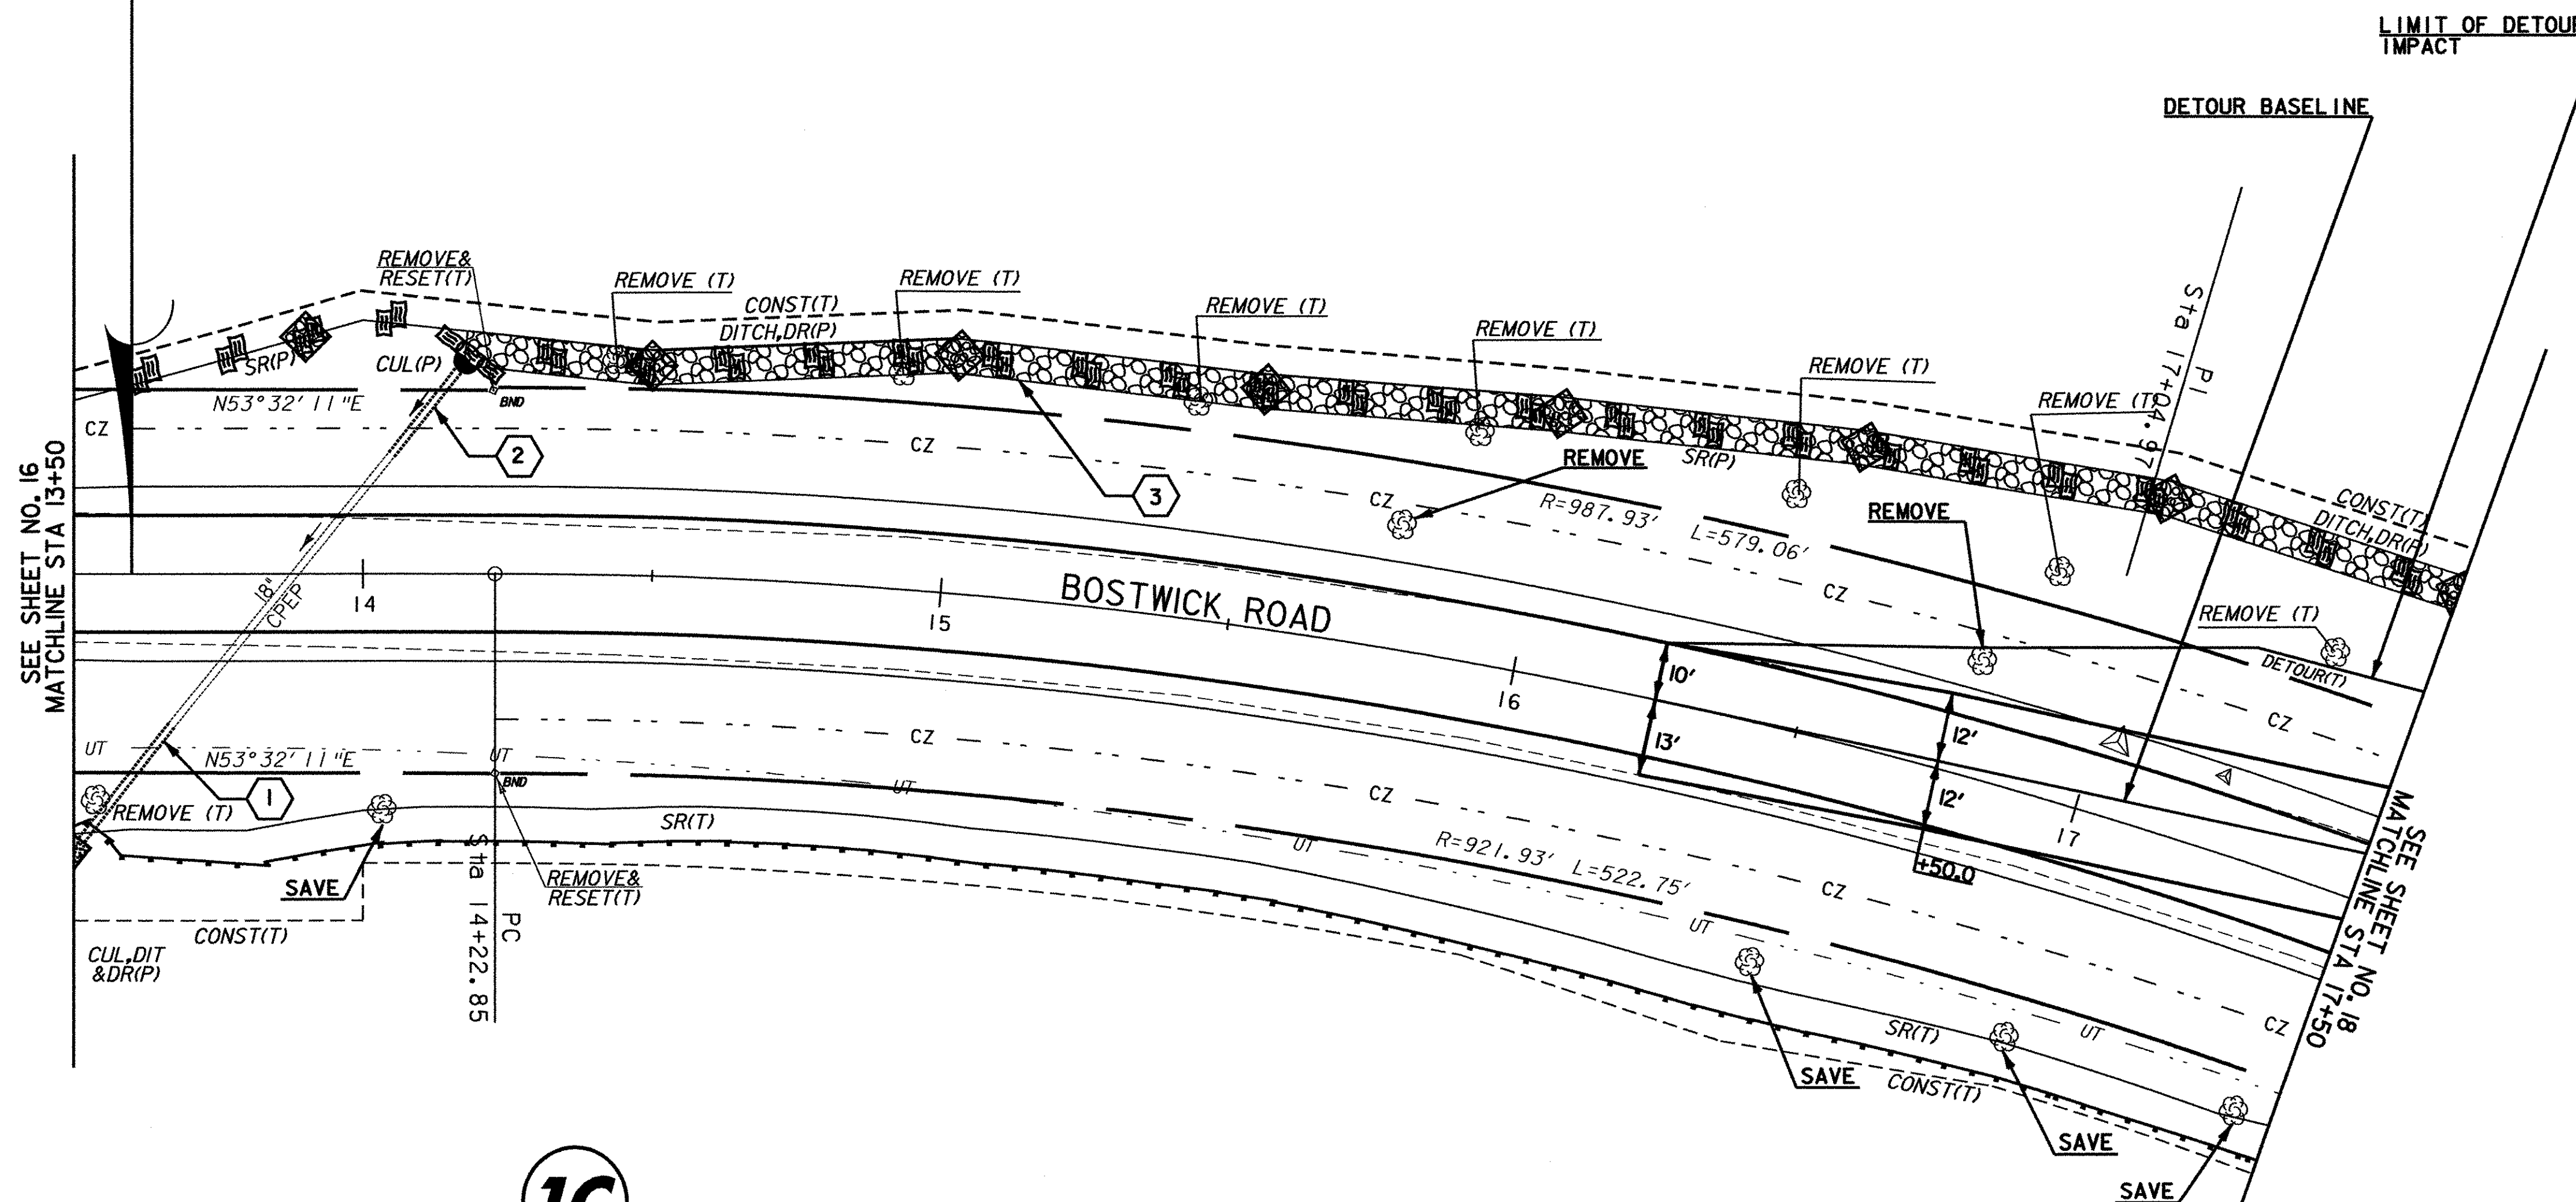

**1C**

**MEACH COVE REAL ESTATE TRUST;  
ANATASIOS PARAFESTAS, TRUSTEE**

- ① STA 13+51.3, RT 46.0 TO STA 13+66.9, RT 26.1  
CONSTRUCT 18' x 27' CPEP EXTENSION  
CONSTRUCT STONE PAD AT OUTLET  
(SEE STONE FILL DETAIL SHEET)
- ② STA 14+05.0, LT 20.4 TO STA 14+22.0, LT 41.4  
CONSTRUCT 18' x 24' CPEP EXTENSION
- ③ STA 13+75, LT TO STA 19+25, LT  
CONSTRUCT 550' TOE OF SLOPE STONE DITCH  
(SEE CROSS SECTIONS AND DRAINAGE DETAIL SHEET)


- STONE DITCH (PERMANENT)
- WETLANDS
- EROSION MATTING (TEMPORARY)
- HAYBALES (TEMPORARY)
- STONE CHECK DAM (TEMPORARY)

LINES SHOWN ON THIS PLAN AS EXISTING  
PROPERTY LINES P/L ARE BELIEVED TO  
BE ACCURATE BUT SHOULD NOT BE RELIED  
UPON FOR PURPOSES UNRELATED TO THE  
TOWN OF SHELBURNE'S ACQUISITION OF LAND  
AND RIGHTS FOR THIS PROJECT.

**FOR R.O.W.  
USE ONLY**

DATUM  
VERTICAL NAVD 88  
HORIZONTAL NAD 83 (1996)

LAYOUT SHEET

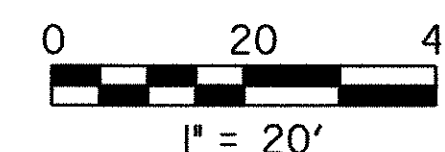

<b>LAYOUT SHEET</b>	PROJECT NAME: SHELBURNE
	PROJECT NUMBER: BRO 1445(30)
	FILE NAME: \\vaot_cadd\flingcabinet\94\96\RightOfWay\layout2.dgn
	PROJECT LEADER: MBZ PLOT DATE: 06-AUG-2003
DESIGNED BY: DMB DRAWN BY: MJF	
	R.O.W. SHEET 17 OF 19 SHEET 8 OF 73