

GEOTEXTILE FOR SILT FENCE	
3+90, LT - 3+90, RT	
5+20, RT - 6+00, LT	

GEOTEXTILE FOR SILT FENCE	
17+50, RT - 20+37, RT	
20+00, LT - 20+37, LT	
20+67, RT - 21+00, RT	
20+67, LT - 21+40, LT	



EROSION MATTING	
21+80, LT - 33+50, LT	

BOSTWICK FARM ROAD DRIVE CURVE DATA	
CURVE #1	
PI = 40+61.44	
Δ = 20°46' 20.0"RT	
R = 200.00'	
T = 36.66'	
L = 72.51'	
E = 3.33'	
BANK = N. C.	

STATE OF VERMONT; LESSOR
MEACH COVE REAL ESTATE TRUST; ANASTASIOS PARAFESTAS, TRUSTEE

STATE OF VERMONT; LESSOR
VERMONT RAILWAY, INC.; LESSEE

STATE OF VERMONT; LESSOR
MEACH COVE REAL ESTATE TRUST; ANASTASIOS PARAFESTAS, TRUSTEE

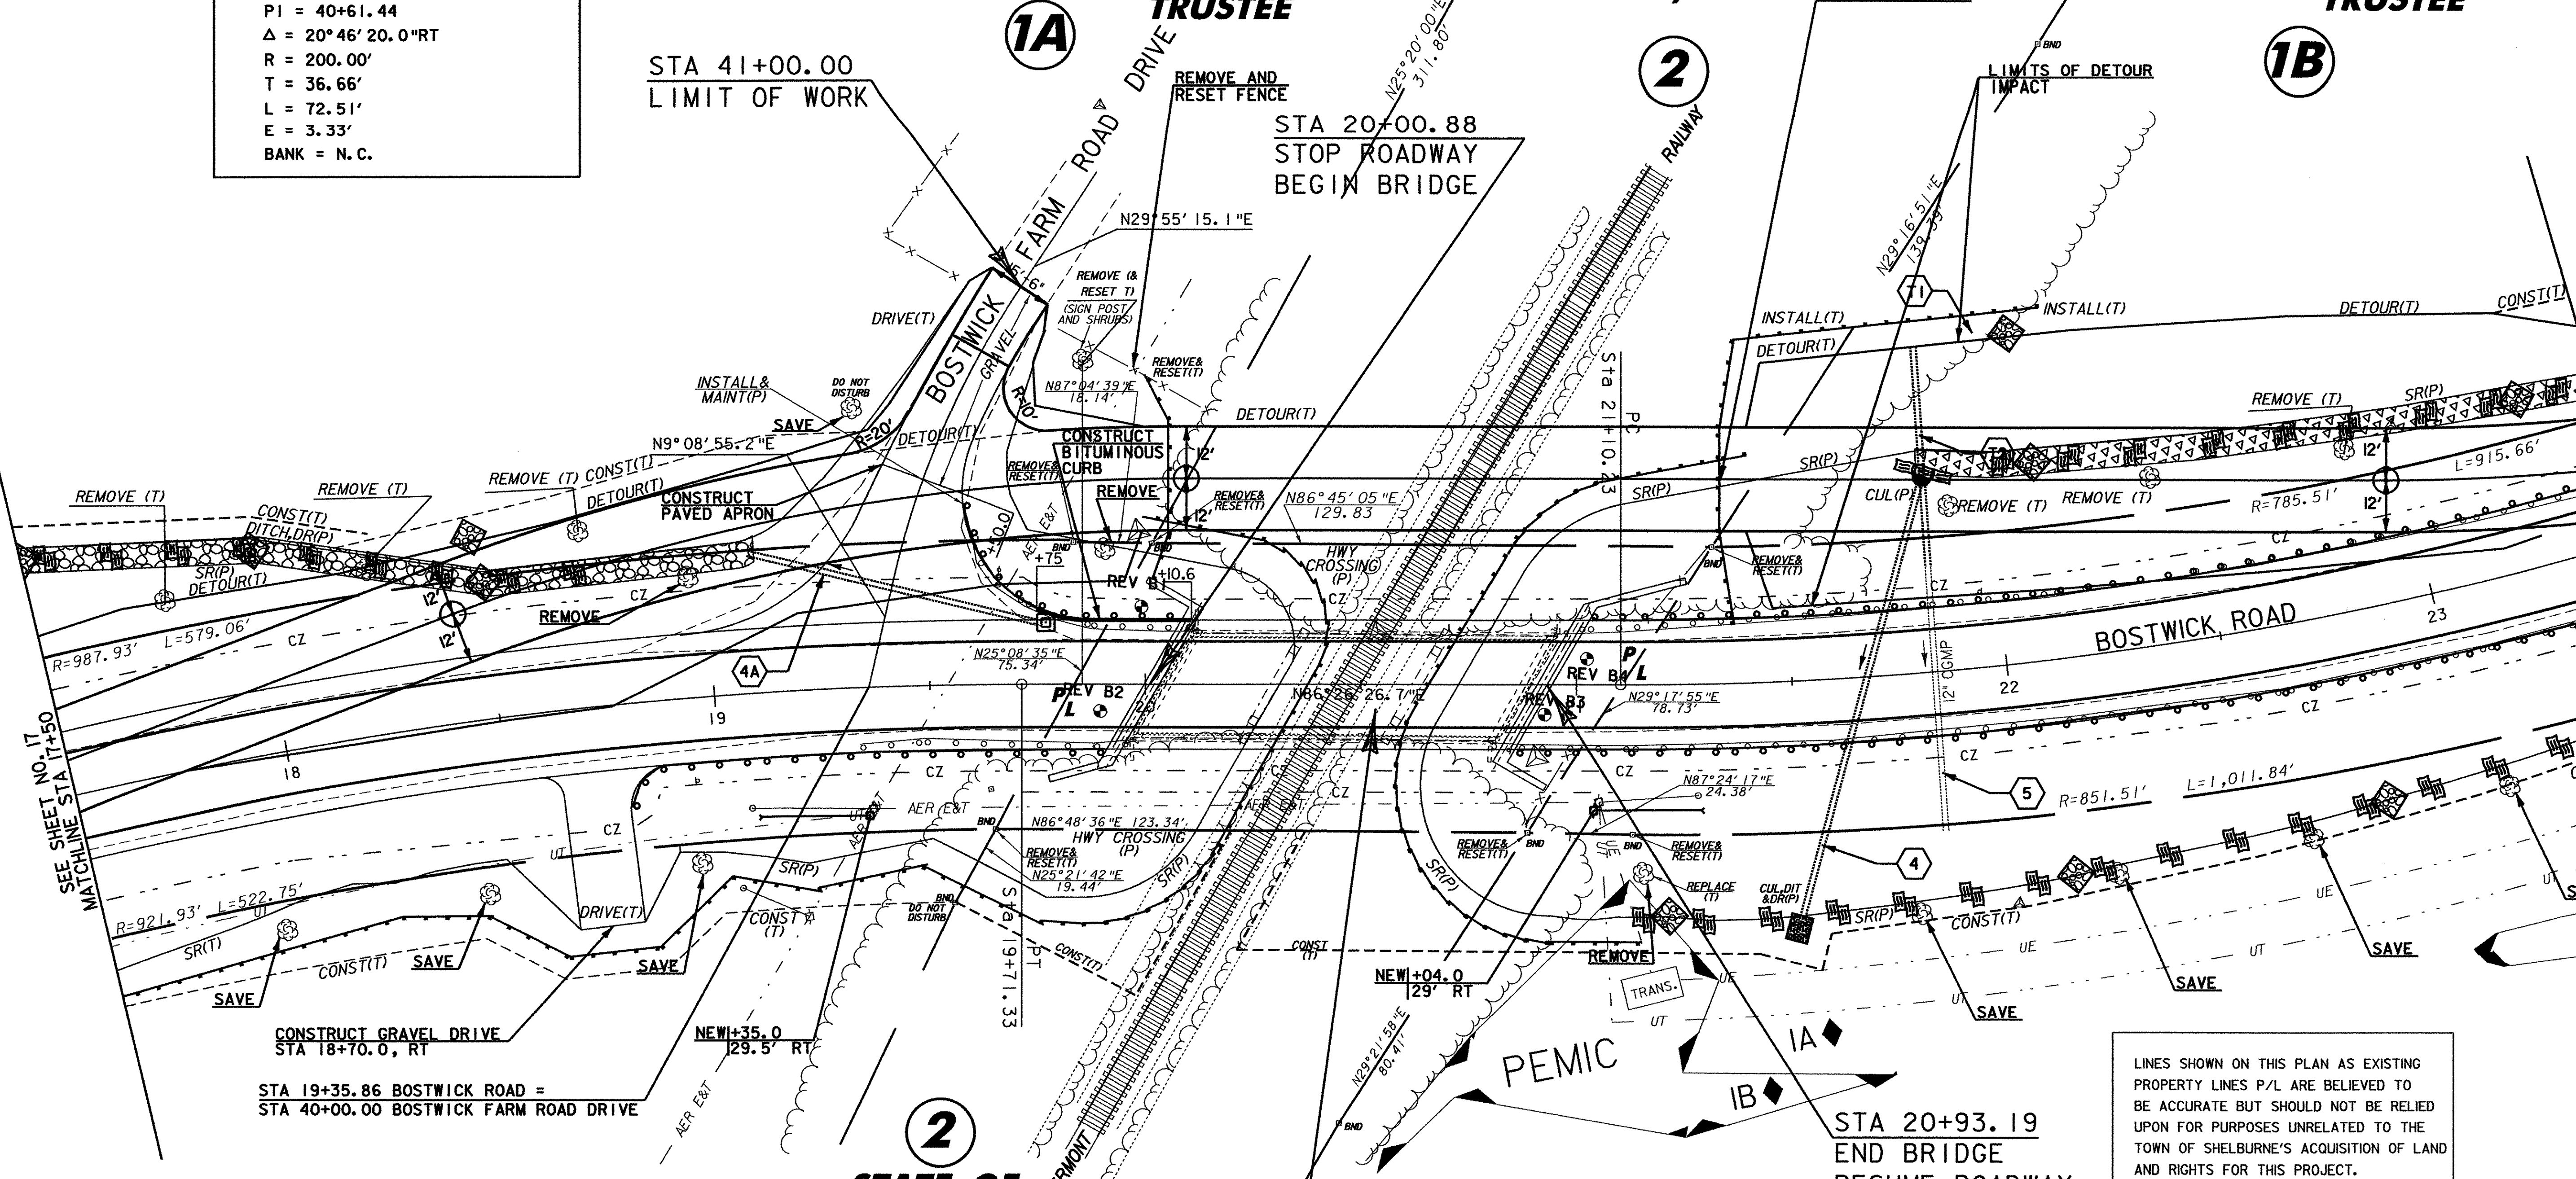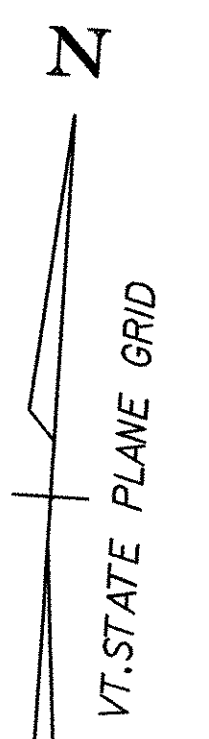


1C
MEACH COVE REAL ESTATE TRUST; ANASTASIOS PARAFESTAS, TRUSTEE

STATE OF VERMONT; LESSOR
VERMONT RAILWAY, INC.; LESSEE

3
FOR R.O.W. USE ONLY
WAKE ROBIN CORPORATION

	STONE DITCH (PERMANENT)
	WETLANDS
	EROSION MATTING (TEMPORARY)
	HAYBALES (TEMPORARY)
	STONE CHECK DAM (TEMPORARY)

DATUM	
VERTICAL	NAVD 88
HORIZONTAL	NAD 83 (1996)

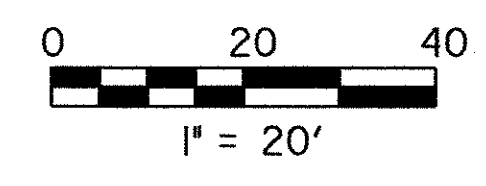

LINES SHOWN ON THIS PLAN AS EXISTING PROPERTY LINES P/L ARE BELIEVED TO BE ACCURATE BUT SHOULD NOT BE RELIED UPON FOR PURPOSES UNRELATED TO THE TOWN OF SHELBURNE'S ACQUISITION OF LAND AND RIGHTS FOR THIS PROJECT.

- 4A STA 19+77, LT 15.0' TO STA 19+10, LT 33.0'
CONSTRUCT 15' x 67' CPEP
CONSTRUCT DI-A STA 19+77, LT 15.0'
- 4 STA 21+50, RT 54.1 TO STA 21+86, LT 48.3
CONSTRUCT 18' x 106' CPEP
CONSTRUCT STONE PAD AT OUTLET
(SEE STONE FILL DETAIL SHEET)
- 5 STA 21+83, LT TO STA 21+83, RT
FILL WITH FLOWABLE FILL AND ABANDON

LAYOUT SHEET	PROJECT NAME: SHELBURNE
	PROJECT NUMBER: BRO 1445(30)
	FILE NAME: \\vaot_cadd\fillingcabinet\94j96\RightOfWay\layout3.dgn
	PROJECT LEADER: MBZ PLOT DATE: 06-AUG-2003
DESIGNED BY: DMB DRAWN BY: MJF	
CHECKED BY: R.O.W. SHEET 18 OF 19 SHEET 9 OF 73	